



Building 2 SG 105 computer room

Existing UFAD Layout and CRAC unit locators

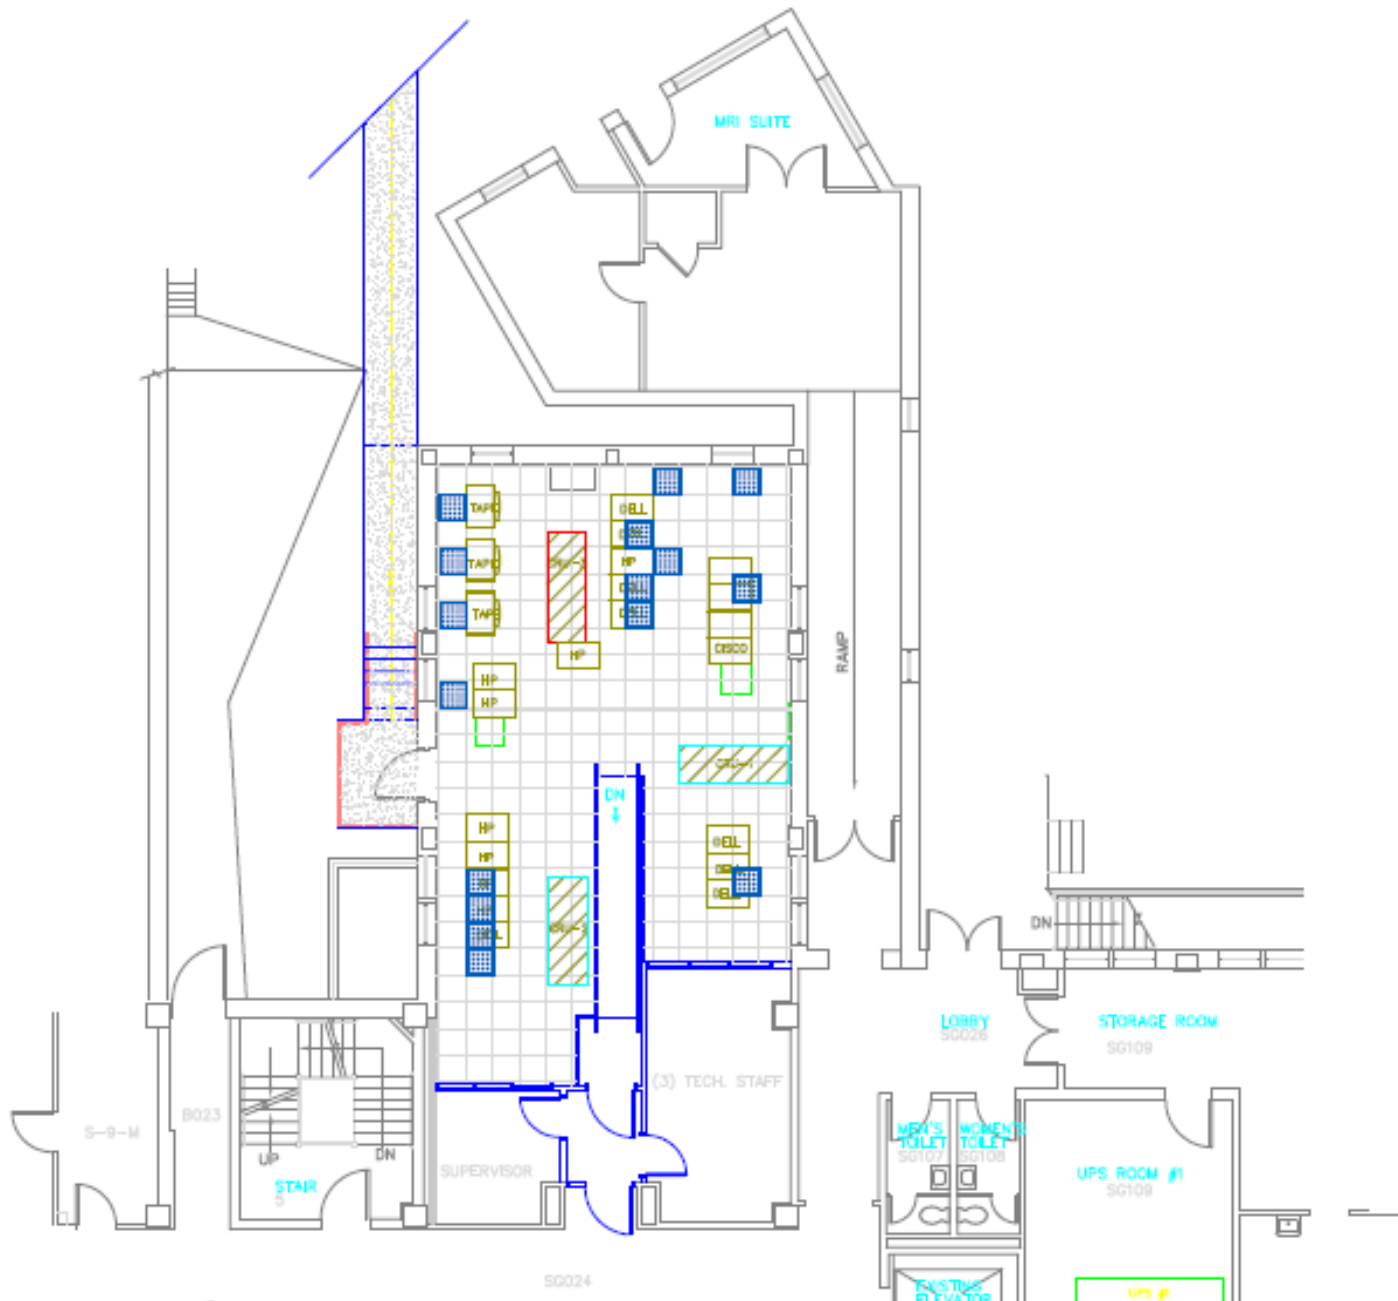

3) TECH. STAFF

Building 2 – Room G100 Split Air Conditioner

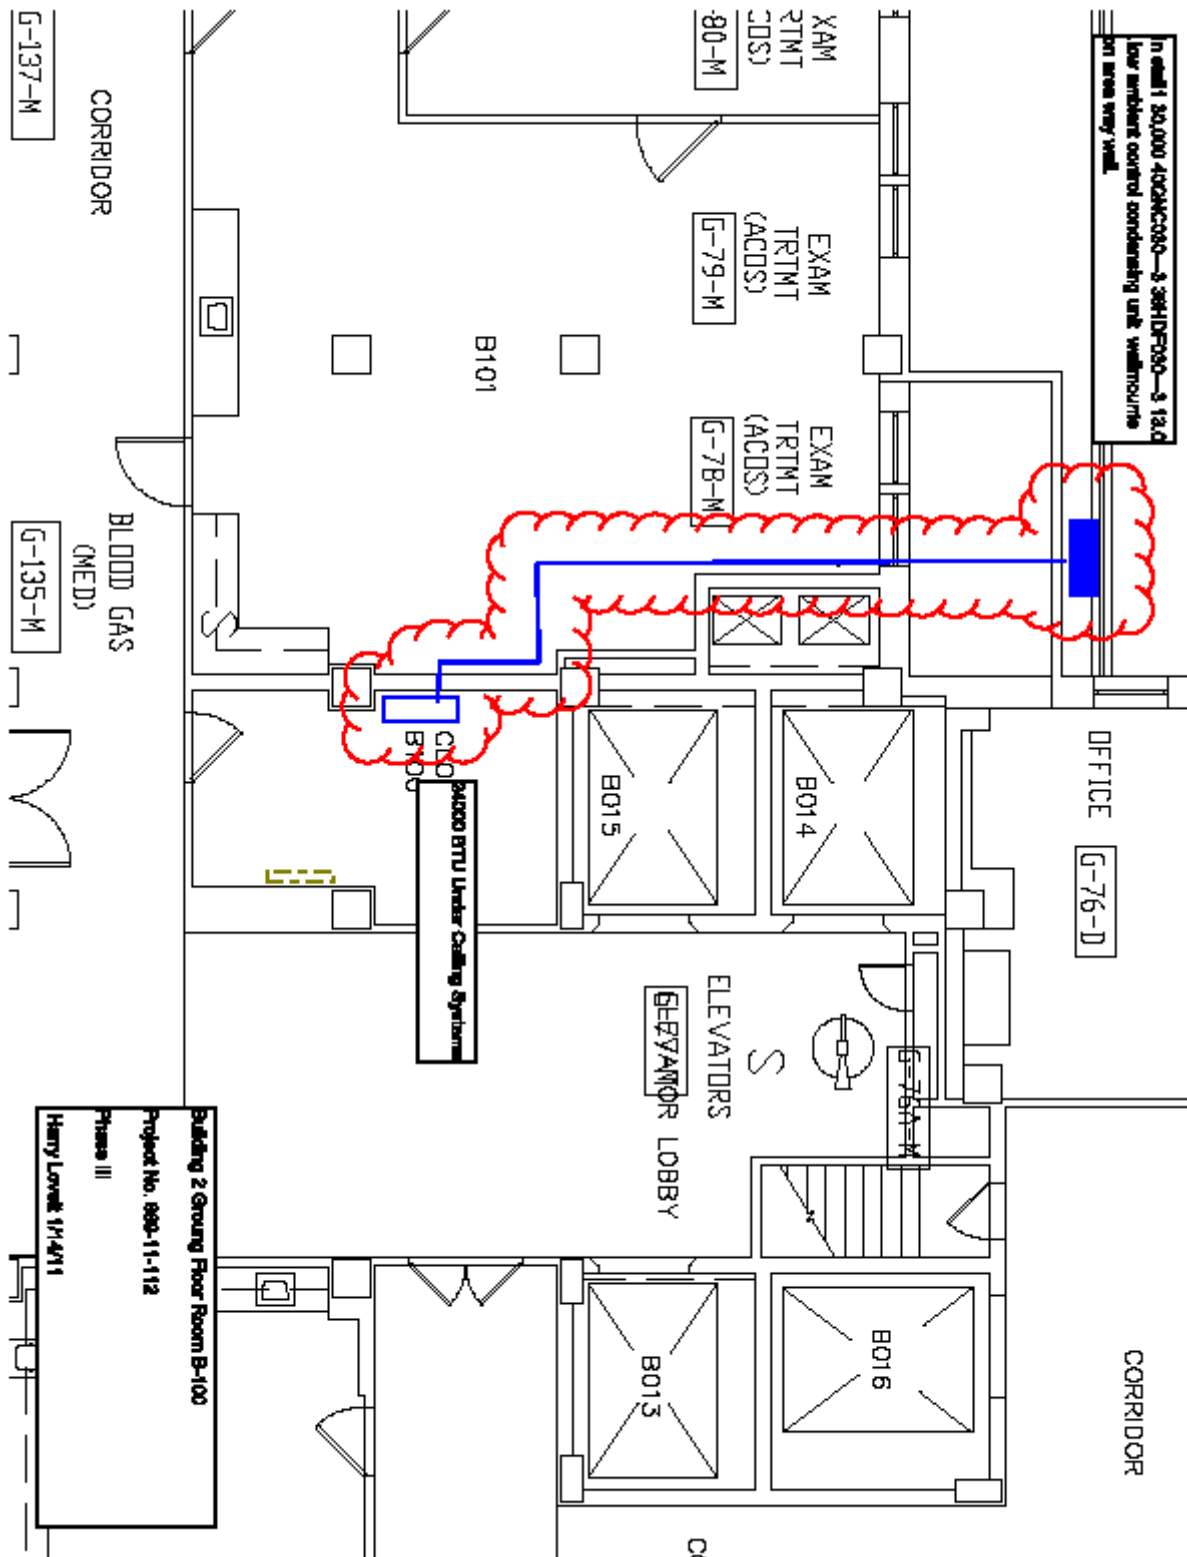

IRM Closet Building 5 C103c

