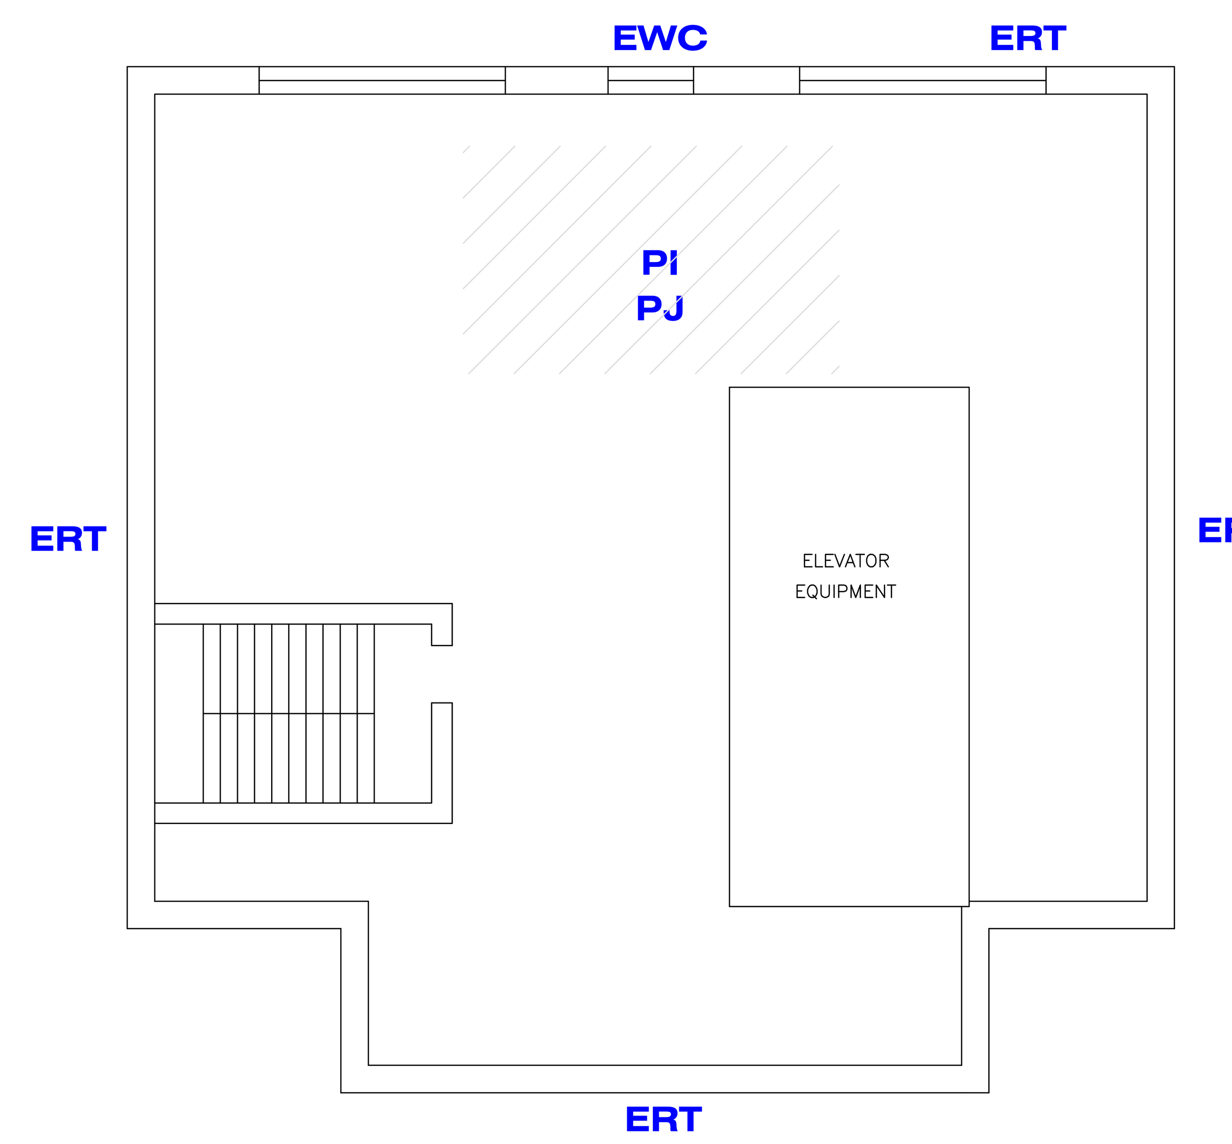

BLDG. 1 - PENTHOUSE MECHANICAL ROOM

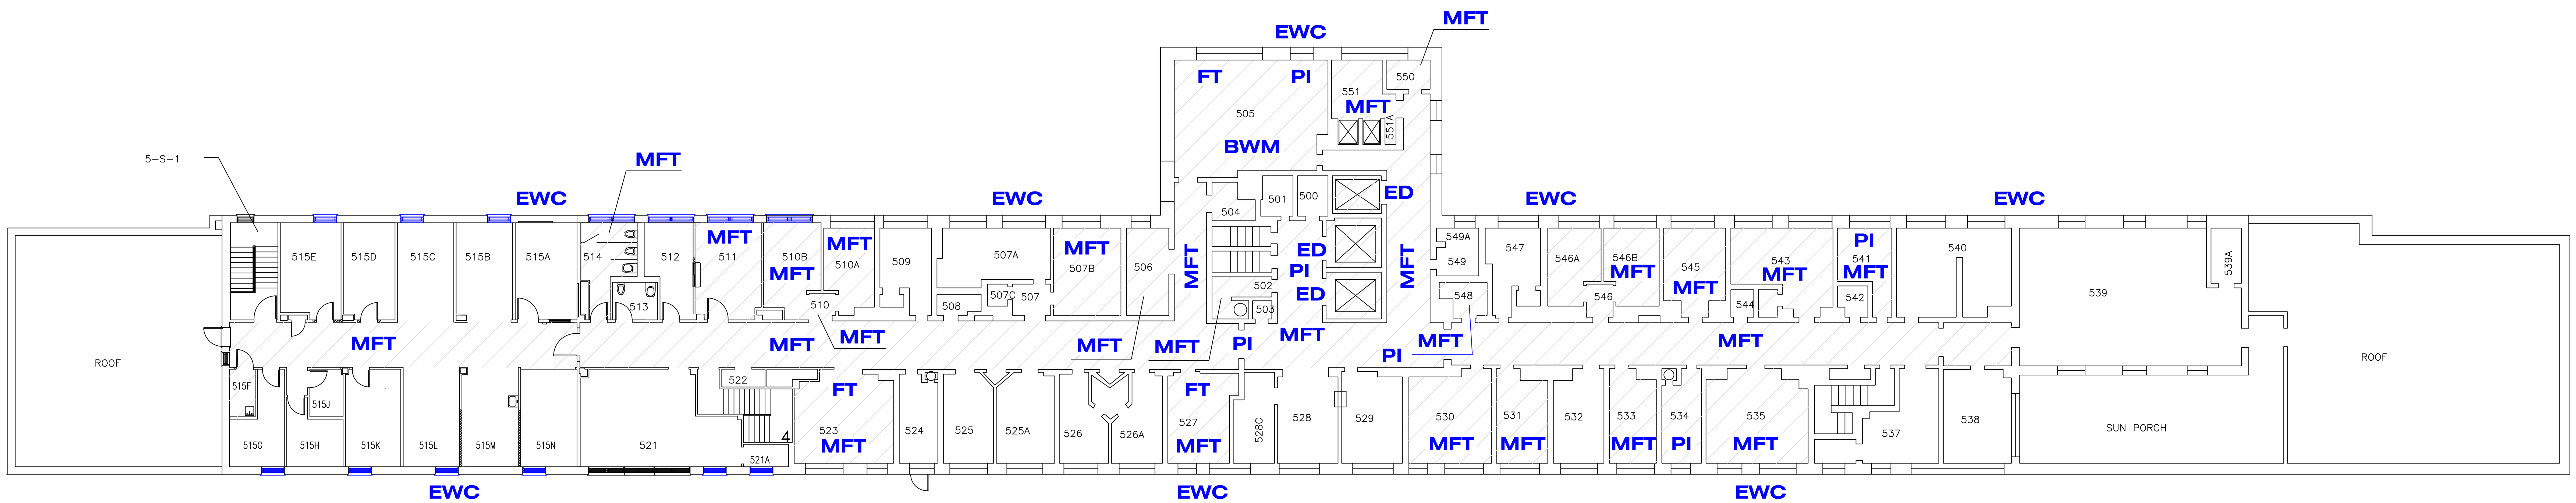

BLDG. 1 - FIFTH FLOOR

LEGEND

PI - PIPE INSULATION W/ ASSOCIATED FITTINGS
EWC - EXTERIOR WINDOW CAULK
FT - FLOOR TILE
MFT - MASTIC ASSOCIATED W/ FLOOR TILE
BWM - BLACK WALL MASTIC
PJ - PIPE FITTINGS
ERT - EXTERIOR ROOF TAR

POSITIVE HOMOGENOUS AREAS
101 **ROOM NUMBER**

SCALE: N.T.S

Revisions: | Date

Approved: Medical Center Director
Approved: Medical Center Assoc. Director
Approved: Engineering Department
Charles Applewhite

Drawing Title: **ASBESTOS LOCATIONS**
Approved: Project Director

Project Title: **ASBESTOS RE-INSPECTION**
Location: **FORT WAYNE, IN**
Date: **12/11/11** | Checked: **RCM** | Drawn: **ICB**

Project Number: **610-11-112**
Building Number: **1**
Drawing Number: **HA-M-1-5**
Dwg. **6** of **7**

DEPARTMENT OF VETERANS AFFAIRS · UNITED STATES OF AMERICA

VA FORM 08-6231, OCT 1978