

CAP THE GAS LINE AT
DEMOLISHED "GAS
METER HOUSE" LOCATION
CLARIFICATION: THE EXISTING
TEE AT THE GAS HOUSE IS A
6' TEE


- CONSTRUCTION NOTES:**
1. CONTRACTOR SHALL VERIFY ALL DIMENSIONS AND LOCATE ALL EXISTING UTILITIES IN CONSTRUCTION AREA BEFORE CONSTRUCTION.
 2. CONTRACTOR SHALL INSTALL NEW 6" POLY GAS LINE. THIS LINE SHALL TIE INTO EXISTING 6" POLY GAS LINE THAT FEEDS FACILITY AND CONNECT TO OKLAHOMA NATURAL GAS (ONG) METER THAT WILL BE LOCATED NEAR EXISTING REGULATORS.
 3. ONG SHALL INSTALL NEW GAS METER AND COMPONENTS TO BE NEAR EXISTING REGULATORS. GAS METER AND REGULATORS SHALL BE SET ON MAINTENANCE CONCRETE PAD AND ONG SHALL ENCLOSE REGULATORS AND GAS METER WITH CHAIN-LINK FENCE.
 4. CONTRACTOR SHALL ENCLOSE BALL VALVE AND NEW GAS LINE CONNECTION WITH CHAIN LINK FENCE AND GATE. THIS WILL BE ADDED TO THE ONG FENCE AS AN EXTENSION OF THE METER FENCE ENCLOSURE.
 5. CONTRACTOR SHOULD NOT NEED TO ADDRESS CROSSING THE SECOND STORM WATER RUN-OFF DITCH TO THE EAST WITH THE NEW GAS LINE. ONG HAS AGREED TO LOCATE METER AS SHOWN, BETWEEN THE TWO DITCHES.
 6. CONTRACTOR SHALL REPLACE ANY DISTURBED EROSION PROTECTION.
 7. TREE REMOVAL IS PERMITTED WITH THE COR'S APPROVAL.
 8. EXISTING GAS METER HOUSE WILL BE DEMOLISHED AND REMOVED BY ONG

NEW GAS METER, NEW GAS LINE CONNECTION, NEW BALL VALVE
WITH CHAIN LINK FENCE ENCLOSURES


CAP THE GAS LINE AT
REGULATOR LOCATION


EAST STORM WATER DITCH: DO NOT CROSS WITH NEW
GAS LINE

APPROXIMATE CONFIGURATION OF
CONTRACTOR SUPPLIED FENCE WITH 4' GATE

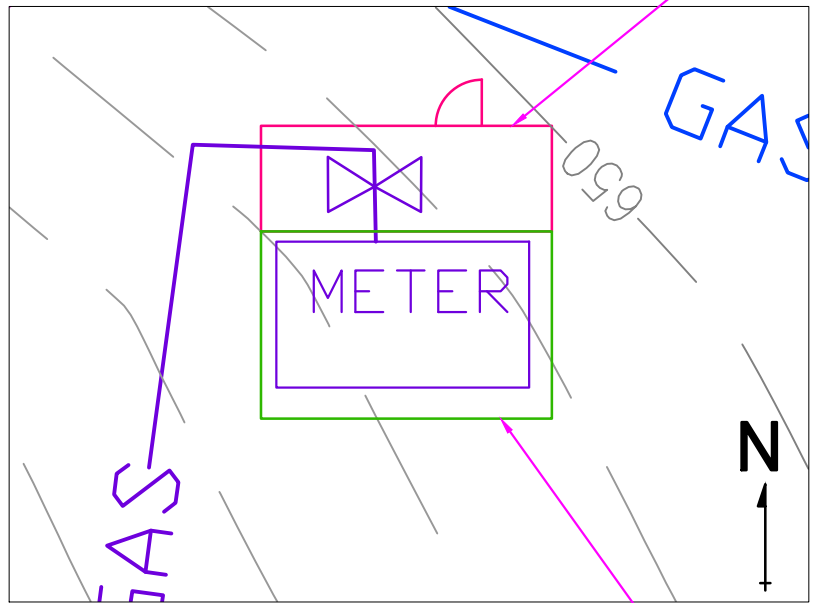

APPROXIMATE CONFIGURATION OF ONG SUPPLIED FENCE
METER PAD TO BE 6' X 13'

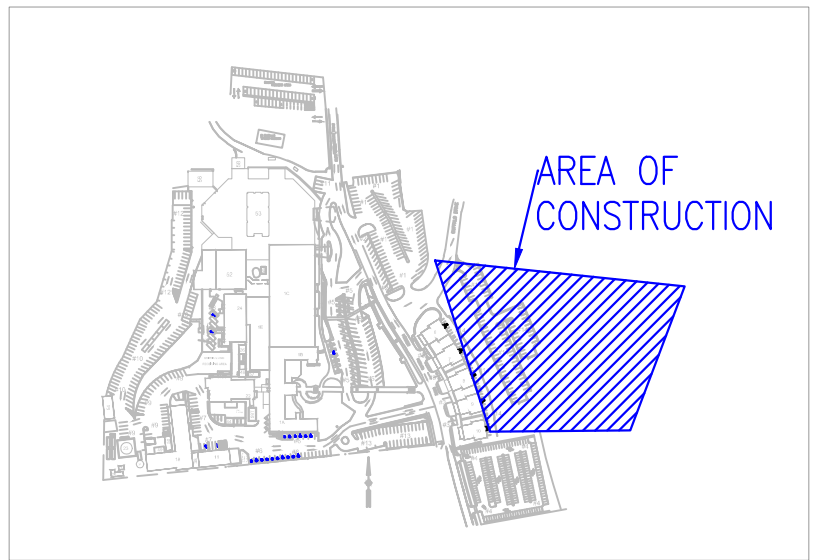

REVISIONS		DATE		 <div>Dept. of Veterans Affairs Medical Center 1011 Honor Heights Drive Muskogee, OK. 74401</div>	
-----------	--	------	--	--	