KEYED NOTES -

1. EXISTING FIRE ALARM NAC PANEL SERVING THE AREA OF WORK.
2. ASCOM NURSE CALL HEAD END EQUIPMENT SERVING THE AREA OF WORK SHALL BE WALL MOUNTED WITHIN NEW TELECOM ROOM DG223A. PROVIDE IP SWITCH AND GATEWAY TO ACCOMMODATE NETWORK INTO ASCOM NURSCALL SYSTEM AND NEW NURSE CALL DEVICES. REFER TO NURSE CALL RISER DETAIL FOR ADDITIONAL INFORMATION.
3. PROVIDE JUNCTION BOX ABOVE CEILING. ROUTE ANY NEW LIFE SAFETY CIRCUITS THROUGHT THIS JUNCTION BOX PRIOR TO TERMINATING IN PANEL.
4. WIREWAY IS MOUNTED ABOVE CEILING, AT THIS LOCATION.
5. UTILIZE THE SPACE OUTLINED TO RISE FROM THIS LEVEL TO SECOND FLOOR FOR ROUTING OF NURSE CALL BACKBONE.
6. NOT USED.
7. PROVIDE NEW ACCESS CONTROL PANEL FOR ACCESS CONTROL DEVICES ON DOORS PROVIDED AS PART OF THIS PROJECT.

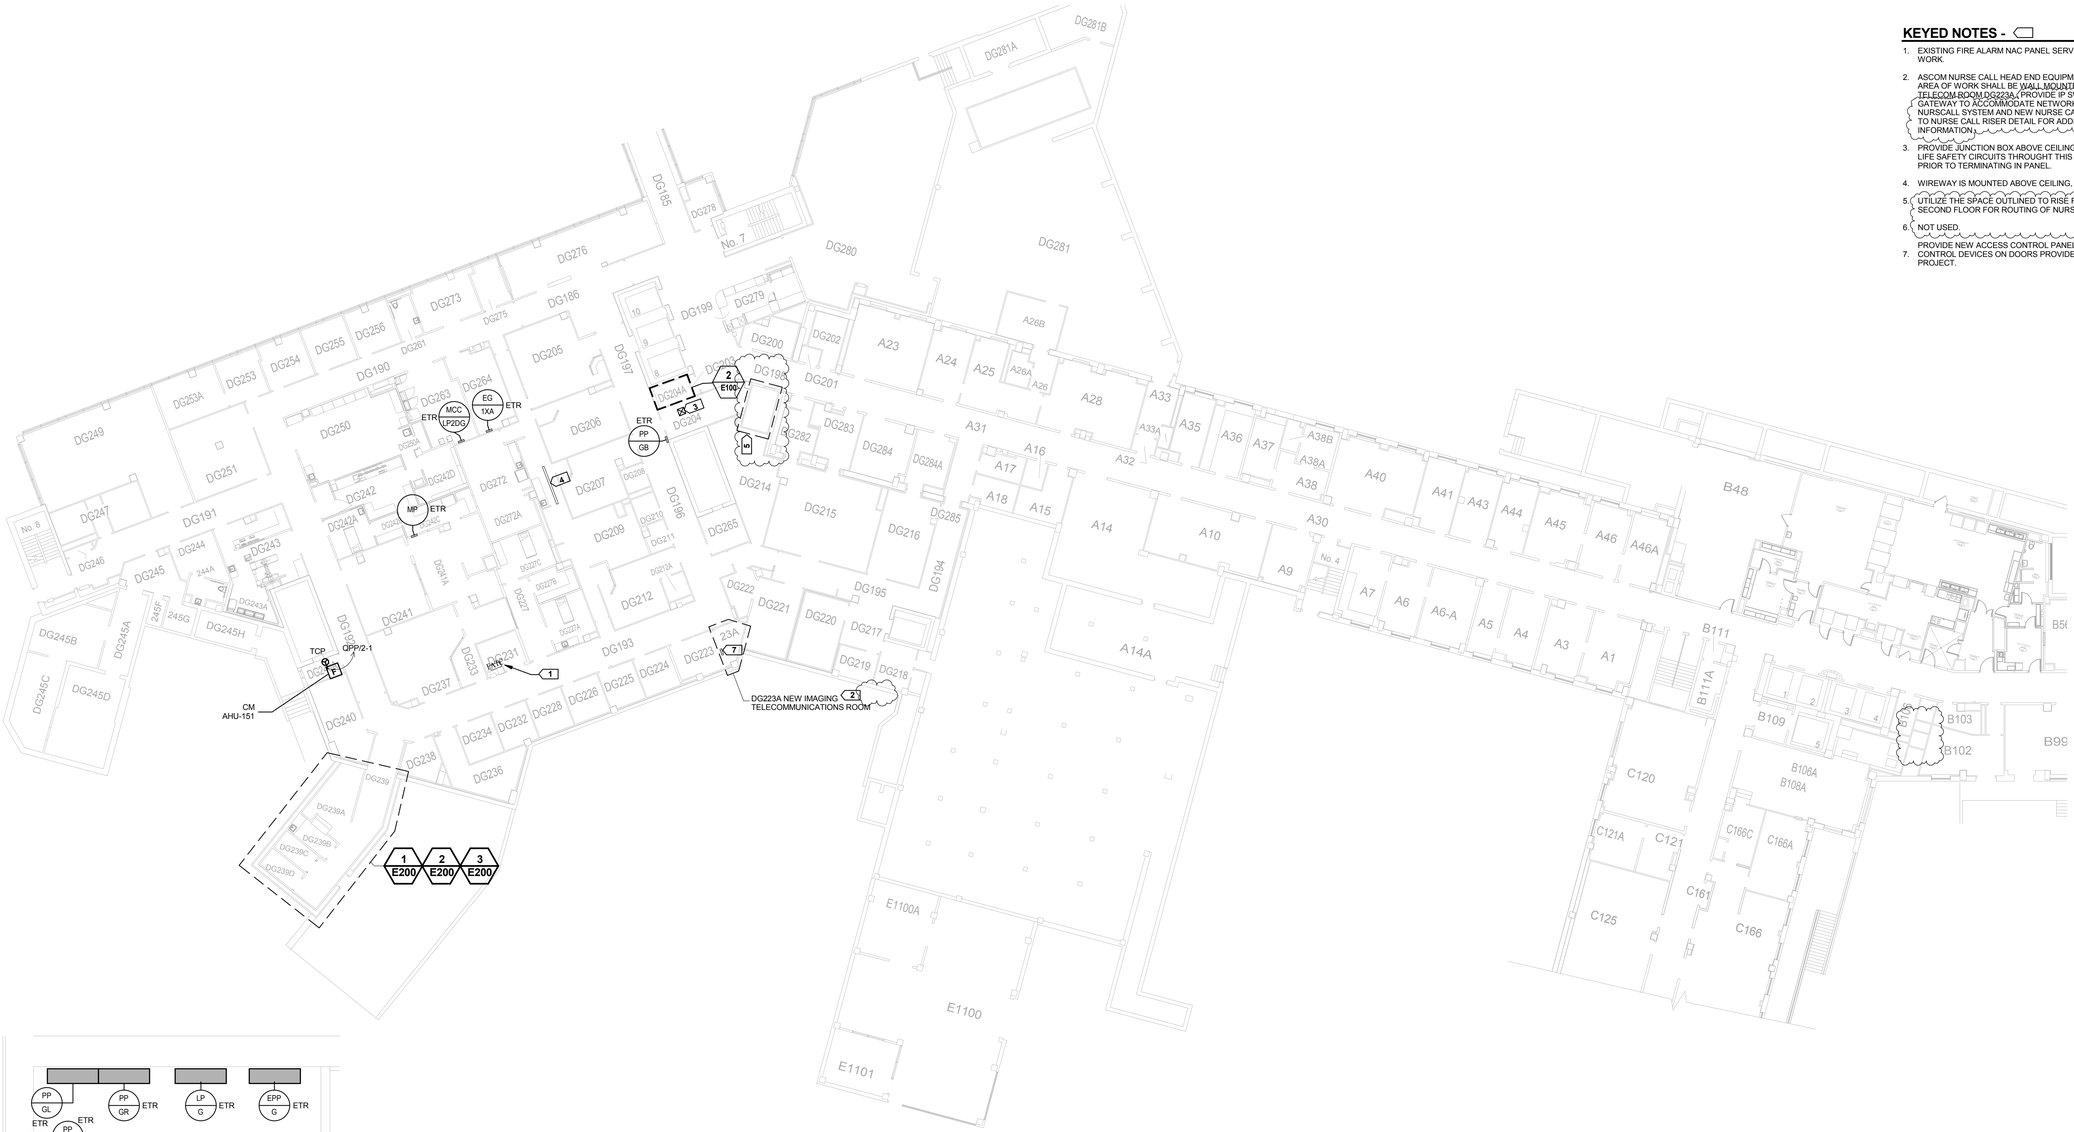

2 E100 ENLARGED ELECTRICAL ROOM - DG-204A

1/2" = 1'-0"

NORTH

1 E100 PARTIAL GROUND FLOOR PLAN

1/16" = 1'-0"

NORTH

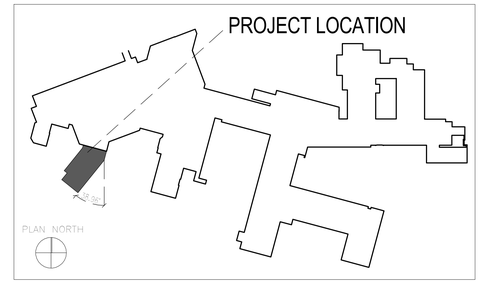

KEY PLAN

100% Construction Documents

VA69D-16-B-1310-A00002	10/26/2016
Revisions:	Date

CONSULTANTS:

BWBR Architects, Inc.
1241 John Q. Hammons Drive
Suite 503
Madison, WI 53717

GRAEF
5126 W. Terrace Drive
Suite 111
Madison, WI 53718

The Concord Group
55 E. Monroe Street
Suite 2850
Chicago, IL 60603

Ring & DuChateau, LLP
17400 W. Capitol Drive
Brookfield, WI 53045

Environmental Management Consulting, Inc.
W7748 County Highway V
Lake Mills, WI 53551

ARCHITECT/ENGINEERS:

13100 watertown plank road
suite 200
elm grove, wi 53122

nagel architects

Nagel Architects Project Number: 151102

Drawing Title: **PARTIAL GROUND FLOOR PLAN**

Approved: Project Director
-
-
-

Project Title: CONSTRUCTION MRI SUITE

Location: William S. Middleton VA Hospital, Madison, WI

Date: 09/26/2016 | Checked: TKO | Drawn: MEG

Project Number: 607-CSI-104

Building Number: BLDG 1, New Addition

Drawing Number: **E100**

Dwg. XX of XX

Office of Construction and Facilities Management

Department of Veterans Affairs

VA FORM 08-6231

ACCOMPANYING AMENDMENT– VA69D-16-B-1310 - A00002