


PHASE 2A

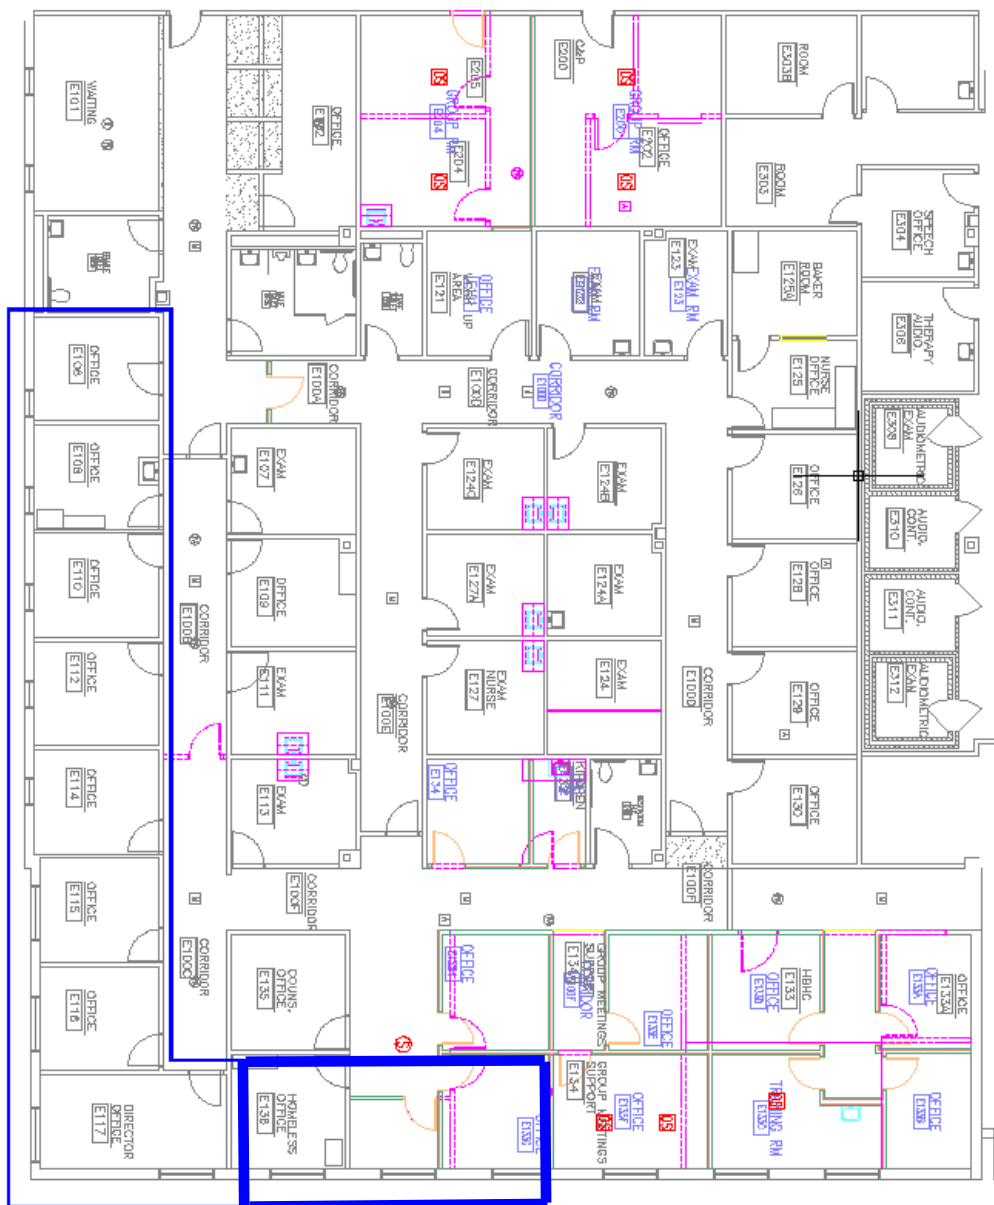


HVAC work above these spaces prior or during Phase 2A.

Attachment 2_RFI-4 Reply_675-
CSI-150_Rev. Phase 2




PHASE 2C

PHASE 2C

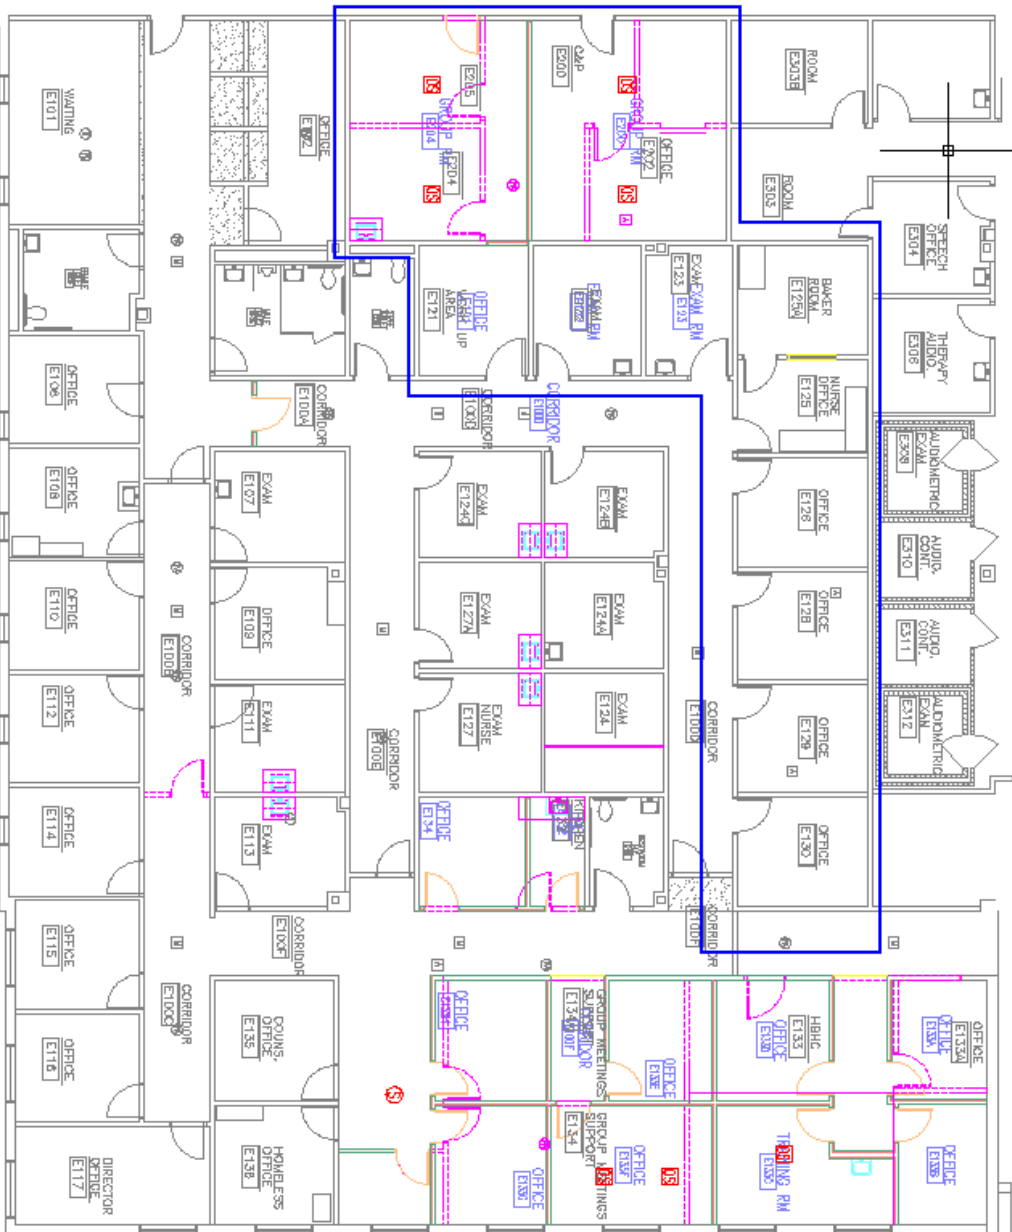

PHASE 2D

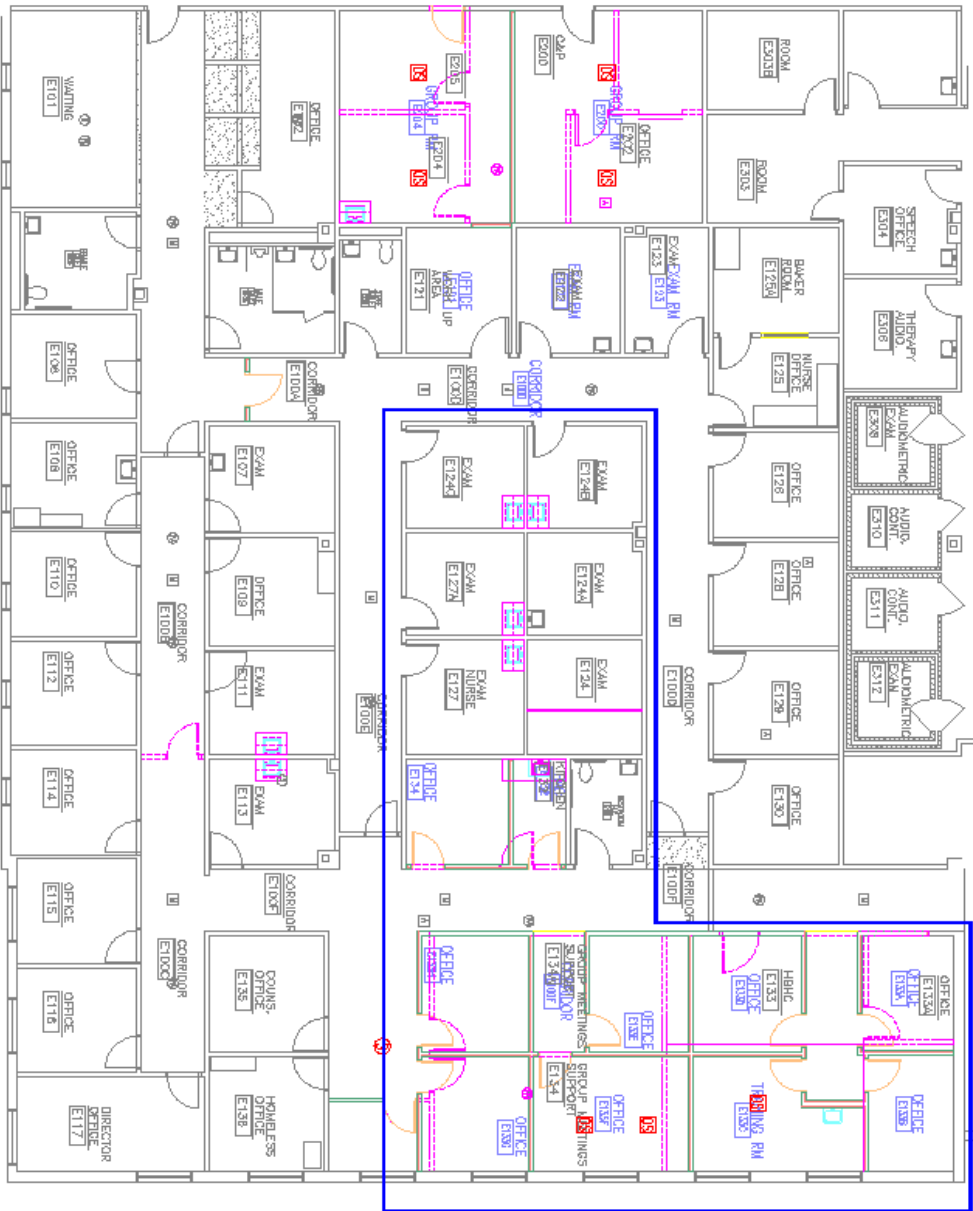

PHASE 2D

No issues with HVAC phasing.