VA248-16-R-0965 A00005

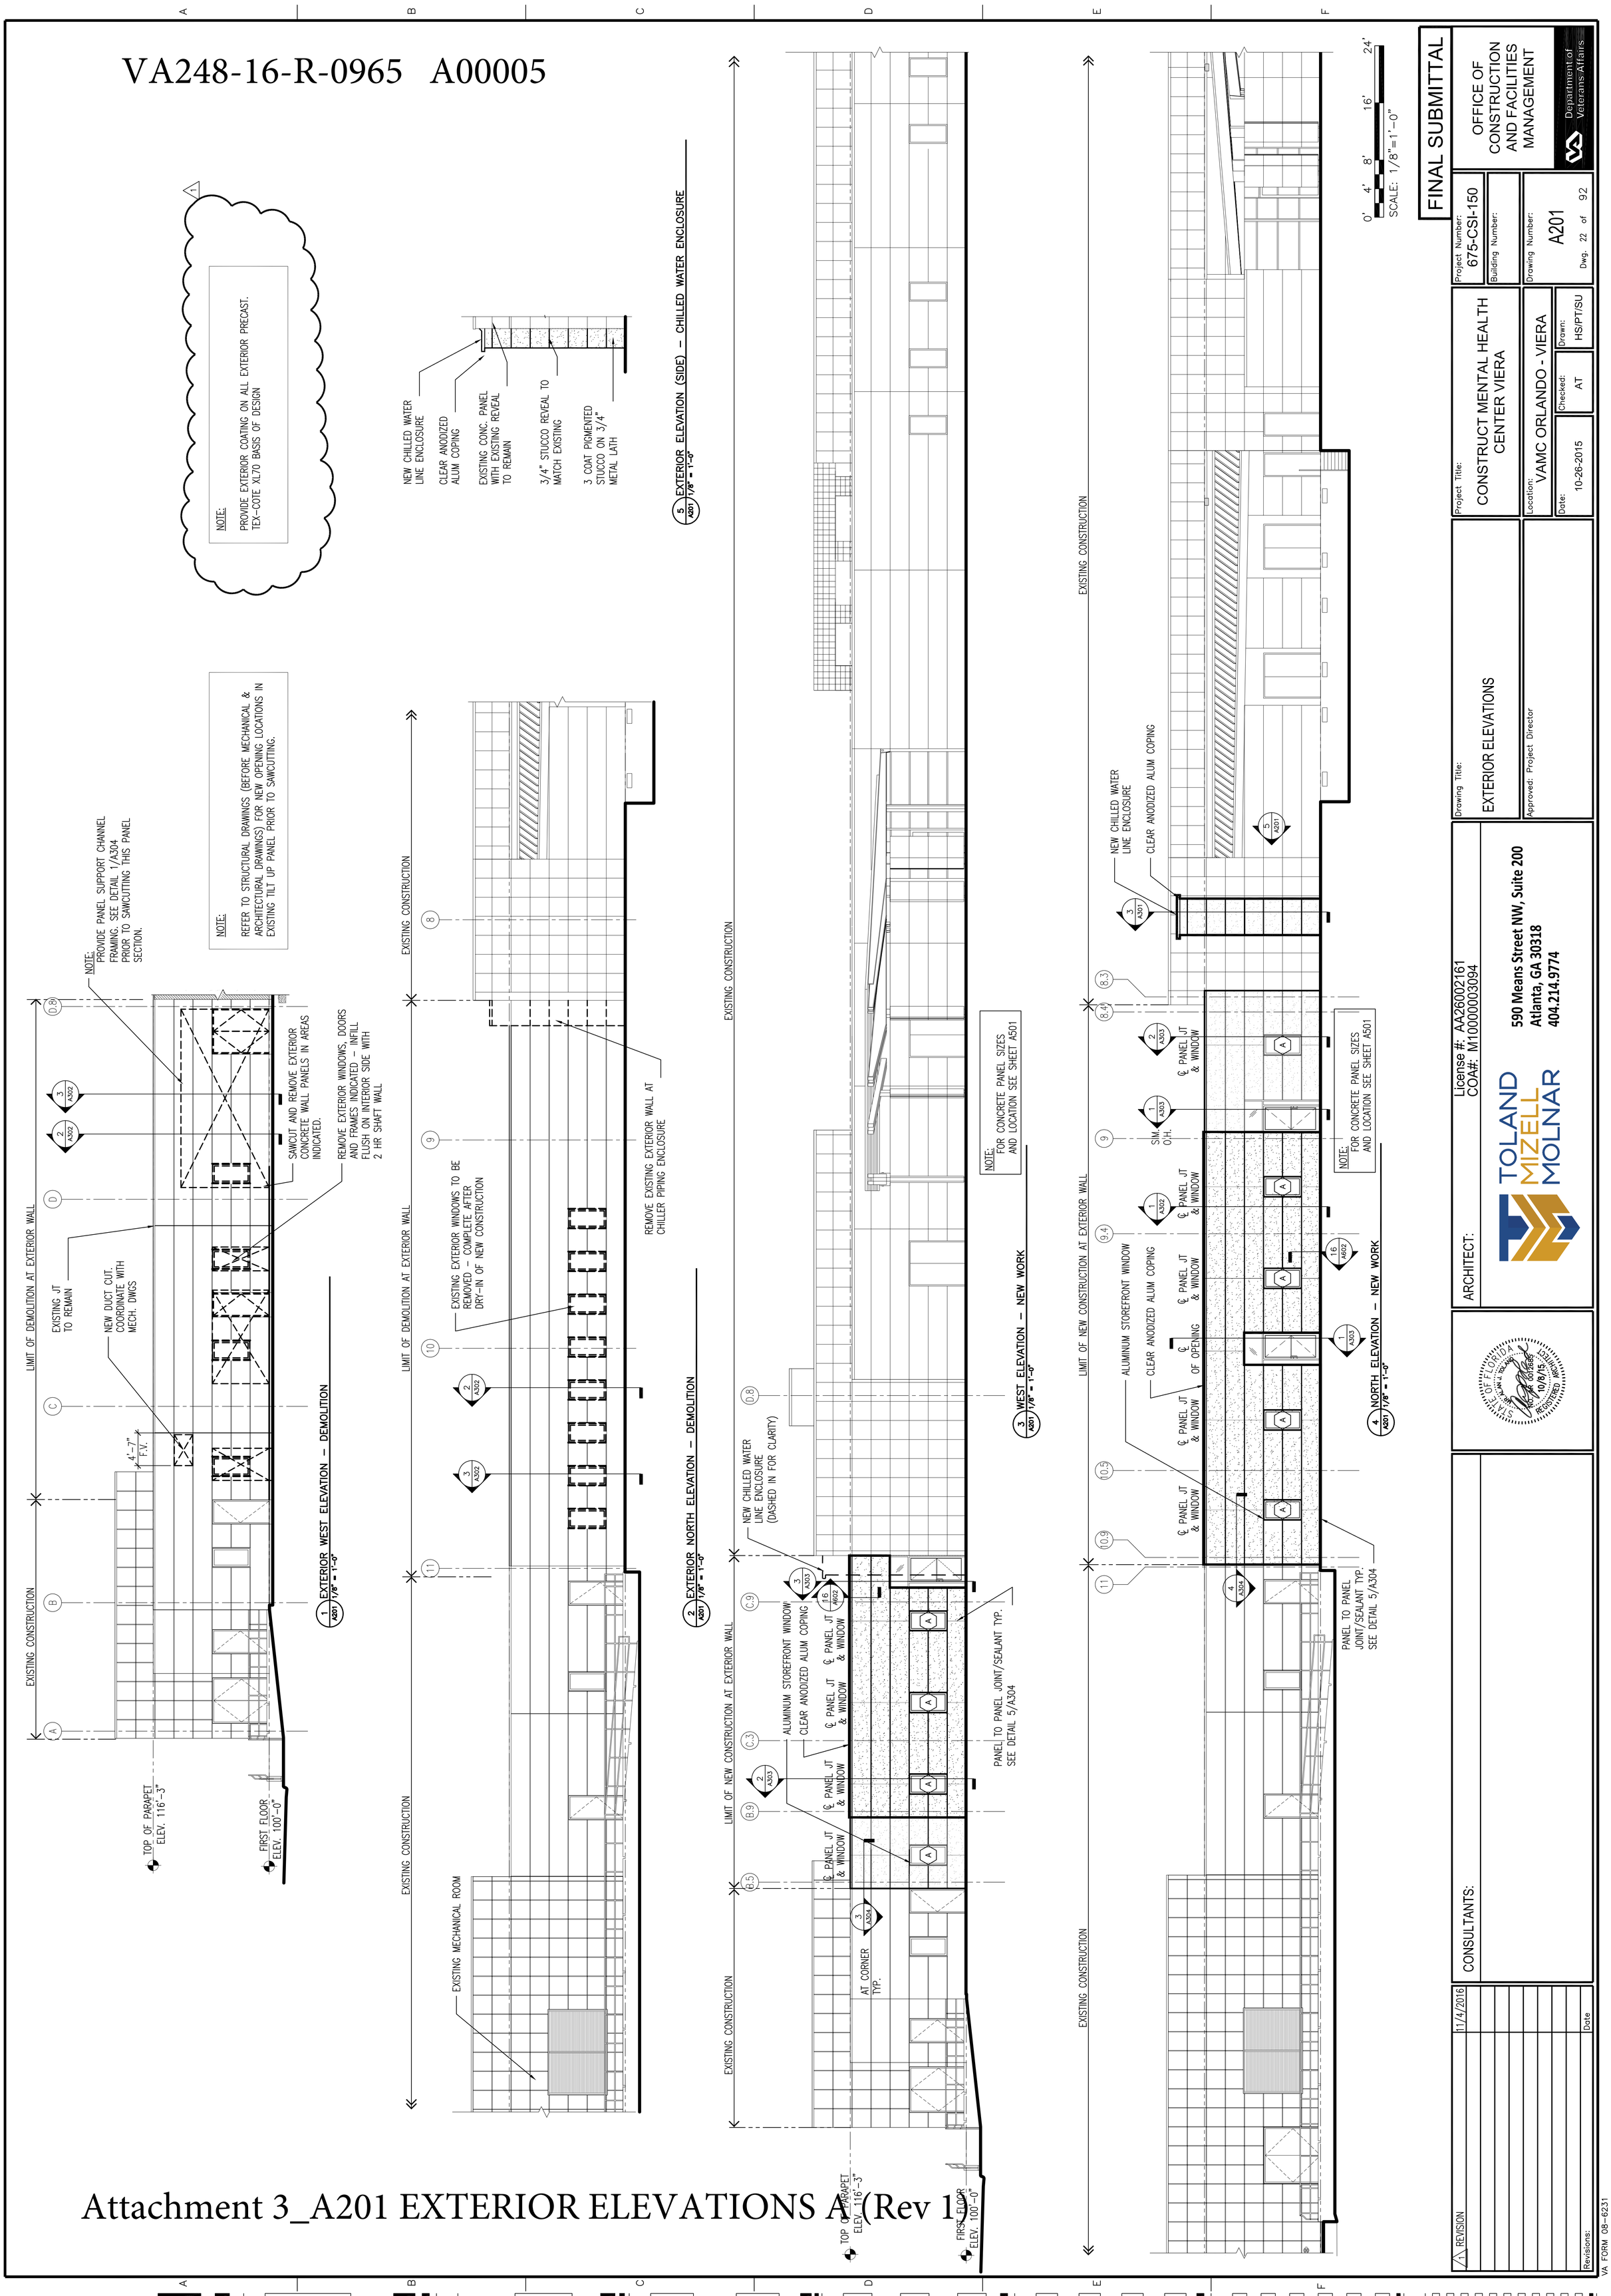

Attachment 3_A201 EXTERIOR ELEVATIONS A(Rev 1

Drawing File: T:\Projects\1501 Construct Mental Health Clinic Viera\3 1501 Drawings\Construct Mental Health Clinic Viera\Sheets\A201 EXTERIOR ELEVATIONS.dwg
Plotted by: mcunningham
Plotted Date: Nov 07, 2016 – 6:53am