Attachment 7_LP101 Landscaping Plan (Rev 1)

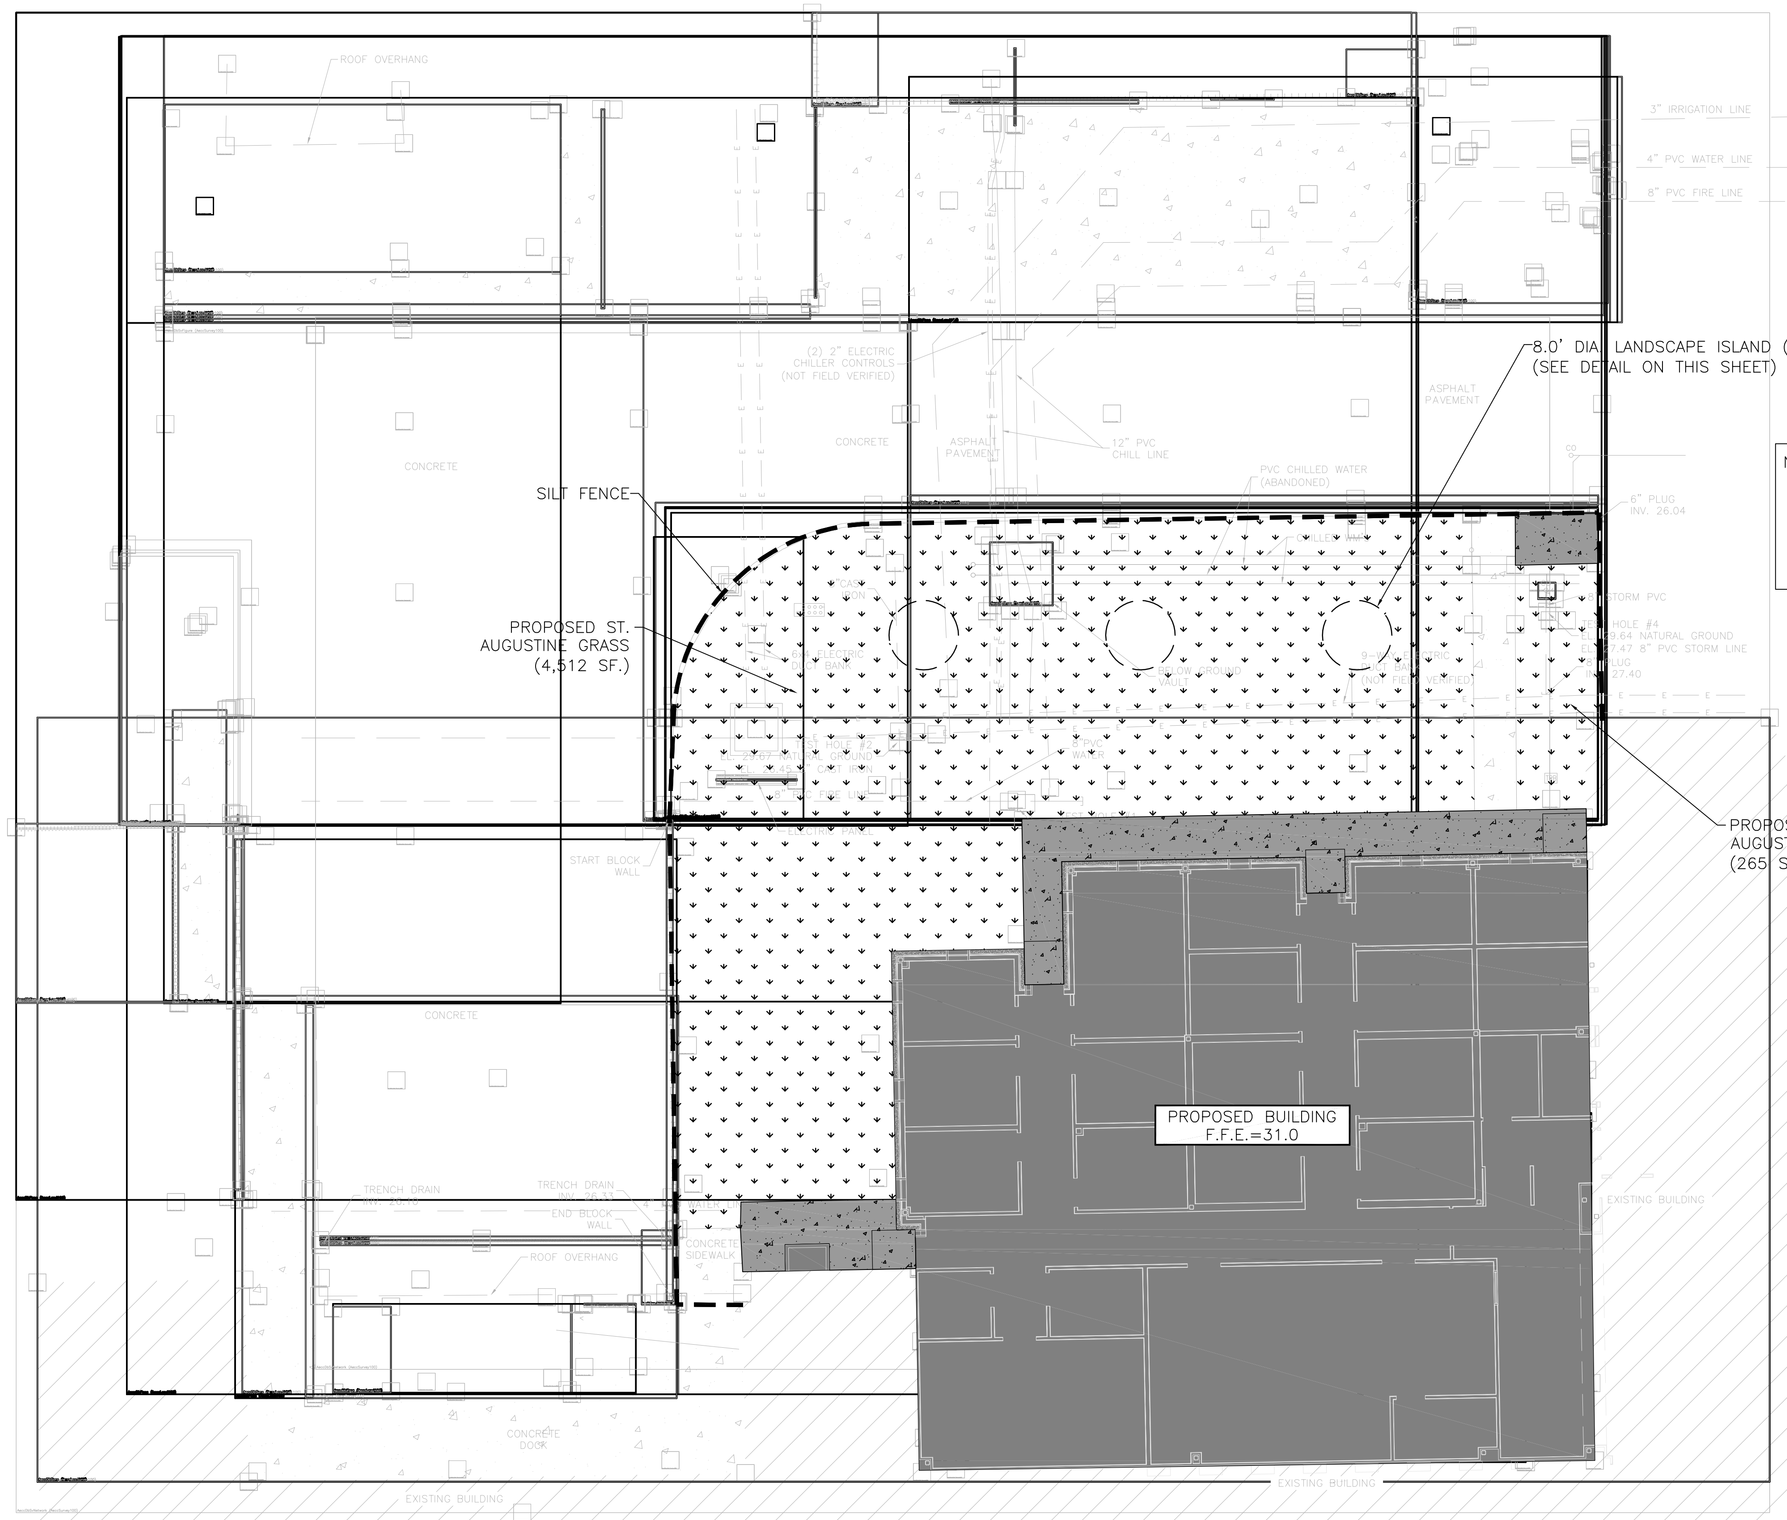

NOTE:

1. EXISTING IRRIGATION LINES AND SPRINKLERS UNDER FOOTPRINT OF PROPOSED BUILDING AND SIDEWALKS SHALL BE REMOVED AND CAPPED AS REQUIRED.

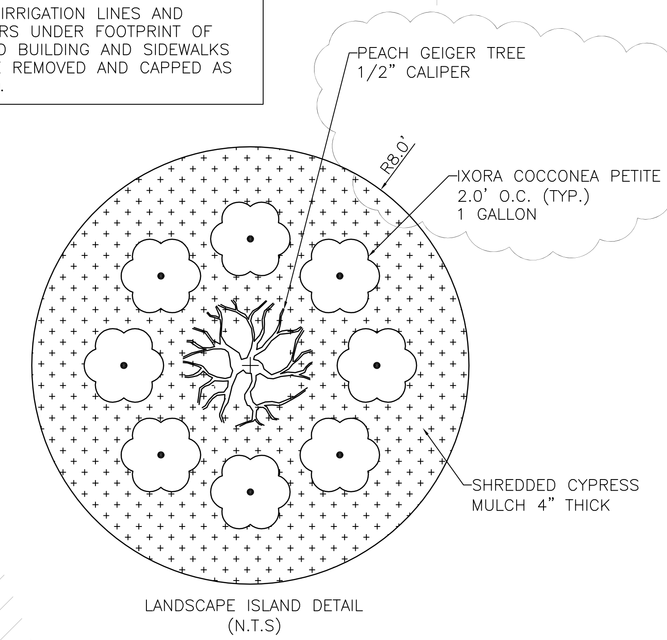

LANDSCAPE ISLAND DETAIL
(N.T.S)

VA248-16-R-0965 A00005

Drawing File: T:\Projects\1501 Construct Mental Health Clinic Viera\4 1501 Issued Submittals\REVISION No1 11-4-2016\675-CSI-105.LP101.dwg
Plotted by: mcunningham
Plotted Date: Nov 07, 2016 - 6:48am

REVISION	11/4/2016
Revisions:	Date

CONSULTANTS:

The Ash Group, Inc.
5802 Benjamin Center Drive, #101
Tampa, FL 33634 EB#6603
P: 813.290.8899 F: 813.290.8891
www.ash-grp.com
...Providing Solutions

ARCHITECT: License #: AA26002161
COA#: M10000003094

TOLAND MIZELL MOLNAR
590 Means Street NW, Suite 200
Atlanta, GA 30318
404.214.9774

Drawing Title: LANDSCAPING PLAN

Approved: Project Director

Project Title: CONSTRUCT MENTAL HEALTH CENTER VIERA

Location: VAMC ORLANDO

Date: 10-08-2015 | Checked: RIP | Drawn: AD

Project Number: 675-CSI-150

Building Number:

Drawing Number: LP101

Dwg. 10 of 92

FINAL SUBMITTAL

OFFICE OF CONSTRUCTION AND FACILITIES MANAGEMENT

Department of Veterans Affairs

VA FORM 08-6231