

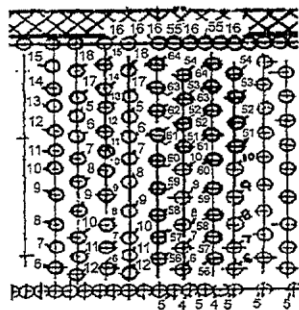
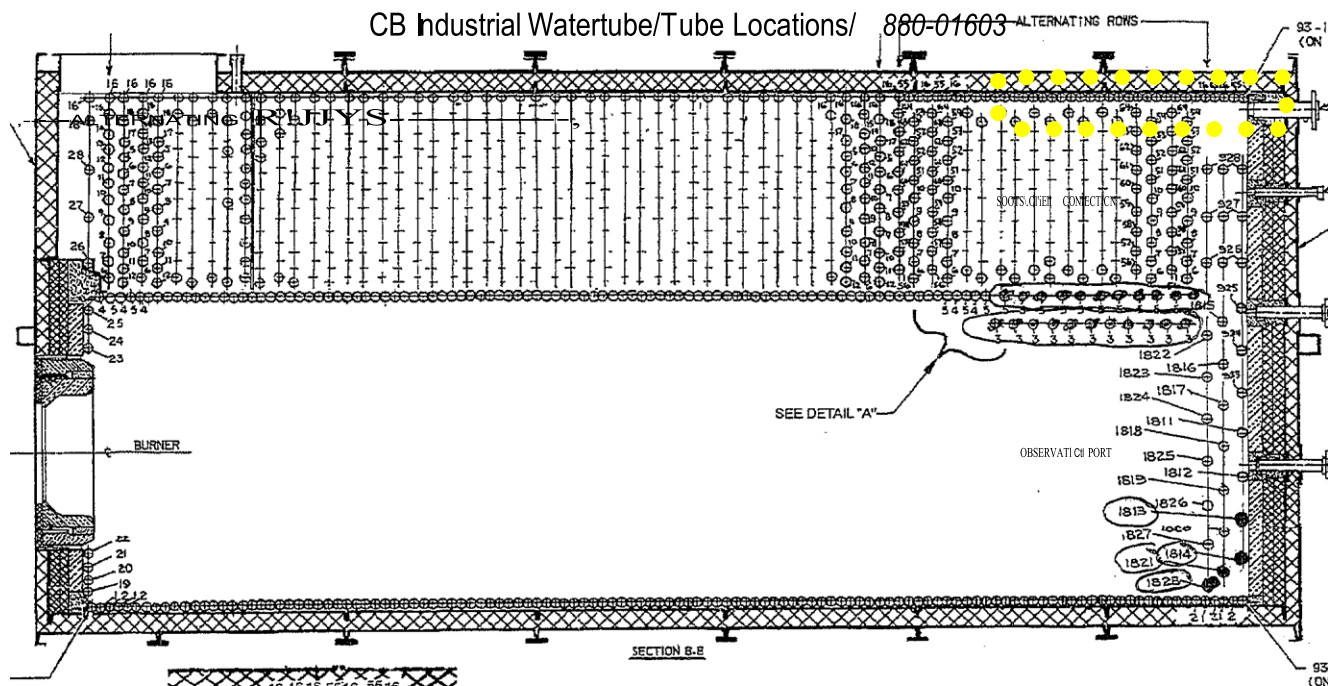


FRONT WALL

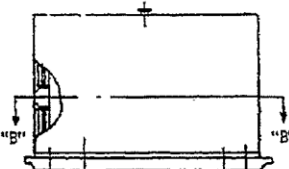

DETAIL "A"  
(ENLARGED VIEW)

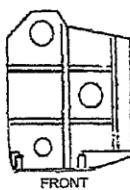

NOTE: PREFIX TO ALL TUBES IS "93A"  
FOR P/N OF TUBES ADD "900" TO  
MARK NUMBER.  
EX: MARK #8 IS 93A908  
MARK #27 IS 93A927

Cleaver Brooks, Inc.  
HOMASVILLE, GA.

TYPICAL TUBE LOCATION,  
DL-68 R.H. BOILER

ORWG. NO. 880-01603

(3 BANK REAR WALL)

DRWG. SCALE: NONE

SECTION KEY