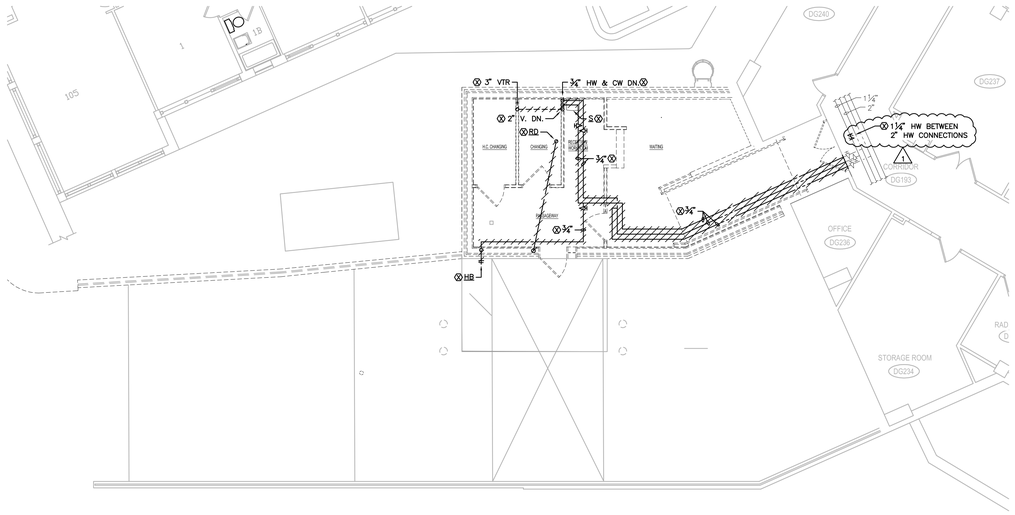

FIRST FLOOR
PLUMBING DEMOLITION PLAN - MRI
2 / P101 — 1/8"=1'-0"

NORTH

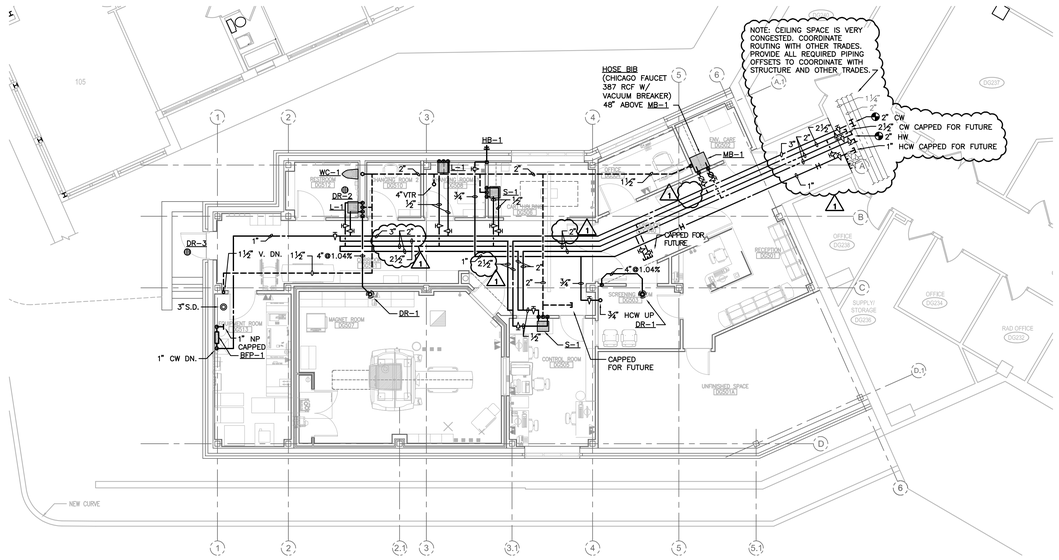

FIRST FLOOR
PLUMBING NEW WORK PLAN - MRI
1 / P101 — 1/8"=1'-0"

NORTH

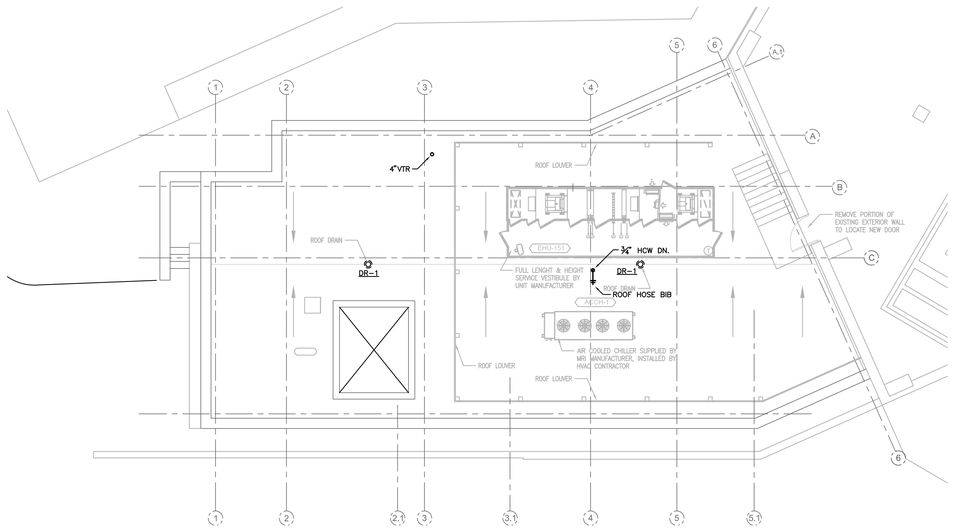

ROOF PLAN
PLUMBING NEW WORK PLAN - MRI
3 / P102 — 1/8"=1'-0"

NORTH

100% Construction Documents

Revisions	Date
1	11/02/2016

CONSULTANTS:

BWBR Architects, Inc.
1241 John Q. Hammons Drive
Suite 503
Madison, WI 53717

GRAEF
5126 W. Terrace Drive
Suite 111
Madison, WI 53718

The Concord Group
55 E. Monroe Street
Suite 2850
Chicago, IL 60603

Ring & DuChateau, LLP
17400 W. Capitol Drive
Brookfield, WI 53045

Environmental Management Consulting, Inc.
W7748 County Highway V
Lake Mills, WI 53551

ARCHITECT/ENGINEERS:

13100 watertown plank road
suite 200
elm grove, wi 53122

nagel architects

Nagel Architects Project Number: 151102

Drawing Title: PLUMBING FIRST FLOOR AND ROOF PLANS - MRI –
Approved Project Director: - - -
Project Title: CONSTRUCTION MRI SUITE
Location: William S. Middleton VA Hospital, Madison, WI
Date: 09/26/2016
Checked: DH
Drawn: DJS
Project Number: 607-CSI-104
Building Number: BLDG 1, New Addition
Drawing Number: P101
Dwg. 64 of 89

Office of Construction and Facilities Management

Department of Veterans Affairs

VA FORM 08-6231

ACCOMPANYING AMENDMENT - VA69D-16-B-1310 A00003