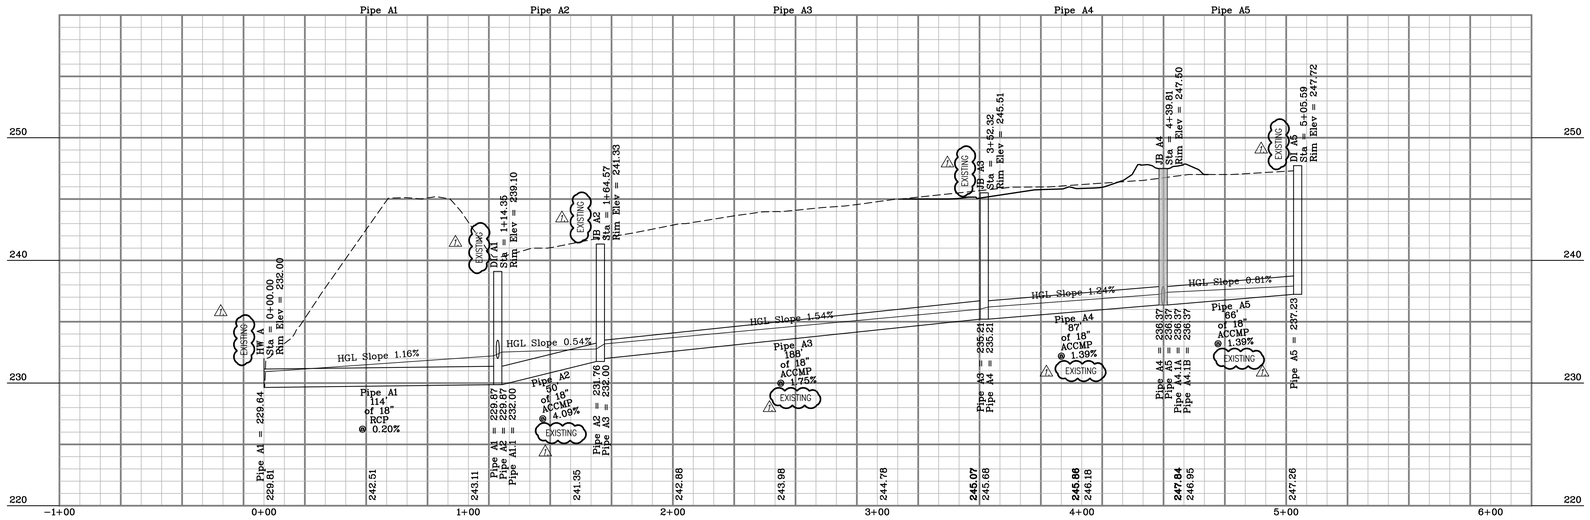

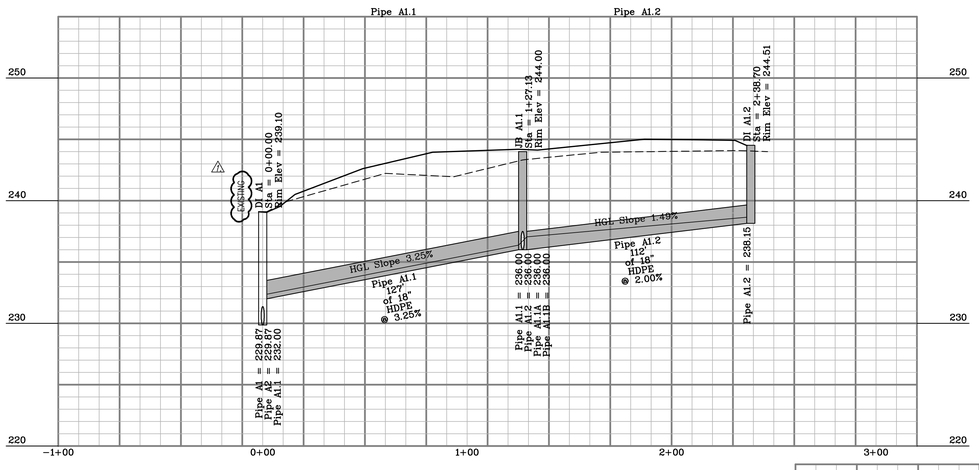

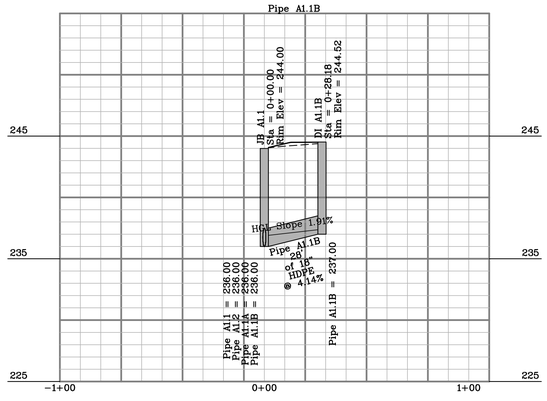

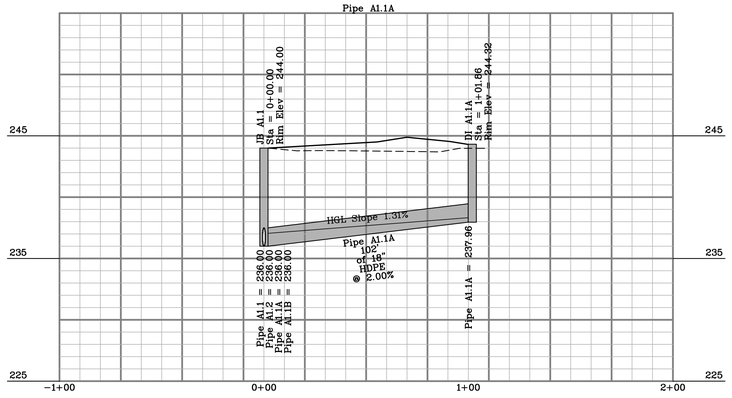

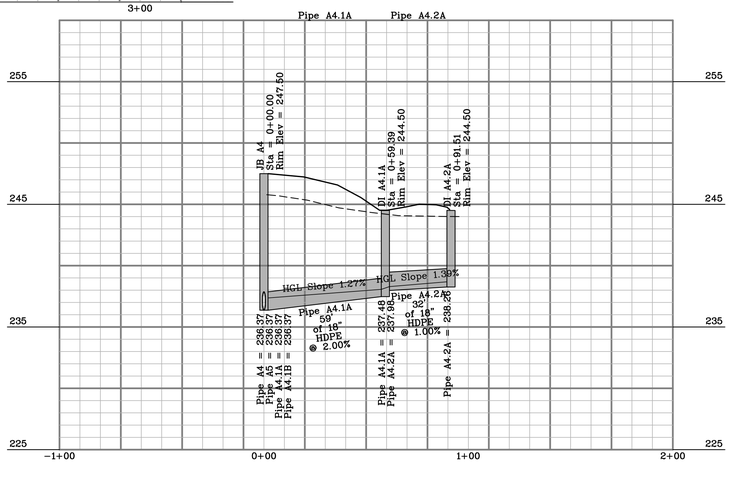

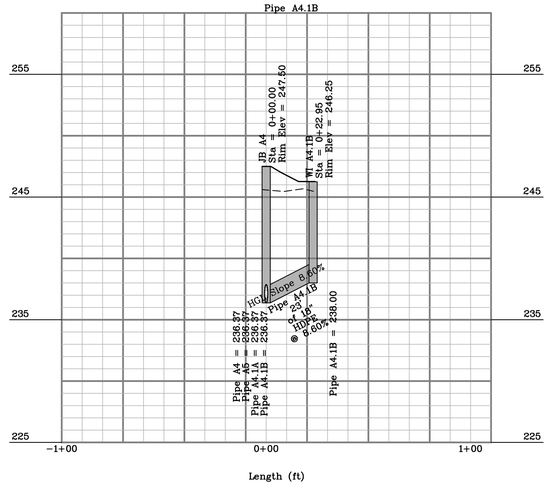

SHEET NOTES

1. NEW PIPES AND STRUCTURES ARE SHADED ⚠

GENERAL NOTES

A. EXISTING CONDITIONS ARE FROM A COMBINATION OF GROUND RUN SURVEY INFORMATION AND INFORMATION FROM THE DESIGN OF THE ADJACENT WELLNESS CENTER PROJECT AS PROVIDED BY THE CLIENT.
B. UTILITY LOCATIONS ARE APPROXIMATE AS PER UTILITY LOCATE AND GROUND RUN SURVEY INFORMATION AND IS SHOWN FOR COORDINATION PURPOSES ONLY. PHYSICAL LOCATION OF EXISTING UTILITIES NEEDS TO BE VERIFIED BY THE CONTRACTOR IN THE FIELD.
C. LOCATION OF PROPOSED WELLNESS CENTER FROM INFORMATION PROVIDED BY THE CLIENT

LEGEND

REFER TO SHEET CI101 FOR LEGEND INFORMATION AND ABBREVAITONS

CG102 STORM DRAIN PROFILES

1" = 30'

NORTH

REVISION NO.	REVISION DESCRIPTION		
1	CLARIFIED EXISTING STORM DRAINS	JMS	03/13/12

Revisions | By | Date

Department of Veterans Affairs
Medical Center
1826 Veterans Blvd.
Dublin, Ga. 31021

SEAL
GEORGIA REGISTERED PROFESSIONAL ENGINEER JASON MARK SMITH
GASWCC LEVEL II DESIGN PROFESSIONAL NO. 0000002492

JMSmith ENGINEERING, LLC
155 CLARKESVILLE STREET
CORNELIA, GEORGIA 30531
TEL (678) 267-3690
LOCAL (706) 894-2331
FAX (678) 267-3731
www.jmsmithengineering.com

Recommended Approvals:	
1. MEDICAL DIRECTOR	6. OPERATIONS SERVICE LINE
2. ASSOCIATE DIRECTOR	7. INFECTION CONTROL
3. CHIEF OF STAFF	8. SAFETY MANAGER
4. ASSOC. DIRECTOR	9. GENERAL ENGINEER
5. SERVICE LINE MGRS.	10. COTR

Drawing Title: STORM DRAIN PROFILES
Project Title: VA HOSPICE CARE UNIT
Submittal: CONSTRUCTION DOCUMENTS (100%)
Job Number: 2009-050-01
Drawn: JMS | Building Number: 86 | AutoCAD File Name: 557.375.86.CG102
Checked: JMS | Reviewed: JMS | Const. Contract
Date: 07/14/2010
Project Number: 557-CSI-375
DRAWING No. CG102
Dwg. X Of XX

Veterans Affairs

Matrix Architects
249 Wayne Avenue, Dayton, Ohio 45402
Telephone:(937) 224-7700 Fax:(937) 224-7125
Matrix Project No. 09104
Consultant

VA FORM 08-6231, JUN 1992