

- NOTES:
1. VERIFY DIMENSIONS IN FIELD PRIOR TO INSTALLATION.
 2. ELECTRICAL EQUIPMENT NOT TO SCALE.
 3. REFER TO SHEET E-203 FOR CONDUIT SCHEDULE.
 4. X AT 3 MODULE LOCATIONS INDICATES THAT NO PV MODULE IS INSTALLED AT THIS LOCATION.
 5. THE TWO SPURS IN THIS LOCATION WILL BE CUT OFF 6" OUTBOARD OF THE TILT BRACKET TO INCREASE CLEARANCE AROUND VENTILATOR.

- NOTE:**
FREE STANDING GUARD-
RAIL SYSTEM TO BE
INSTALLED ALONG THE
PERIMETER
- ROOF HATCH GUARDRAIL:**
1. SHALL BE BY KEE SAFETY
OR EQUIVALENT.
2. SHALL COMPLY W/ OSHA
29 CFR 1910.23 & 29 CFR
1910.56
3. GATE SHALL HAVE SPRING
HINGES.
4. SUBMIT PRODUCT DATA &
SHOP DRAWINGS.
5. COMPLY W/ SPECIFICATIONS

C	CONSTRUCTION SET	THB	JLC	11.10.10
B	100% SUBMITTAL	THB	JLC	10.13.10
A	50% SUBMITTAL	THB	JLC	08.02.10
REV	DESCRIPTION	BY	CHK	DATE


SunWize
1155 Flatbush Rd., Kingston, NY 12401
Tel: 845-336-0146 Fax: 845-336-0457
WWW.SUNWIZE.COM
THIS DRAWING IS THE CONFIDENTIAL
PROPERTY OF SUNWIZE TECHNOLOGIES

PROJECT NAME:
SAMUEL S. STRATTON VAMC

PROJECT / CUSTOMER INFORMATION:
SAMUEL S. STRATTON VAMC
113 HOLLAND AVENUE
ALBANY, NY 12208
PHONE: 518-626-5500

SHEET TITLE:
ROOF AND EQUIPMENT LAYOUT

PROJECT NUMBER: **52818-12-0415L**
DRAWING NUMBER: **000-000-000-000-0000**
PAPER SIZE: **ARCHITECTURAL (36"X48")**
SHEET NO:
A-200

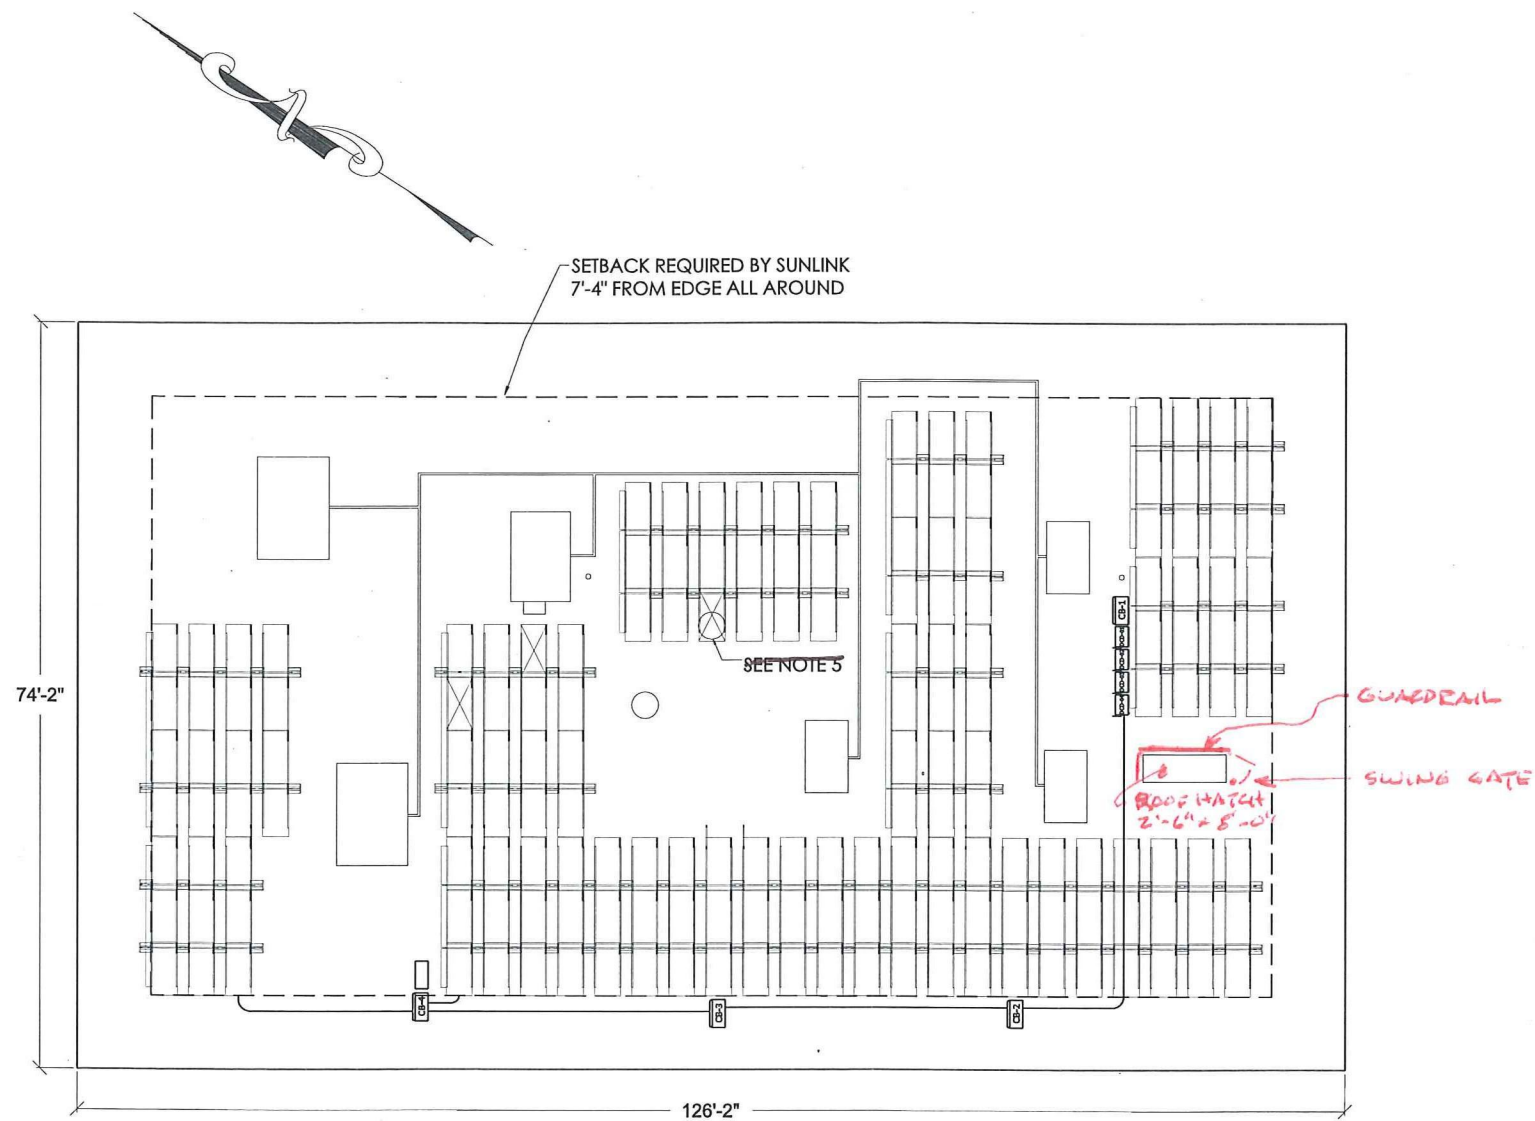

1 ROOF, PV ARRAY AND EQUIPMENT LAYOUT
PLAN VIEW - SCALE: 1/8" = 1'-0"