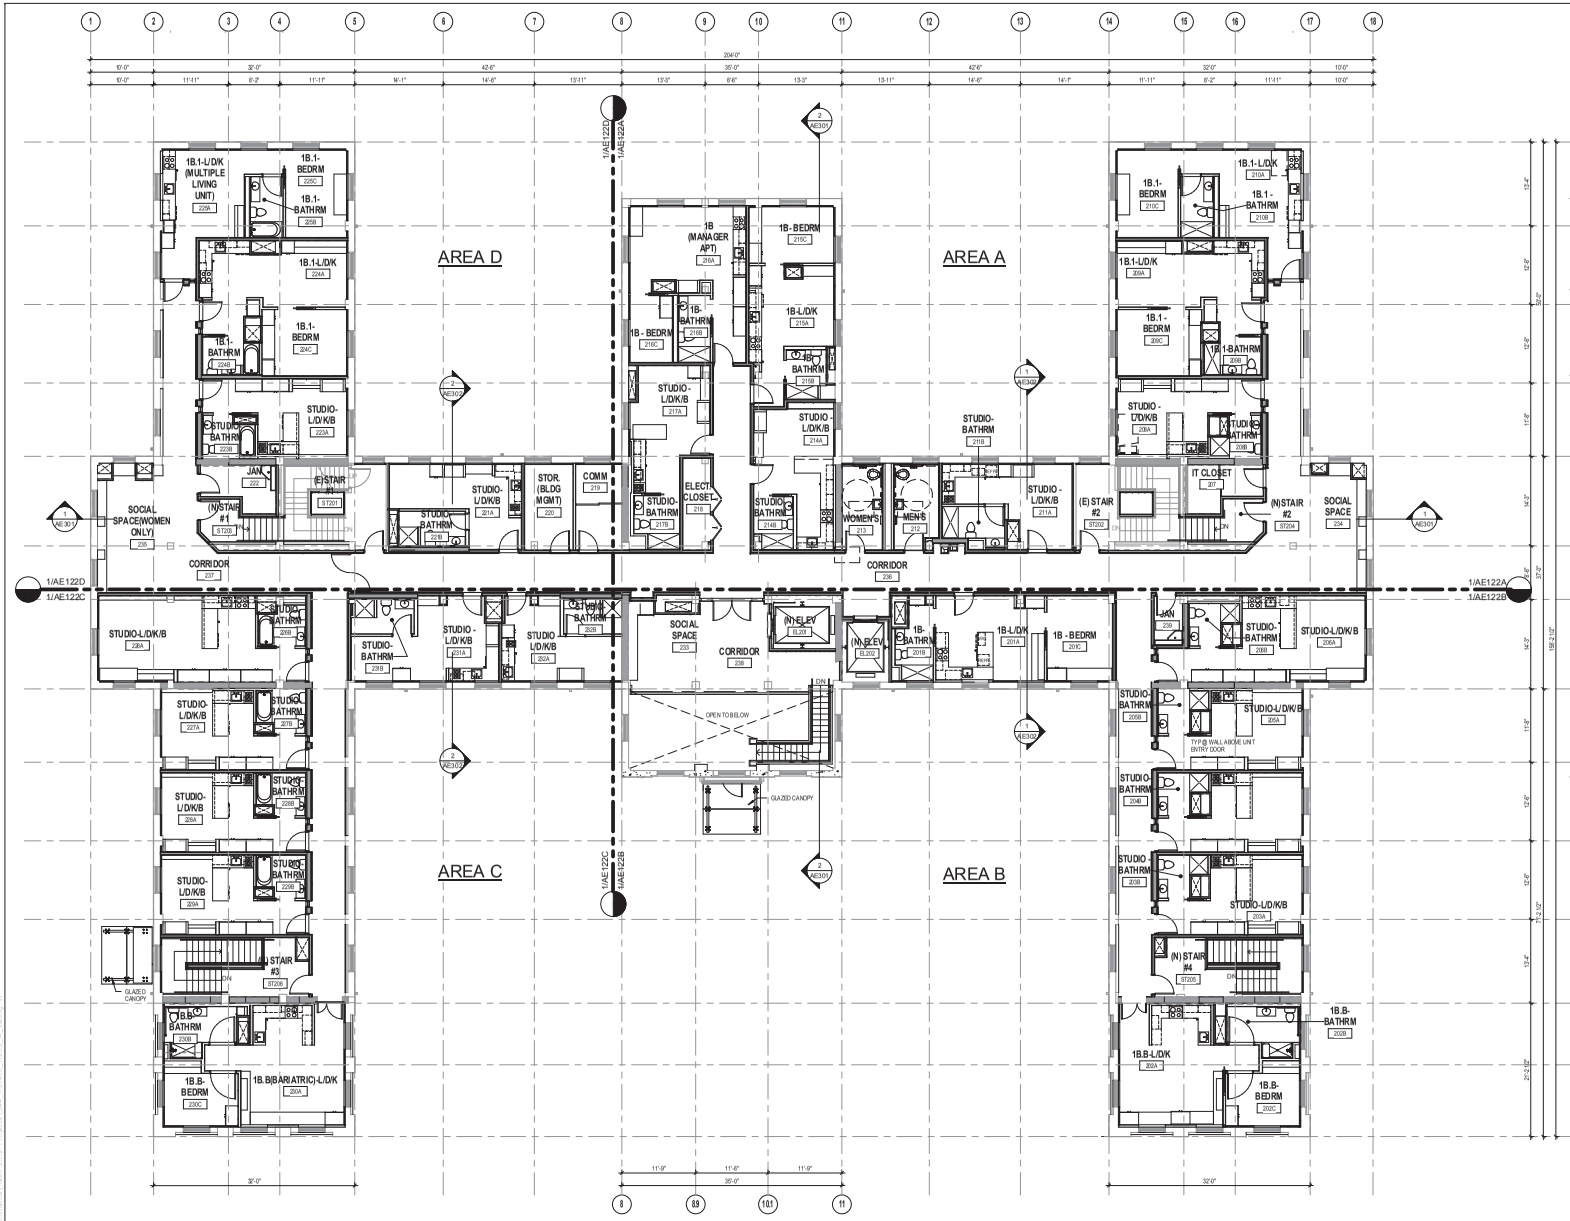

1 SECOND FLOOR PLAN
SCALE: 1/8"=1'-0"

SHEET NOTES - FLOOR PLAN

#	NOTE
1	ALL DIMENSIONS ARE FROM FACE OF WALL FINISH UNLESS OTHERWISE NOTED.
2	LOCATE ALL DOORS FRAMES WITH FACE OF JAMB 4" AWAY FROM ADJACENT WALL UNLESS OTHERWISE NOTED.
3	SEE ENLARGED PLANS AND SHEET AE650 AND A651 FOR WALL TYPES
4	SEE SHEET AE601 FOR DOOR SCHEDULE
5	SEE SHEET AE602 FOR WINDOW SCHEDULE
6	SEE SHEET G002 FOR ARCHITECTURAL SYMBOLS AND ABBREVIATIONS
7	SEE SHEETS AF SERIES FOR FINISH PLANS AND ROOM & MATERIAL SHEDULES
9	SEE STRUCTURAL DRAWINGS FOR STRUCTURAL REINFORCEMENT AND NEW CONCRETE WALL INFILL.
10	PROVIDE TOPPING SLAB INFILL AND/OR LEVELING COMPOUND TO CREATE A LEVEL SMOOTH SURFACE PRIOR TO NEW PARTITION AND FLOOR FINISH INSTALLTION TO APPROX THICKNESS OF 1" FROM TOP OF EXISTING STRUCTURAL SLAB. REMOVAL OF EXISTING PARTITIONS AND FINISHED WILL UNCOVER VARIOUS EXISTING CONCRETE TOPPING SLAB CONDITIONS.

LEGEND - FLOOR PLAN

EXISTING CONSTRUCTION TO REMAIN IN PLACE, PROTECT DURING CONSTRUCTION

NEW CONSTRUCTION

PROTECT AREA DURING CONSTRUCTION

1 HOUR FIRE-RATED WALL SYSTEM

KEYNOTE LEGEND

KEYNOTE	DESCRIPTION

PROGRAM SUMMARY

FUNCTIONAL AREA	TOTAL NET AREA (SF)		TOTAL GROSS AREA (SF)	
	PROGRAMMED	ASSIGNED	PROGRAMMED	ASSIGNED
CORPORATE AREA: ADMINISTRATION	3,010	3,133	4,666	4,792
SERVICE AND SOCIAL AREA	1,120	1,89(ADD 4 SOCIAL SPACES)	1,736	3,618
RESIDENT MULTIPURPOSE AREA	1,680	2,754 (MULTIPURPOSE ROOM @ 1ST FLOOR)	2,527	2,676
RECEPTION AREA	1,340	2,076	2,077	2,178
LIVING UNITS (INCLUDE RESIDENT MANAGER APARTMENTS AND RESIDENT ROOMS)	22,000	20,074	34,100	38,059
TOTAL	29,100	29,931	45,106	51,523
D/NTG FACTOR			PROGRAMMED	ASSIGNED
			1.55	1.72

LIVING UNITS	BASEMENT FLOOR		1ST / 2ND FLOOR		TOTAL	
	PROGRAMMED NO. OF UNITS	ASSIGNED NO. OF UNITS	PROGRAMMED NO. OF UNITS	ASSIGNED NO. OF UNITS	PROGRAMMED NO. OF UNITS	ASSIGNED NO. OF UNITS
RESIDENT MANAGER APARTMENTS	0	0	2 (1@ EACH FLOOR)	2 (1@ EACH FLOOR)	2	2
STUDIO	6	6	28	26 (10 @1ST FLOOR AND 16 @2ND FLOOR)	34	32
1B (ONE BEDROOM)	4	3	6	4 (2@ EACH FLOOR)	10	7
1B.B (BARIATRIC ONE BEDROOM)	0	0	4	4 (2@ EACH FLOOR)	4	4
1B.1 (MULTIPLE LIVING UNIT)	0	2	12	8 (4@ EACH FLOOR)	12	10
TOTAL	10	11	52	44	62	55

NOTE: ACCESSIBLE RESIDENTAIL UNITS INCLUDE 002, 011, 102, 129, 202 & 230 SERIES ROOMS.

FULLY SPRINKLERED

Revisions:	Date
AS-BUILT RECORD DRAWINGS	07/10/15
FOR CONSTRUCTION	08/07/12

CONSULTANTS:

LICENSED ARCHITECT NICOS A. KATSELLIS RCE NO. C29800 REN. 04-30-13 STATE OF CALIFORNIA

ARCHITECT/ENGINEERS:

LEO A DALY
27th Floor, 550 South Hope Street
Los Angeles, CA 90071 USA
Tel 213-629-0100 Fax 213-629-0070

Drawing Title: PROPOSED FLOOR PLAN - SECOND FLOOR LEVEL

Approved: Project Director

Project Title: VA GLA HEALTHCARE SYSTEM WEST LA MEDICAL CENTER SEISMIC CORRECTIONS

Location: LOS ANGELES, CA 90073

Date: 07/10/2015 | Checked: AA | Drawn: TP

Project Number: 691-406

Building Number: 209

Drawing Number: AE102

Dwg. of

Office of Construction and Facilities Management

VA FORM 08-6231