



2 7TH FLOOR PARTIAL EQUIPMENT PLAN - PHASE 4
1/4" = 1'-0"

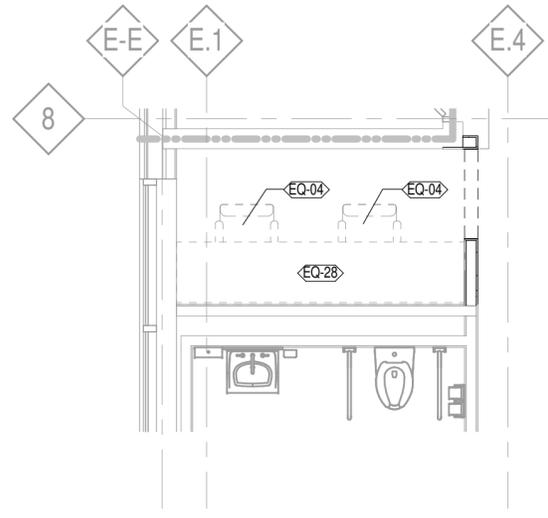


1 7TH FLOOR PARTIAL EQUIPMENT PLAN - PHASE 4
1/4" = 1'-0"

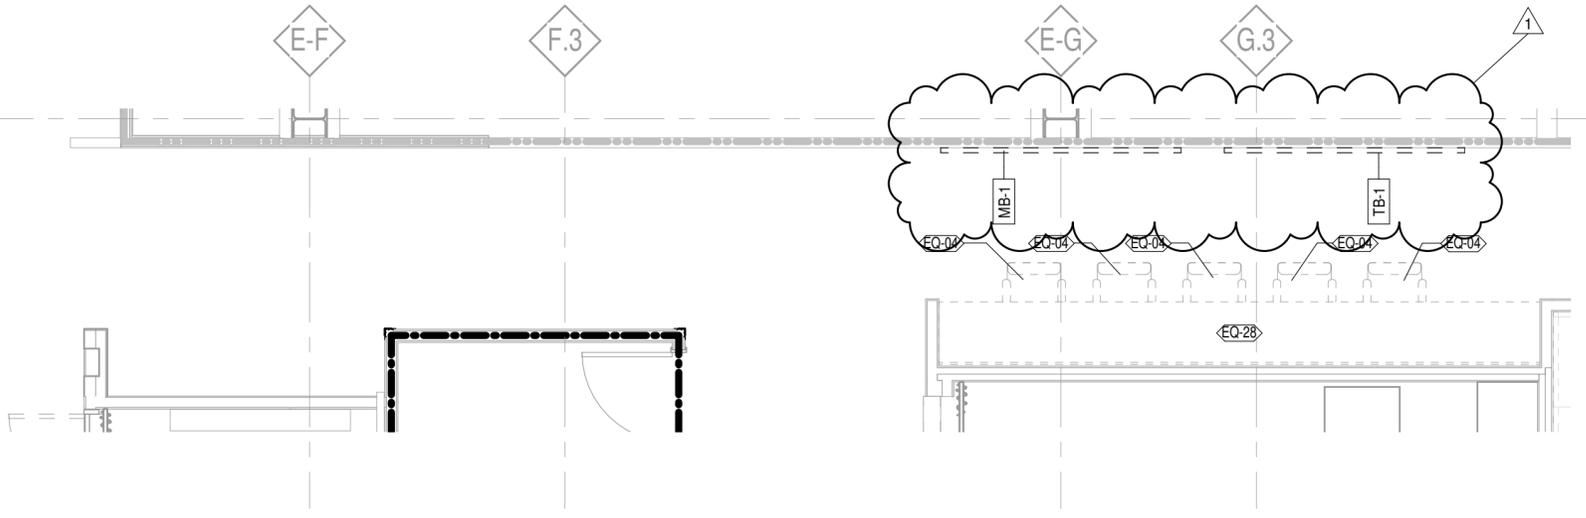

4 7TH FLOOR PARTIAL EQUIPMENT PLAN - PHASE 4B
1/4" = 1'-0"

3 7TH FLOOR PARTIAL EQUIPMENT PLAN - PHASE 4
1/4" = 1'-0"

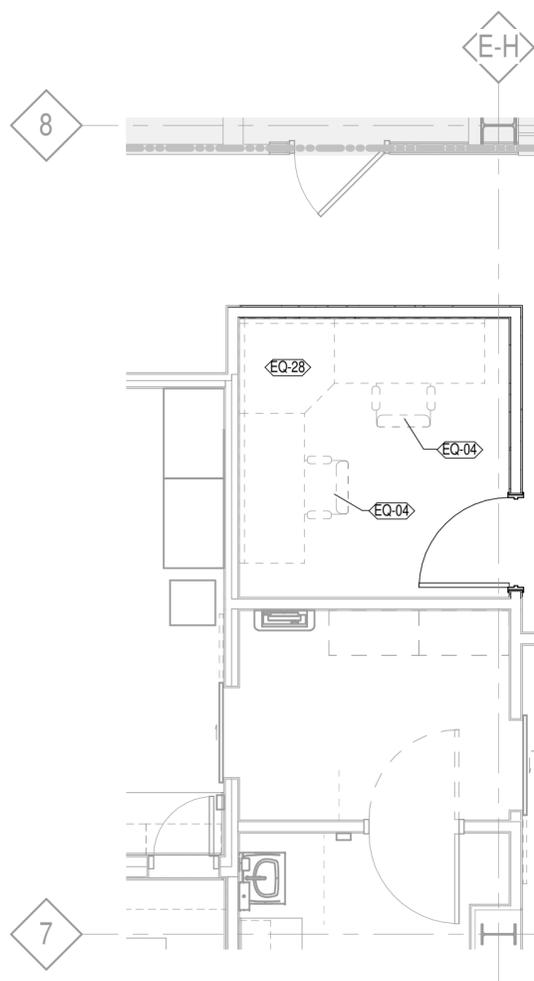

1

2

3

4

5