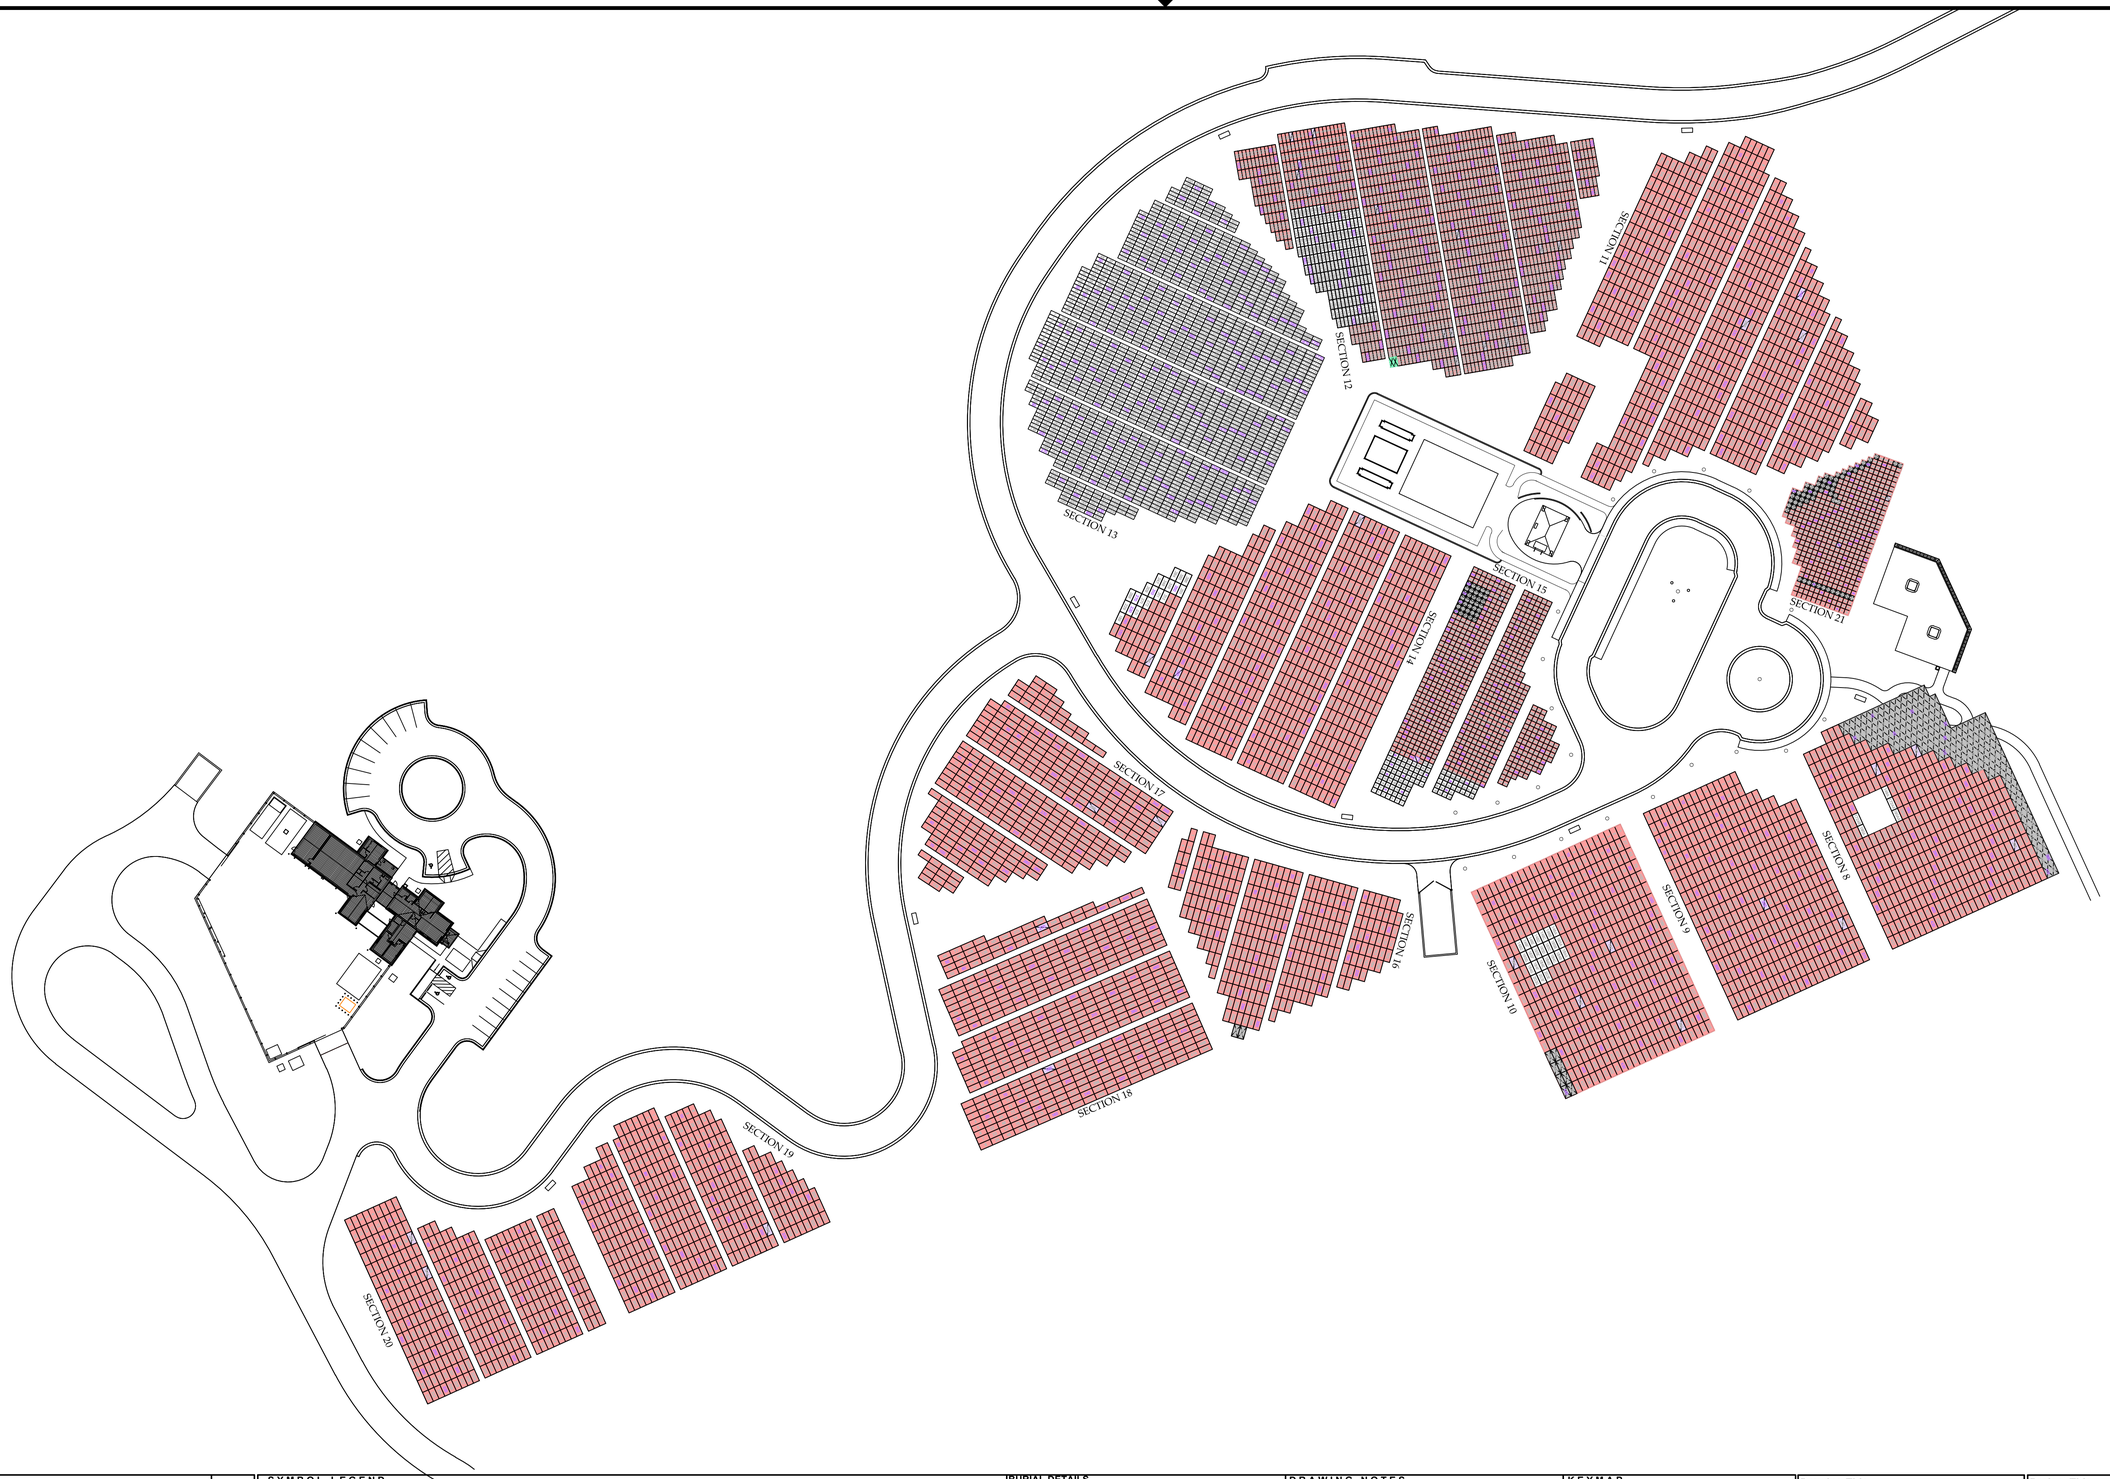

0 60' 120'

SCALE - 1"= 60'

one inch = two hundred feet (400, 200, 0, 200, 400)

one inch = one hundred feet (200, 100, 0, 100, 200)

one inch = sixty feet (120, 60, 0, 60, 120)

one inch = fifty feet (100, 50, 0, 50, 100)

one inch = forty feet (80, 40, 0, 40, 80)

one inch = thirty feet (60, 30, 0, 30, 60)

one inch = twenty feet (40, 20, 0, 20, 40)

one inch = ten feet (20, 10, 0, 10, 20)

Revisions	Date

SYMBOL LEGEND

AVAILABLE GRAVESITE W/NUMBER	
RESERVED GRAVESITE W/NUMBER	
OCCUPIED GRAVESITE W/NUMBER	
FULLY OBSTRUCTED GRAVESITE W/NUMBER	
OCCUPIED PARTIALLY OBSTRUCTED GRAVESITE W/NUMBER	
AVAILABLE PARTIALLY OBSTRUCTED GRAVESITE W/NUMBER (FULL CASKET SITE AVAILABLE FOR CREMAINS ONLY)	
ROW | GRAVESITE NUMBER	00/00

CONTROL MARKER	
EXISTING STRUCTURE WITH CLASSIFICATION NUMBER	BLDG 0000
HEADSTONE OR NUMBER ARE UNREADABLE	NR
PAVED ROAD W/CURB & GUTTER (C & G SHOWN BOTH SIDES)	
UNIMPROVED DIRT/GRAVEL ROAD	
METAL PICKET FENCE	
CHAIN LINK FABRIC FENCE	
PROPERTY BOUNDARY LINE	
OVERHEAD ELECTRIC LINE AND POWER POLE	
UNDERGROUND ELECTRIC LINE	
SANITARY SEWER LINE	
STORM DRAIN LINE	
IRRIGATION LINE	
WATER LINE	

BURIAL DETAILS

DRAWING NOTES

1. SHADING SHOWN IN A GRAVESITE INDICATES OCCUPIED STATUS, SUPERSEDING ANY OTHER MARKING THERIN.
2. GRAVESITE STATUS HAS BEEN POSTED ON THIS LAYOUT PLAN THROUGH
3. DRAWING SCALE IS ACCURATE ONLY ON FULL-SIZE (30-INCH HIGH BY 42-INCH WIDE) COPIES OF THIS DRAWING.
4. (*) THIS SPACE DOES NOT INDICATE AN AVAILABE GRAVE SITE IT IS DESIGNATED AS AN OPEN AREA AND IT IS SHOWN TO FACILITATE A GRAPHICALY ACCURATE REPRESENTATION OF THIS CEMETERY SECTION BY MAINTAINING THE PLACEMENT OF THE CORRECT ADJACENCIES.

KEYMAP

Drawing Title: 876 SALISBURY NATIONAL CEMETERY ANNEX	Project Title: GRAVESITE LAYOUT PLAN		Date: 06/27/16
			Project No.: -
Approved: Division Chief	Building No.	Checked	Drawn
Approved: Service Director	Location: SALISBURY, NC		DRAWING NO.: 876 ANNEX ALL SECTIONS REFLAYERS

Veterans Administration