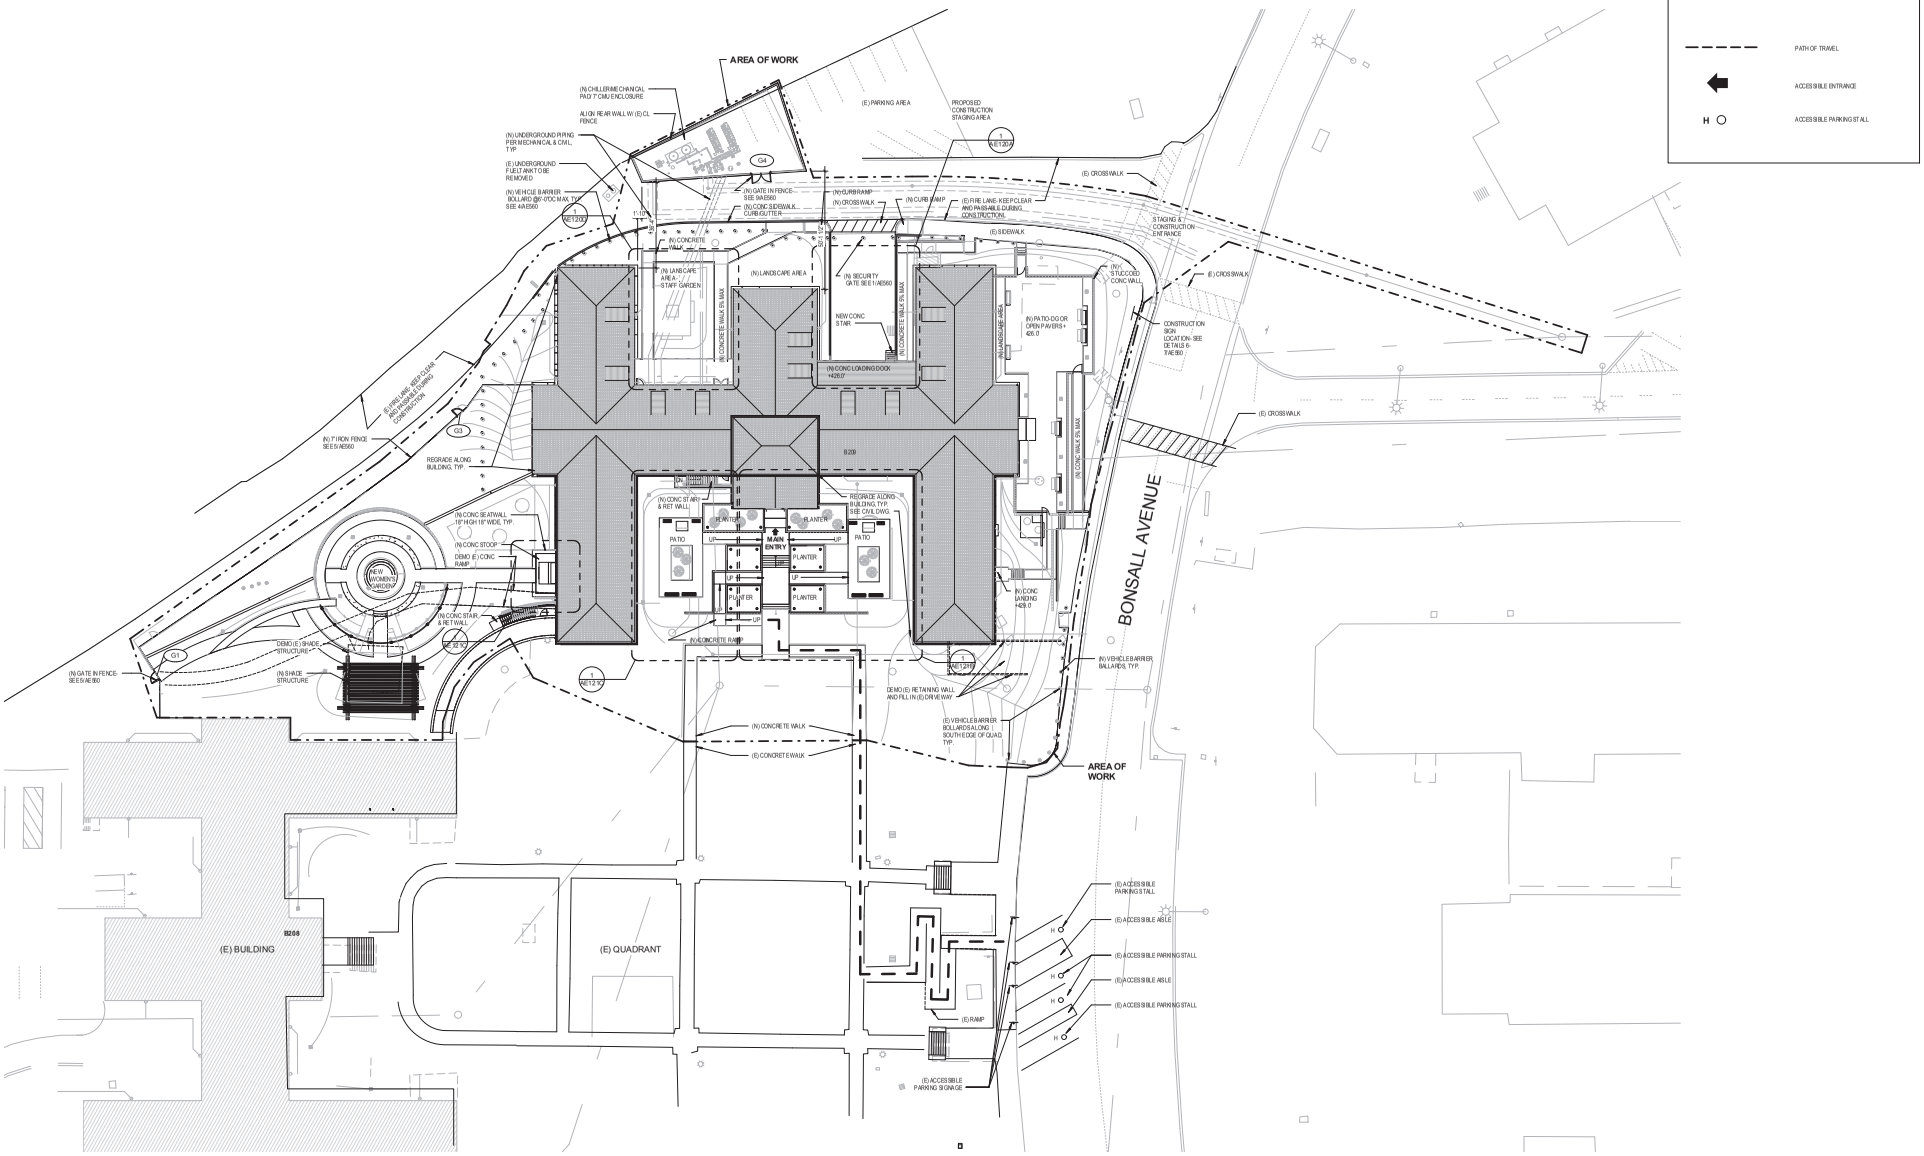

1 OVERALL SITE PLAN
SCALE: 3/64" = 1'-0"

N TRUE NORTH

FULLY SPRINKLERED

AS-BUILT RECORD DRAWINGS	07/10/15
FOR CONSTRUCTION	08/07/12
Revisions:	Date

CONSULTANTS:

LICENSED ARCHITECT — NICOS A. KATSELLIS — No. C29800 — REN. 04-30-13 — STATE OF CALIFORNIA

ARCHITECT/ENGINEERS:

LEO A DALY
27th Floor, 550 South Hope Street
Los Angeles, CA 90071 USA
Tel 213-629-0100 Fax 213-629-0070

Drawing Title: OVERALL SITE PLAN
Approved: Project Director

Project Title: VA GLA HEALTHCARE SYSTEM
WEST LA MEDICAL CENTER
SEISMIC CORRECTIONS
Location: LOS ANGELES, CA 90073
Date: 07/10/2015 | Checked: AA | Drawn: TP

Project Number: 691-406
Building Number: 209
Drawing Number: AS101
Dwg. of

Office of Construction and Facilities Management

VA FORM 08-6231