


STONE

6" SILVER BASE


1 NORSTONE FINISH WALL AT FIREPLACE

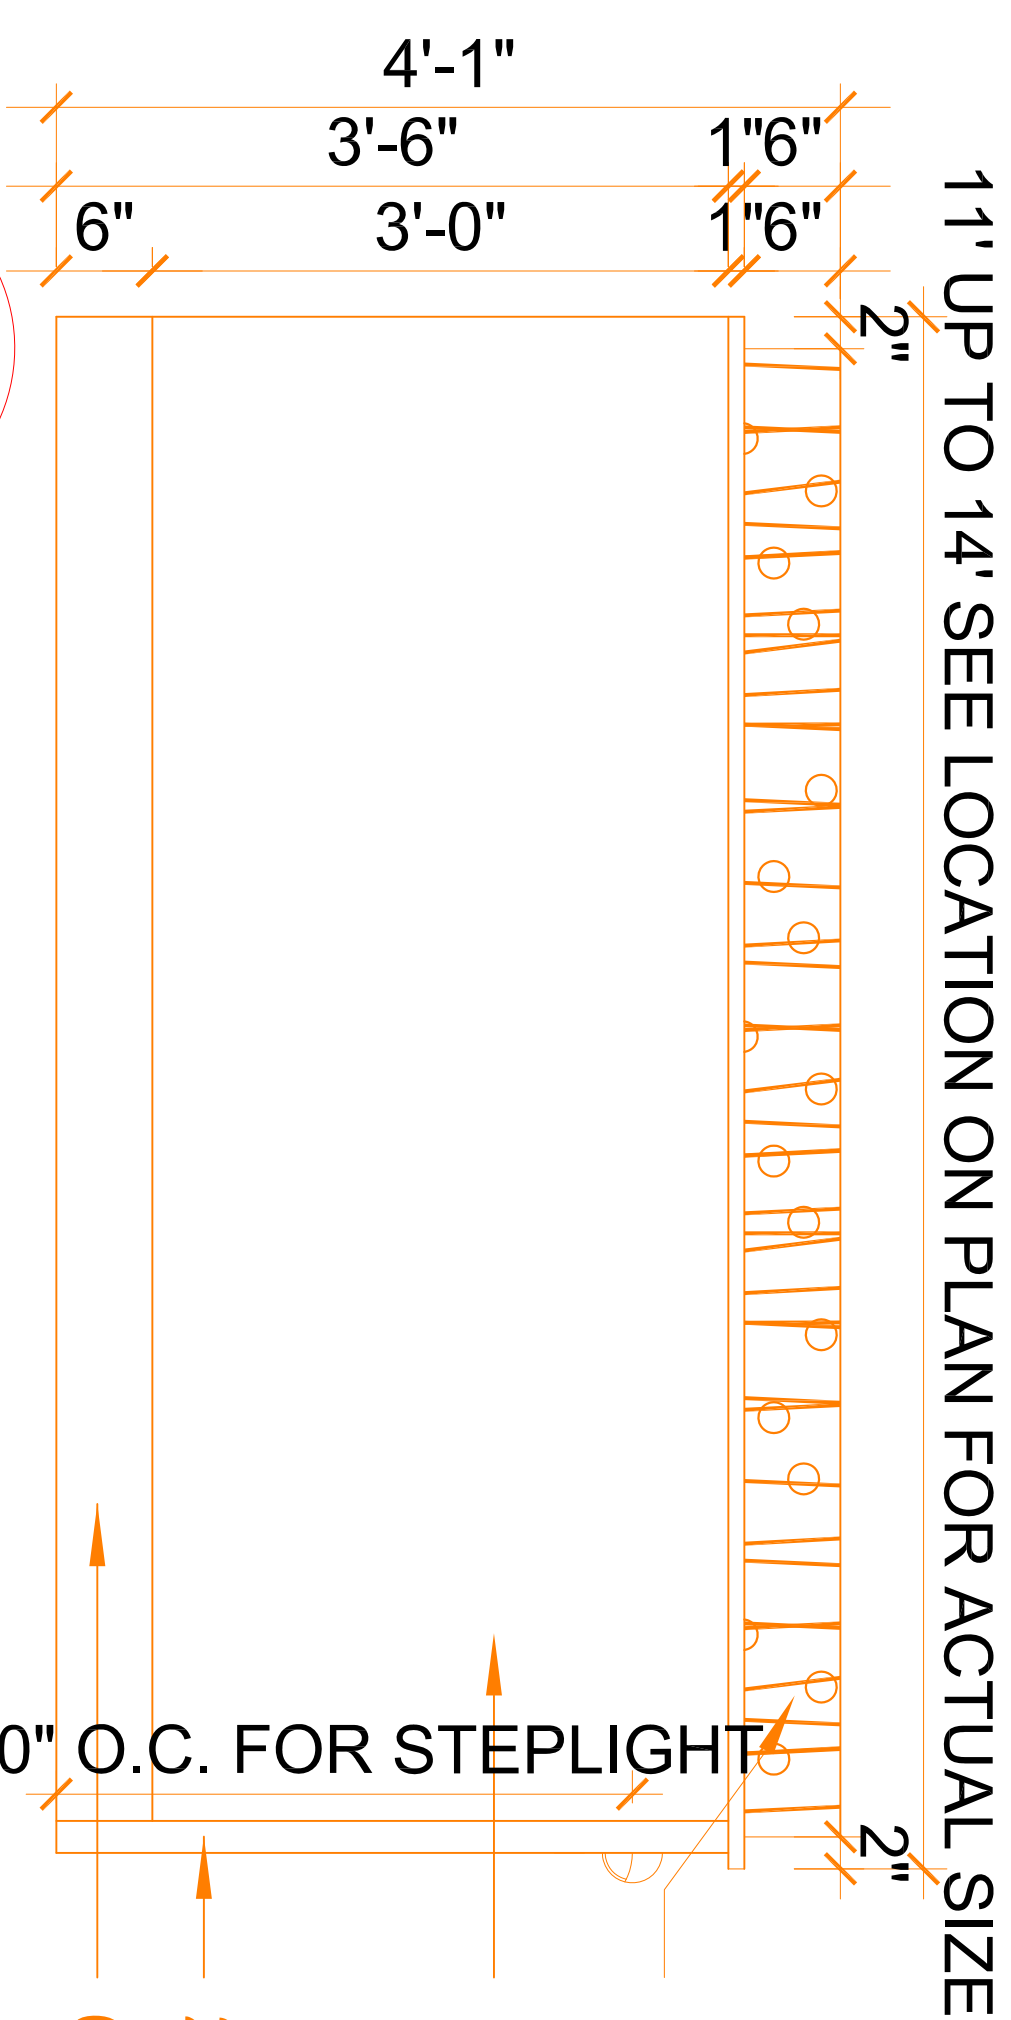


1' UP TO 14' SEE LOCATION ON PLAN FOR ACTUAL SIZE

TEMPERED ARCHITECTURAL GLASS
DIRTT: PATTERN: BLOOP ETCHED GLASS
WP1 DIRTT STANDARD
THERMAFOIL TO MATCH AMBER
CHERRY FINISH
2" CORNER GUARD CG1 AMBER CHERRY
6" SILVER BASE


2 TYPICAL HALF WALL AT PODS

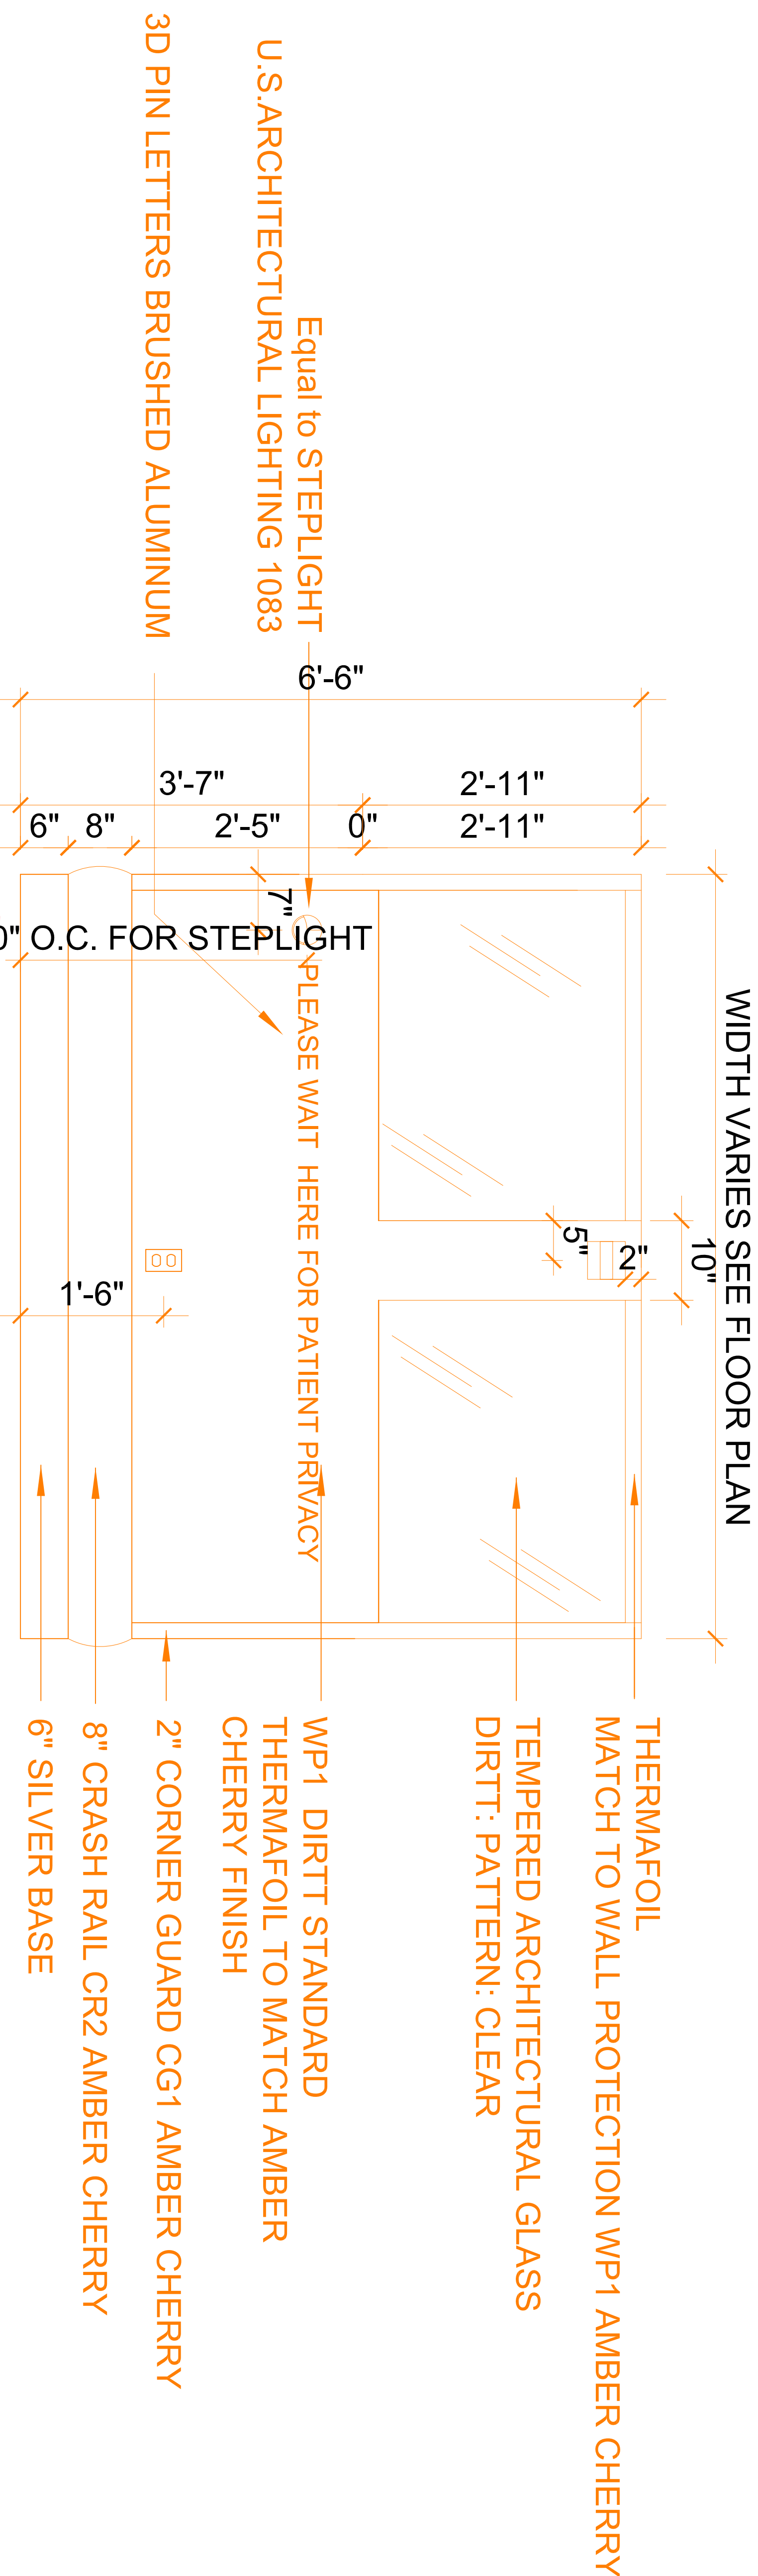

3 TYPICAL WALL GLASS INSERTS

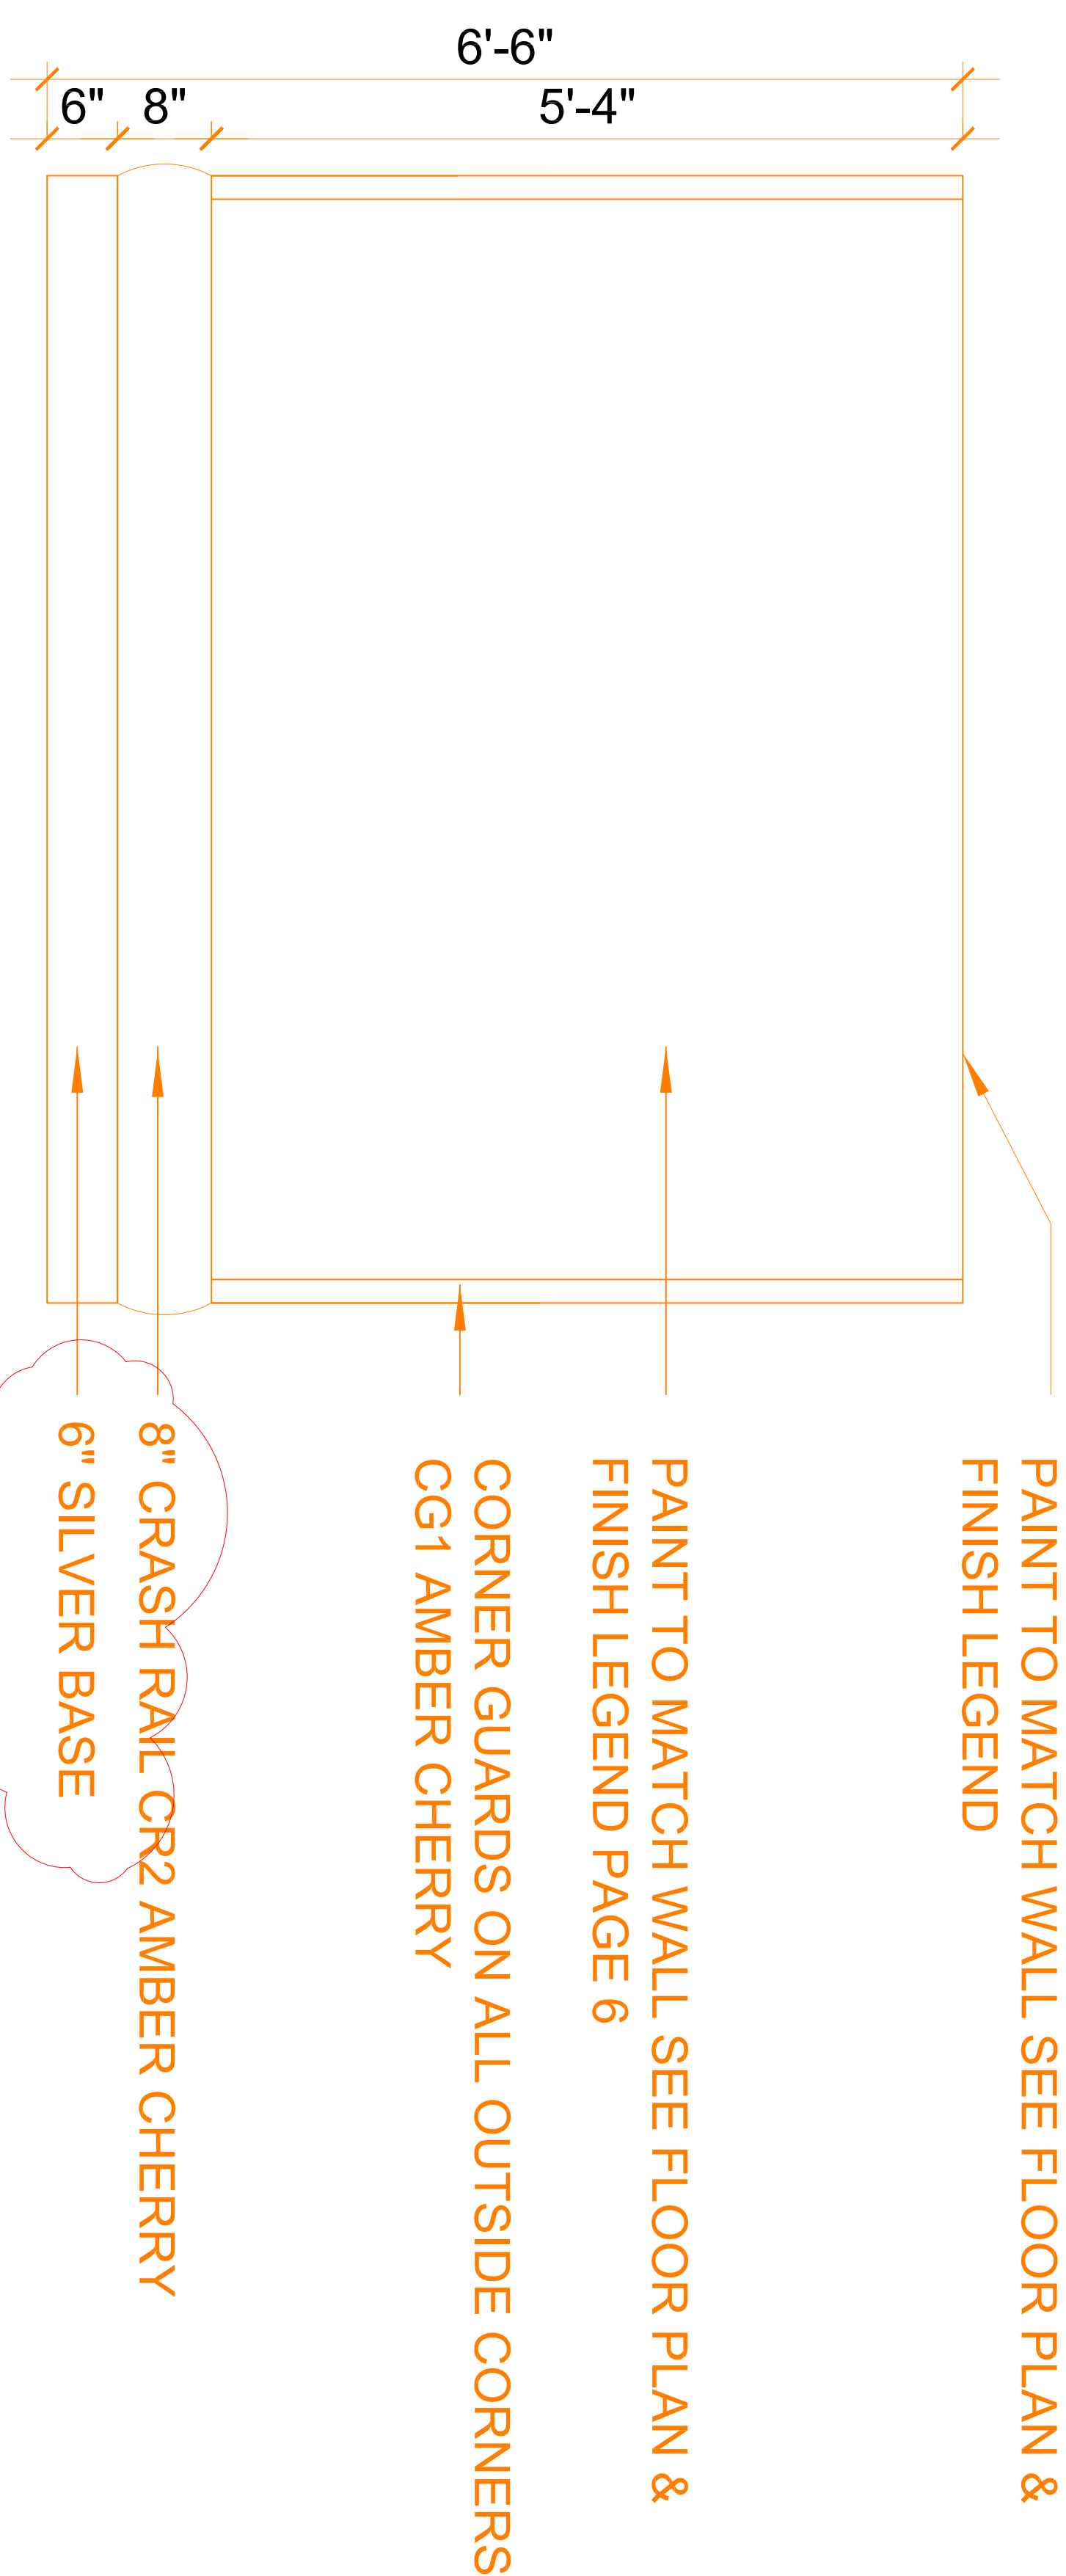

4 TYPICAL PAINTED WALL

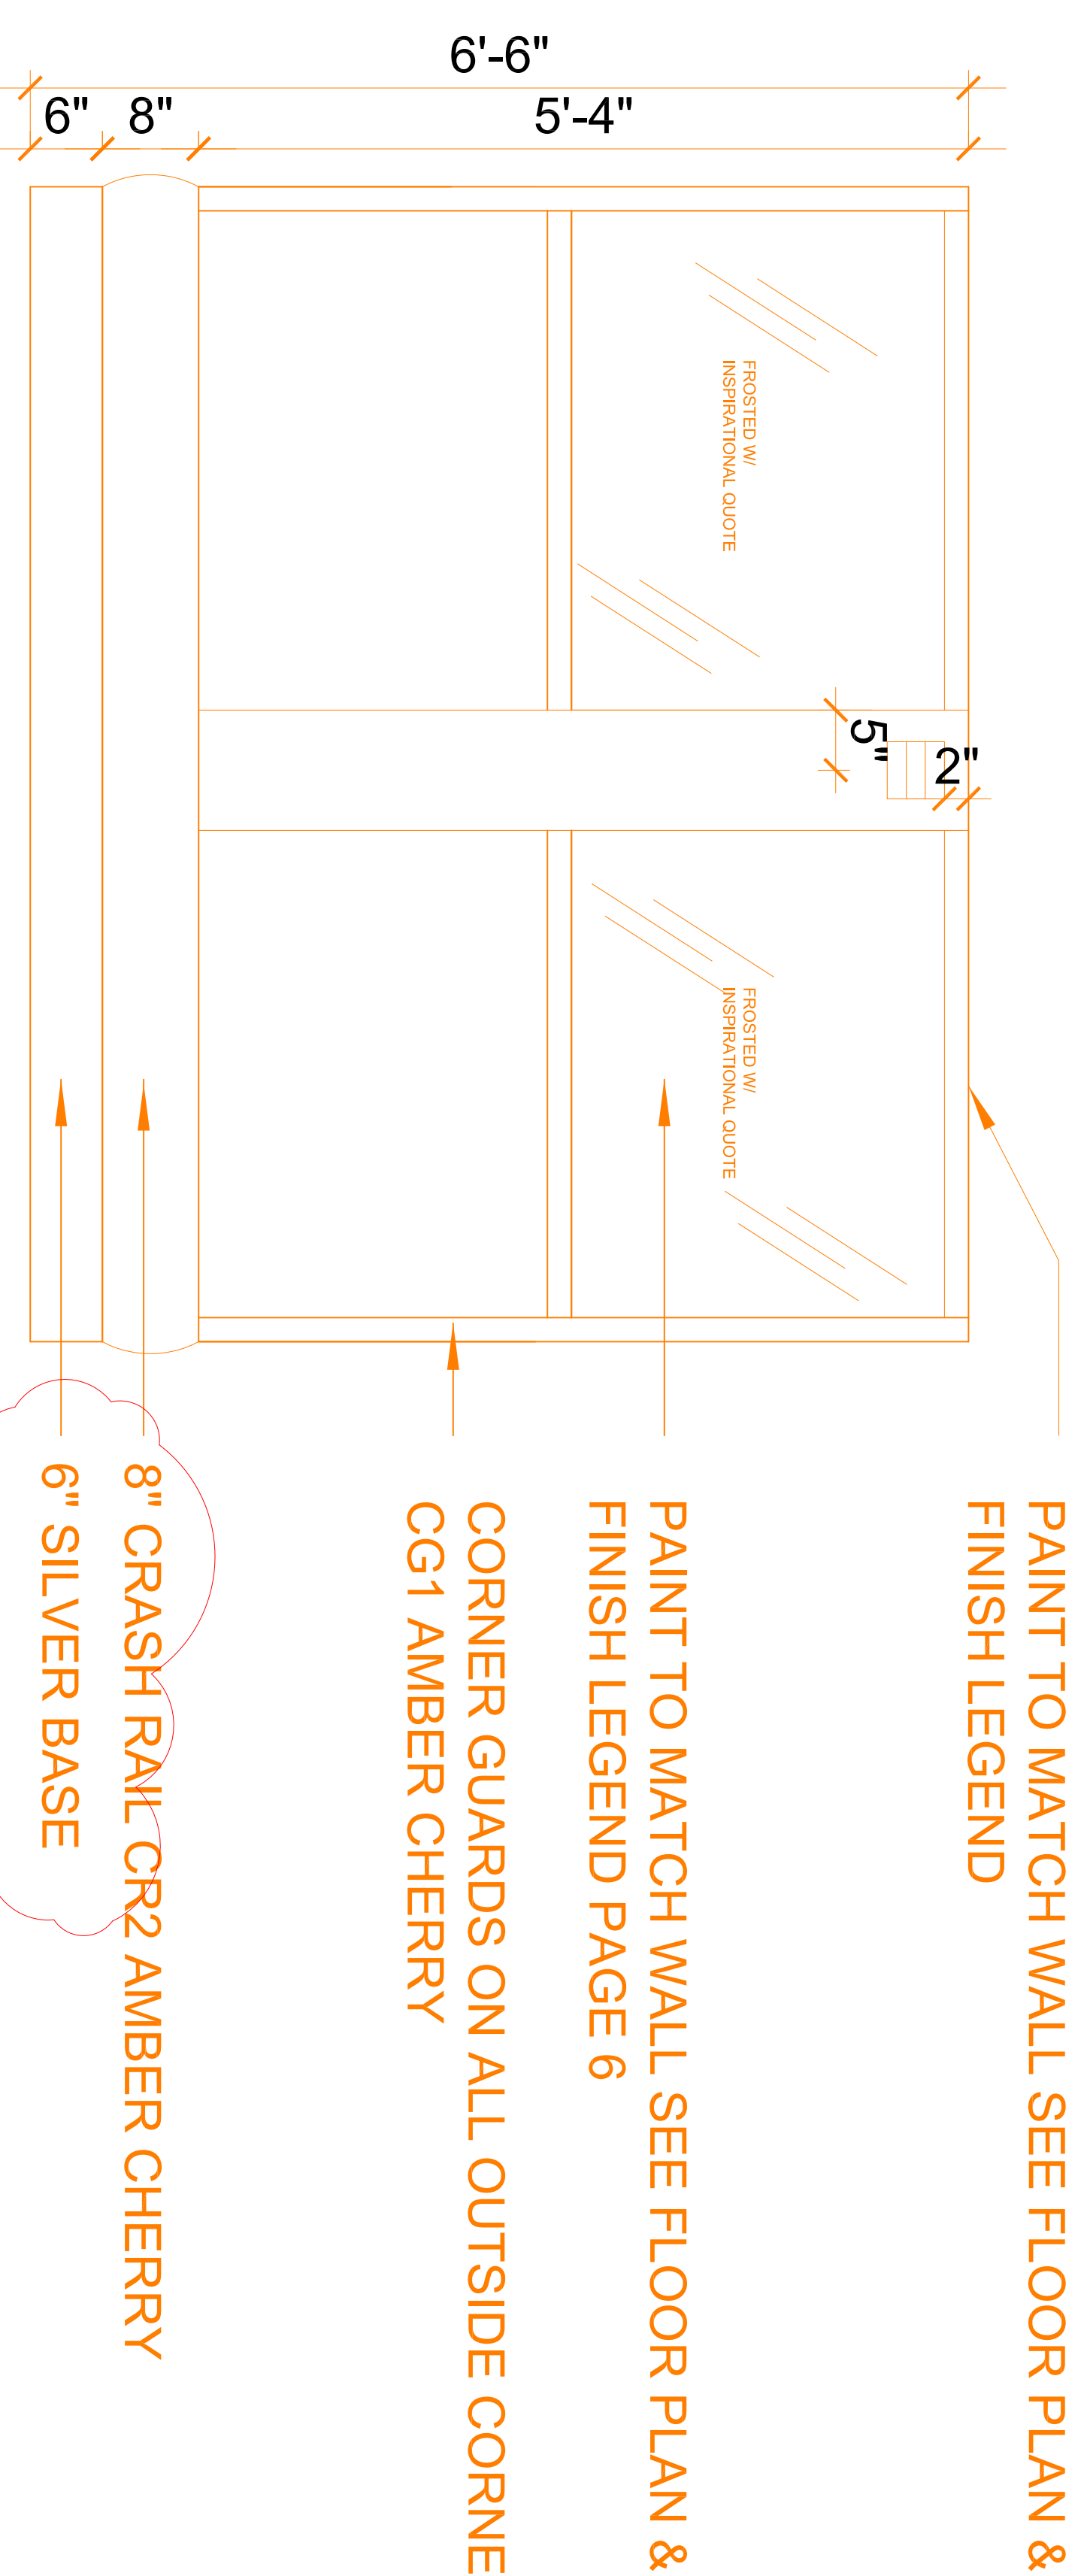

5 TYPICAL PAINTED WALL

