



AHU - 1 RISER
MECHANICAL - NEW WORK
0 1 2 3 4 8
GRAPHIC SCALE (FEET)

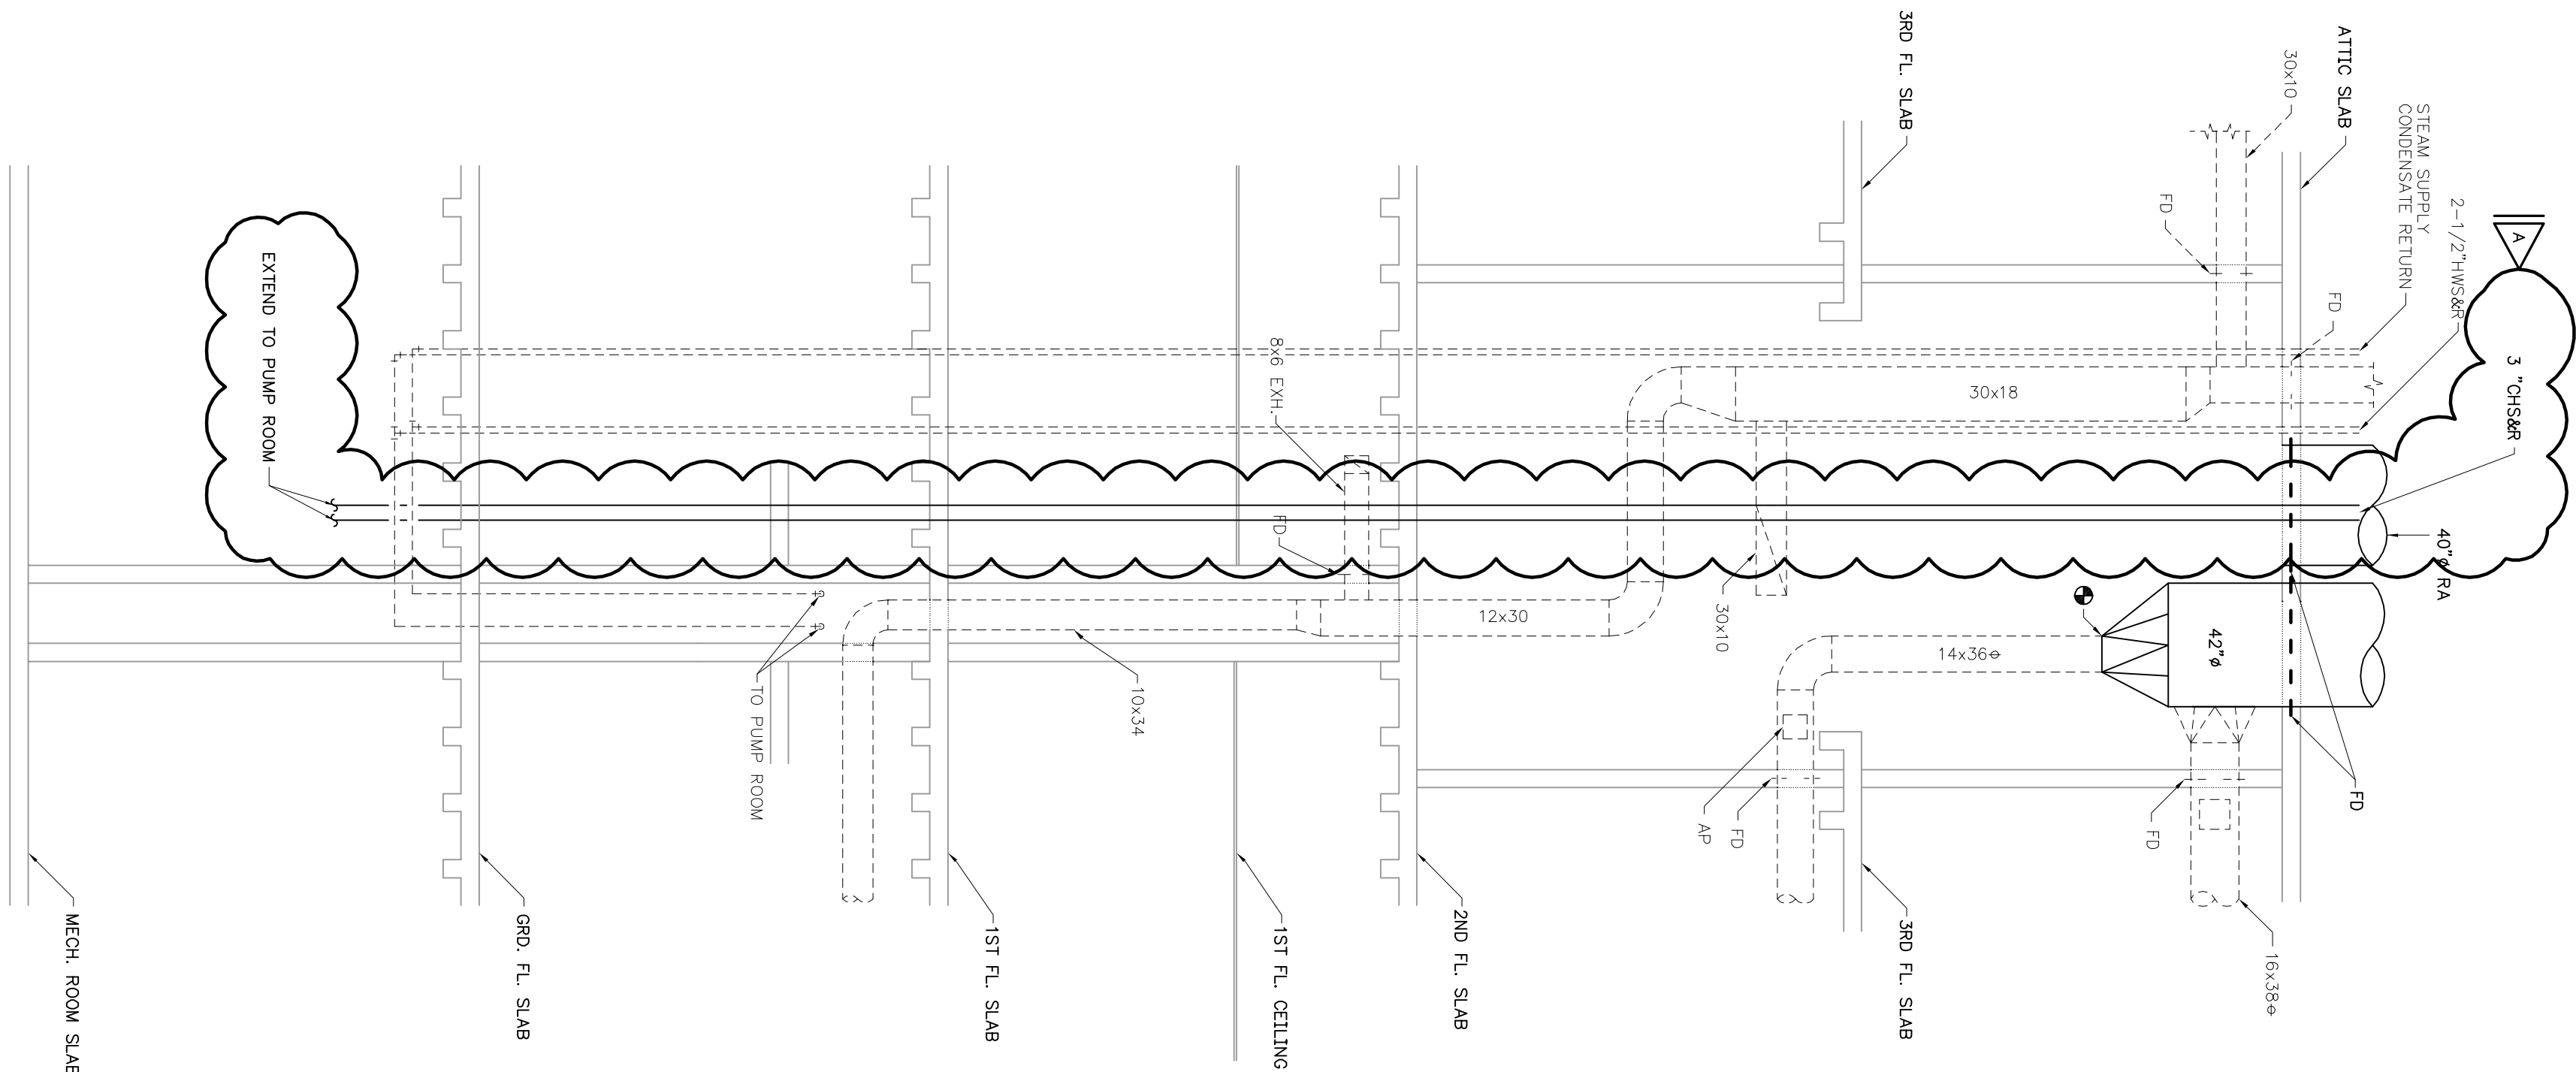


AHU - 2 RISER
MECHANICAL - NEW WORK
0 1 2 3 4 8
GRAPHIC SCALE (FEET)

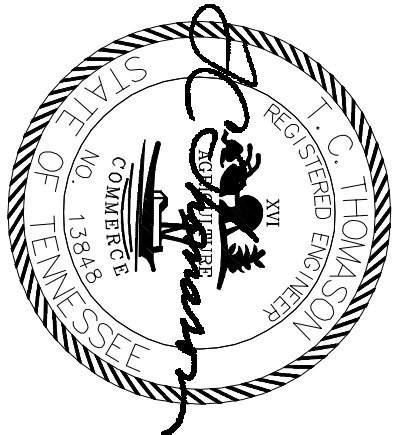


CONSTRUCTION DOCUMENTS

REVISION A - ADDENDUM NO. 1 - 3/21/12

Revisions	Date



Tennessee Valley Health System
NASHVILLE
CAMPUS

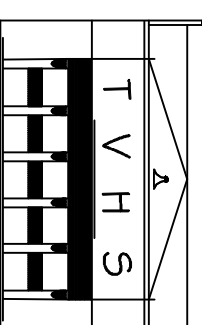

MURFREESBORO
CAMPUS

Tennessee Valley Healthcare System

Drawing Title		Project Title		Date	
MECHANICAL RISER NEW WORK		REPLACE ATTIC AHUS BUILDING 1		01/20/2012	
Approved: --		Approved: Facility Manager		Project No. 626A4-11-203	
Approved: --		Approved: Director		Building Number 1	
				Created TCI	
				Drawn BP	
				Location TWIS - YORK CAMPUS	
				DRAWING NO. 1 - M 8	
				FILE NAME 1026A02	
Veterans Administration					