


B
1-A 4

LOUVER DETAIL

ARCHITECTURAL

ATTIC FFL = 35'-8" (+/-) ABOVE BASEMENT FFL

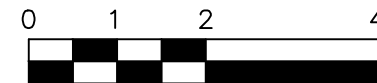

GRAPHIC SCALE (FEET)

REV.A - ADDENDUM #1

3/21/12



Tennessee Valley Healthcare System



	Drawing Title	Project Title	Date 3/21/12
			Project No. 626A4-11-203
Approved: --	Approved: Facility Manager	Building Number 1	Checked -
Approved: --	Approved: Director	Location TVHS - YORK CAMPUS	Drawn -
			DRAWING NO. 1-A 4
			FILE NAME

Veterans
Administration