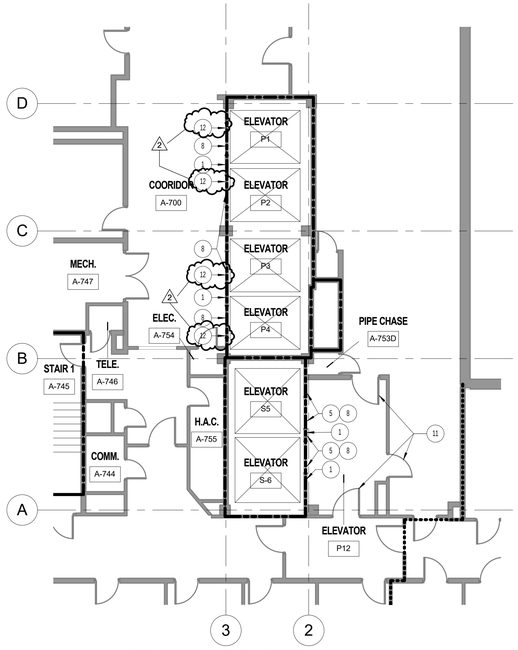

ELEVATORS P1-4 & S5-6 - LEVEL 7 FLOOR PLAN

7 / AS101 SCALE: 1/8" = 1'-0"

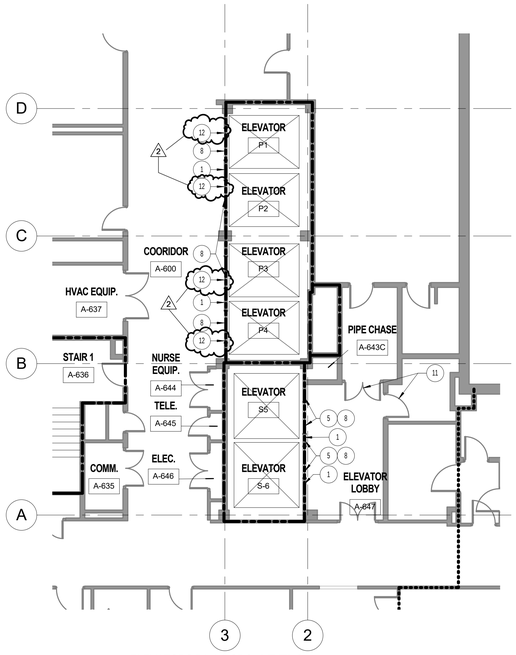

ELEVATORS P1-4 & S5-6 - LEVEL 6 FLOOR PLAN

6 / AS101 SCALE: 1/8" = 1'-0"

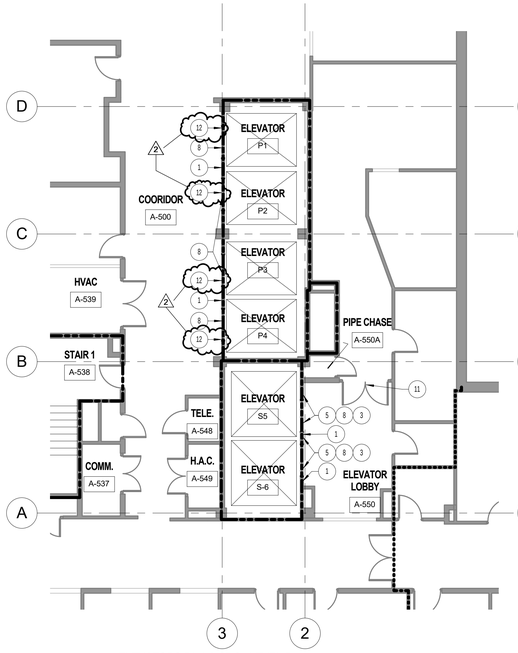

ELEVATORS P1-4 & S5-6 - LEVEL 5 FLOOR PLAN

5 / AS101 SCALE: 1/8" = 1'-0"

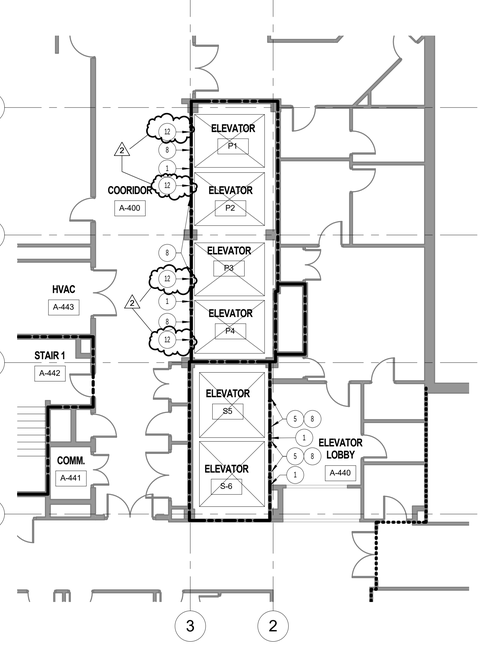

ELEVATORS P1-4 & S5-6 - LEVEL 4 FLOOR PLAN

8 / AS101 SCALE: 1/8" = 1'-0"

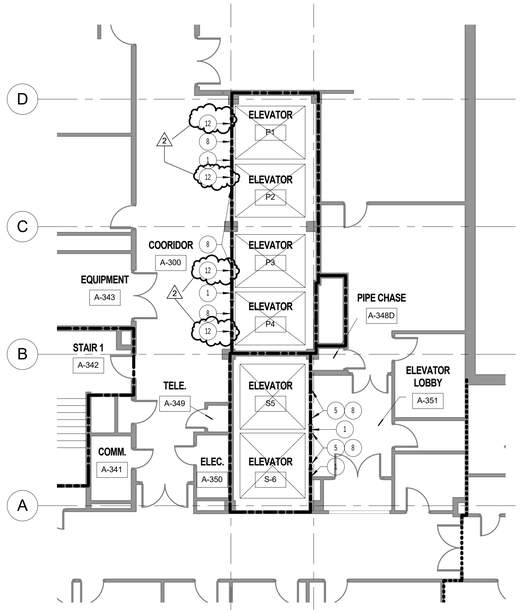

ELEVATORS P1-4 & S5-6 - LEVEL 3 FLOOR PLAN

4 / AS101 SCALE: 1/8" = 1'-0"

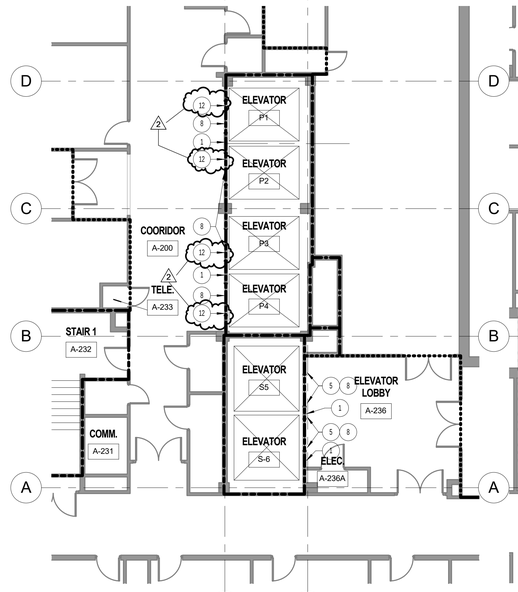

ELEVATORS P1-4 & S5-6 - LEVEL 2 FLOOR PLAN

3 / AS101 SCALE: 1/8" = 1'-0"

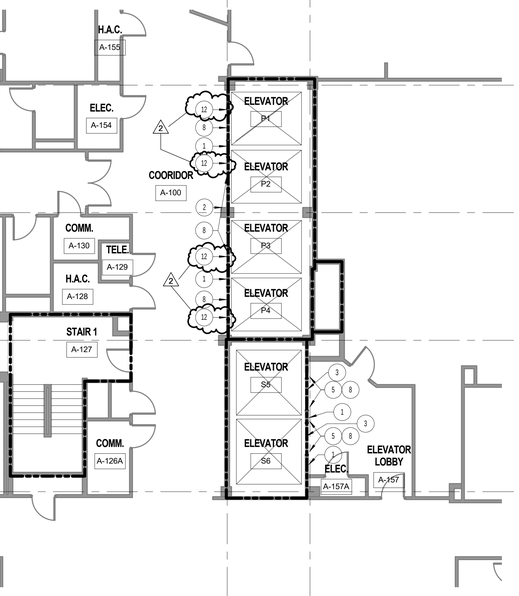

ELEVATORS P1-4 & S5-6 - LEVEL 1 FLOOR PLAN

2 / AS101 SCALE: 1/8" = 1'-0"

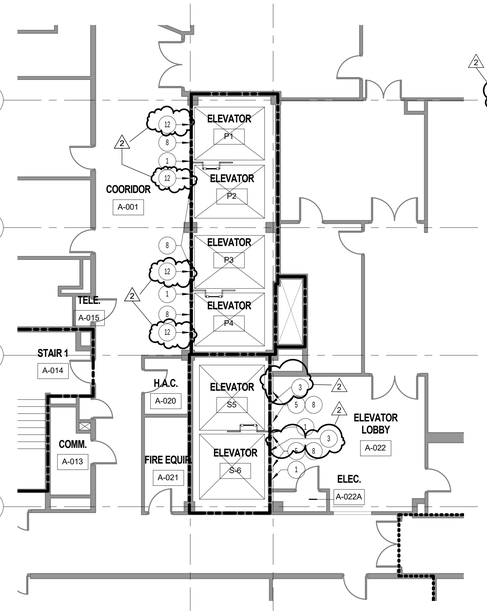

ELEVATORS P1-4 & S5-6 - LEVEL 0 FLOOR PLAN

1 / AS101 SCALE: 1/8" = 1'-0"

PLAN LEGEND

- NEW WALL
- EXISTING WALL TO REMAIN
- 2 HOUR RATED WALL, TO REMAIN
- SMOKE RATED WALL ,TO REMAIN
- 101 — NEW DOOR
- DOOR TAG
- EXISTING DOOR
- ROOM 101 — ROOM TAG
- 1 — PLAN NOTE
- 1 — ALTERNATE/BID DEDUCT ITEM

CONSTRUCTION PLAN GENERAL NOTES

1. ALL DIMENSIONS SHOWN ARE TO FACE OF WALL FRAMING/ MASONRY UNLESS NOTED OTHERWISE. DIMENSIONS DESIGNATES AS "CLR" OR "CLEAR" INDICATE A CLEAR DIMENSION FROM FACE OF FINISH TO FACE OF FINISH.
2. KEYNOTES AND LEGENDS ARE TYPICAL FOR ALL FLOOR PLAN SHEETS, INDIVIDUAL NOTES MAY NOT APPLY TO EACH SHEET.
3. REFERENCE STRUCTURAL, MECHANICAL, PLUMBING AND ELECTRICAL FOR ITEMS. COORDINATE AS REQUIRED INCLUDING NECESSARY FRAMING, BLOCKING, ETC
4. VERIFY EXISTING FIELD CONDITIONS PRIOR TO BEGINNING WORK, AND REPORT DISCREPANCIES IMMEDIATELY TO ARCHITECT FOR CLARIFICATION.
5. PATCH EXISTING WALLS WHERE NEW WALLS MEET.
6. ALL GYPSUM WALLBOARD IS 5/8" TYPE "X" UNLESS NOTED OTHERWISE.
7. PROVIDE MINIMUM CLEARANCES AT ALL DOORS PER DETAILS ON AS001.
8. CONTRACTOR TO MAINTAIN/REPAIR RATING OF EXISTING PARTITIONS AS AFFECTED BY DEMOLITION/NEW CONSTRUCTION, TYPICAL THROUGHOUT
9. ALL NEW PARTITIONS ARE WALL TYPE S3.A1 UNLESS NOTED OTHERWISE.
10. WHERE NO DIMENSION IS INDICATED, FINISH DOORS 6" FROM EDGE OF STUD FRAMING AT CORNERS UNLESS OTHERWISE NOTED.
11. COLUMN GRID IS PROVIDED FOR ORIENTATION AND VERTICAL RELATION. ADDITIONAL EXISTING COLUMNS, BEAMS AND STRUCTURAL SYSTEMS EXIST BUT HAVE NOT BEEN VERIFIED.

CONSTRUCTION PLAN NOTES

1. REPLACE CAB CALL BUTTONS AND OPERATING PANELS AS SPECIFIED, AT 36" ABOVE FF. REMOVE "IN CASE OF FIRE" SIGNAGE. PATCH AND REPAIR FINISHES TO MATCH EXISTING ADJACENT AS SCHEDULED.
2. CEILING MOUNTED MONITOR TIED TO ELEVATOR MONITORING SYSTEM.
3. REPLACE ELEVATOR DOORS.
4. INFILL, PATCH AND FINISH OPENINGS AS REQUIRED TO MATCH EXISTING CONDITIONS. ALIGN FINISH FACE OF WALL, BOTH SIDES. COORDINATE WITH FINISH SCHEDULE.
5. COVER EXISTING GUARD WITH HIGH IMPACT ENGINEERED PETG ELEVATOR FRAME PROTECTION. PAINT EXISTING FRAME AND METAL DOOR (UNLESS SS).
6. COVER EXISTING FRAME, BOTH JAMBS, WITH NEW FINISH STAINLESS STEEL SLEEVE FOR ELEVATOR DOOR FRAME. PAINT EXISTING DOOR (UNLESS SS).
7. PROVIDE PENETRATION OF WALL FOR MECHANICAL, ELECTRICAL OR DATA CONNECTIONS AS SPECIFIED. COORDINATE WITH MEP DRAWINGS.
8. REMOVE CAB INDICATOR LAMPS AND PANELS AND TRAVEL DIRECTION INDICATORS, PROVIDE LED INDICATOR PANEL TIED TO NEW CONTROL SYSTEM AS SPECIFIED, PATCH AND REPAIR FINISHES TO MATCH EXISTING ADJACENT AS SCHEDULED.
9. PROVIDE TEMPORARY SMOKE PARTITION TO ALLOW ACCESS FROM ELEVATOR P-8 TO ACUTE CARE WAITING FOR DURATION OF P-7 ELEVATOR SHUTDOWN. MODIFY ACOUSTICAL CEILING TILE SYSTEM AS REQUIRED TO COMPLETE NEW WORK. TEMPORARY SMOKE PARTITION SHALL BE 3 5/8" STEEL STUDS @ 16" O.C. WITH 5/8" TYPE 'X' GYP BD BOTH SIDES, TO DECK. PROVIDE SMOKE SEAL RATED CAULKING AS REQUIRED TO PROVIDE SMOKE RATED PARTITION, AND FINISHED INTERIOR SPACE. PROVIDE PAINT AND COVED WALL BASE, BOTH SIDES. FINISHES TO MATCH ADJACENT EXISTING PARTITION. PROVIDE TEMPORARY ELEVATOR CONTROLS FOR P8 AND P9. REMOVE TEMPORARY SMOKE PARTITION AND CONTROLS WHEN ELEVATOR P-7 IS BACK IN SERVICE. MODIFY ACOUSTICAL CEILING TILE SYSTEM BACK TO ITS ORIGINAL CONDITION.
10. REMOVE AND STORE EXISTING DOOR LEAF AND ASSOCIATED HARDWARE. PAINT EXISTING FRAME TO MATCH EXISTING COLOR. REINSTALL DOOR LEAF AND ASSOCIATED HARDWARE ONCE ELEVATOR P-7 IS OPERATIONAL AND PLACED IN SERVICE.
11. CONTRACTOR SHALL NOT HAVE ACCESS THROUGH THIS DOOR IN ANY PHASE.
12. PAINT ELEVATOR METAL DOOR AND FRAMES (UNLESS SS) - P2.

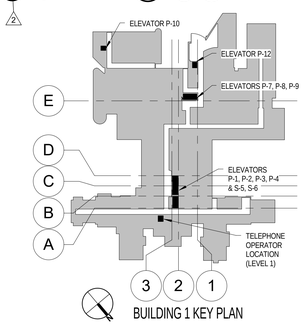

BUILDING 1 KEY PLAN

Revisions:	Date
2 ADDENDUM 1	11/17/2015

U.S. Department of Veterans Affairs

ROBLEY REX VAMC
800 ZORN AVENUE LOUISVILLE, KY 40206

ARCHITECT/ENGINEERS:

PROJECT LEAD
Architect, Structural Engineer, Civil Engineer
GUIDON DESIGN
905 N. CAPITOL AVE. SUITE 100 INDIANAPOLIS, IN. 46204
317.800.6388 WWW.GUIDONDESIGN.COM
SUSTAINABLE ARCHITECTURE + ENGINEERING

MEP Engineer
MILLER-REMICK LLC.
1010 Kings Highway South
Cherry Hill, NJ 08034
Tele: 856-429-4000

Elevator Design
STUARD & ASSOCIATES, INC.
2500 Lincoln Hill Road
Martinsville, IN 46151
Tele: 765-352-1975

BID DOCUMNETS

Drawing Title: FLOOR PLANS	Project Title: UPGRADE ELEVATOR CONTROLS	Project Number: 15.1035	OFFICE OF FACILITIES MANAGEMENT
		Building Number: #1	
Approved for Design Concept: FACILITY MANAGEMENT DIVISION MANAGER	Location: ROBLEY REX VA MEDICAL CENTER	Drawing Number: AS101	VA Project Number: 603-15-101
	Date: 2015/09/25 · Checked By: STW · Drawn By: LAL		VA | U.S. Department of Veterans Affairs

C:\Users\tatkinson\Documents\15.1035-A-VAMC LOUISVILLE ELEVATORS_TATKINSON@GUIDONDESIGN.COM.rvt