


7
AS103

ELEVATOR P12 - LEVEL 0 FLOOR PLAN






SCALE: 1/8" = 1'-0"

CONSTRUCTION PLAN GENERAL NOTES

1. ALL DIMENSIONS SHOWN ARE TO FACE OF WALL FRAMING/MASONRY UNLESS NOTED OTHERWISE. DIMENSION DESIGNATES AS "CL" OR "CL&R" INDICATE A CLEAR DIMENSION FROM FACE OF FINISH TO FACE OF FINISH.
2. KEYNOTES AND LEGENDS ARE TYPICAL FOR ALL FLOOR PLAN SHEETS. INDIVIDUAL NOTES MAY NOT APPLY TO EACH SHEET.
3. REFERENCE STRUCTURAL, MECHANICAL, PLUMBING AND ELECTRICAL FOR ITEMS: COORDINATE AS REQUIRED INCLUDING NECESSARY FRAMING, BLOCKING, ETC
4. VERIFY EXISTING FIELD CONDITIONS PRIOR TO BEGINNING WORK, AND REPORT DISCREPANCIES IMMEDIATELY TO ARCHITECT FOR CLARIFICATION.
5. PATCH EXISTING WALLS WHERE NEW WALLS MEET.
6. ALL GYPSUM WALLBOARD IS 5/8" TYPE "X" UNLESS NOTED OTHERWISE.
7. PROVIDE MINIMUM CLEARANCES AT ALL DOORS PER DETAIL ON A5001.
8. CONTRACTOR TO MAINTAIN/REPAIR RATING OF EXISTING PARTITIONS AS AFFECTED BY DEMOLITION/NEW CONSTRUCTION, TYPICAL THROUGHOUT
9. ALL NEW PARTITIONS ARE: WALL TYPE 3.6.1 UNLESS NOTED OTHERWISE.
10. WHERE NO DIMENSION IS INDICATED: FINISH DOORS 6" FROM EDGE OF STUD FRAMING AT CORNERS UNLESS OTHERWISE NOTED.
11. COLUMN GRID IS PROVIDED FOR ORIENTATION AND VERTICAL RELATION. ADDITIONAL EXISTING COLUMNS, BEAMS AND STRUCTURAL SYSTEMS EXIST BUT HAVE NOT BEEN VERIFIED.

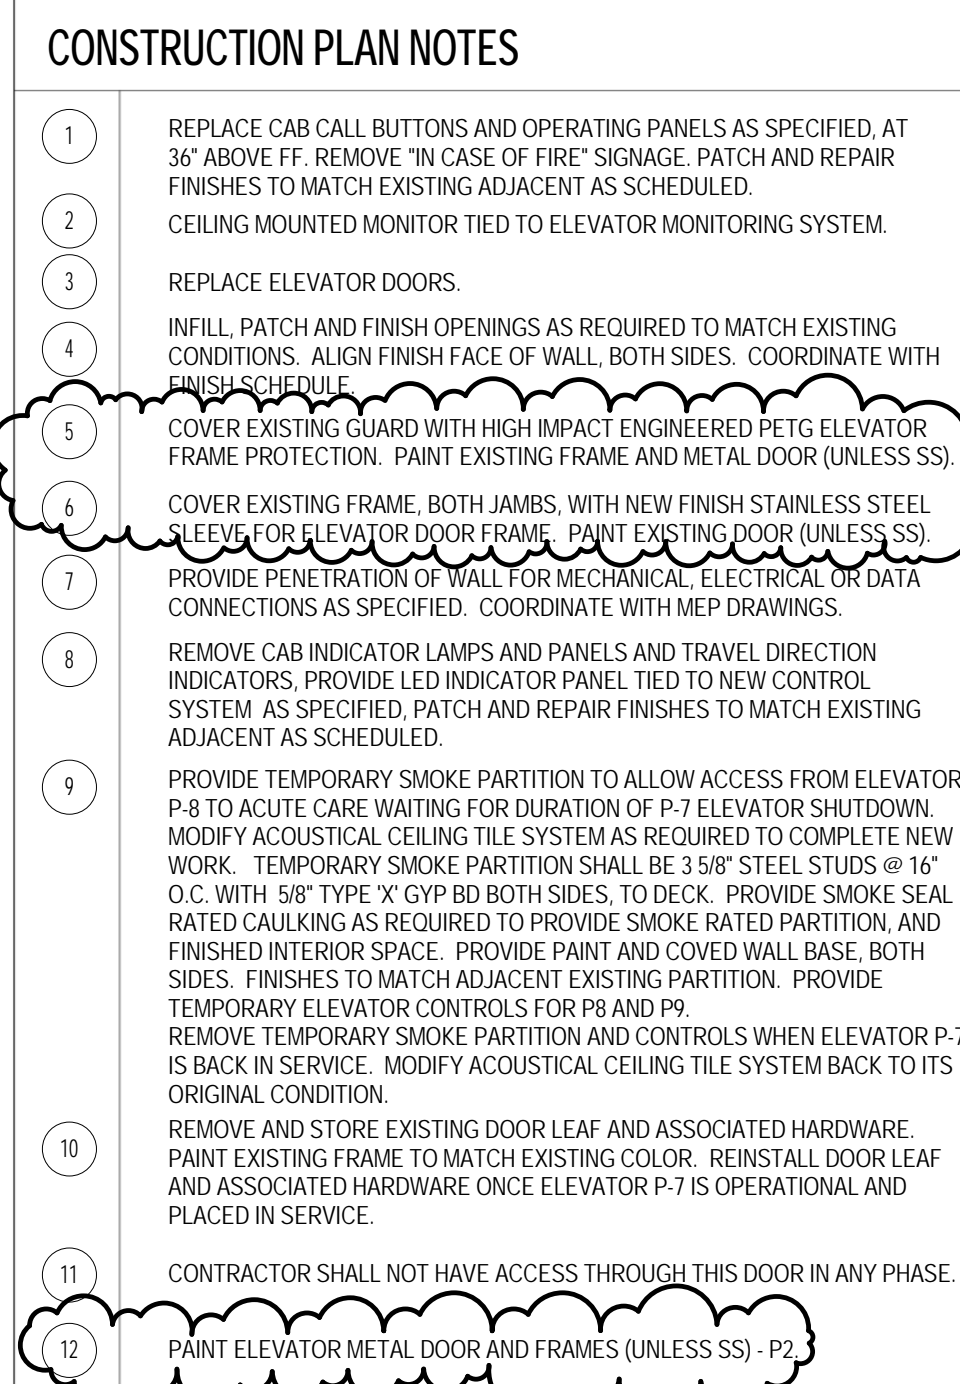


BUILDING 1 KEY PLAN

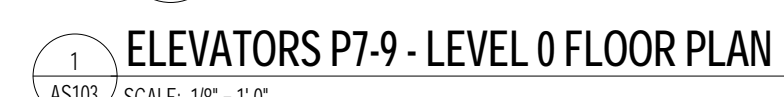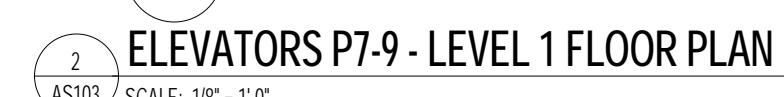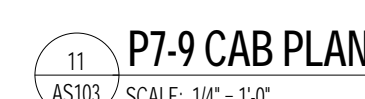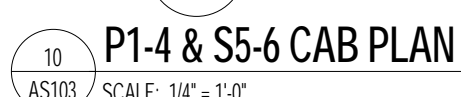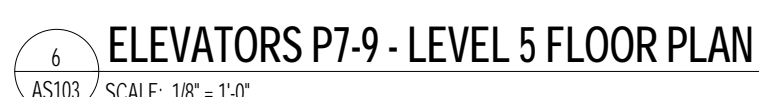

VA |  **U.S. Department
of Veterans Affairs**

ROBLEY REX VAMC
800 ZORN AVENUE LOUISVILLE, KY 40206

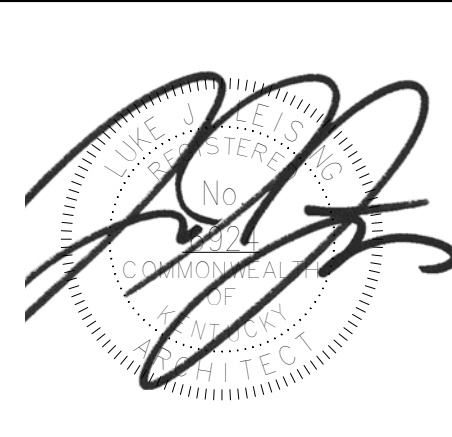

MEP Engineer
MILLER-REMICK LLC.

Elevator Design
STUARD &

Drawing Title FLOOR PLANS & CAB PLANS
Approved for Design Concept: FACILITY MANAGEMENT DIVISION MANAGER

Project Title		
UPGRADE ELEVATOR CONTROLS		
Location		
ROBLEY REX VA MEDICAL CENTER		
Date	Checked By:	Drawn By:
2015/09/25	STW	LAL

Project Number	15.1035
Building Number	#1
Drawing Number	AS103

OFFICE OF FACILITIES MANAGEMENT	
VA Project Number 603-15-101	
VA	 U.S. Department of Veterans Affairs