



M = MEDIUM PRESS STEAM
 VR = VACUUM RETURN
 D = DRIP RETURN

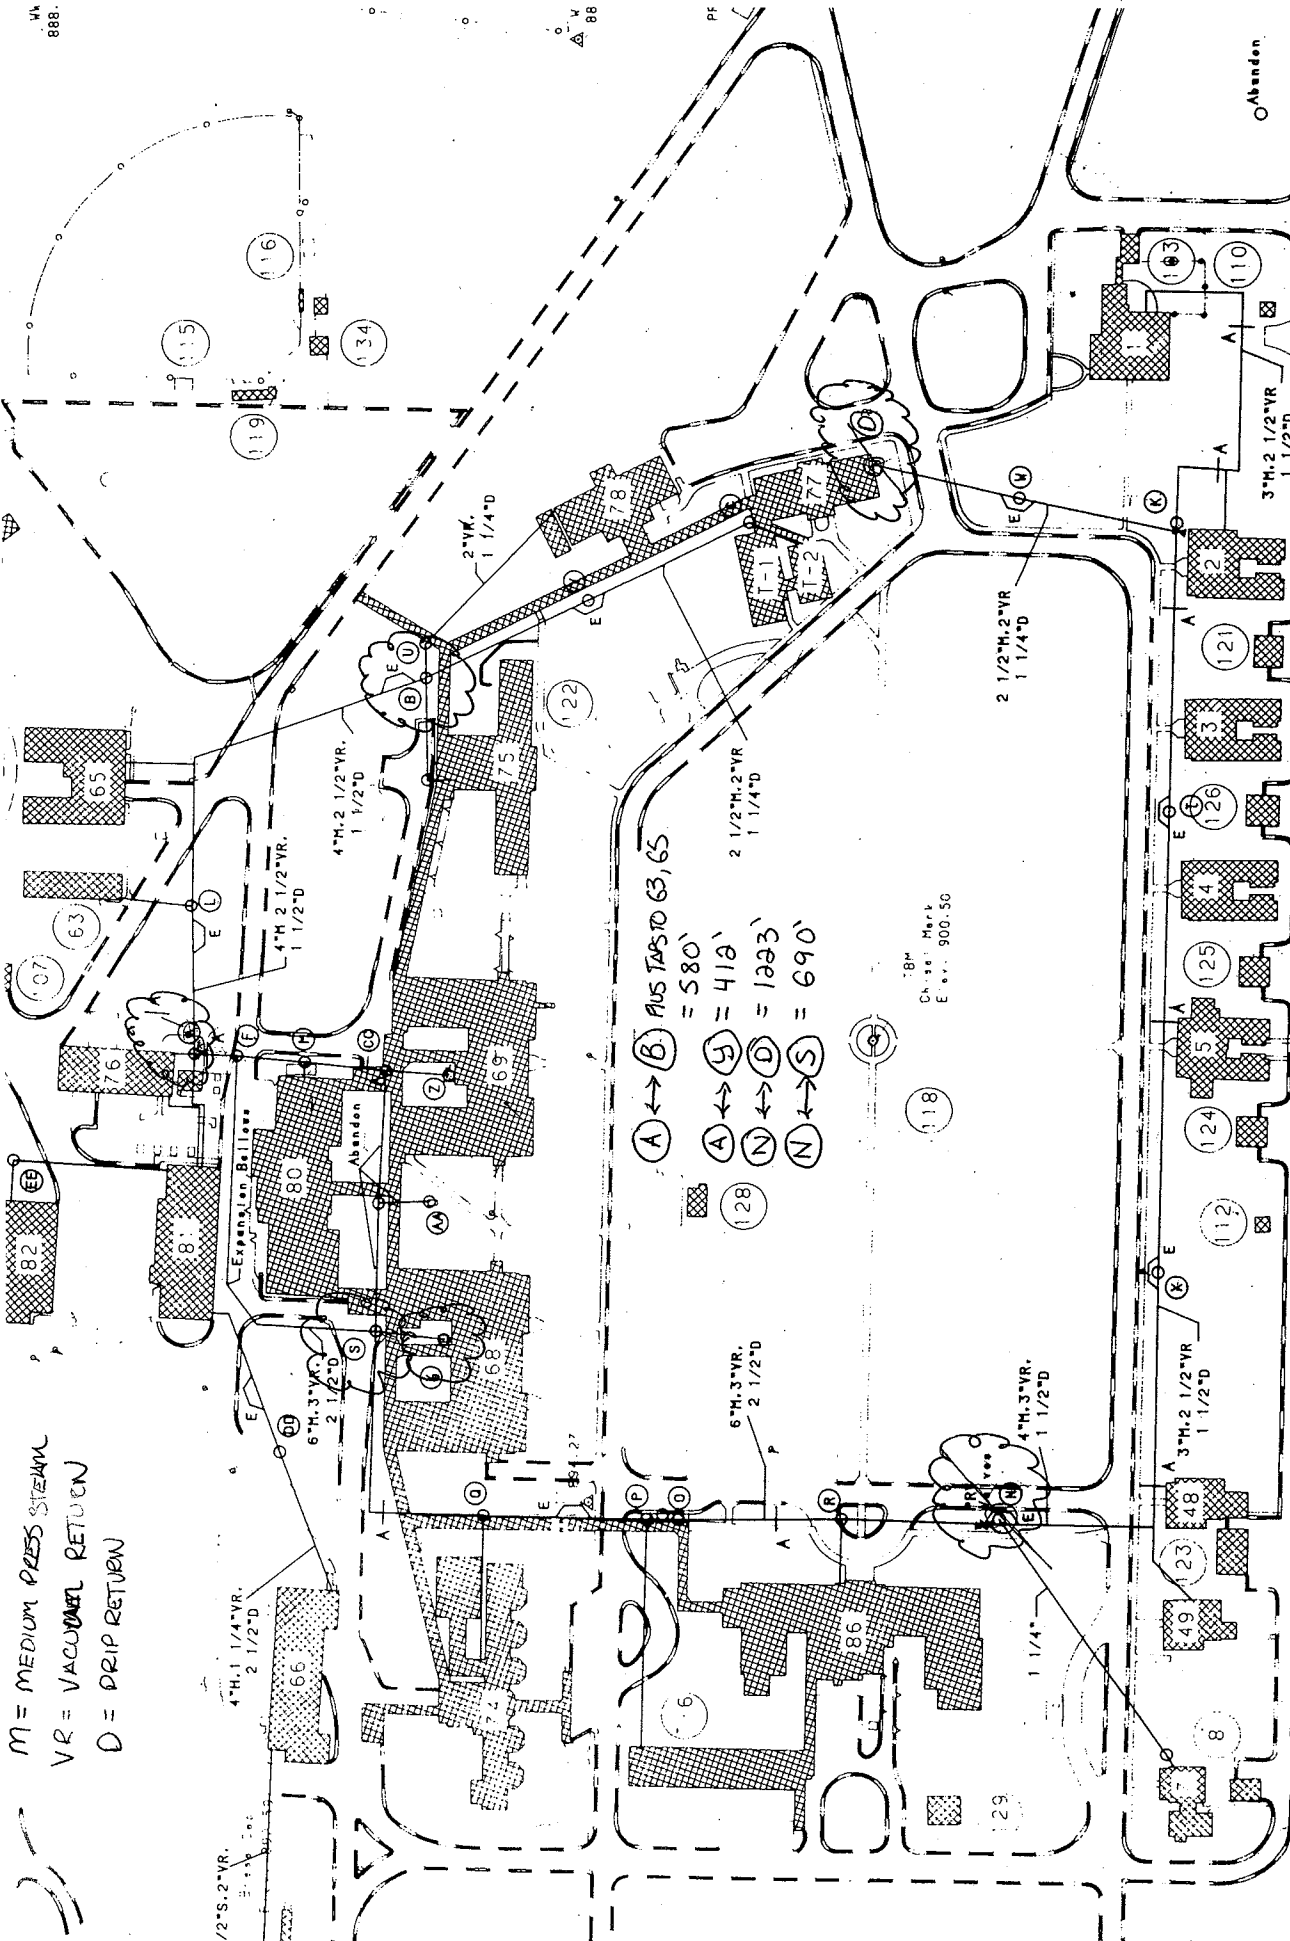


(A) ↔ (B) AUS TAPS TO 63, 65
 = 580'
 (A) ↔ (C) = 418'
 (N) ↔ (D) = 1223'
 (N) ↔ (S) = 690'

18"
 Charge Mark
 E... 900.50

Abandon

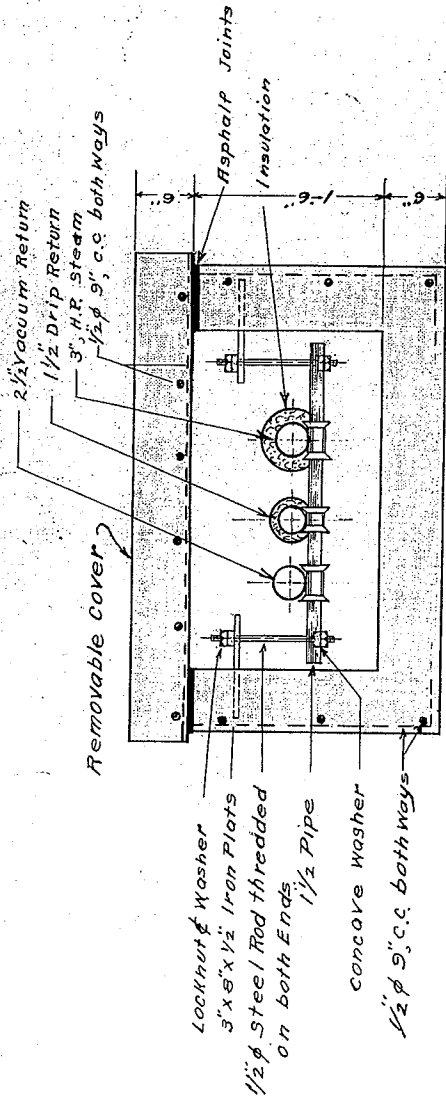


SECTION, B.B.

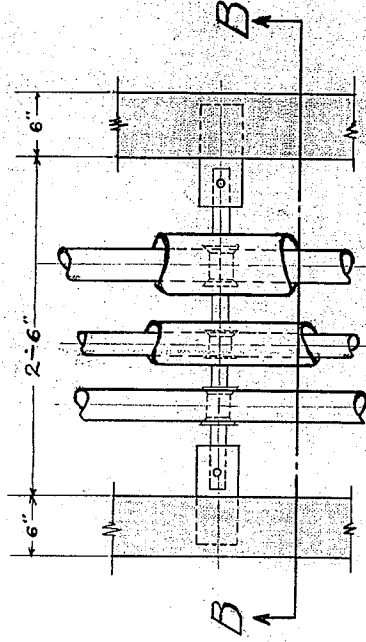

PLAN,

DETAIL OF NEW CONCRETE PIPE TRENCH.

Scale 1/8" = 1'-0"

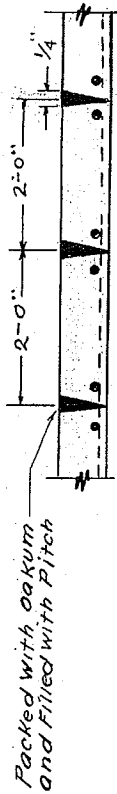

DETAIL OF REMOVABLE COVER.
Not to Scale.

U. S. VETERANS BUREAU	
WASHINGTON, D. C.	
VED. <i>Frank M. Jones</i>	DIRECTOR
CHIEF CONSTRUCTION DIVISION	
<i>act. J. M. Russell</i>	CHIEF DESIGN SUBDIVISION