



REVISION A - ADDENDUM NO. 1 - 3/21/12

Revisions	
Date	

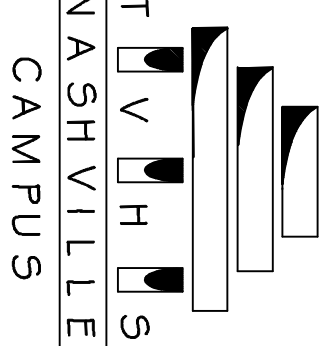


T	V	H	S
NASHVILLE			
CAMPUS			

Tennessee Valley Healthcare System

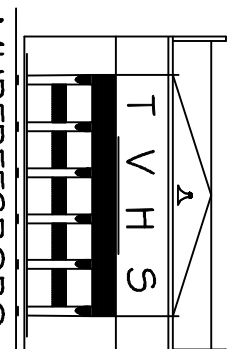


MURFREESBORO
CAMPUS

Tennessee Valley Healthcare System MURFREESBORO CAMPUS			Drawing Title NEW WORK FLOOR PLAN			Project Title REPLACE ATTIC AHUS BUILDING 6			Date 01/20/2012						
Approved: --			Approved: Facility Manager			Building Number 6			Checked TCT		Drawn SPR		Project No. 6254A-11-204		
Approved: --			Approved: Director			Location TWS - YORK CAMPUS			DRAWING NO. 6-M-3			FILE NAME 1027W01			
Veterans Administration															

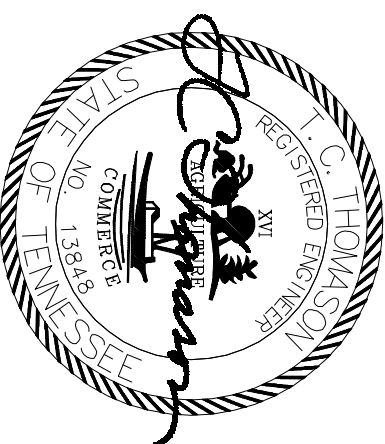

CONSTRUCTION DOCUMENTS

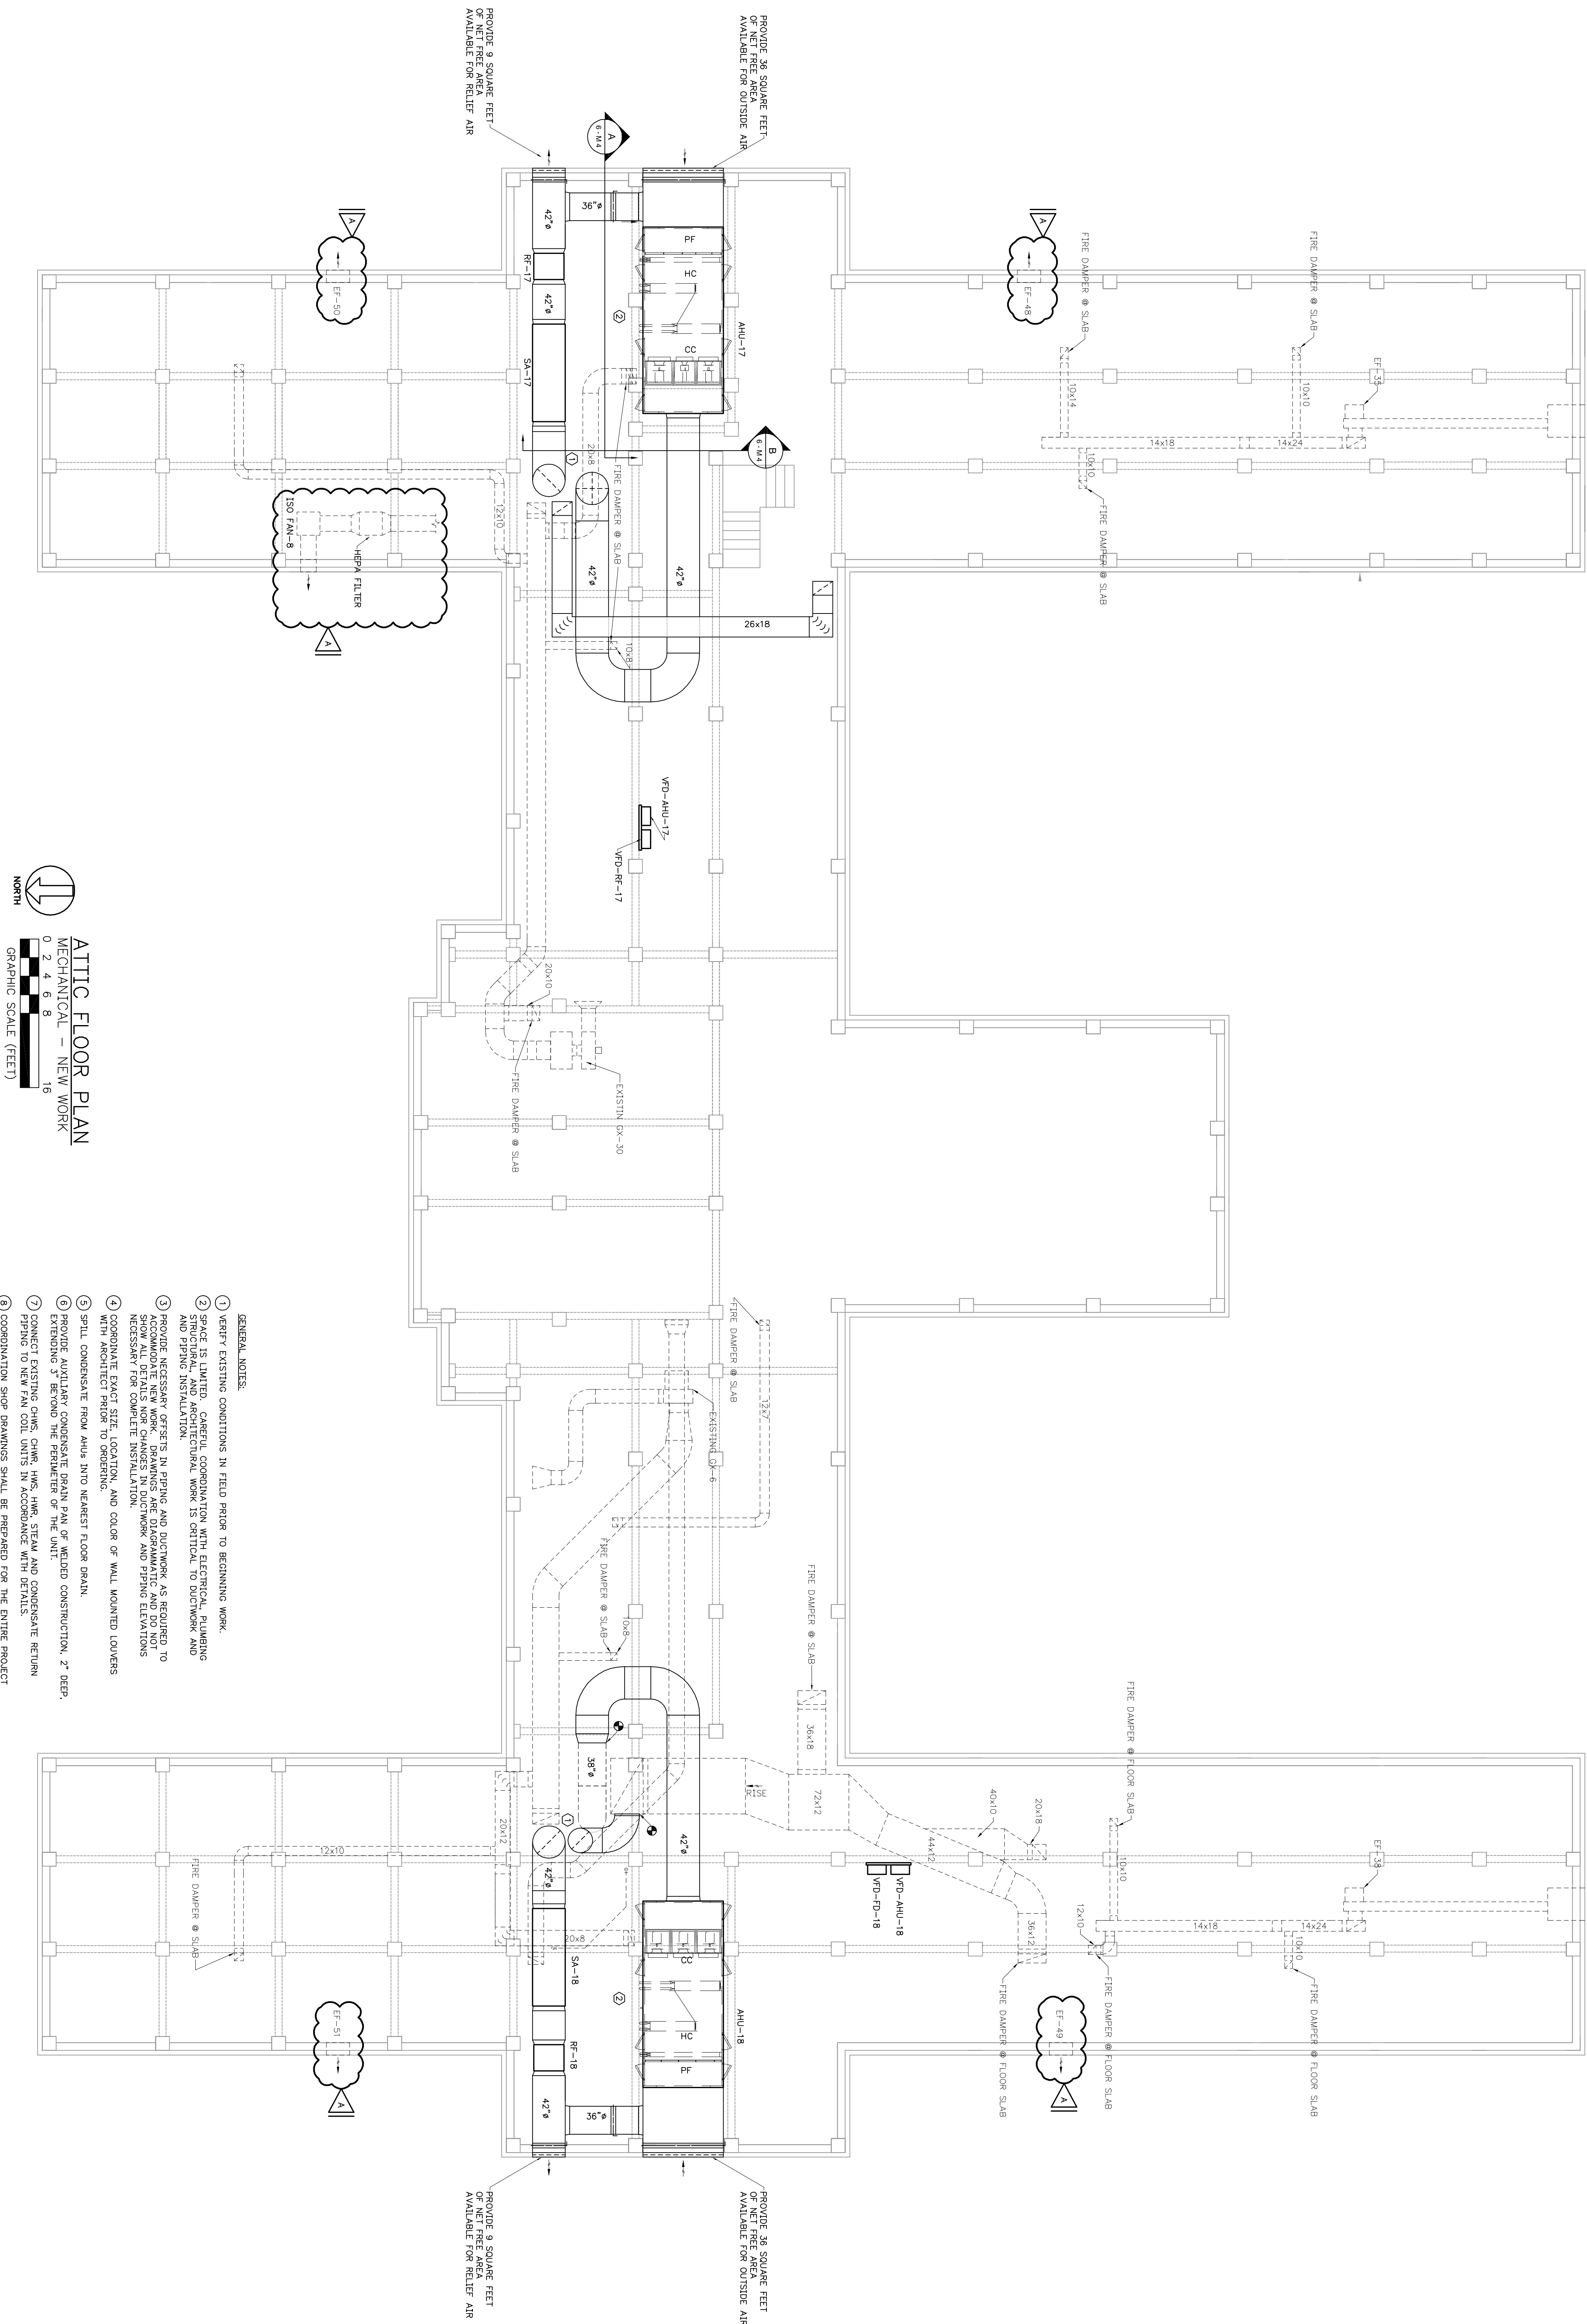


DRAWING NOTES:

① SEE RISER DIAGRAM ON DRAWING 6-M9 FOR TIE-IN TO EXISTING RETURN IN CHASE.

② SEE LARGE SCALE PLANS DRAWING 6-M7 FOR PIPING CONNECTIONS

ATTIC FLOOR PLAN
MECHANICAL - NEW WORK
0 2 4 6 8 16
GRAPHIC SCALE (FEET)