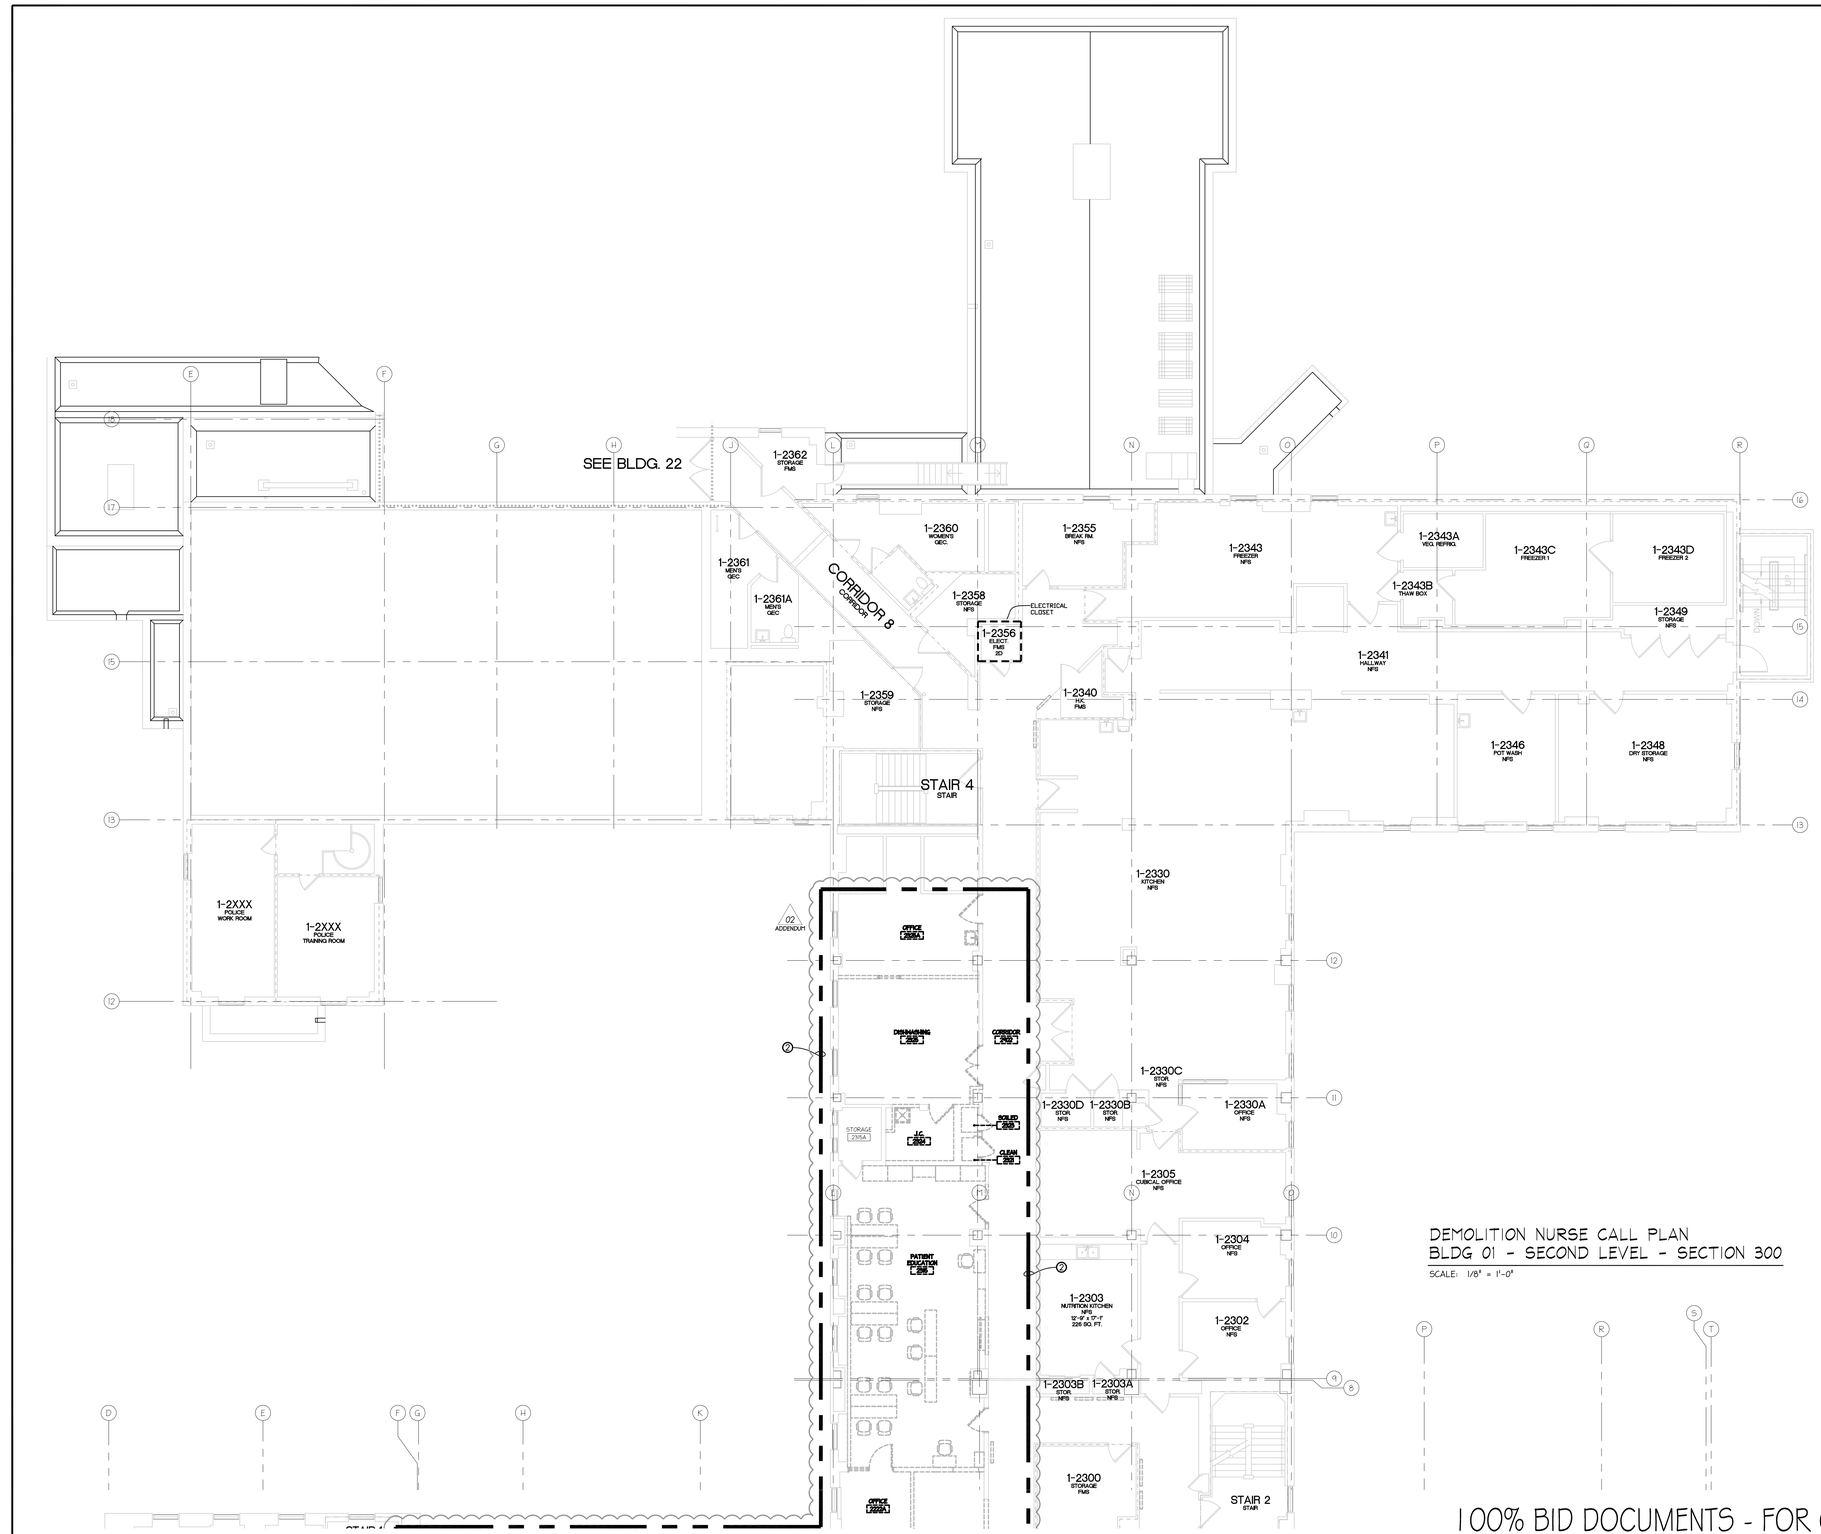

SYSTEMS DEMOLITION KEYED NOTES:

GENERAL NOTES:

1. WHERE DEVICES ARE SHOWN TO BE DEMOLISHED IN WALLS THAT ARE SHOWN TO REMAIN, REMOVE BOX, CONDUIT, AND CONDUCTORS BACK TO SOURCE. ABANDON CONDUIT IN WALL. PATCH WALL AND PAINT TO MATCH EXISTING. IF THERE ARE OTHER DEVICES REMAINING ON THE BRANCH CIRCUIT, PROTECT THE INTEGRITY OF THE CIRCUIT AND MAINTAIN POWER TO THE DEVICES.
2. DEVICES BEING DEMOLISHED SHALL BE PRESENTED TO OWNER FOR SALVAGE. IF UNWANTED DISPOSE OF DEVICES PROPERLY.
3. DEMOLISH EXISTING NURSE CALL DEVICES AS INDICATED UNLESS IDENTIFIED OTHERWISE ON CONSTRUCTION DRAWING. DEMOLISH ALL ASSOCIATED BOXES, CONDUITS AND CABLES BACK TO SOURCE OR TO THE EXTENT OF WHICH THE INTEGRITY OF ANY DEVICES ARE MAINTAINED.

KEYED NOTES:

1. DEVICES IN THIS AREA ARE NEW AS A RESULT OF RECENT RENOVATION. DEVICES MAY REMAIN OR BE REPLACED AS REQUIRED, BUT MUST INTEGRATE WITH THE NEW CAMPUS SYSTEM MANUFACTURER. (02 ADDENDUM)
2. THIS AREA IS BEING DEMOLISHED AS PART OF THE SCOPE OF A SIMULTANEOUS PROJECT (EXISTING DEVICES ARE PROVIDED FOR REFERENCE ONLY).

NURSE CALL SYMBOLS

$_{X}$	DOME LIGHT 2G - 1"C X: NONE = WALL (MH = 2' ABOVE DOOR) C = CEILING Z = ZONE	BNDL
①	SINGLE PATIENT STATION 3G - 44" MH - 1"C	BN1
②	DUAL PATIENT STATION 3G - 44" MH - 1"C	BN2
③	DUAL PUSH BUTTON/CUSTOM 1G - 44" MH - 3/4"C	BN3
④	BATH PULL STATION 1G - 44" - 3/4"C (TOILET) 1G - 68" - 3/4"C (SHOWER)	BN4
⑥	DUTY STATION 3G - 44" MH - 3/4"C	BN6
⑦	STAFF STATION 3G - 44" MH - 3/4"C	BN7
⑧	STAFF ASSIST/CODE BLUE 1G - 44" MH - 3/4"C	BN8
⑩	PUSH FOR HELP 1G - 44" MH - 3/4"C	BN10
⑪	STAFF REGISTRATION 1G - 44" MH - 3/4"C	BN11
⑫	NC4 JACK 1G - 44" MH - 3/4"C	BN12
(M)	SPECIALTY PLATE	BNM
(N)$_{LCD}$	MASTER STATION 1G - 16" MH - 3/4"C	BNLCD
(N)$_{TSM}$	MASTER STATION 1G - 16" MH - 3/4"C	BNTSM
(CB)	CODE BLUE 1G - 44" MH - 3/4"C	BNCB
(CP)	CODE PINK/BABY MISSING 1G - 44" MH - 3/4"C	BNCP
(BM)	BABY MISSING 1G - 44" MH - 3/4"C	BNBM
(SA)	STAFF ASSIST 1G - 44" MH - 3/4"C	BNSA
(U)	UNIVERSAL INTERFACE 3G - ABOVE CEILING - 3/4"C	BNU
(CC)	CALL CORD	BNCC
(PS)	PILLOW SPEAKER	BNPS
(TV)	TV CONTROL 3/4"C PATH FROM BED STATION TO TV	BNTV
(37)	37 PIN BED CONNECTOR 1G - 16" MH - 3/4"C	BN37
(BL)	BED LIGHT CONTROL 3/4"C PATH FROM BED STATION TO LIGHT	BNBL
NCC	NURSE CALL TERMINAL CABINET SURFACE WALL MOUNT 30" x 30" (2) 2"C (1) 20AMP VAC PER CABINET (EMERGENCY) OBTAIN QUANITY FROM VENDOR	BNUR
(B-B-B)	GCM#-JBUS#-ID#	BNGCM

DEMOLITION NURSE CALL PLAN
BLDG 01 - SECOND LEVEL - SECTION 300

SCALE: 1/8" = 1'-0"

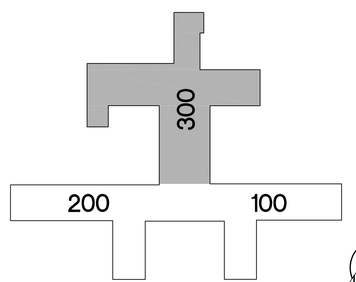

KEY PLAN

NORTH

100% BID DOCUMENTS - FOR CONSTRUCTION

Revisions	Date
35% SCHEMATIC SUBMISSION	03/14/2014
65% DESIGN DEVELOPMENT SUBMISSION	05/23/2014
95% CONSTRUCTION DOCUMENT SUBMISSION	08/08/2014
100% BID DOCUMENT SUBMISSION	05/19/2016
ADDENDUM 02	01/04/2017

CONSULTANTS:

ARCHITECT/ENGINEERS:

DIEKEMA HAMANN
architecture+engineering
612 South Park Street
Kalamazoo, Michigan 49007
15 Ionia Ave SW
Grand Rapids, Michigan 49503
TL 269.373.1108
FX 269.373.1186

Drawing Title: DEMOLITION NURSE CALL PLAN BLDG 01 - SECOND LEVEL - SECTION 300

Approved: Project Director

Project Title: NURSE CALL SYSTEM REPLACEMENT BUILDINGS 1 AND 22

Location: ALEDA E. LUTZ VA MEDICAL CENTER

Date: MAY 19, 2016 | Checked: PN | Drawn: SH

Project Number: 655-13-113

Building Number: 01

Drawing Number: 01-ES9 Dwg. 11 of 45

Office of Construction and Facilities Management

Department of Veterans Affairs

VA FORM 08-6231

DHAE PROJECT NO.: 13102.00 FILE NAME: B01-E2.2.DWG