


three inches = one foot
 one and one half inches = one foot
 one inch = one foot
 one inch = one foot
 three quarters inch = one foot
 one half inch = one foot
 one half inch = one foot
 three eighths inch = one foot
 one quarter inch = one foot
 one eighth inch = one foot
 one eighth inch = one foot


- SYSTEMS NOTES:**
- GENERAL NOTES:**
 1. UNLESS OTHERWISE NOTED, COORDINATE EXACT MOUNTING HEIGHTS OF ALL DEVICES WITH ARCHITECTURAL INTERIOR ELEVATIONS.
 ALL NURSE CALL SYSTEM CONDUITS SHALL BE FACTORY APPLIED COLOR YELLOW AND LABELED ON 5' CENTERS PER WRITTEN SPECIFICATIONS (INCLUDING EXISTING CONDUITS BEING RE-USED).
- KEYED NOTES:**
 1. ONLY IF MANUFACTURER'S TOILET EMERGENCY STATIONS CANNOT INCLUDE INTEGRAL AUDIO FEATURE, PROVIDE AND INSTALL DUTY STATION ADJACENT TO ALL TOILET EMERGENCY STATIONS TO ALLOW AUDIO COMMUNICATION BETWEEN CARE PROVIDER (TYPICAL ALL TOILET LOCATIONS ON LEVELS 1 & 2 OF BUILDING 22).
 2. PROVIDE AND INSTALL CONNECTION TO 4 PROGRAMMING OF MIDDLEWARE FOR AUTOMATIC TRANSMISSION OF ELOPEMENT ALARMS TO CARE PROVIDER MOBILE DEVICES.
 3. STAFF STATION ALONG CORRIDOR TO BE LOCATED 66" TO CENTER OF BOX (TYPICAL ALL LOCATIONS IN CORRIDOR ON LEVELS 1 & 2 OF BUILDING 22).

NURSE CALL SYMBOLS		
	DOME LIGHT 2G - 1'C X1 NONE - WALL (1'H = 2' ABOVE DOOR) C - CEILING	ENDL
	SINGLE PATIENT STATION 3G - 44" MH - 1'C	BN1
	DUAL PATIENT STATION 3G - 44" MH - 1'C	BN2
	DUAL PUSH BUTTON/CUSTOM 1G - 44" MH - 3/4"C	BN3
	BATH PULL STATION 1G - 44" - 3/4"C (TOILET) 1G - 68" - 3/4"C (SHOWER)	BN4
	DUTY STATION 3G - 44" MH - 3/4"C	BN6
	STAFF STATION 3G - 44" MH - 3/4"C	BN7
	STAFF ASSIST/CODE BLUE 1G - 44" MH - 3/4"C	BN8
	PUSH FOR HELP 1G - 44" MH - 3/4"C	BN10
	STAFF REGISTRATION 1G - 44" MH - 3/4"C	BN11
	NCA JACK 1G - 44" MH - 3/4"C	BN12
	SPECIALTY PLATE	BN1
	MASTER STATION 1G - 16" MH - 3/4"C	BNLCD
	MASTER STATION 1G - 16" MH - 3/4"C	BNTSM1
	CODE BLUE 1G - 44" MH - 3/4"C	BNCB
	CODE PINK/BABY MISSING 1G - 44" MH - 3/4"C	BNCP
	BABY MISSING 1G - 44" MH - 3/4"C	BNBM1
	STAFF ASSIST 1G - 44" MH - 3/4"C	BNSA
	UNIVERSAL INTERFACE 3G - ABOVE CEILING - 3/4"C	BNU
	CALL CORD	BNCC
	PILLOW SPEAKER	BNPS
	TV CONTROL 3/4"C PATH FROM BED STATION TO TV	BNTV
	37 PIN BED CONNECTOR 1G - 16" MH - 3/4"C	BN37
	BED LIGHT CONTROL 3/4"C PATH FROM BED STATION TO LIGHT	BNBL
	NURSE CALL CONTROL CABINET SURFACE WALL MOUNT 30" x 30" (1) 20AMP VAC PER CABINET (EMERGENCY) OBTAIN QUANTITY FROM VENDOR	BNUR
	GCM#-JBUS#-ID#	BNGCM1

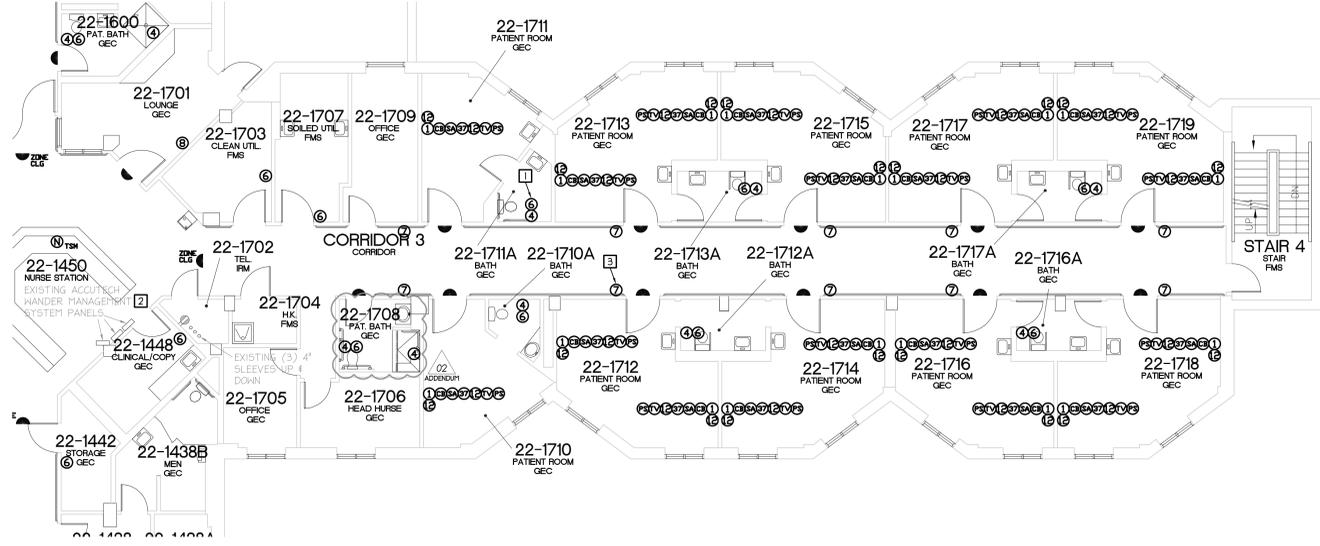

NURSE CALL PLAN
 BLDG 22 - FIRST LEVEL - SECTION 700
 SCALE: 1/8" = 1'-0"

100% BID DOCUMENTS - FOR CONSTRUCTION

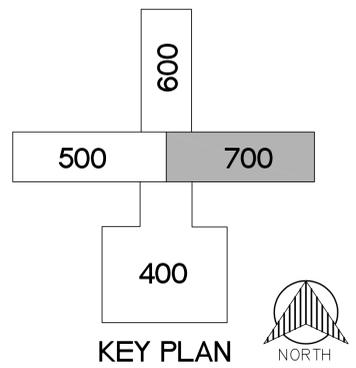

Revisions	Date

CONSULTANTS:

ARCHITECT/ENGINEERS:



DIEKEMA HAMANN
 architecture+engineering
 612 South Park Street
 Kalamazoo, Michigan 49007
 15 Ionia Ave SW
 Grand Rapids, Michigan 49503
 TL 269.373.1108
 FX 269.373.1186

Drawing Title NURSE CALL PLAN BLDG 22 - FIRST LEVEL - SECTION 700
Approved Project Director

Project Title NURSE CALL SYSTEM REPLACEMENT BUILDINGS 1 AND 22	Project Number 655-13-113
Location ALEDA E. LUTZ VA MEDICAL CENTER	Building Number 22
Date MAY 19, 2016	Checked PN
Drawn SH	Drawing Number 22-ES20 Dwg. 22 of 27

Office of Construction and Facilities Management



Department of Veterans Affairs