



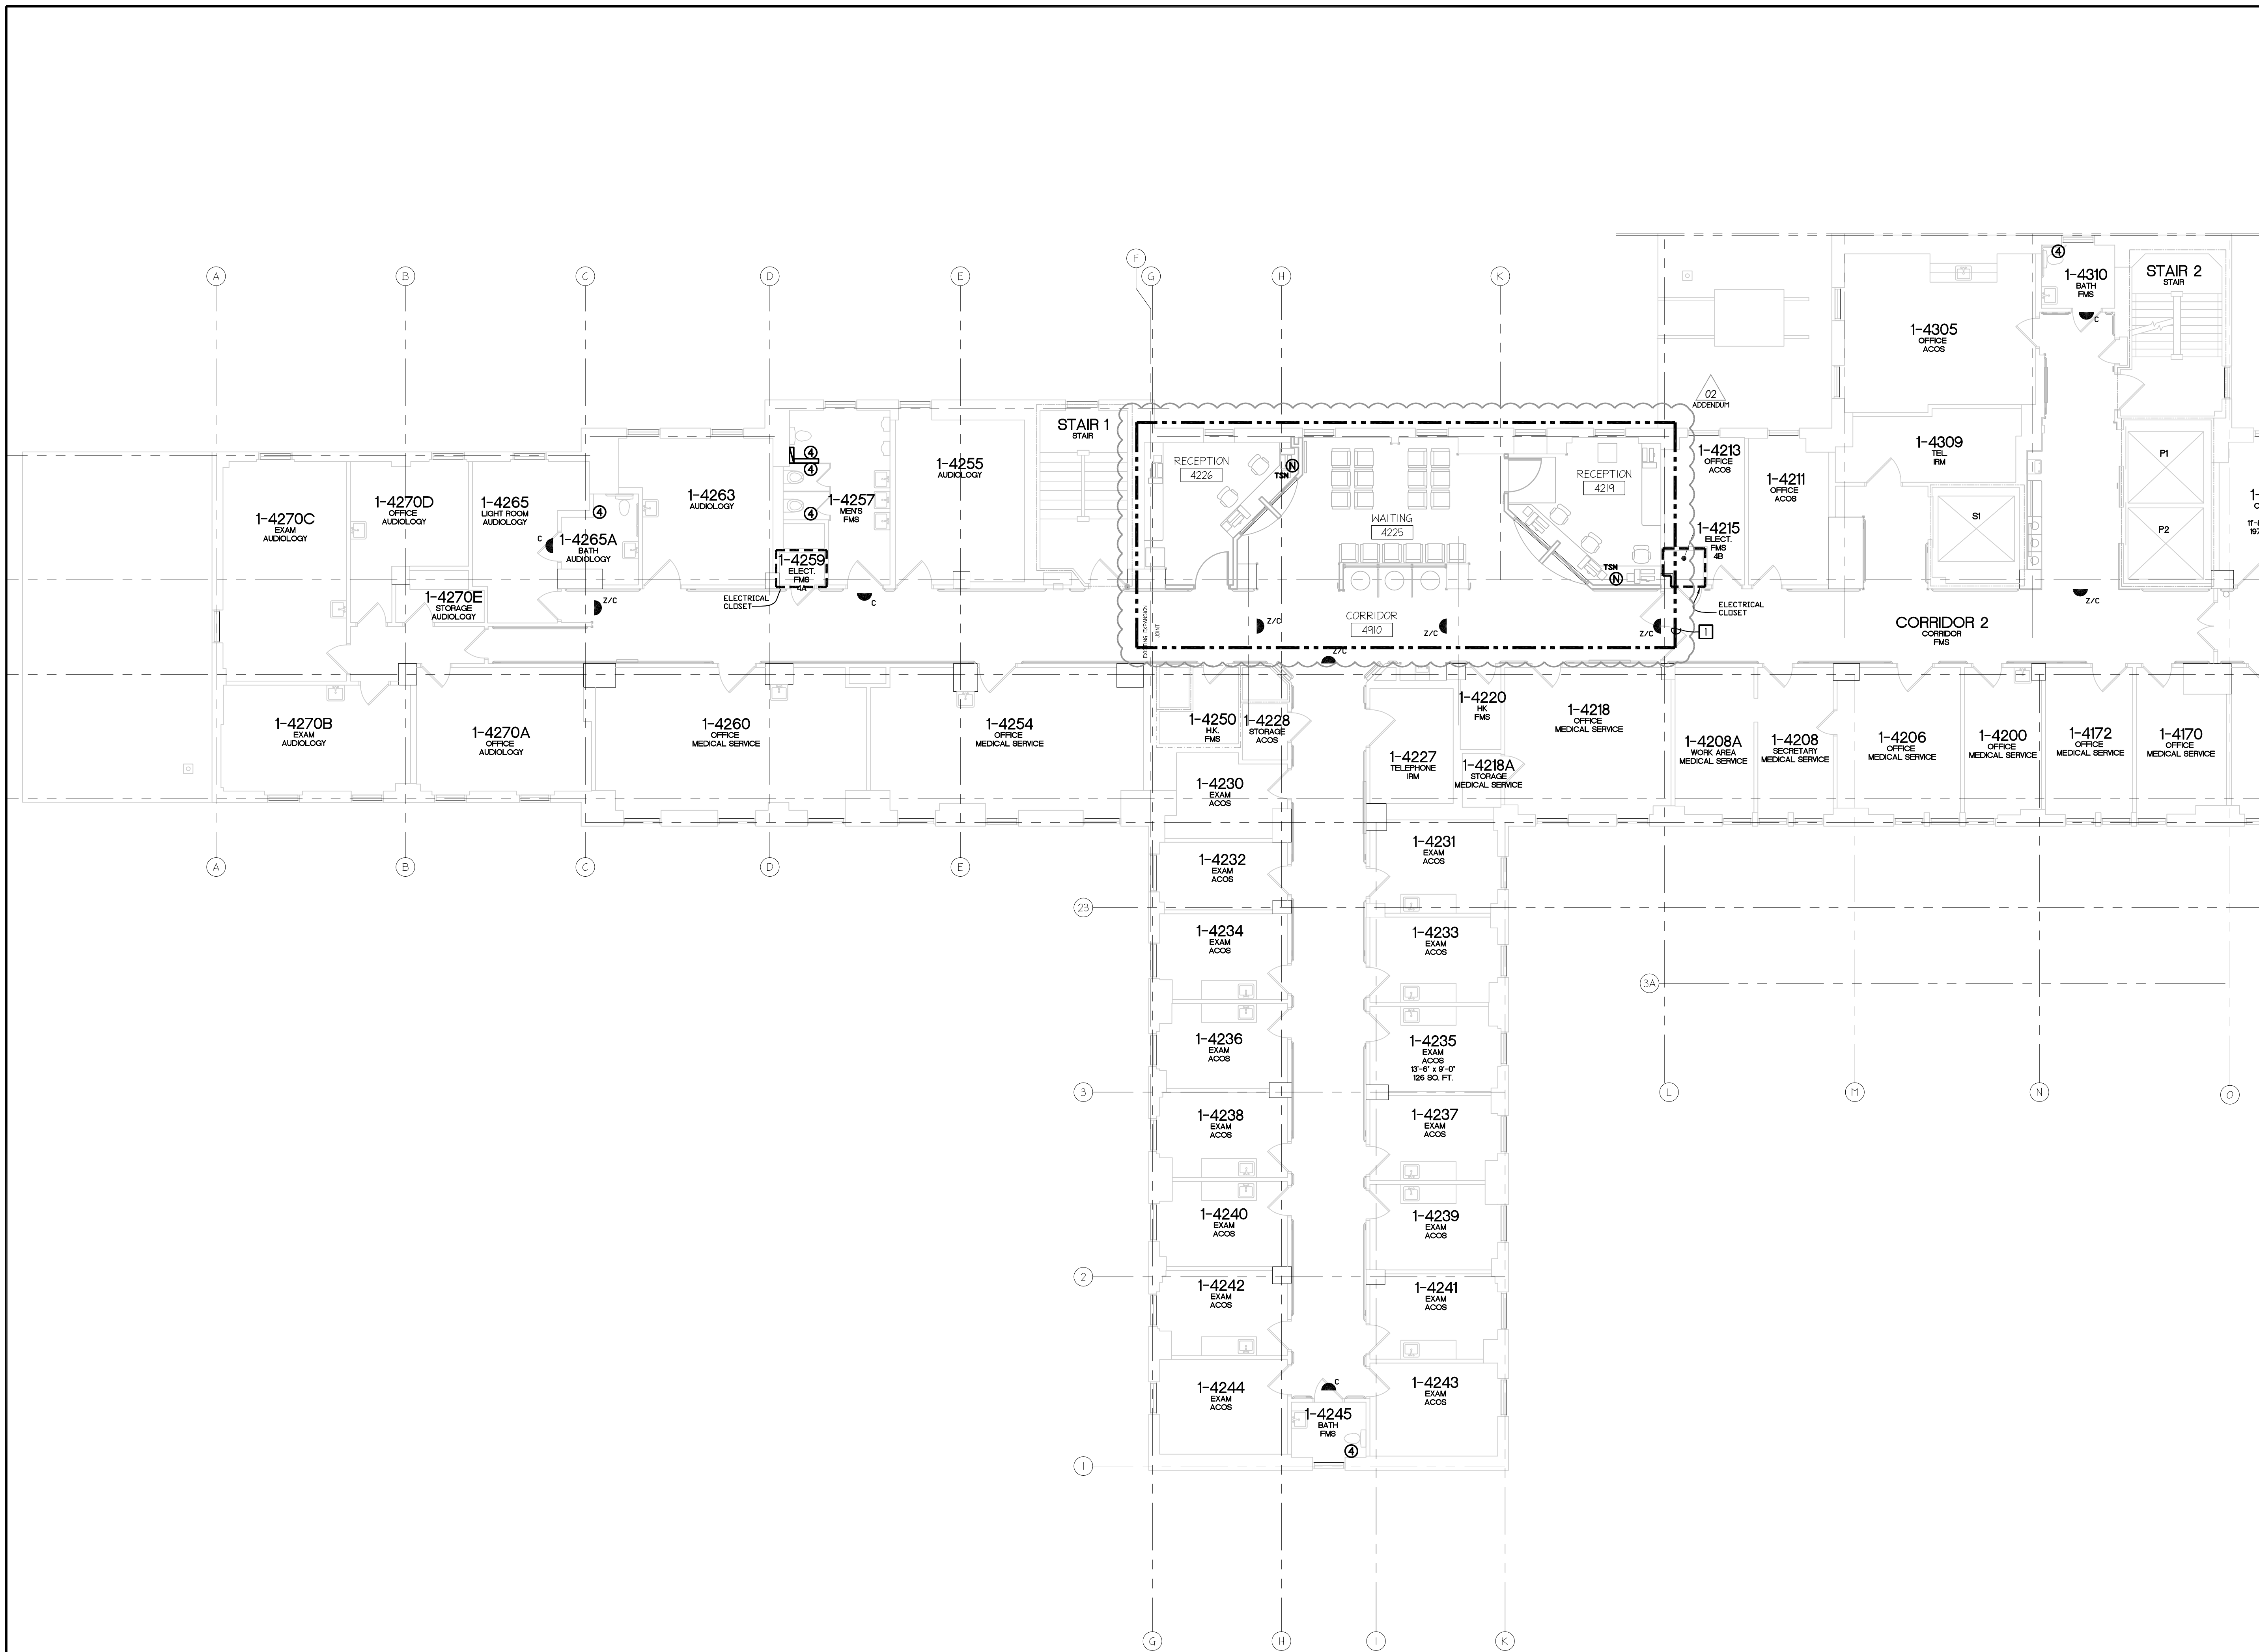

NURSE CALL PLAN
BLDG 01 - FOURTH LEVEL - SECTION 200
SCALE: 1/8" = 1'-0"

- SYSTEMS NOTES:**
- GENERAL NOTES:**
1. ALL NURSE CALL SYSTEM CONDUITS SHALL BE FACTORY APPLIED COLOR YELLOW AND LABELED ON 5' CENTERS PER WRITTEN SPECIFICATIONS (INCLUDING EXISTING CONDUITS BEING RE-USED).
- KEYED NOTES:**
1. THIS AREA IS BEING RENOVATED AS PART OF THE SCOPE OF A SIMULTANEOUS PROJECT. COORDINATE ROUGH-IN SCHEDULE WITH COR. PROVIDE AND INSTALL ALL OTHER NURSE CALL SYSTEM COMPONENTS (INCLUDING BUT NOT LIMITED TO CABLING, TERMINATIONS, DEVICES, LABELING, & PROGRAMMING).

NURSE CALL SYMBOLS		
	DOME LIGHT 2G - 1'C X: NONE = WALL (1'H = 2" ABOVE DOOR) C = CEILING Z = ZONE	BNL
	SINGLE PATIENT STATION 3G - 44" MH - 1'C	BN1
	DUAL PATIENT STATION 3G - 44" MH - 1'C	BN2
	DUAL PATIENT STATION/CUSTOM IG - 44" MH - 3/4"C	BN3
	BATH PULL STATION IG - 44" - 3/4"C (TOILET) IG - 68" - 3/4"C (SHOWER)	BN4
	DUTY STATION 3G - 44" MH - 3/4"C	BN6
	STAFF STATION 3G - 44" MH - 3/4"C	BN7
	STAFF ASSIST/CODE BLUE IG - 44" MH - 3/4"C	BN8
	PUSH FOR HELP IG - 44" MH - 3/4"C	BN10
	STAFF REGISTRATION IG - 44" MH - 3/4"C	BN11
	NC4 JACK IG - 44" MH - 3/4"C	BN12
	SPECIALTY PLATE	BNM
	MASTER STATION IG - 16" MH - 3/4"C	BNLCD
	MASTER STATION IG - 16" MH - 3/4"C	BN15M
	CODE BLUE IG - 44" MH - 3/4"C	BNCB
	CODE PINK/BABY MISSING IG - 44" MH - 3/4"C	BNCP
	BABY MISSING IG - 44" MH - 3/4"C	BNBM
	STAFF ASSIST IG - 44" MH - 3/4"C	BNSA
	UNIVERSAL INTERFACE 3G - ABOVE CEILING - 3/4"C	BNU
	CALL CORD	BNCC
	PILLOW SPEAKER	BNPS
	TV CONTROL 3/4"C PATH FROM BED STATION TO TV	BNTV
	37 PIN BED CONNECTOR IG - 16" MH - 3/4"C	BN37
	BED LIGHT CONTROL 3/4"C PATH FROM BED STATION TO LIGHT	BNBL
	NURSE CALL TERMINAL CABINET SURFACE WALL MOUNT 30" x 30" (2) 2"C (1) 20AMP VAC PER CABINET (EMERGENCY) OBTAIN QUANTITY FROM VENDOR	BNUR
	GCM#-JEUS#-ID#	BN10M

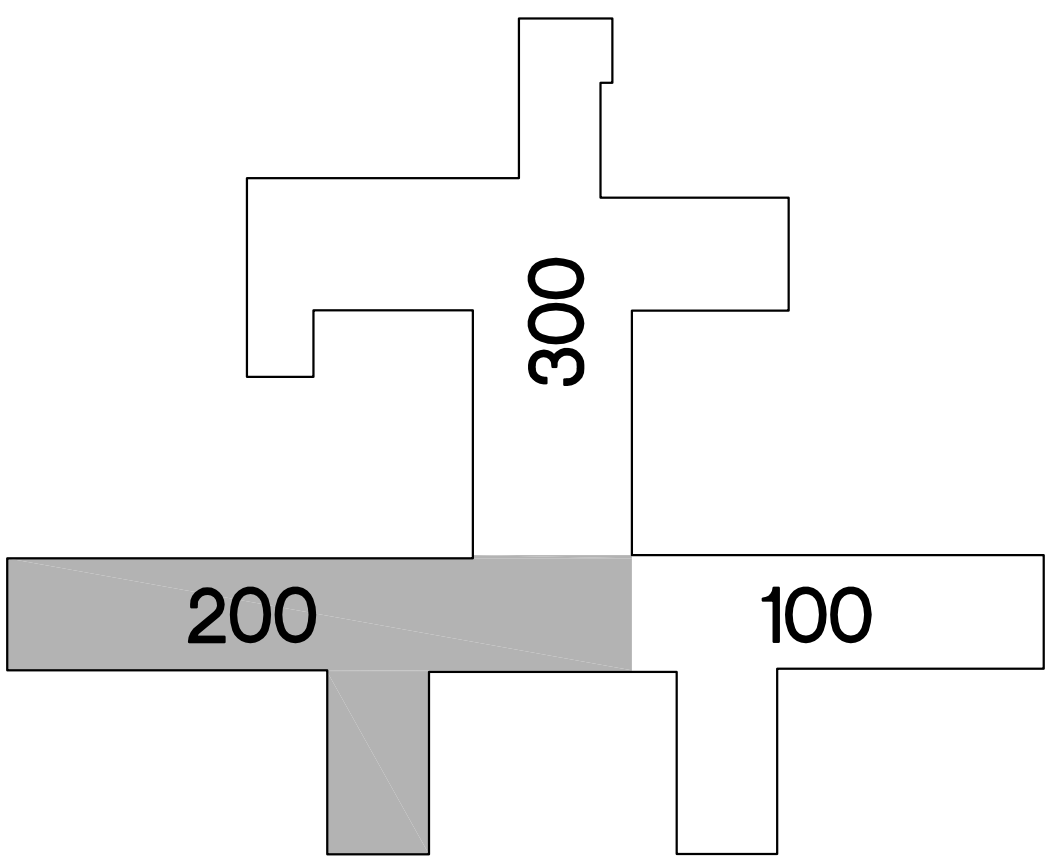

KEY PLAN

35% SCHEMATIC SUBMISSION	03/14/2014
65% DESIGN DEVELOPMENT SUBMISSION	05/23/2014
95% CONSTRUCTION DOCUMENT SUBMISSION	08/08/2014
100% BID DOCUMENT SUBMISSION	05/19/2016
ADDENDUM 02	01/04/2017
Revisions	Date

CONSULTANTS:

ARCHITECT/ENGINEERS:



DIEKEMA HAMANN
architecture+engineering
612 South Park Street
Kalamazoo, Michigan 49007
15 Ionia Ave SW
Grand Rapids, Michigan 49503
TL 269.373.1108
FX 269.373.1186

Drawing Title
NURSE CALL PLAN
BLDG 01 - FOURTH LEVEL -
SECTION 200

Approved Project Director

Project Title
NURSE CALL SYSTEM
REPLACEMENT
BUILDINGS 1 AND 22

Location
ALEDA E. LUTZ VA MEDICAL CENTER

Date
MAY 19, 2016

Checked
PN

Drawn
SH

Project Number
655-13-113

Building Number
01

Drawing Number
01-ES35
Dwg. 37 of 45

Office of
Construction
and Facilities
Management

