


End of activity at
entrance of Lot

Represent end of
active for North Lot

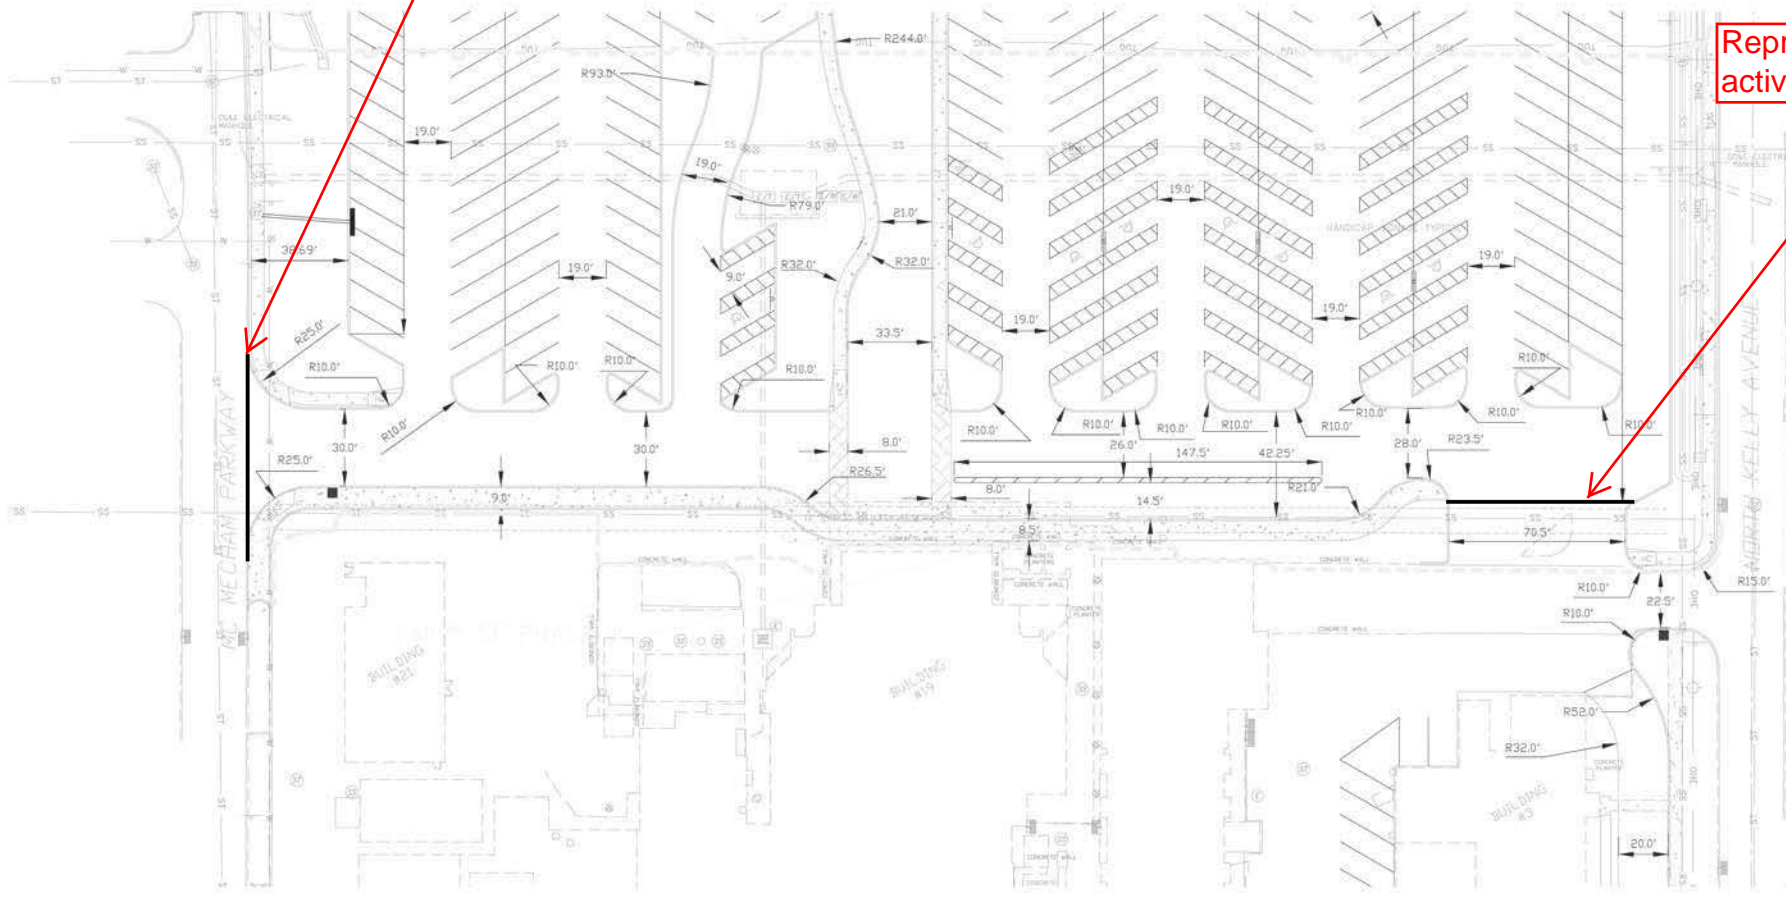

Drawing Title		Project Title		Date	
North Parking Lot		Repair North Parking Lot		JUNE 1, 2004	
Approved: Design Chief		Building Number		Project No.	
				635-304	
Approved: Service Chief		Location		Drawing No.	
		VA MEDICAL CENTER OKLAHOMA CITY, OKLAHOMA		C-1	
				The C20 of C33	

DEPARTMENT of
VETERANS AFFAIRS