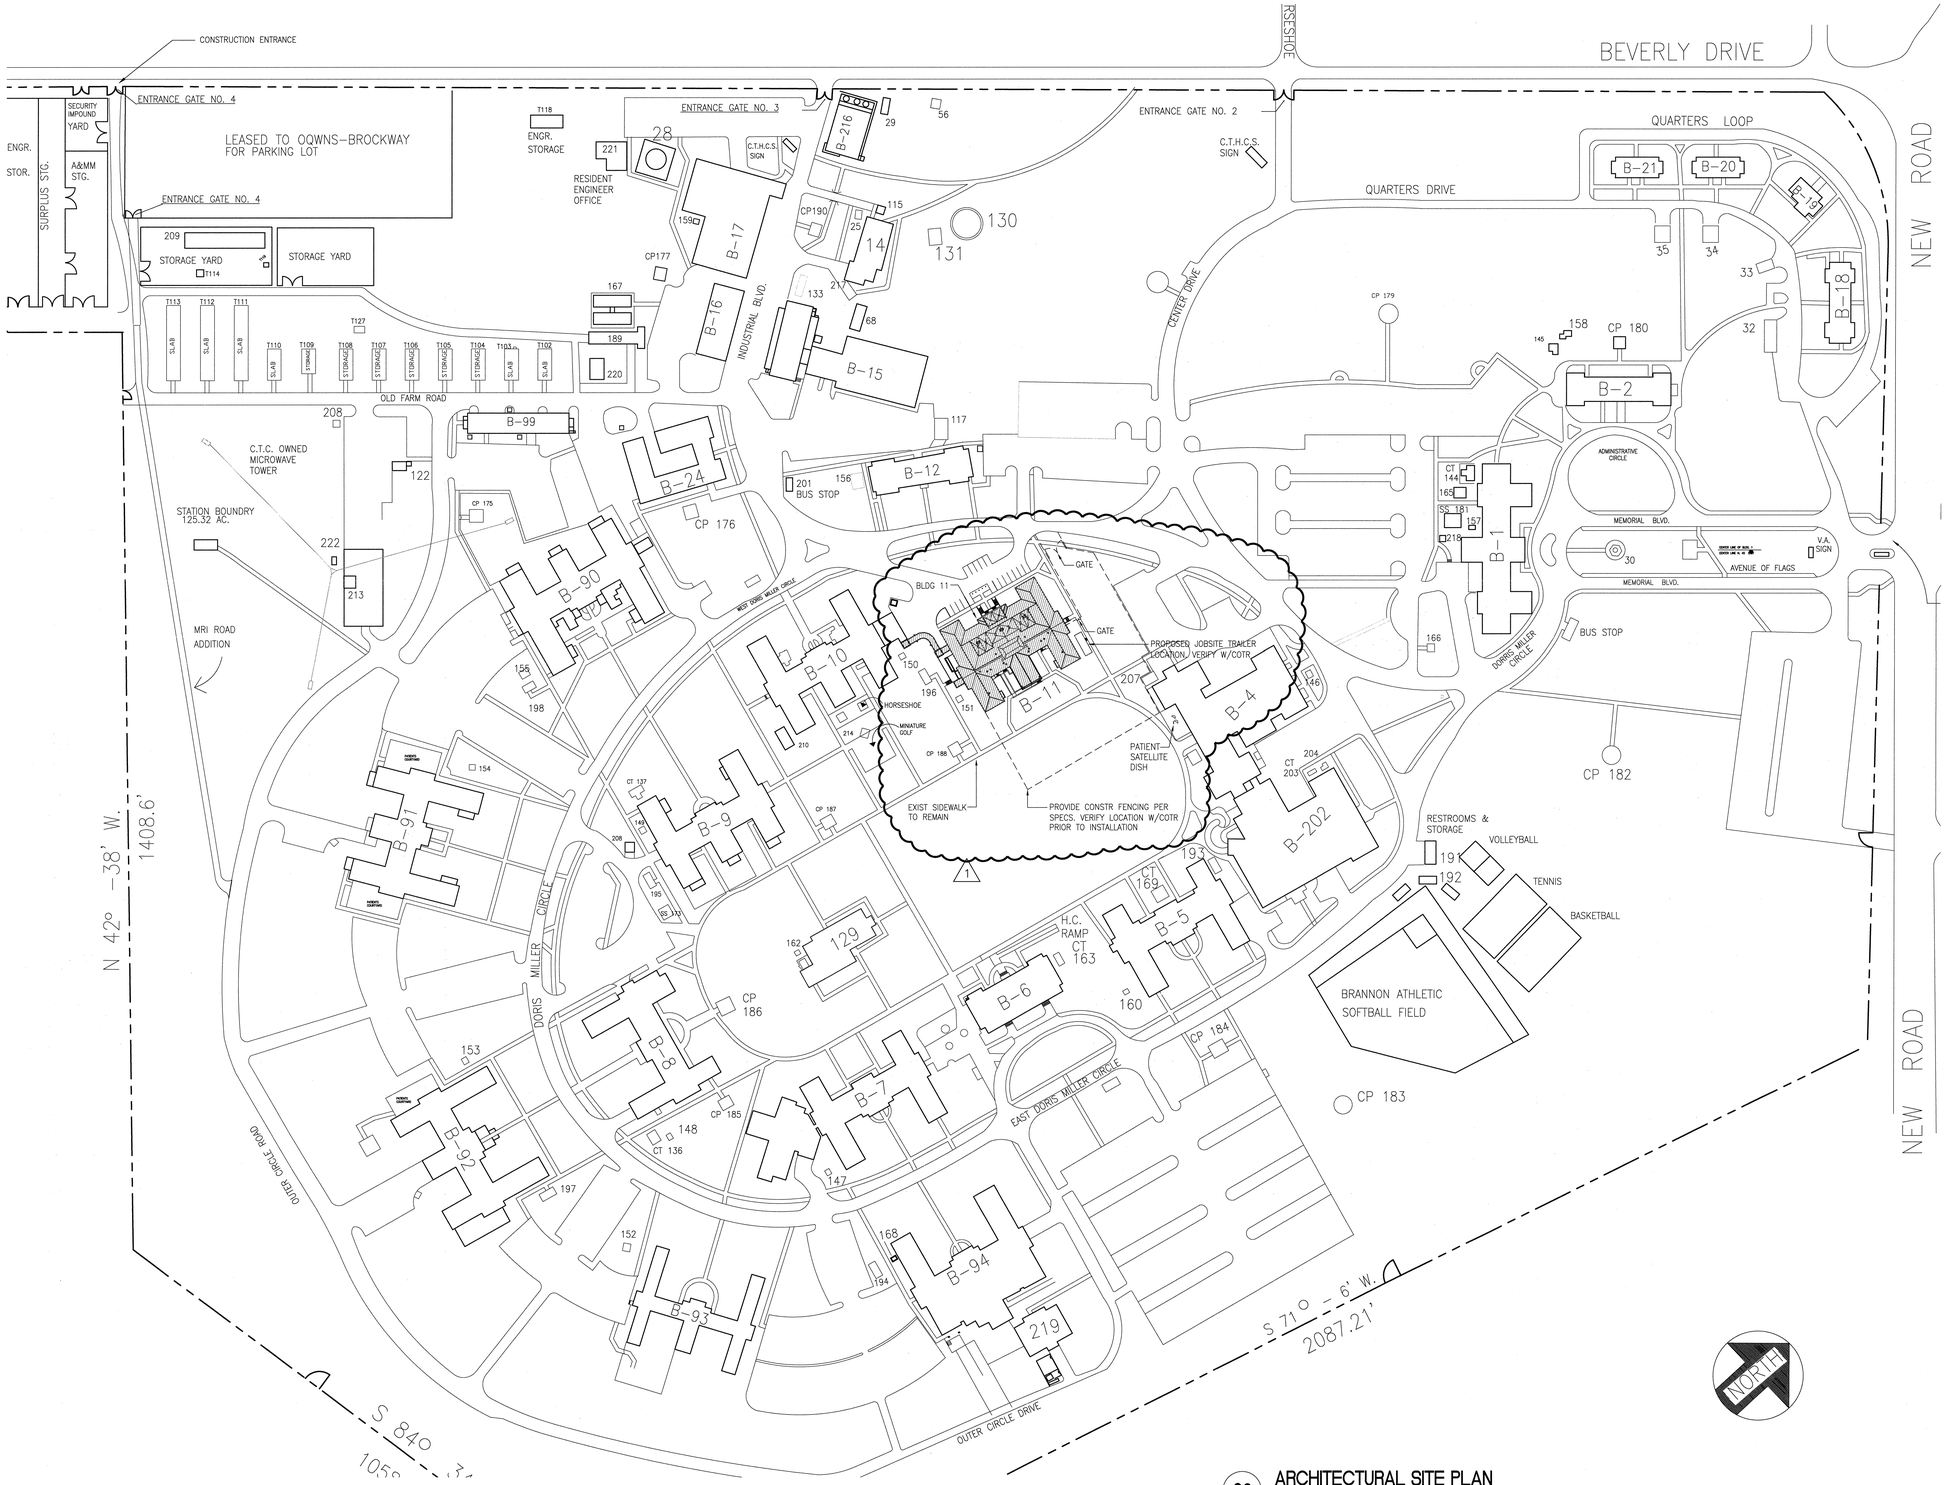

02 ARCHITECTURAL SITE PLAN

1"=100'-0"

GENERAL

COVER SHEET

11-AGI-0.00R	DRAWING INDEX & ARCHITECTURAL SITE PLAN
11-AGI-0.01	ABBREVIATIONS, LEGENDS, & SYMBOLS
11-AGI-0.02	NATIONAL EVALUATION REPORT NO. NER-243
11-AGI-0.03	CODE, LIFE SAFETY, & MISC SIGNAGE
11-AGI-0.04	PROPOSED CONSTRUCTION PHASING PLAN

CIVIL

C 0.1	DEMOLITION PLAN
C 1.0	CIVIL SITE PLAN
C 2.0	CIVIL GRADING PLAN
C 2.1	STORM WATER POLLUTION PREVENTION PLAN
C 3.0	UTILITY PLAN
C 4.0	CIVIL DETAILS

STRUCTURAL

11-SS-1.01	GENERAL NOTES
11-SS-1.02	GENERAL NOTES
11-SS-2.01	FOUNDATION PLAN, FIRST & SECOND FLOOR FRAMING PLANS
11-SS-2.02	PENTHOUSE & ROOF FRAMING PLANS
11-SS-3.01	BASEMENT & FOUNDATION DETAILS
11-SS-3.02	FOUNDATION DETAILS
11-SS-4.01	FRAMING DETAILS
11-SS-4.02	FRAMING DETAILS

ARCHITECTURAL

11-AD-1.00R	DEMOLITION PLANS & ELEVATION
11-AD-1.01	FIRST & SECOND FLOOR DEMOLITION PLANS
11-AS-1.00	BASEMENT FLOOR PLAN
11-AS-1.01	FIRST FLOOR PLAN
11-AS-1.02	SECOND FLOOR PLAN
11-AS-1.03R	ROOF & ATTIC PLANS
11-AS-1.04	BASEMENT, FIRST, & SECOND FLOOR FINISHES PLANS-NEW ADDITION
11-AS-1.05	FIRST & SECOND FLOOR FINISHES PLANS-BLDG 11
11-AS-1.06R	BASEMENT, FIRST, & SECOND FLOOR EQUIPMENT PLANS-NEW ADDITION
11-AS-1.07R	FIRST & SECOND FLOOR EQUIPMENT PLANS-BLDG 11
11-AS-1.08	BASEMENT REFLECTED CEILING PLAN – NEW ADDITION
11-AS-1.09	FIRST FLOOR REFLECTED CEILING PLAN-BLDG 11 & NEW ADDITION
11-AS-1.10	SECOND FLOOR REFLECTED CEILING PLAN-BLDG 11 & NEW ADDITION
11-AS-2.00	INTERIOR ELEVATIONS – BASEMENT
11-AS-2.01R	INTERIOR ELEVATIONS – BASEMENT
11-AS-2.02R	INTERIOR ELEVATIONS – BASEMENT
11-AS-2.03R	INTERIOR ELEVATIONS – FIRST FLOOR
11-AS-2.04R	INTERIOR ELEVATIONS – FIRST FLOOR
11-AS-2.05R	INTERIOR ELEVATIONS – SECOND FLOOR
11-AS-2.06R	INTERIOR ELEVATIONS – SECOND FLOOR
11-AS-2.07R	INTERIOR ELEVATIONS – FIRST & SECOND FLOORS
11-AS-2.08R	INTERIOR ELEVATIONS – FIRST & SECOND FLOORS
11-AS-2.09R	INTERIOR ELEVATIONS – BASEMENT, FIRST, & SECOND FLOORS
11-AS-3.00	EXTERIOR BUILDING ELEVATIONS
11-AS-3.01	BUILDING SECTIONS & DETAILS
11-AS-3.02	EXTERIOR WALL SECTIONS
11-AS-3.03	EXTERIOR WALL SECTIONS
11-AS-3.04	PHOTOGRAPHS OF EXISTING CONDITIONS
11-AS-4.00	ENLARGED BASEMENT FLOOR PLAN-NEW ADDITION
11-AS-4.01	ENLARGED FIRST FLOOR PLAN-NEW ADDITION
11-AS-4.02	ENLARGED FIRST FLOOR PLAN-BLDG 11
11-AS-4.03	ENLARGED SECOND FLOOR PLAN-NEW ADDITION
11-AS-4.04	ENLARGED SECOND FLOOR PLAN-BLDG 11
11-AS-5.00	EXTERIOR SECTION DETAILS
11-AS-5.01	EXTERIOR SECTION DETAILS
11-AS-5.02R	EXTERIOR PLAN DETAILS
11-AS-5.03	EXTERIOR PLAN DETAILS
11-AS-5.04	INTERIOR PLAN & SECTION DETAILS
11-AS-5.05	CAST STONE TYPES & PROFILES
11-AS-5.06	CAST STONE TYPES & PROFILES
11-AS-5.10	MILLWORK DETAILS
11-AS-5.11R	MILLWORK DETAILS
11-AS-5.12R	MILLWORK DETAILS
11-AS-5.20	WINDOW SCHEDULE & DETAILS
11-AS-5.21	WINDOW DETAILS
11-AS-6.00	PARTITION TYPES
11-AS-6.01	DOOR SCHEDULE & DETAILS

FIRE PROTECTION

11-FG-0.01	FIRE PROTECTION GENERAL – COVER SHEET
11-FP-1.00	BASEMENT – AUTOMATIC SPRINKLER SYSTEM
11-FP-1.01	FIRST FLOOR – AUTOMATIC SPRINKLER SYSTEM
11-FP-1.02	SECOND FLOOR – AUTOMATIC SPRINKLER SYSTEM
11-FA-1.00	BASEMENT – FIRE ALARM SYSTEM
11-FA-1.01	FIRST FLOOR – FIRE ALARM SYSTEM
11-FA-1.02	SECOND FLOOR – FIRE ALARM SYSTEM
11-CR-1.00	BASEMENT – LIFE SAFETY PLAN
11-CR-1.01	FIRST FLOOR – LIFE SAFETY PLAN
11-CR-1.02	SECOND FLOOR – LIFE SAFETY PLAN

PLUMBING

11-PL-0.01	PLUMBING LEGEND AND SYMBOLS
11-PL-1.00	PLUMBING BASEMENT & UNDERFLOOR PLAN
11-PL-1.01	PLUMBING LEVEL 1 FLOOR PLAN
11-PL-1.02	PLUMBING LEVEL 2 FLOOR PLAN
11-PL-1.03	PLUMBING ROOF PLAN
11-PL-1.04	PLUMBING LEVEL 1 AND 2 DEMO PLANS
11-PL-2.01	PLUMBING RISERS
11-PL-5.01	PLUMBING DETAILS
11-PL-6.01	PLUMBING SCHEDULES AND NOTES

MECHANICAL

11-MH-0.01	ABBREVIATIONS, SYMBOLS, AND GENERAL NOTES
11-MH-0.02	AIR FLOW DIAGRAM, TEMPERATURE CONTROL DIAGRAM AND SEQUENCE OF OPERATION
11-MH-1.00	MECHANICAL BASEMENT FLOOR PLAN
11-MH-1.01	MECHANICAL LEVEL 1 FLOOR PLAN
11-MH-1.02	MECHANICAL LEVEL 2 FLOOR PLAN
11-MH-1.03	MECHANICAL ATTIC FLOOR PLAN
11-MH-1.04	MECHANICAL LEVEL 1 DEMOLITION PLAN
11-MH-1.05	MECHANICAL LEVEL 2 DEMOLITION PLAN
11-MH-1.06	MECHANICAL BASEMENT PIPING PLAN
11-MH-1.07	MECHANICAL LEVEL 1 PIPING PLAN
11-MH-1.08	MECHANICAL LEVEL 2 PIPING PLAN
11-MH-4.01	MECHANICAL LARGE SCALE PLANS AND SECTIONS
11-MH-5.01	MECHANICAL DETAILS
11-MH-5.02	MECHANICAL DETAILS
11-MH-5.03	MECHANICAL DETAILS
11-MH-6.01	MECHANICAL SCHEDULES

ELECTRICAL

11-ES-0.00	NOTES, LEGEND AND ABBREVIATIONS, LOAD ANALYSIS
11-ES-1.00	BASEMENT FLOOR PLAN – POWER
11-ES-1.01	FIRST FLOOR PLAN – POWER
11-ES-1.02	SECOND FLOOR PLAN – POWER
11-ES-1.03	ROOF PLAN – ELECTRICAL
11-ES-1.04	ROOF PLAN – LIGHTNING PROTECTION
11-ES-1.05	ELECTRICAL LEVELS 1 & 2 DEMO PLANS
11-ES-2.00	BASEMENT FLOOR PLAN – LIGHTING
11-ES-2.01	FIRST FLOOR PLAN – LIGHTING
11-ES-2.02	SECOND FLOOR PLAN – LIGHTING
11-ES-3.00	BASEMENT FLOOR PLAN – SPECIAL SYSTEMS
11-ES-3.01	FIRST FLOOR PLAN – SPECIAL SYSTEMS
11-ES-3.02	SECOND FLOOR PLAN – SPECIAL SYSTEMS
11-ES-4.00	ELECTRICAL ONE LINE DIAGRAMS
11-ES-6.00	LIGHT FIXTURE SCHEDULE
11-ES-6.01	PANEL SCHEDULES
11-ES-6.02	PANEL SCHEDULES
11-ES-7.00	ELECTRICAL DETAILS

01 DRAWING SHEET INDEX

NO SCALE

Revisions:	Date
SCHEMATIC DESIGN SUBMISSION	08/02/10
DESIGN DEVELOPMENT SUBMISSION	09/03/10
CONSTRUCTION DOCUMENT SUBMISSION	11/22/10
ISSUED FOR BIDS	12/19/11
1 AMENDMENT NO. 04	04/05/12

CONSULTANTS:

REGISTERED ARCHITECT THOMAS R. WILSON 6173 STATE OF TEXAS 4-4-12

ARCHITECT/ENGINEERS:

WILSON ARCHITECTURAL GROUP
5051 WESTHEIMER, SUITE 200 HOUSTON, TEXAS 77056 TELEPHONE (713) 623-6794

MEP ENGINEERS	BURNS DeLATTE AND McCOY, INC.
STRUCTURAL ENGINEERS	PINNACLE STRUCTURAL
FIRE PROTECTION ENGINEERS	PROTECTION DEVELOPMENT INC.
CIVIL ENGINEERS	BREWER AND ESCALANTE

DO NOT SCALE THESE DRAWINGS. G.C. TO FIELD VERIFY DIMENSIONS

"ISSUED FOR BIDS" AMENDMENT NO. 04 FULLY SPRINKLERED

Drawing Title	DRAWING INDEX & ARCHITECTURAL SITE PLAN
Approved Project Director	
Project Title	BUILDING 11 ADDITION & INTERIOR RENOVATIONS
Location	WACO, TEXAS
Date	19 DEC 2011
Checked	
Drawn	
Project Number	674A4-CSI-516
Building Number	11
Drawing Number	11-AGI-0.00R
Dwg. -- of --	

Office of Construction and Facilities Management

Department of Veterans Affairs

VA FORM 08-6231