




three inches = one foot
 one and one half inches = one foot
 one inch = one foot
 three quarters inch = one foot
 one half inch = one foot
 one quarter inch = one foot
 three eighths inch = one foot
 one eighth inch = one foot

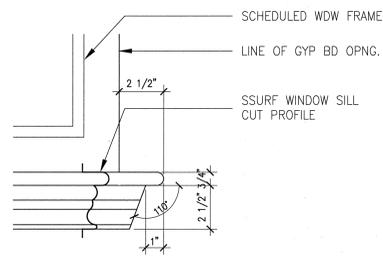


29 SILL ELEVATION
 SCALE: 3" = 1'-0"

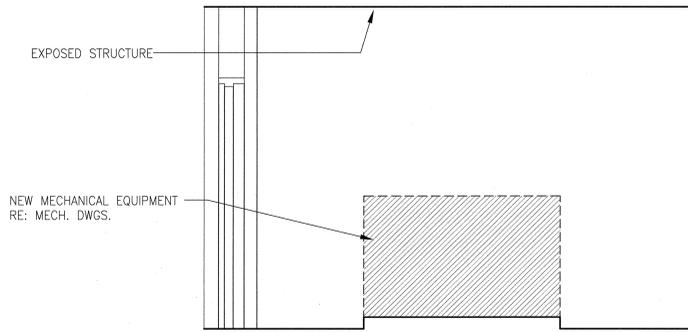


19 MECHANICAL ROOM
 SCALE: 1/2"=1'-0"

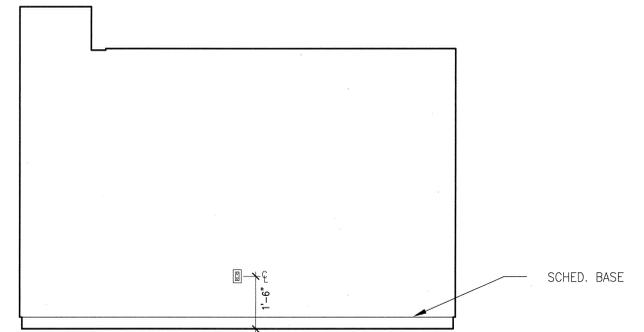


09 OFFICE - RM. 106
 SCALE: 1/2"=1'-0"

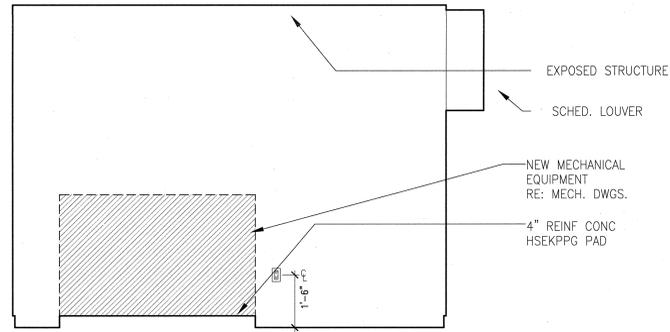


27 MECHANICAL
 SCALE: 1/2" = 1'-0"

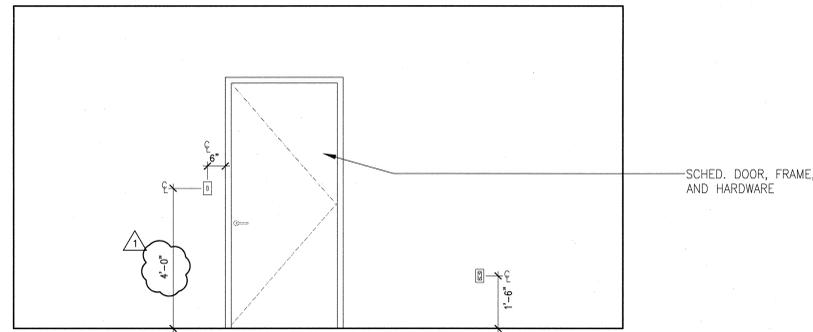


17 MECHANICAL ROOM
 SCALE: 1/2"=1'-0"

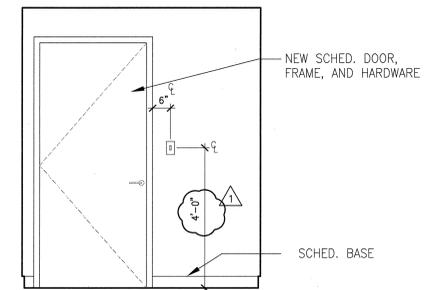


07 OFFICE - RM. 106
 SCALE: 1/2"=1'-0"

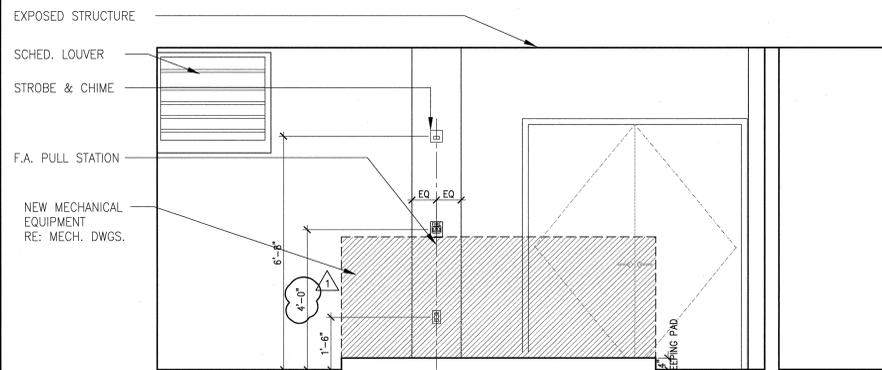

26 MECHANICAL ROOM
 SCALE: 1/2"=1'-0"

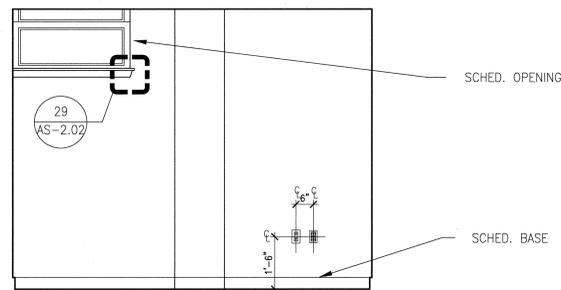


16 OFFICE - RM. 106
 SCALE: 1/2"=1'-0"

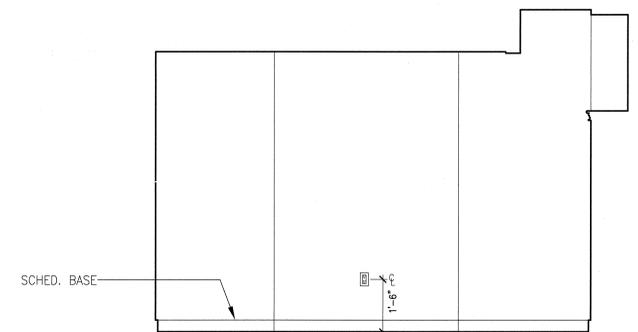

06 OFFICE - RM. 106
 SCALE: 1/2"=1'-0"

SCHEMATIC DESIGN SUBMISSION	08/02/10
DESIGN DEVELOPMENT SUBMISSION	09/03/10
CONSTRUCTION DOCUMENT SUBMISSION	11/22/10
ISSUED FOR BIDS	12/19/11
AMENDMENT NO. 04	04/05/12
Revisions	Date

CONSULTANTS:

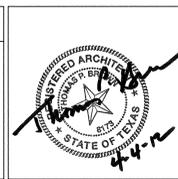

ARCHITECT/ENGINEERS:

WILSON ARCHITECTURAL GROUP
 5001 WESTHEIMER, SUITE 200 HOUSTON, TEXAS 77056 TELEPHONE (713) 621-8704

MEP ENGINEERS
 STRUCTURAL ENGINEERS
 FIRE PROTECTION ENGINEERS
 CIVIL ENGINEERS

BURNS DeLATTE AND McCOY, INC.
 PINNACLE STRUCTURAL
 PROTECTION DEVELOPMENT INC.
 BREWER AND ESCALANTE

DO NOT SCALE THESE DRAWINGS. G.C. TO FIELD VERIFY DIMENSIONS

Drawing Title	Project Title	Project Number	ISSUED FOR BIDS	AMENDMENT NO. 04	FULLY SPRINKLERED
INTERIOR ELEVATIONS - BASEMENT	BUILDING 11 ADDITION & INTERIOR RENOVATIONS	674A4-CSI-516			
Approved Project Director	Location	Building Number	Office of Construction and Facilities Management		
	WACO, TEXAS	11	Department of Veterans Affairs		
Date	Checked	Drawn	Drawing Number		
19 DEC 2011			11-AS-2.02R		
			Dwg. of		