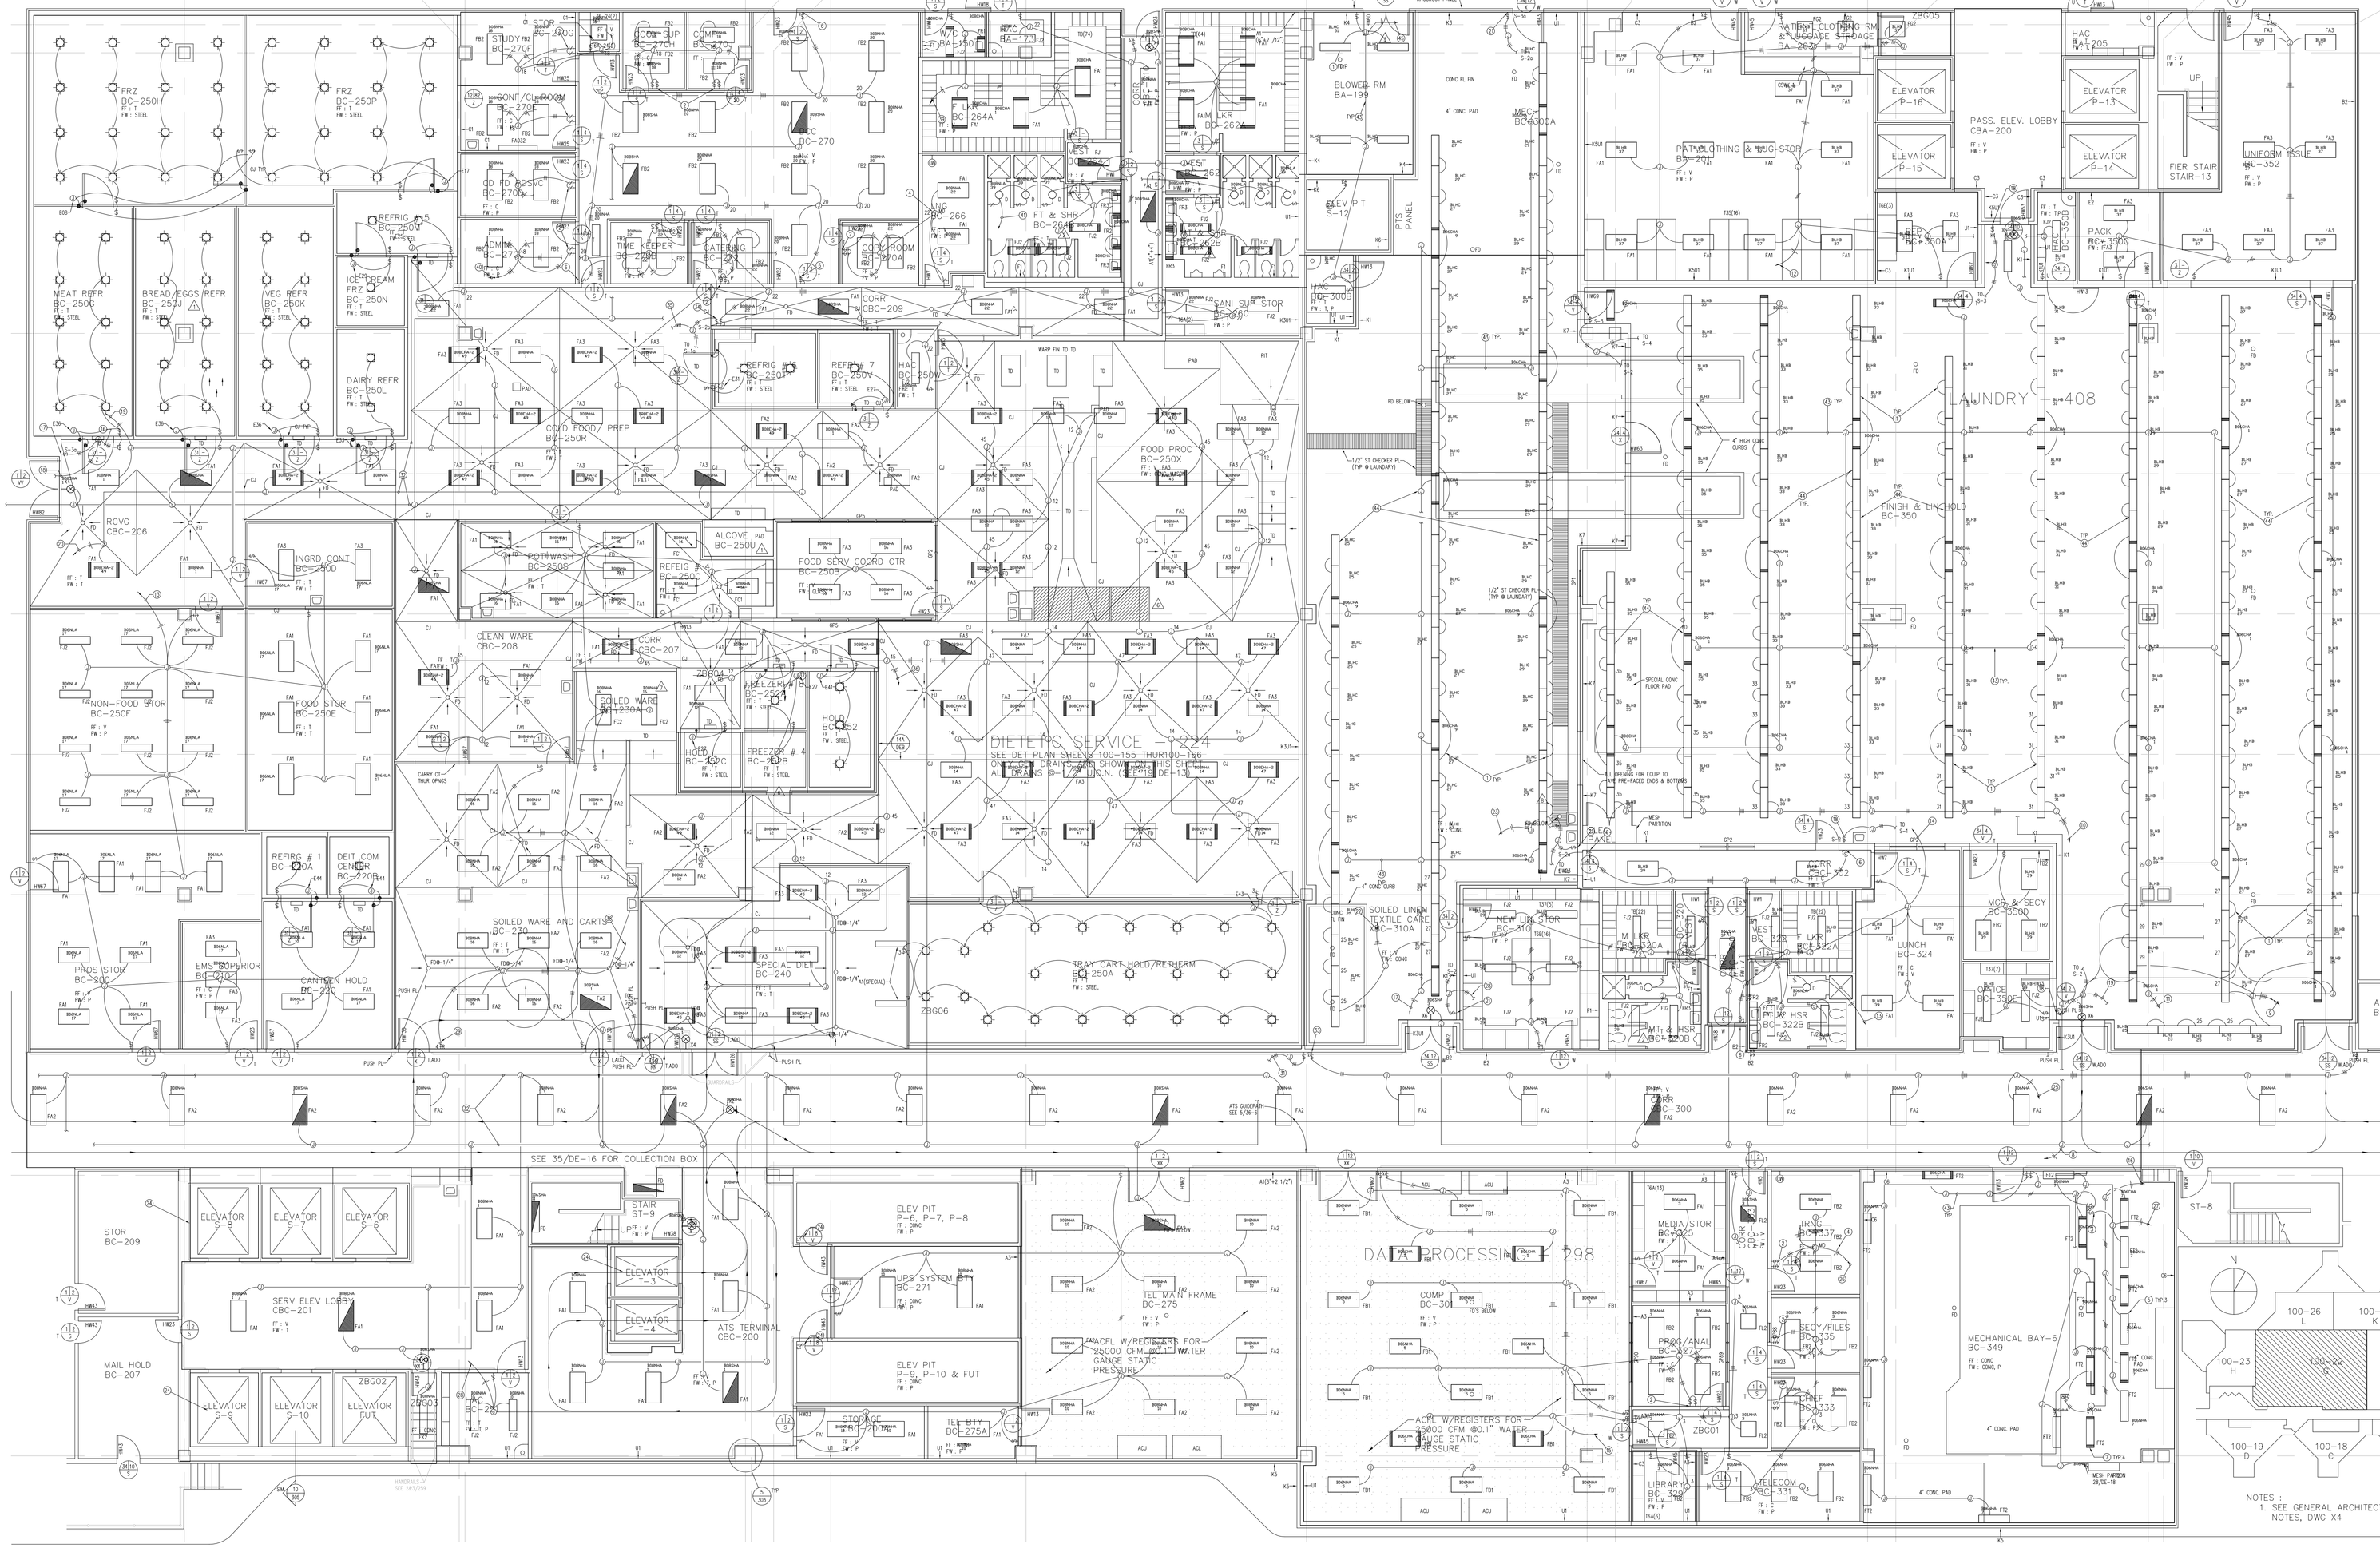

LIGHTING LEGEND

SYMBOL	NAME	DESCRIPTION
	2X4FLF	2X4 FLUORESCENT LIGHTING FIXT.
	1X4FLF	1X4 FLUORESCENT LIGHTING FIXT.
	12X24FLF	12X24 FLUORESCENT LIGHTING FIXT.
	4X4FLF	4X4 FLUORESCENT LIGHTING FIXT.
	2X2FLF	2X2 FLUORESCENT LIGHTING FIXT.
	1X1FLF	1X1 FLUORESCENT LIGHTING FIXT.
	2X3FLF	2X3 FLUORESCENT LIGHTING FIXT.
	18X48FLF	18X48 FLUORESCENT LIGHTING FIXT.
	6X48FLF	6X48 FLUORESCENT LIGHTING FIXT.
	6X36FLF	6X36 FLUORESCENT LIGHTING FIXT.
	6X24FLF	6X24 FLUORESCENT LIGHTING FIXT.
	1X8FLF	1X8 FLUORESCENT LIGHTING FIXT.
	12X36FLD	12X36 FLOOD LIGHT.
	2X2FLFEM	2X2 FLUORESCENT EMERGENCY LTG.
	1X2FLFEM	1X2 FLUORESCENT EMERGENCY LTG.
	6X18FLEM	6X18 FLUORESCENT EMERGENCY LTG.
	6X24FLEM	6X24 FLUORESCENT EMERGENCY LTG.
	6X36FLEM	6X36 FLUORESCENT EMERGENCY LTG.
	1X3FLFEM	1X3 FLUORESCENT EMERGENCY LTG.
	2X4FLFEM	2X4 FLUORESCENT EMERGENCY LTG.
	4X4FLFEM	4X4 FLUORESCENT EMERGENCY LTG.
	1X4FLFEM	1X4 FLUORESCENT EMERGENCY LTG.
	2X4FLFLS	2X4 FLUORESCENT LTG. LIFE SAFETY
	2X2FLFLS	2X2 FLUORESCENT LTG. LIFE SAFETY
	1X4FLFLS	1X4 FLUORESCENT LTG. LIFE SAFETY
	1X8FLFLS	1X8 FLUORESCENT LTG. LIFE SAFETY
	1X16FLFLS	1X16 FLUORESCENT LTG. LIFE SAFETY
	1X12FLFLS	1X12 FLUORESCENT LTG. LIFE SAFETY
	1X16FLF	1X16 FLUORESCENT LTG.
	1X12FLFEM	1X12 FLUORESCENT EMERGENCY LTG.
	1X16FLEM	1X16 FLUORESCENT EMERGENCY LTG.
	UCLGT-EM	UNDER COUNTER LIGHTS TYPE "EY"
	6X40DFLF	6X4 FLUORESCENT FIXTURE-DUAL SWITCHED.
	6X36DSFL	6X36 FLUORESCENT FIXTURE-DUAL SWITCHED
	6X24DSFL	6X24 FLUORESCENT FIXTURE-DUAL SWITCHED
	FL4EMST	1X4 FLUORESCENT STRIP EM. FIXTURE.
	4FLSTRF	1X4 FLUORESCENT STRIP FIXTURE.
	LIGHTEEM	INCANDESCENT FIXT. ON EM. PWR. CLG.
	LIGHTEEM	INCANDESCENT FIXT. ON EM. PWR. WALL
	LIGHT-C	CLG. MOUNTED INCANDESCENT LTG. FIXT.
	LIGHT-W	WALL MOUNTED INCANDESCENT LTG. FIXT.
	EXITLTG-C	EXIT LIGHT (CEILING MOUNTED)
	EXITLTG-D	EXIT LIGHT CEILING MOUNTED (DOUBLE FACE)
	EXITLTG-S	EXIT LIGHT CEILING MOUNTED (SINGLE FACE).
	EXITLTW-D	EXIT LIGHT WALL MOUNTED (DOUBLE FACE).
	EXITLTG-W	EXIT LIGHT (WALL MOUNTED)
	JBOX-W	WALL JUNCTION BOX
	JBOX-C	CEILING MOUNTED JUNCTION BOX
	PILOTSTAT	INTERSTITIAL PILOT LIGHT
	MOTCSNSR	MOTION DETECTOR SENSOR
$	1POLE-SW	SINGLE POLE SWITCH
$2	2POLE-SW	DOUBLE POLE SWITCH
$3	3POLE-SW	THREE – WAY SWITCH
$4	4POLE-SW	FOUR – WAY SWITCH
D	DMRCTRL	DIMMER CONTROL
$PL	1PEM-SW	ONE POLE SW. TO CNTRL EM. LTG. FIXT.
$D3	3DMR-SW	3-WAY DIMMER SWITCH
$MK	MCOMKSW	MOMENTARY CONTACT KEYED SWITCH
$K	KEY-SW	KEY SWITCH
$M	MMLMTRSW	MANUAL MOTOR STARTING SW. W/THRML
$MC	MCONT-SW	MOMENTARY CONTACT SWITCH
$PB	PBTNTSTAT	PUSH BUTTON STATION
$P	PILOT-SW	SWITCH W/PILOT LIGHT
$RC	RMTCTRSW	REMOTE CONTROL SWITCH
$WP	WPROOFSW	WEATHERPROOF SWITCH
$3K	3W-KSWCH	THREE – WAY KEY OPERATED SWITCH
$SC	SLTCTRL	SURGICAL LIGHT INTENSITY CONTROLLER
$T	TIMER-SW	TIMER SWITCH
$D	DIMER-SW	DIMER SWITCH
	ARROW1	FOR DIRECTION
	SNGLARROW	FOR DIRECTION
	ARROW2	FOR DIRECTION
	ARROW1	FOR DIRECTION
	SYMBOL1	
	SYMBOL2	

RECORD DRAWING	R-3-92
AMENDMENT NO. 1	20 FEB 87
AMENDMENT NO. 2	27 FEB 87
AMENDMENT NO. 3	6 MAR 87
10C-A-03	10 NOV 87
10C A-24	29 APR 88
RFI #A-1128	7 MAY 90
RFI #A-235	-
RFI #M-150	-
	18 JAN 2005
Revisions	Date

Professional Seal

Drawing Title	BASEMENT FLOOR PLAN–AREA G LIGHTING
Project Title	AS–BUILT Drawings
Date	2 JAN 87
Project No.	580–040
Approved:	
Approved:	
Building Number	100
Checked	
Drawn	
Drawing No.	100–28R2
Location	VAMC, HOUSTON TEXAS.

VAMC, HOUSTON

Department of Veterans Affairs

VA FORM 08–6231, OCT 1978