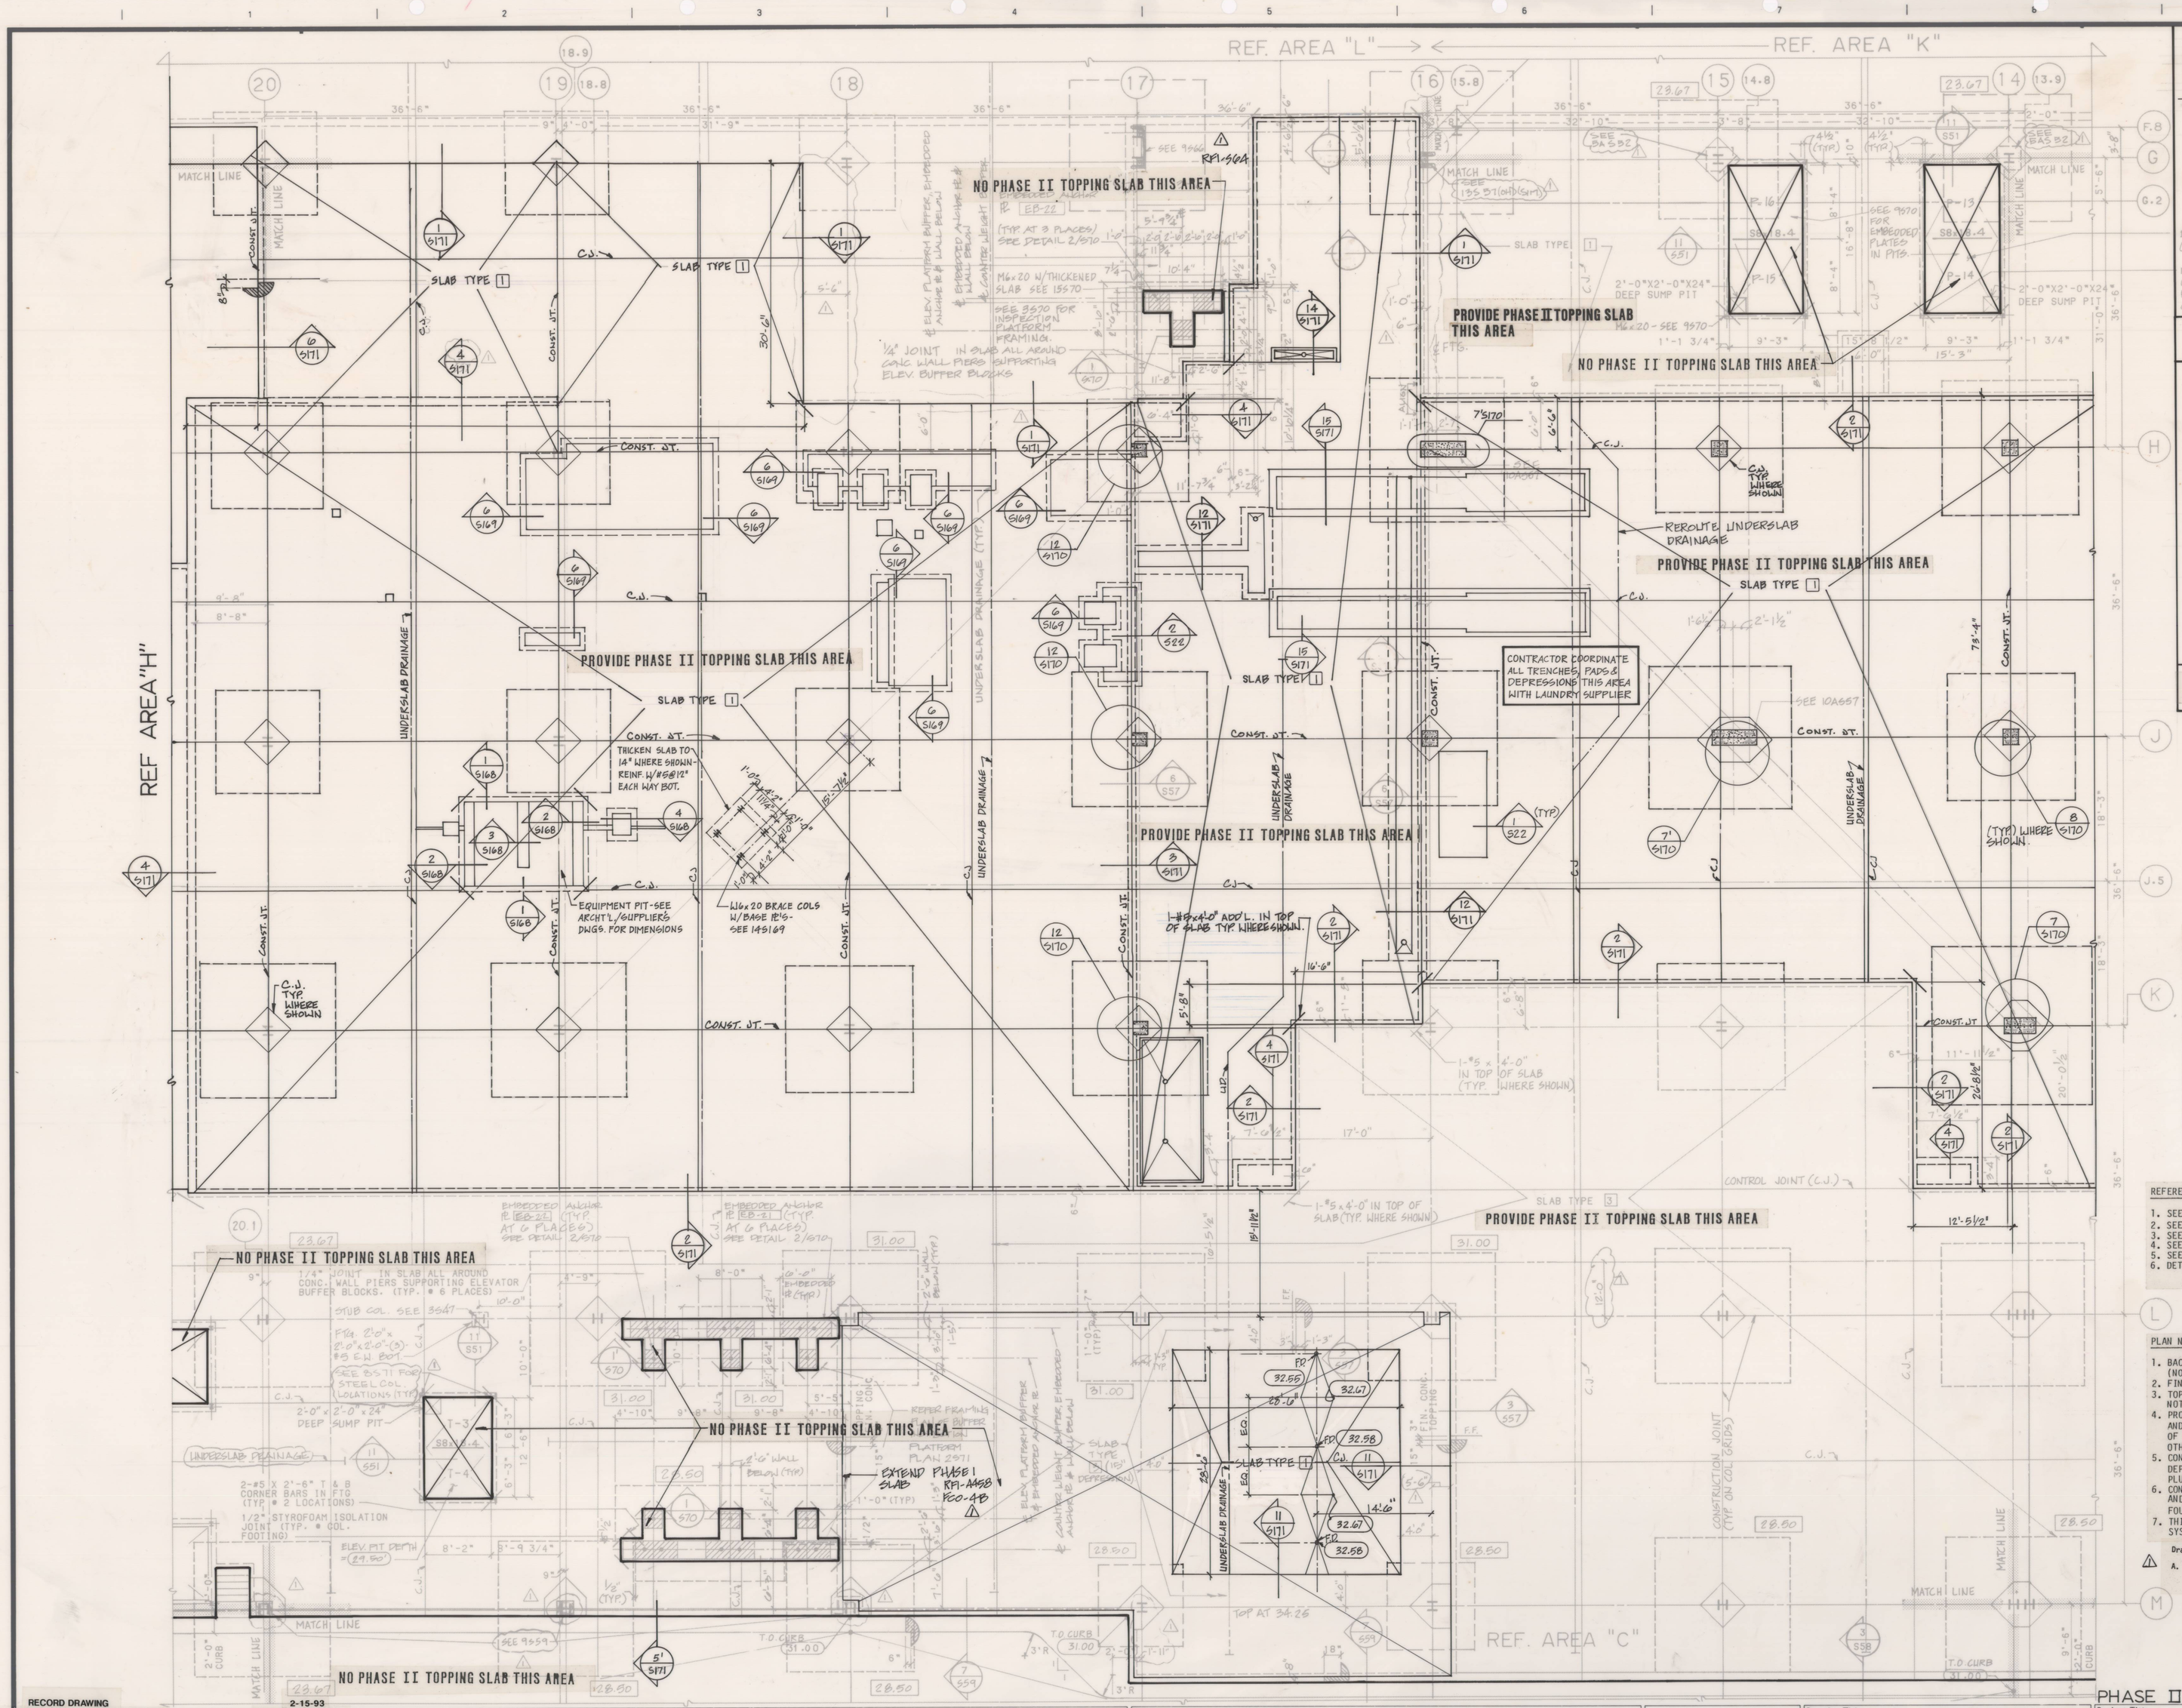

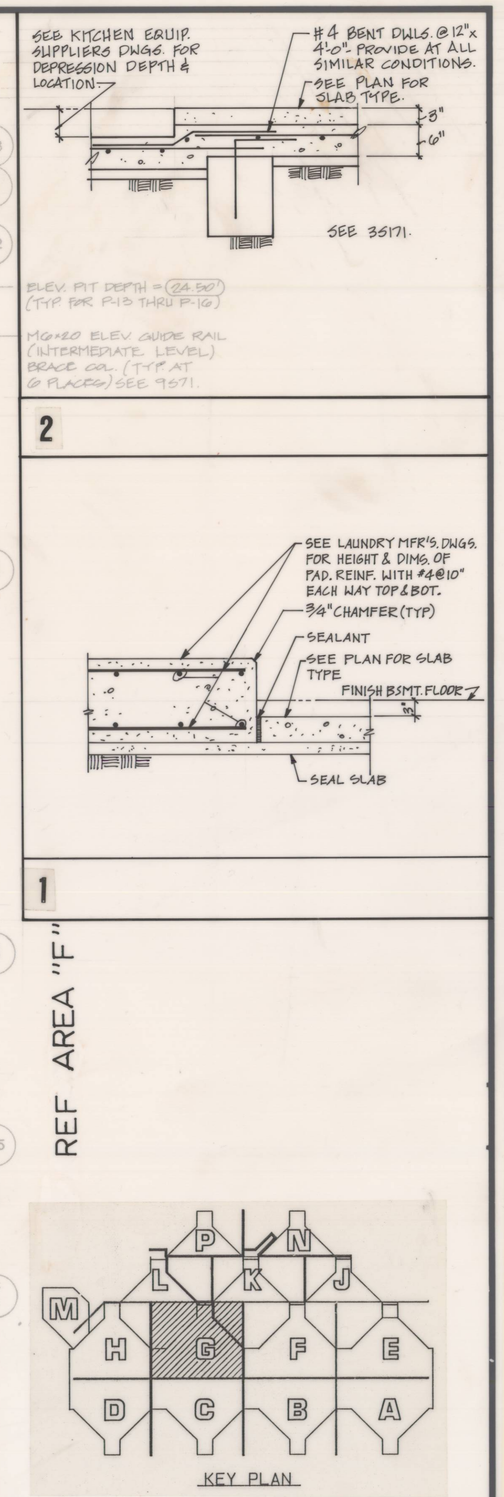

KEY PLAN

REFERENCE NOTES:

1. SEE SHEET 100-S2 FOR GENERAL NOTES.
2. SEE SHEET 100-S4 FOR GRID DIMENSION PLAN.
3. SEE SHEET 100-S15 FOR BASEMENT KEY PLAN.
4. SEE SHEET 100-S170 FOR SLAB TYPES AND TYPICAL DETAILS.
5. SEE PHASE I DRAWINGS FOR EXTENT AND DETAILS OF PHASE I CONSTRUCTION.
6. DETAILS ARE REFERENCED TO SHEET NUMBERS.

PLAN NOTES:

1. BACKGROUND INFORMATION (SHOWN SCREENED) IS PHASE I CONSTRUCTION (NOT IN THIS CONTRACT) AND IS SHOWN FOR BACKGROUND PURPOSE ONLY.
2. FINISH BASEMENT FLOOR AT ELEVATION 34.50 U.N.O. THUS (32.50)
3. TOP OF STRUCTURAL SLAB TO BE 3" BELOW FINISH BASEMENT FLOOR, UNLESS NOTED OTHERWISE.
4. PROVIDE 3" NORMAL WEIGHT CONCRETE TOPPING SLAB OVER BOTH PHASE I AND PHASE II BASEMENT STRUCTURAL SLAB, UNLESS SHOWN OTHERWISE. TOP OF TOPPING SLAB TO BE AT FINISH BASEMENT FLOOR, UNLESS NOTED OTHERWISE.
5. CONTRACTOR TO COORDINATE ALL TOPPING SLAB REQUIREMENTS, INCLUDING DEPRESSIONS, OPENINGS, SLOPES, ETC. WITH THE ARCHITECTURAL, PLUMBING AND ELECTRICAL DRAWINGS.
6. CONTRACTOR TO COORDINATE CRANE FOUNDATION AND ACCESS REQUIREMENTS AND SHALL BE FULLY RESPONSIBLE FOR DESIGN AND INSTALLATION OF ALL FOUNDATIONS AND REQUIRED ANCHORAGE.
7. THIS LEVEL FULLY PROTECTED BY AN AUTOMATIC FIRE EXTINGUISHMENT SYSTEM.

Drawing No. 100-S22: ADD 5" depression in the area indicated on Architectural Drawing No. 100-157 (2 locations).
A. Coordinates D-2, D-3, E-3, E-4: Refer to 6S169 and use appropriate detail for 5" depression for additional reinforcement.

PHASE II

RECORD DRAWING	2-15-93
1 RFI #S64, RFI #A-458	9-10-87
Revisions	Date

SLOPE IN COMPUTER ROOM

3D/INTERNATIONAL AND STONE, MARRACCINI AND PATTERSON
3D/I • SMP A JOINT VENTURE HOUSTON, TEXAS
1900 WEST LOOP SOUTH, SUITE 200 HOUSTON, TEXAS 77027 TELEPHONE (713) 871-7000

STRUCTURAL AND CIVIL : WALTER P. MOORE AND ASSOCIATES, INCORPORATED
MECHANICAL AND ELECTRICAL : YANDELL & HILLER, INC. AND 3D/INTERNATIONAL

Drawing Title: BASEMENT FLOOR PLAN AREA G
Approved Project Director: A C Pappanikil

Project Title: REPLACEMENT / MODERNIZATION MEDICAL CENTER
Building Number: 100 | Checked: L.W.S. | Drawn: G.S.
Location: VAMC HOUSTON, TEXAS

Date: 2 JAN. 1987
Project No.: 580-040
DRAWING NO.: 100-S22R
Dwg. 19 of 202

Veterans Administration

100-S22
BASEMENT FLOOR PLAN - AREA G