

Nelson Engineering Co.
5335 North Courtenay Pkwy
Merritt Island, FL 32953
(321) 449-1128 Fax (321) 449-1195
www.NelsonEngCo.com


INITIALS	DATE
DESIGNED BY: BW	2/12/16
DRAWN BY: BH	2/12/16
CHECKED BY: DC	2/12/16


DEPARTMENT OF VETERANS AFFAIRS
ARC-FLASH ANALYSIS AND SHORT CIRCUIT STUDY
WILKES-BARRE VA MEDICAL CENTER
PRIMARY DISTRIBUTION SINGLE LINE

DATE	REVISION

SIZE	DWG. NO.	REV
E	WBVAMC - 693-SL-P285	A

CONTRACT NO.	GS-10F-0011V	SHEET	1	OF	10
--------------	--------------	-------	---	----	----

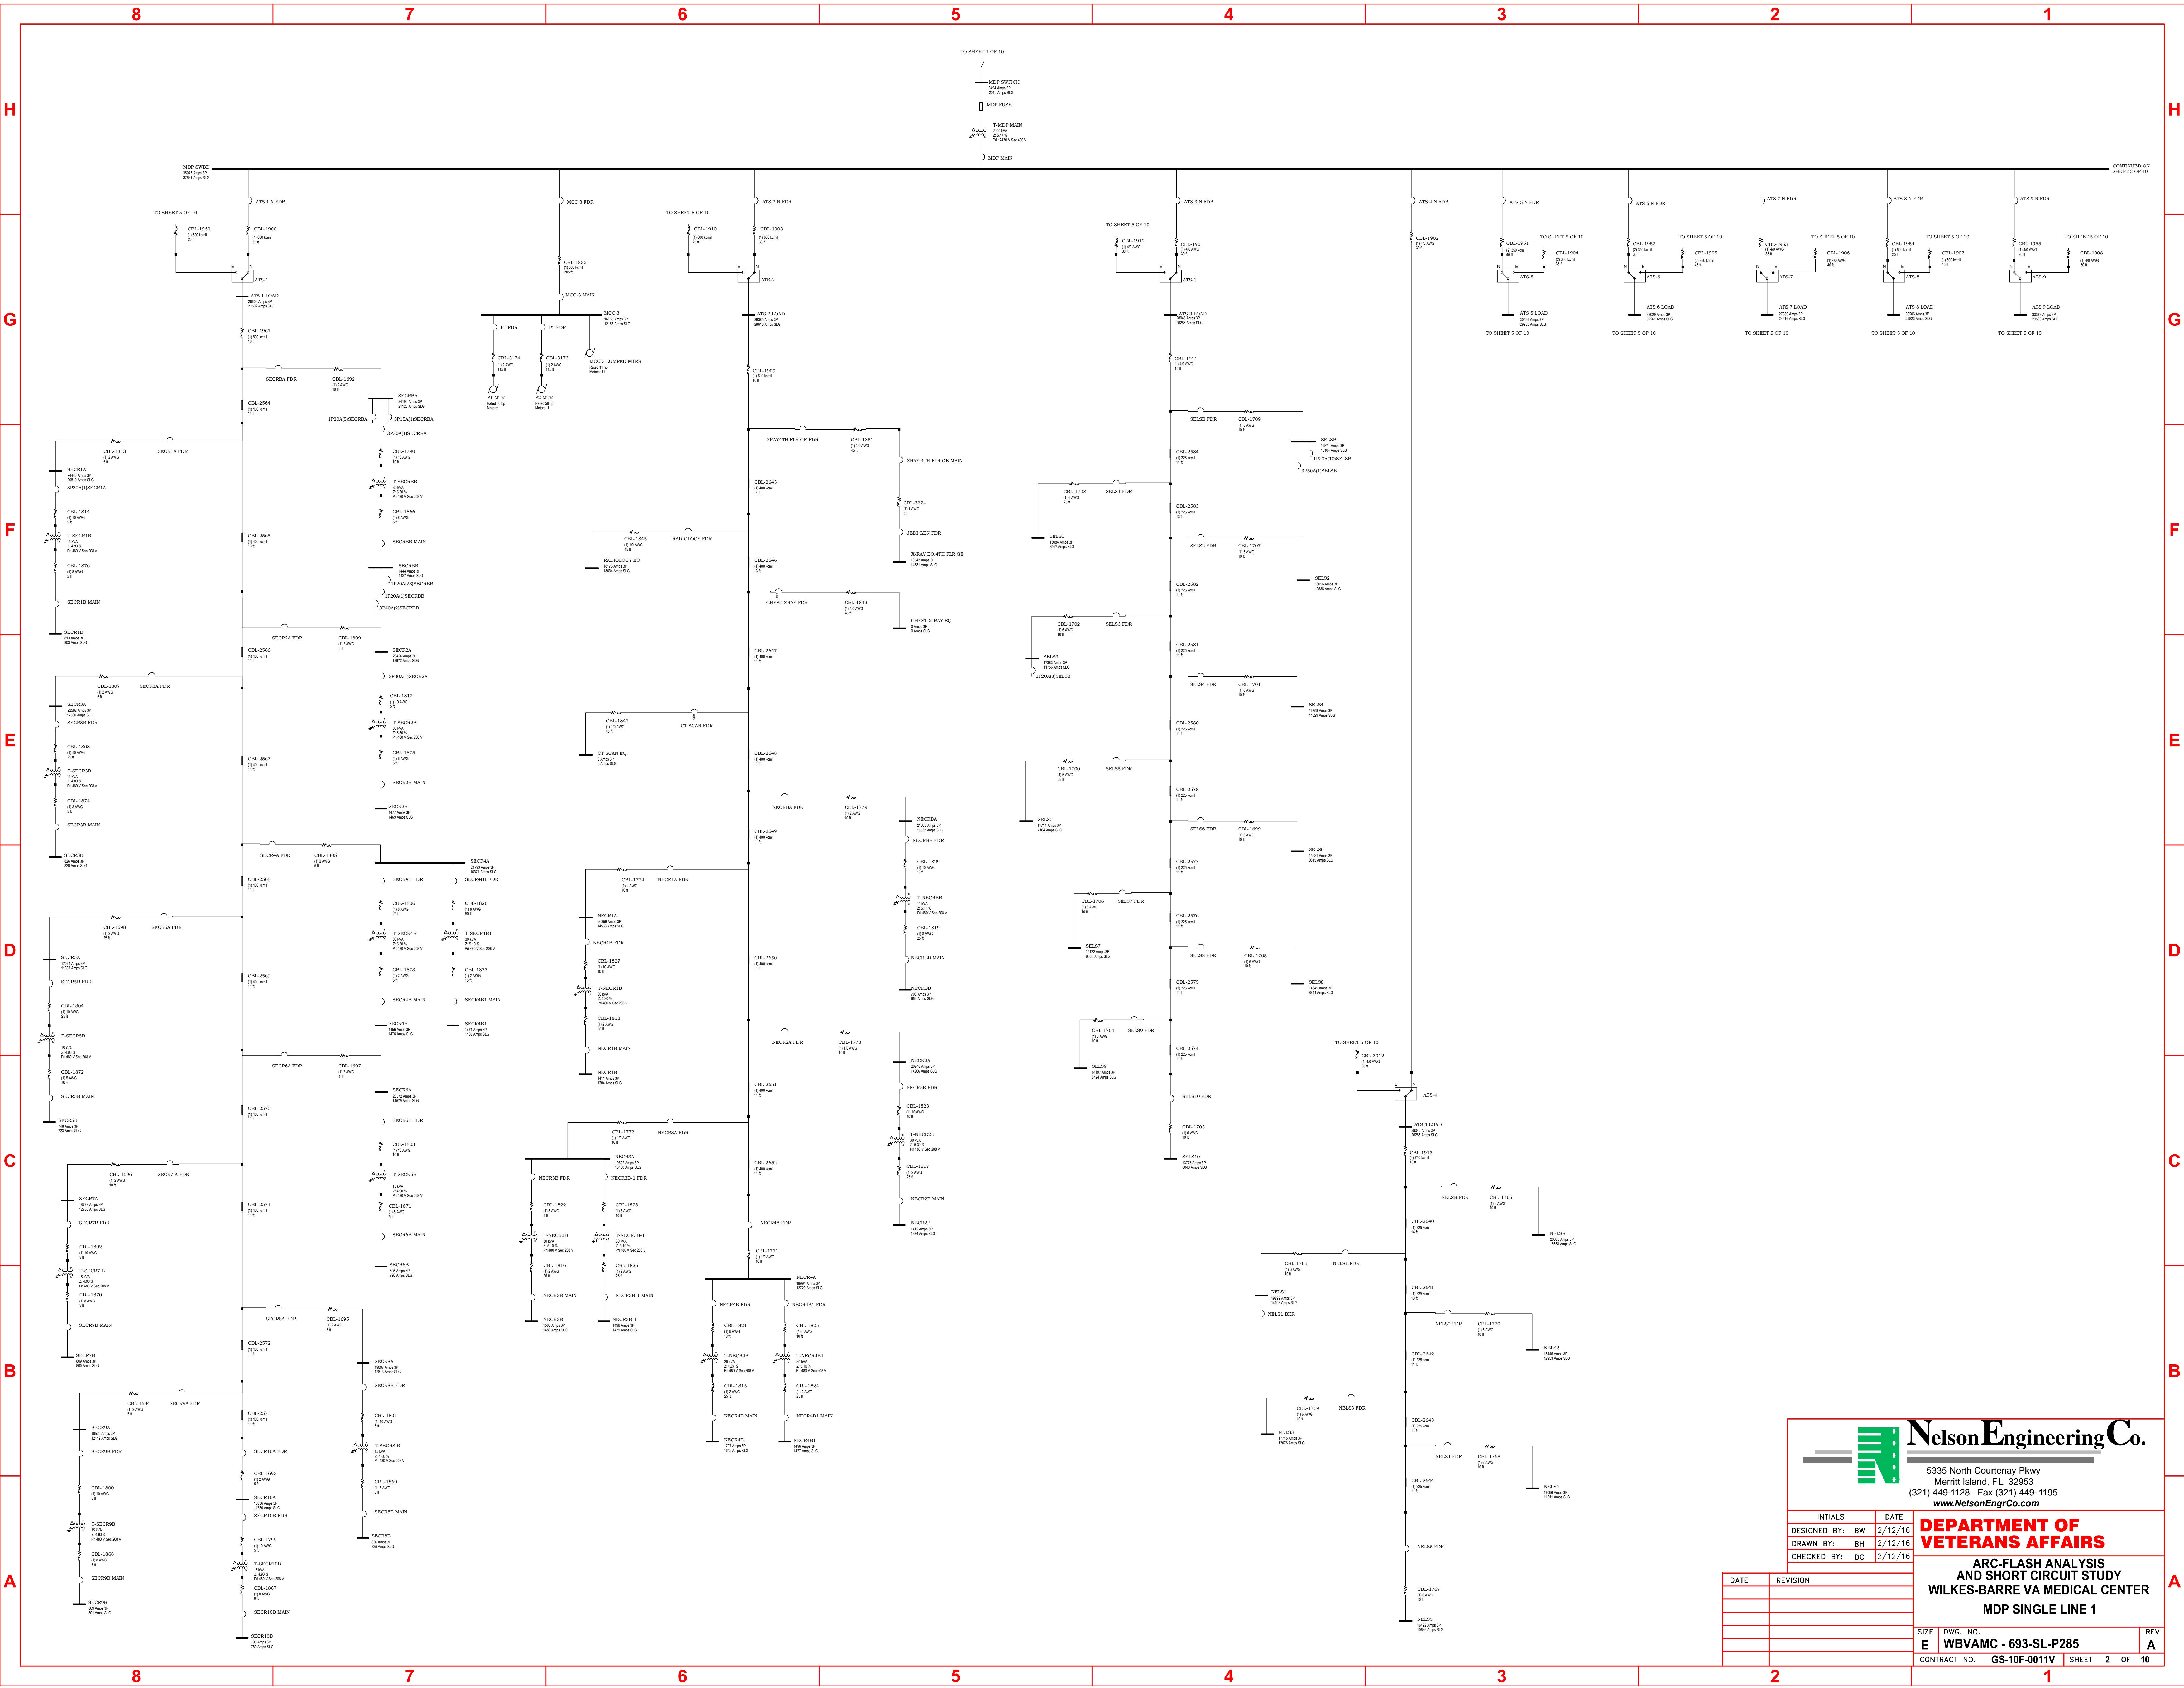



Nelson Engineering Co.
5335 North Courtenay Pkwy
Merritt Island, FL 32953
(321) 449-1128 Fax (321) 449-1195
www.NelsonEngCo.com

INITIALS	DATE
DESIGNED BY: BW	2/12/16
DRAWN BY: BH	2/12/16
CHECKED BY: DC	2/12/16


DEPARTMENT OF VETERANS AFFAIRS
ARC-FLASH ANALYSIS AND SHORT CIRCUIT STUDY
WILKES-BARRE VA MEDICAL CENTER
MDP SINGLE LINE 1


DATE	REVISION

SIZE	DWG. NO.	REV
E	WBVAMC - 693-SL-P285	A

CONTRACT NO.	GS-10F-0011V	SHEET	2	OF	10
--------------	--------------	-------	---	----	----

CONTINUED ON
SHEET 2 OF 10

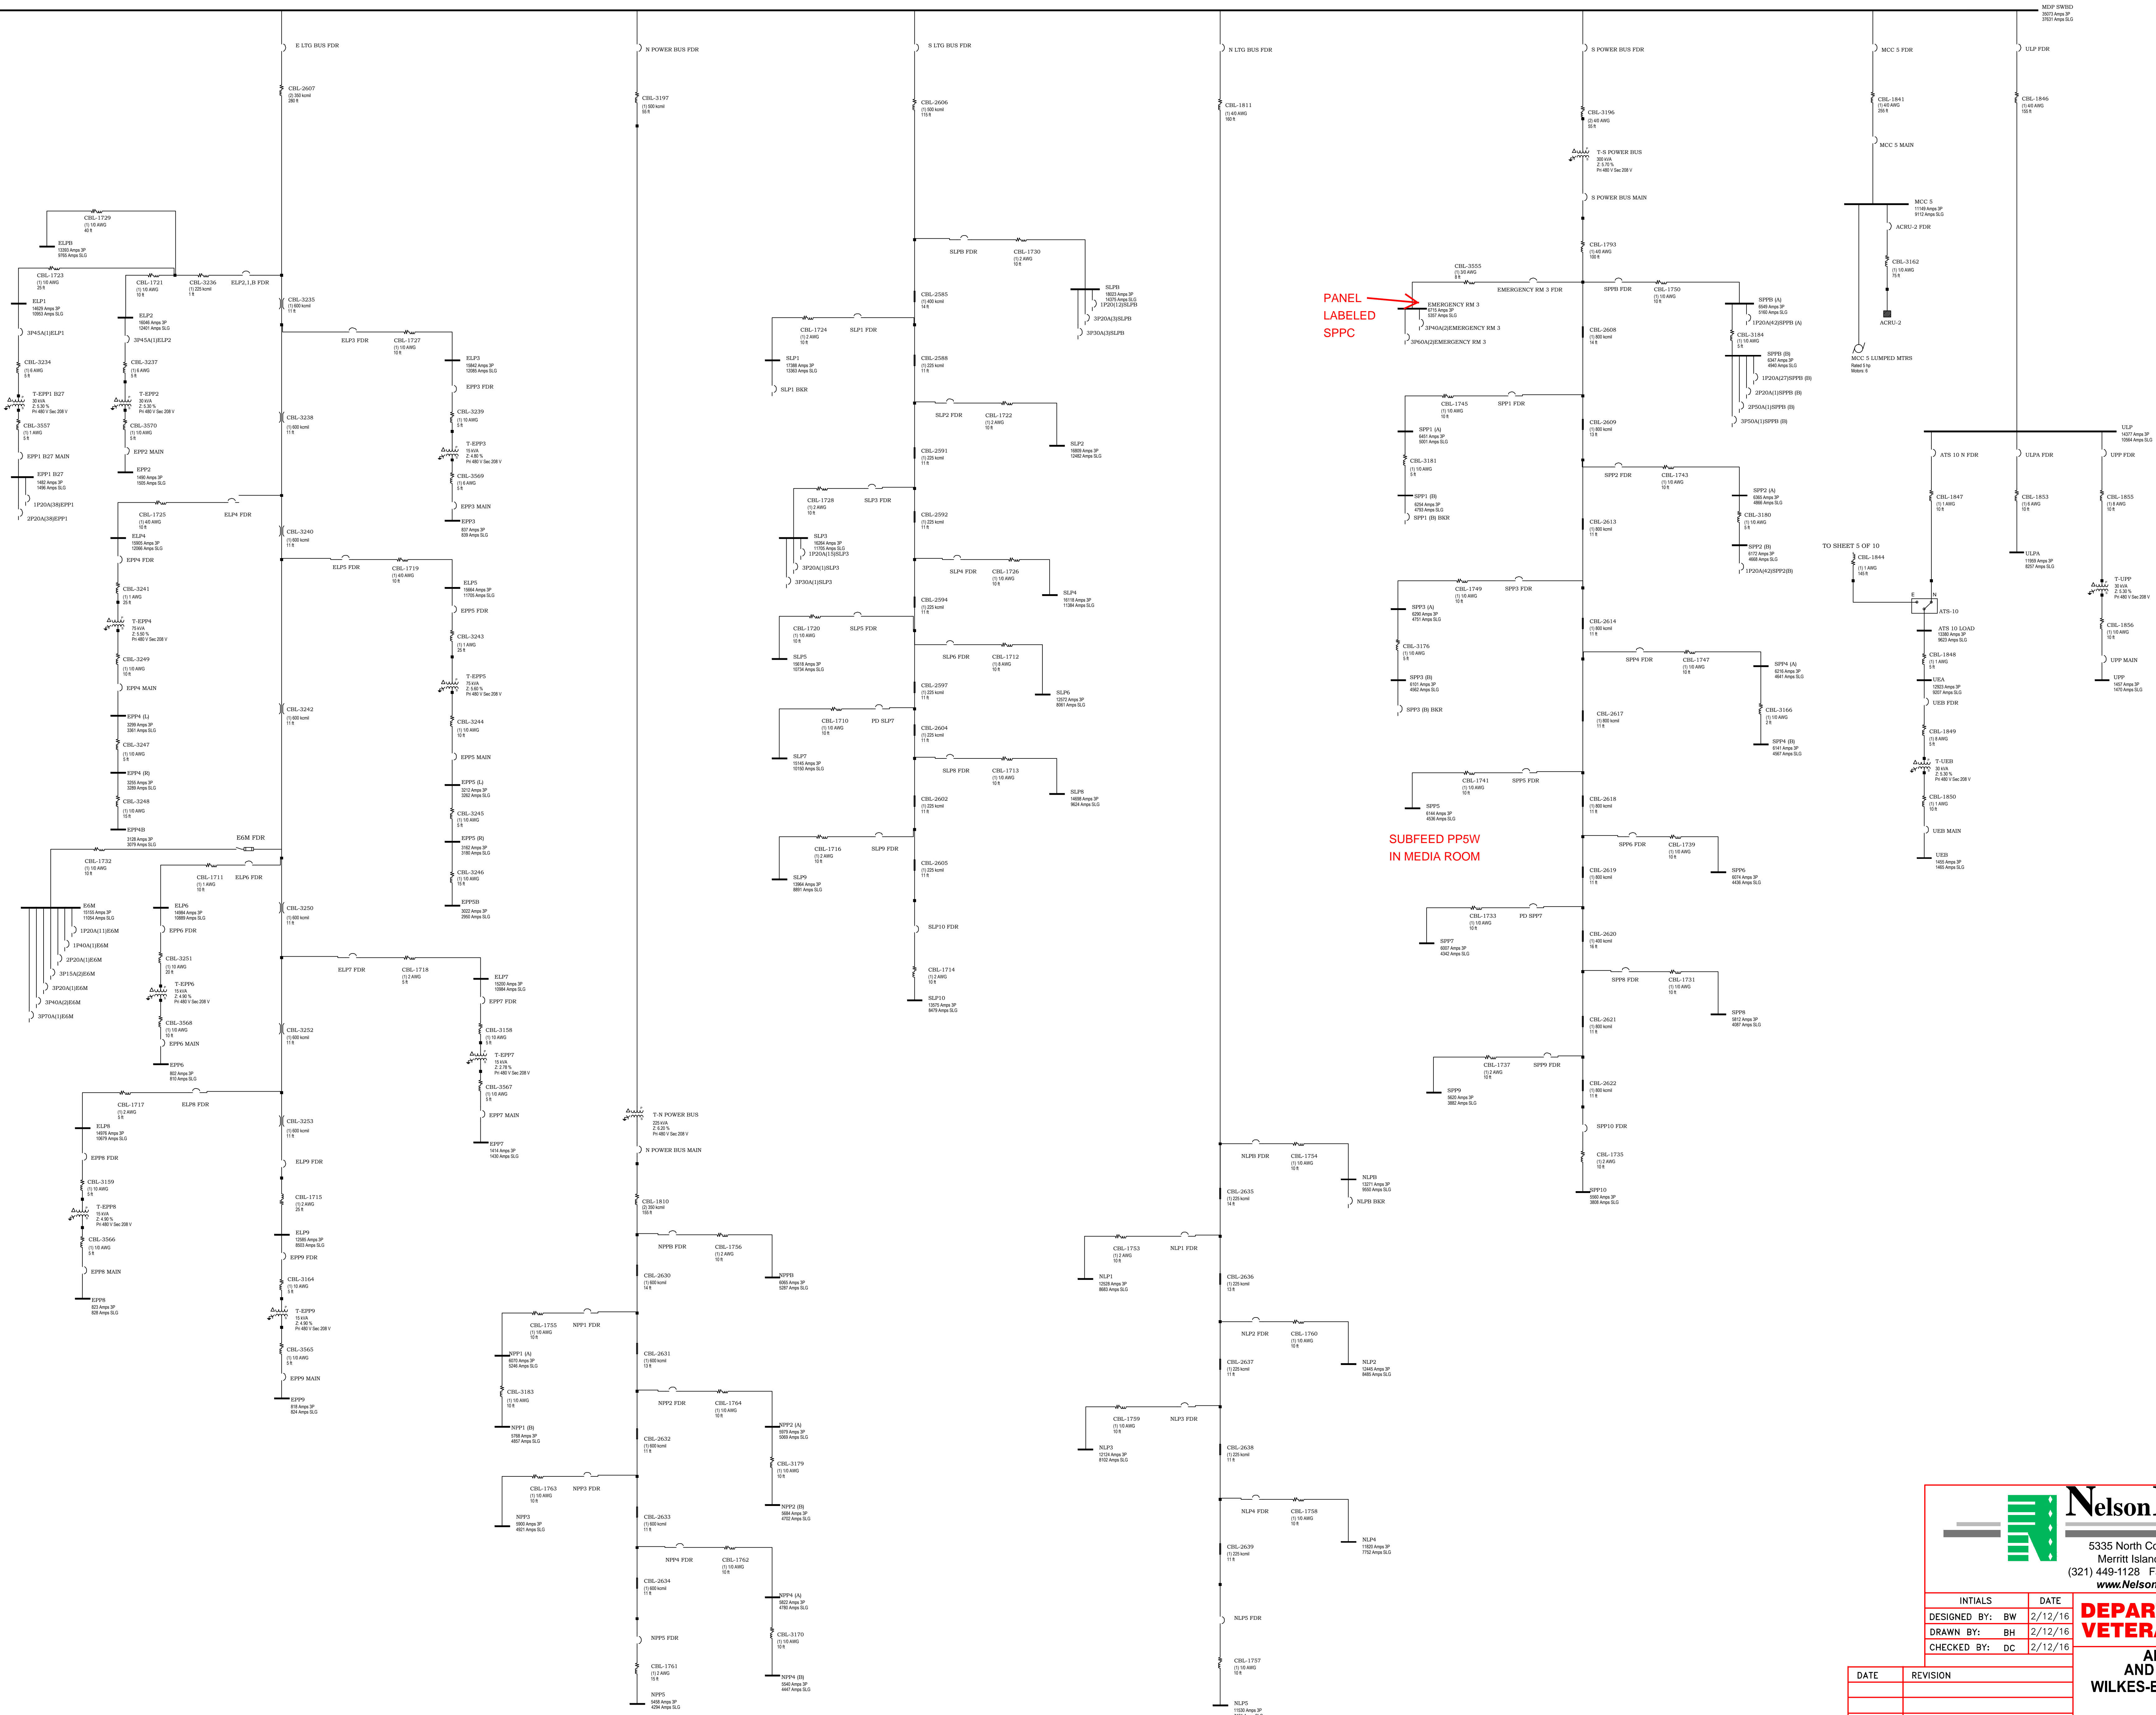

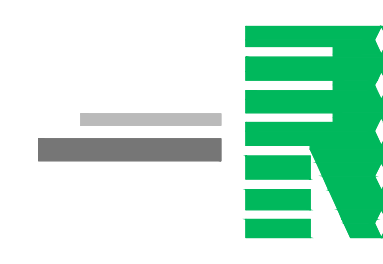

Nelson Engineering Co.
5335 North Courtenay Pkwy
Merritt Island, FL 32953
(321) 449-1128 Fax (321) 449-1195
www.NelsonEngCo.com


INITIALS	DATE
DESIGNED BY: BW	2/12/16
DRAWN BY: BH	2/12/16
CHECKED BY: DC	2/12/16


DATE	REVISION

DEPARTMENT OF VETERANS AFFAIRS
ARC-FLASH ANALYSIS AND SHORT CIRCUIT STUDY
WILKES-BARRE VA MEDICAL CENTER
MDP SINGLE LINE 2

SIZE	DWG. NO.	REV
E	WBVAMC - 693-SL-P285	A

CONTRACT NO.	SHEET	OF
GS-10F-0011V	3	10

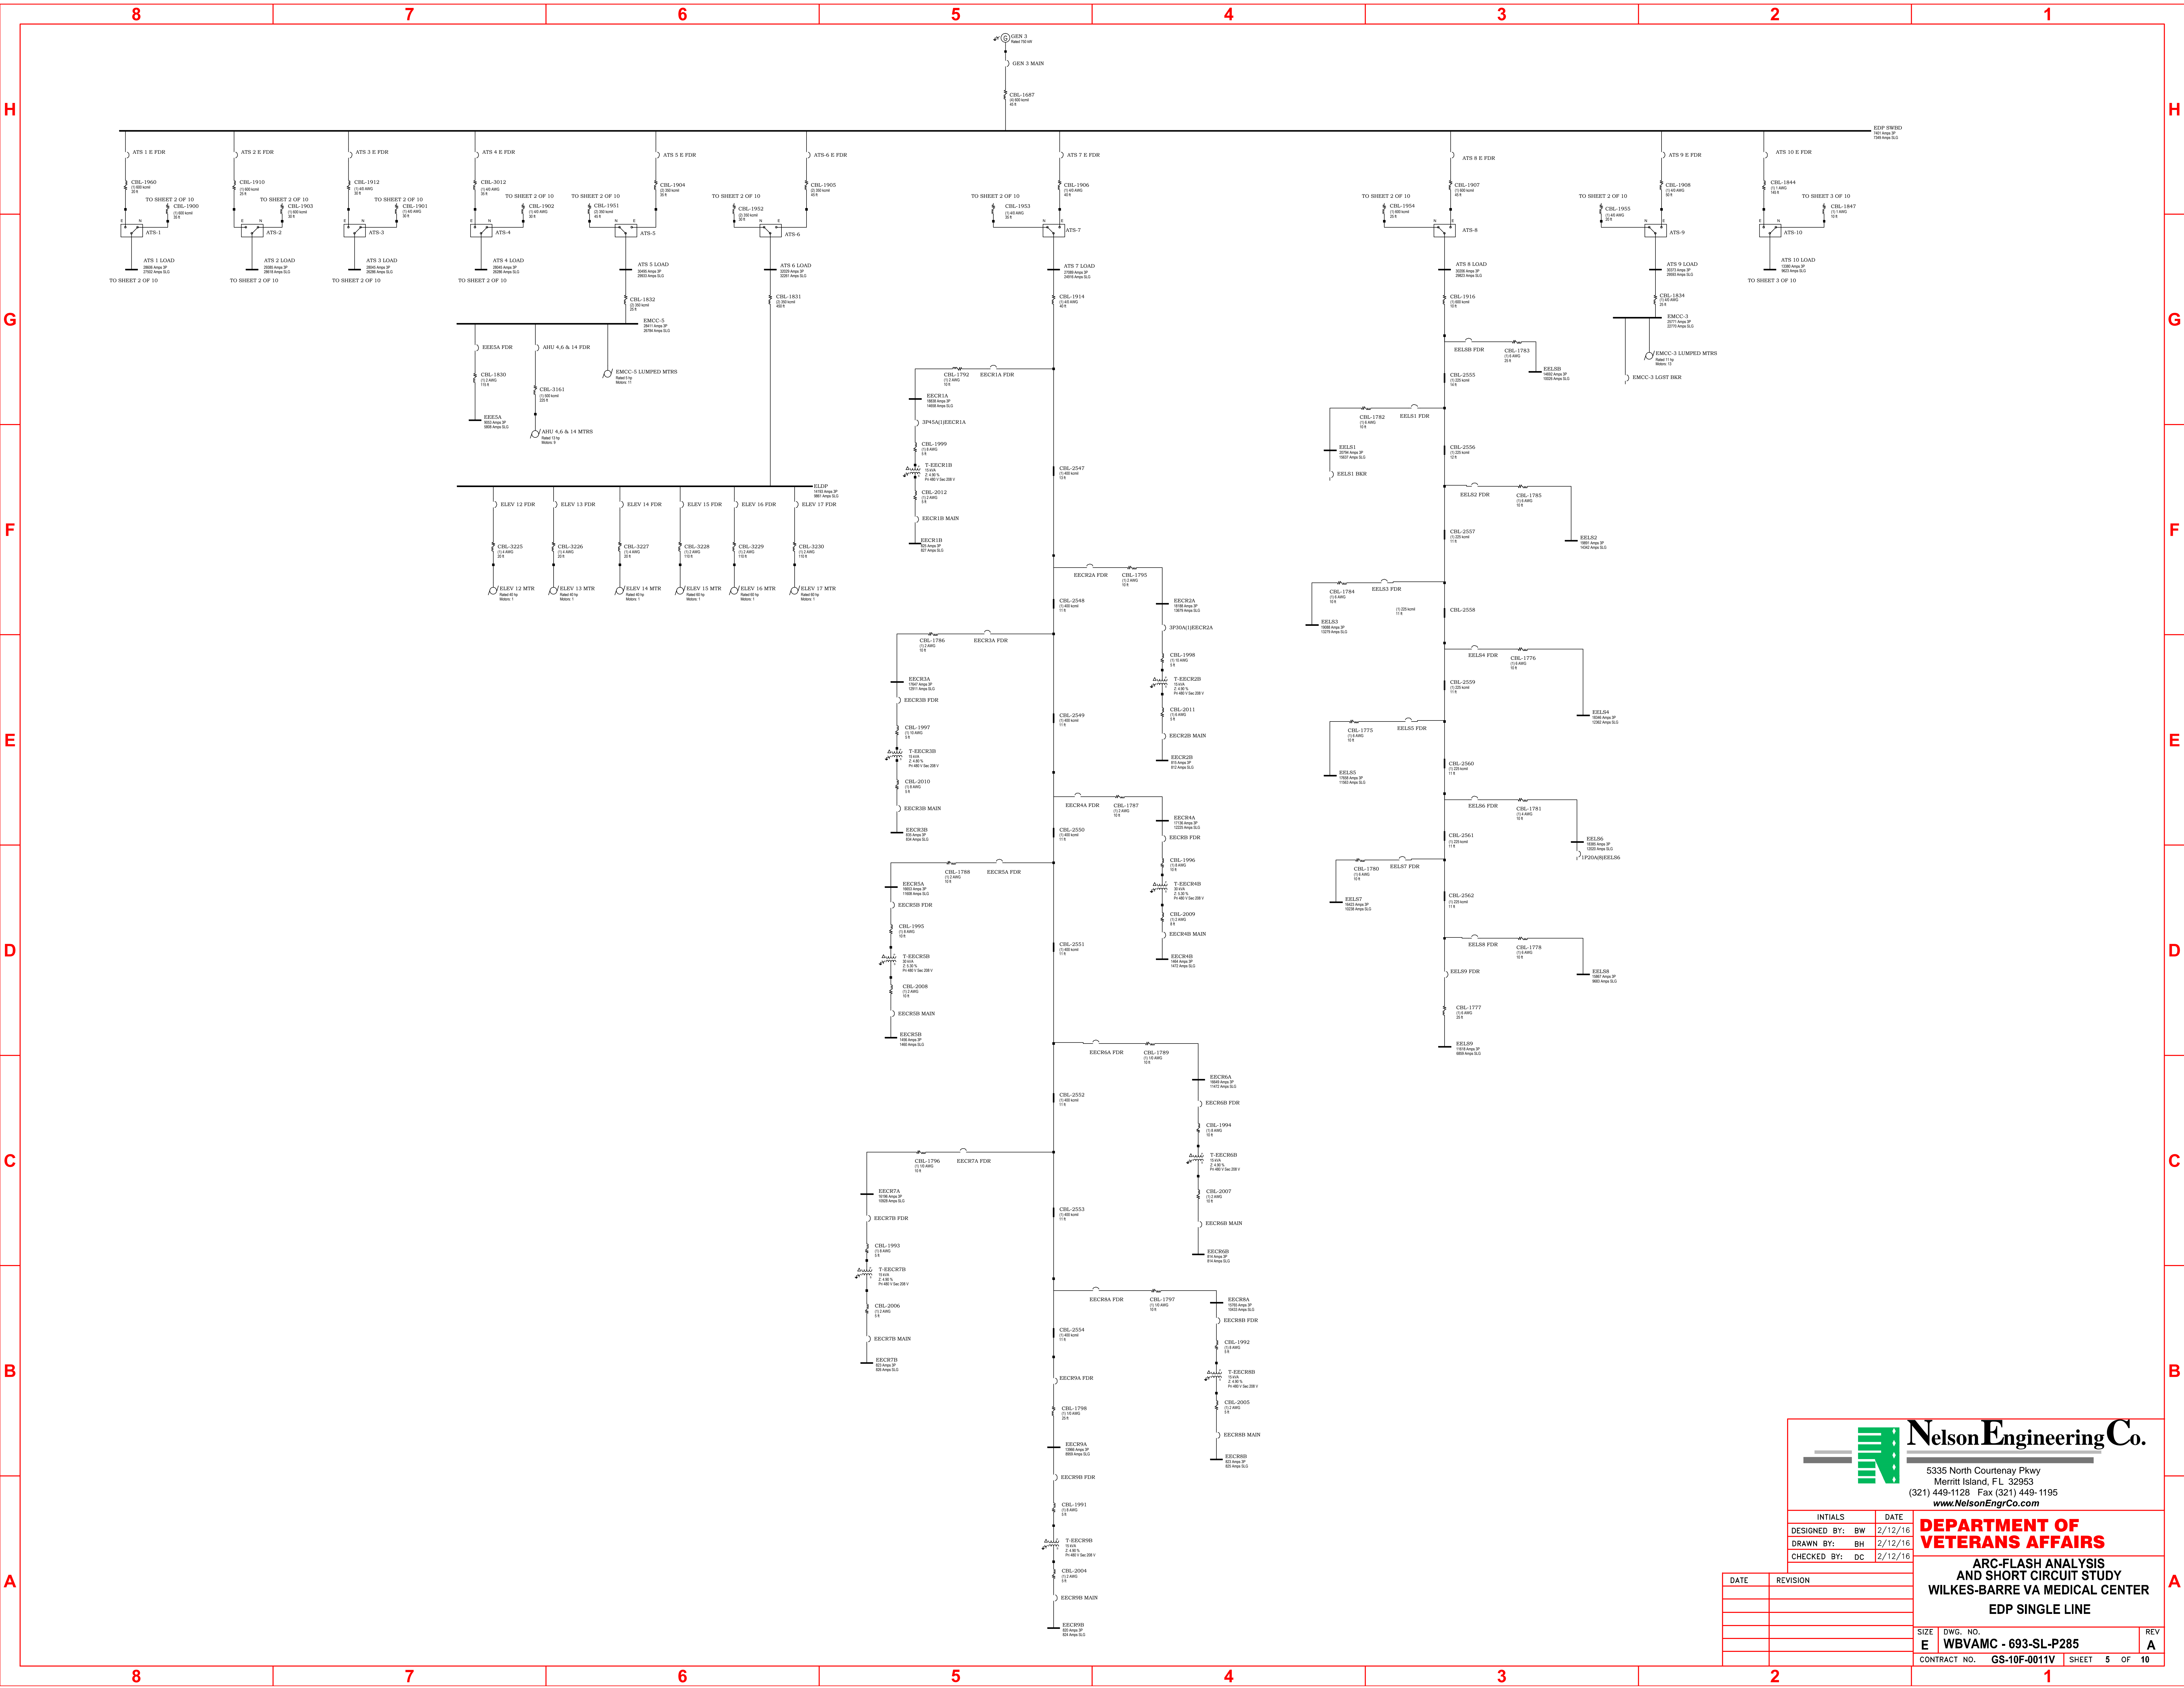




Nelson Engineering Co.
5335 North Courtenay Pkwy
Merritt Island, FL 32953
(321) 449-1128 Fax (321) 449-1195
www.NelsonEngCo.com


INITIALS	DATE
DESIGNED BY: BW	2/12/16
DRAWN BY: BH	2/12/16
CHECKED BY: DC	2/12/16

DEPARTMENT OF VETERANS AFFAIRS
ARC-FLASH ANALYSIS AND SHORT CIRCUIT STUDY
WILKES-BARRE VA MEDICAL CENTER
EDP SINGLE LINE

DATE	REVISION

SIZE	DWG. NO.	REV
E	WBVAMC - 693-SL-P285	A
CONTRACT NO.	GS-10F-0011V	SHEET 5 OF 10

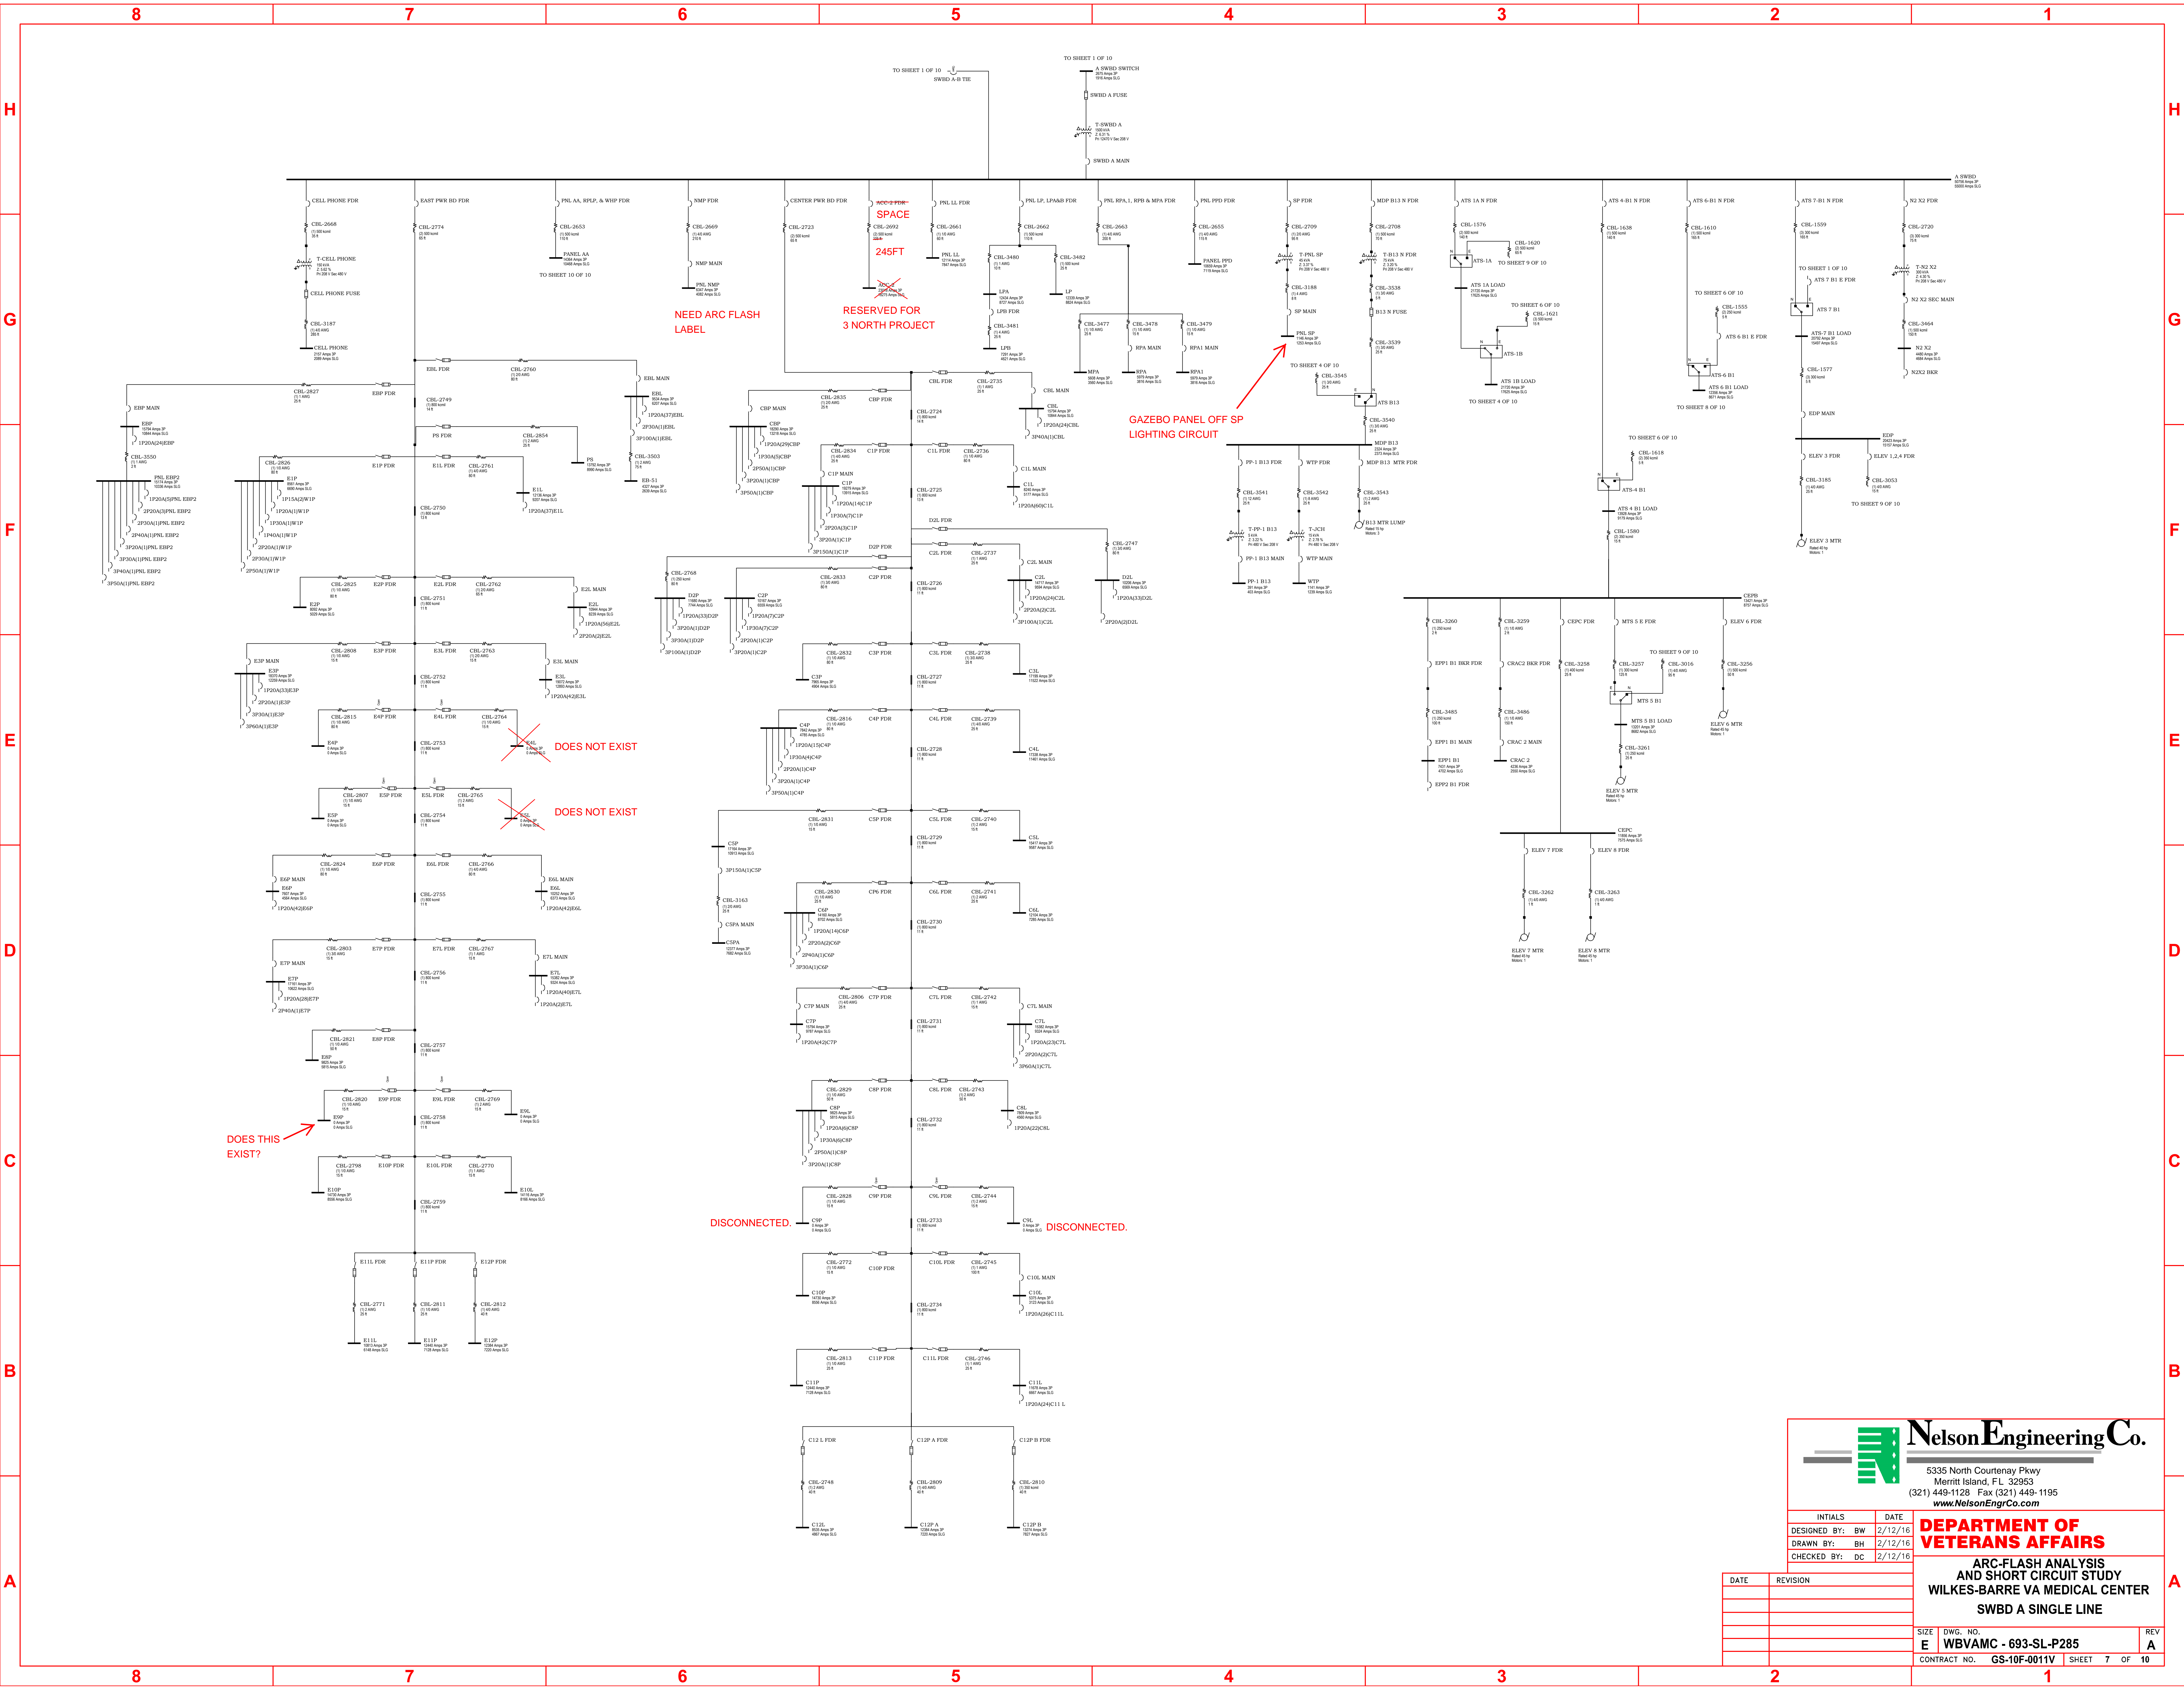

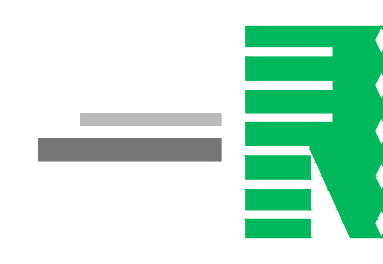


Nelson Engineering Co.
5335 North Courtenay Pkwy
Merritt Island, FL 32953
(321) 449-1128 Fax (321) 449-1195
www.NelsonEngCo.com


INITIALS	DATE
DESIGNED BY: BW	2/12/16
DRAWN BY: BH	2/12/16
CHECKED BY: DC	2/12/16

DATE	REVISION

DEPARTMENT OF VETERANS AFFAIRS
ARC-FLASH ANALYSIS AND SHORT CIRCUIT STUDY
WILKES-BARRE VA MEDICAL CENTER
SWBD A SINGLE LINE

SIZE	DWG. NO.	REV
E	WBVAMC - 693-SL-P285	A
CONTRACT NO.	GS-10F-0011V	SHEET 7 OF 10

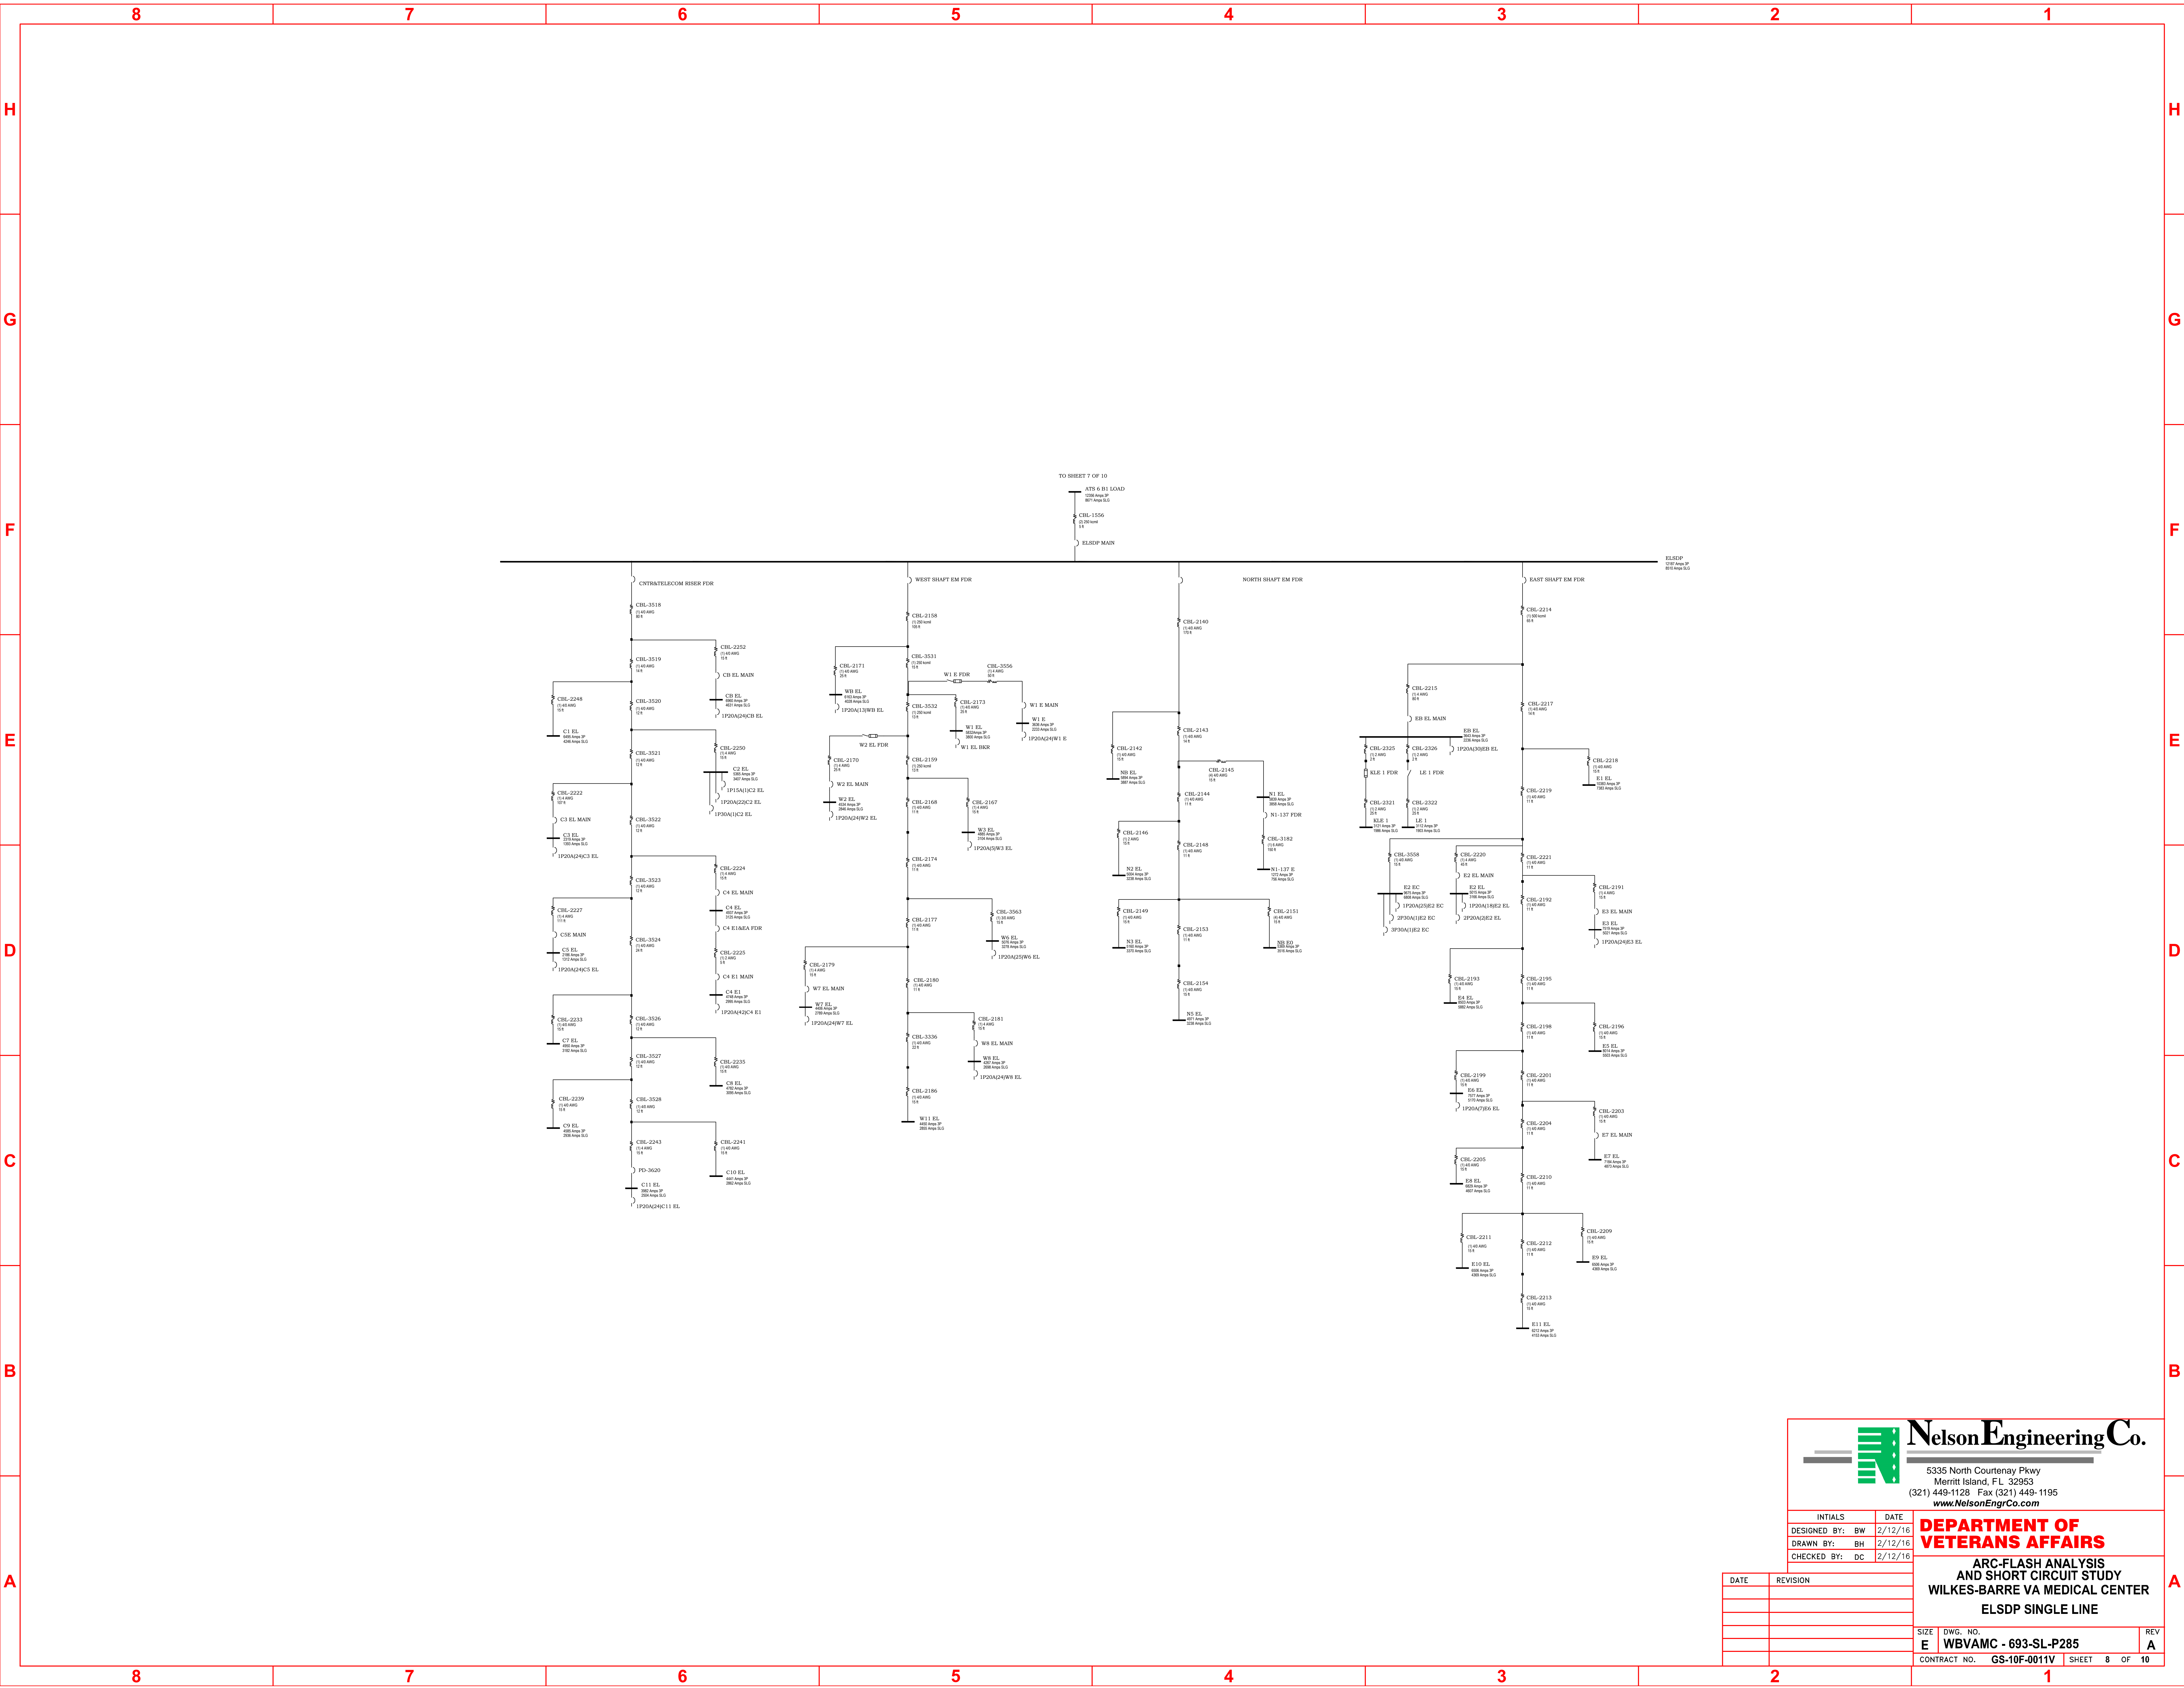




Nelson Engineering Co.
5335 North Courtenay Pkwy
Merritt Island, FL 32953
(321) 449-1128 Fax (321) 449-1195
www.NelsonEngCo.com


INITIALS	DATE
DESIGNED BY: BW	2/12/16
DRAWN BY: BH	2/12/16
CHECKED BY: DC	2/12/16

DEPARTMENT OF VETERANS AFFAIRS
ARC-FLASH ANALYSIS AND SHORT CIRCUIT STUDY
WILKES-BARRE VA MEDICAL CENTER
ELSDP SINGLE LINE

DATE	REVISION

SIZE	DWG. NO.	REV
E	WBVAMC - 693-SL-P285	A
CONTRACT NO.	GS-10F-0011V	SHEET 8 OF 10

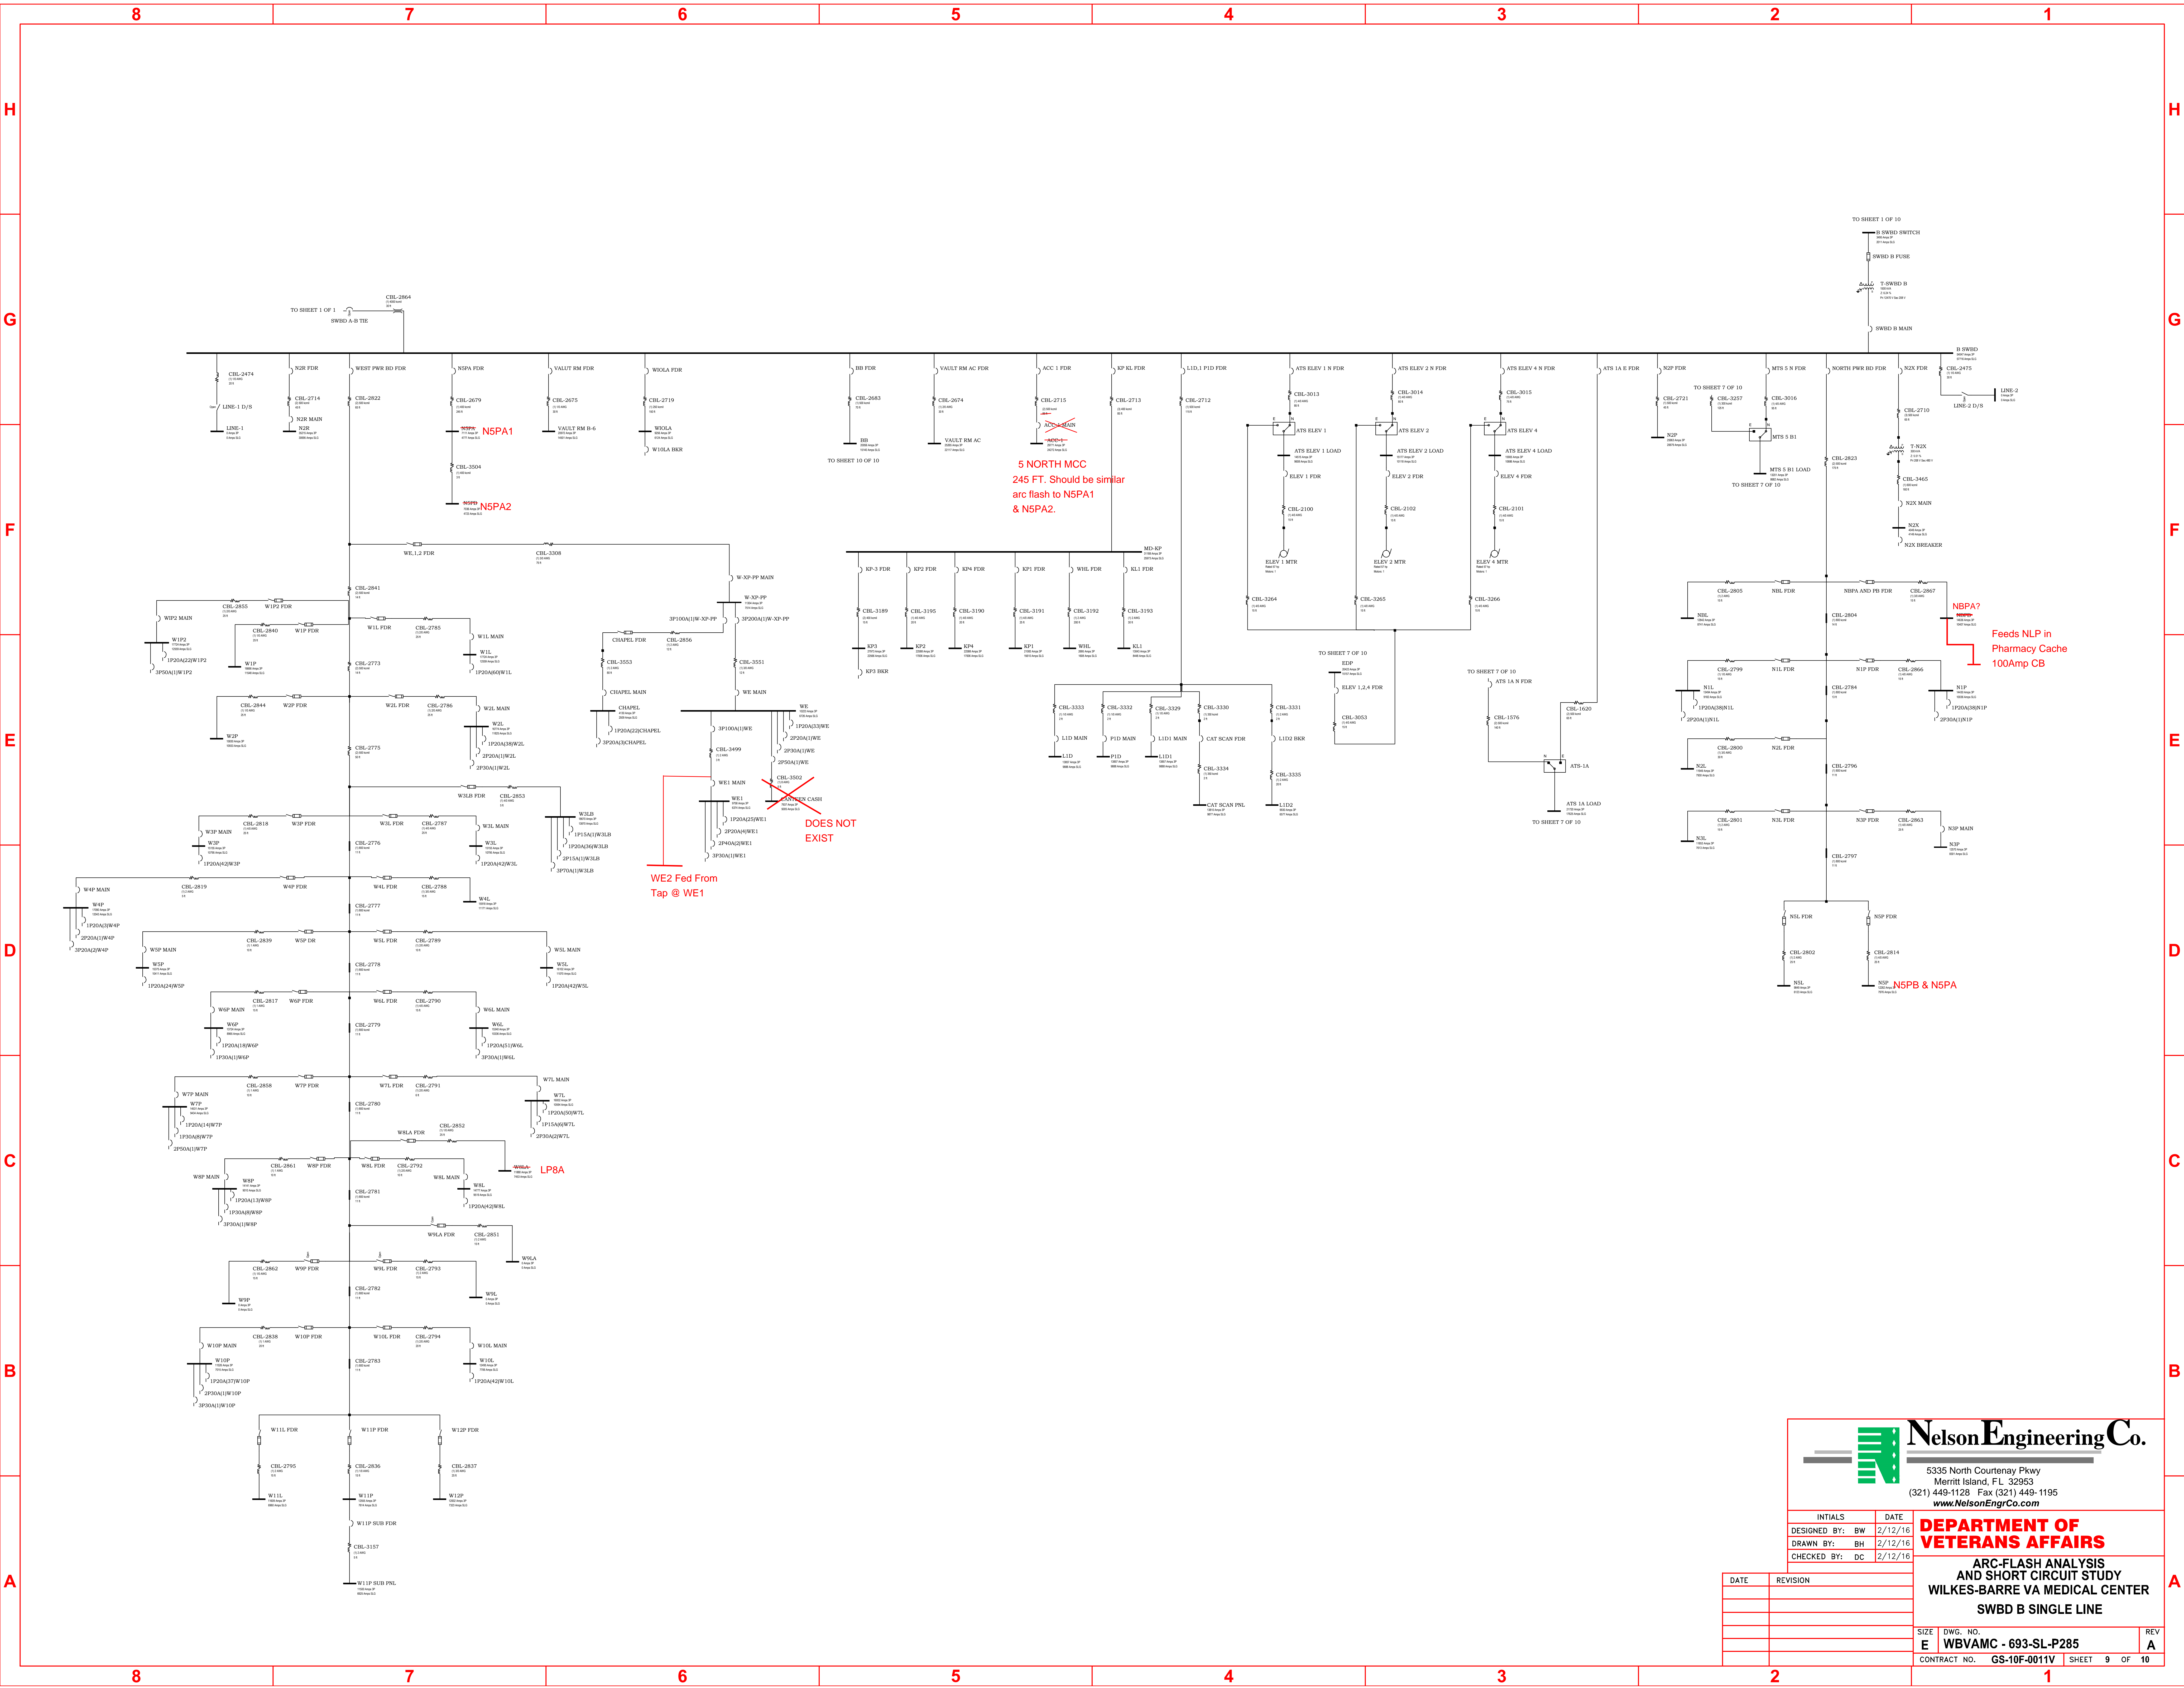

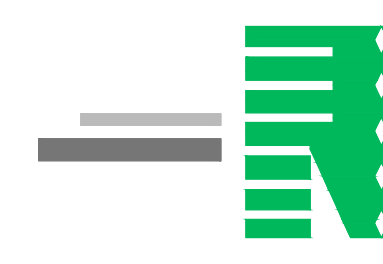


Nelson Engineering Co.
5335 North Courtenay Pkwy
Merritt Island, FL 32953
(321) 449-1128 Fax (321) 449-1195
www.NelsonEngCo.com


INITIALS	DATE
DESIGNED BY: BW	2/12/16
DRAWN BY: BH	2/12/16
CHECKED BY: DC	2/12/16

DATE	REVISION

DEPARTMENT OF VETERANS AFFAIRS
ARC-FLASH ANALYSIS AND SHORT CIRCUIT STUDY
WILKES-BARRE VA MEDICAL CENTER
SWBD B SINGLE LINE

SIZE	DWG. NO.	REV
E	WBVAMC - 693-SL-P285	A
CONTRACT NO.	GS-10F-0011V	SHEET 9 OF 10

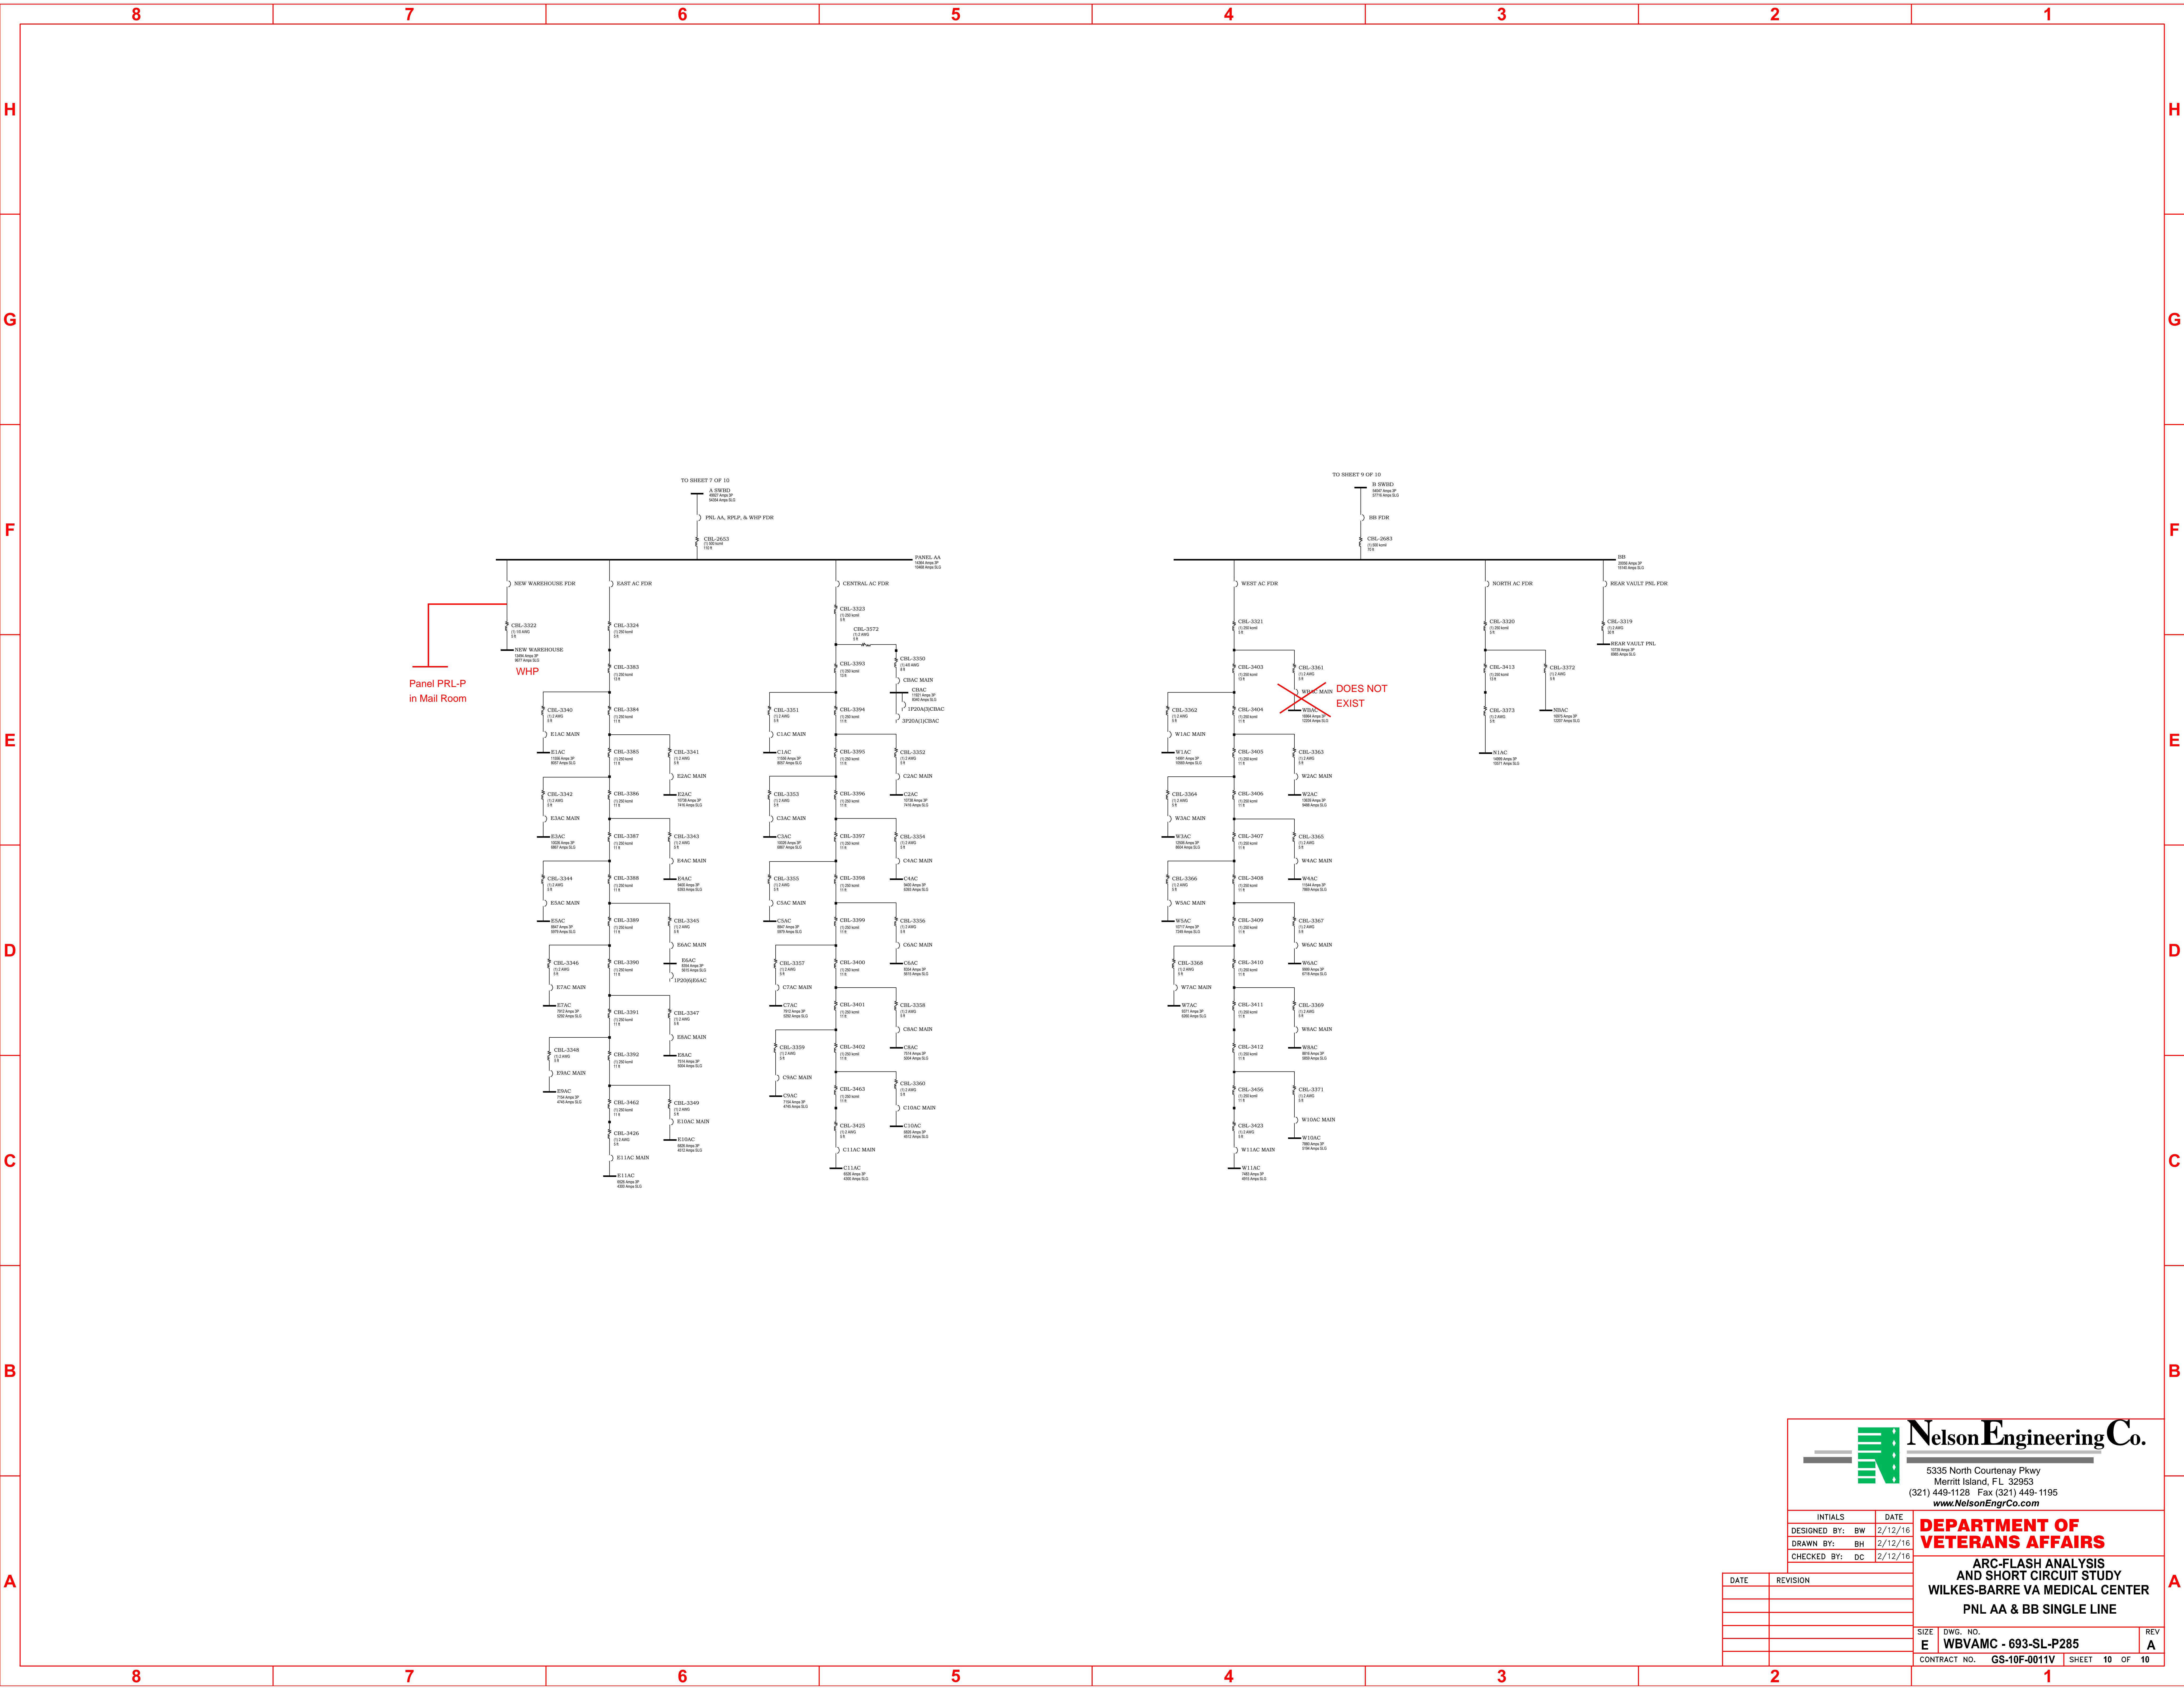



Nelson Engineering Co.
5335 North Courtenay Pkwy
Merritt Island, FL 32953
(321) 449-1128 Fax (321) 449-1195
www.NelsonEngCo.com

INITIALS	DATE
DESIGNED BY: BW	2/12/16
DRAWN BY: BH	2/12/16
CHECKED BY: DC	2/12/16

DEPARTMENT OF VETERANS AFFAIRS
ARC-FLASH ANALYSIS AND SHORT CIRCUIT STUDY
WILKES-BARRE VA MEDICAL CENTER
PNL AA & BB SINGLE LINE

SIZE	DWG. NO.	REV
E	WBVAMC - 693-SL-P285	A
CONTRACT NO. GS-10F-0011V		SHEET 10 OF 10