


ALL ADDENDUM, CLARIFICATION AND  
CHANGE ORDER DATA HAVE BEEN  
ADDED TO THIS DRAWING.  
THIS DRAWING IS COMPLETE AND  
UP-TO-DATE AS OF 3-25-67

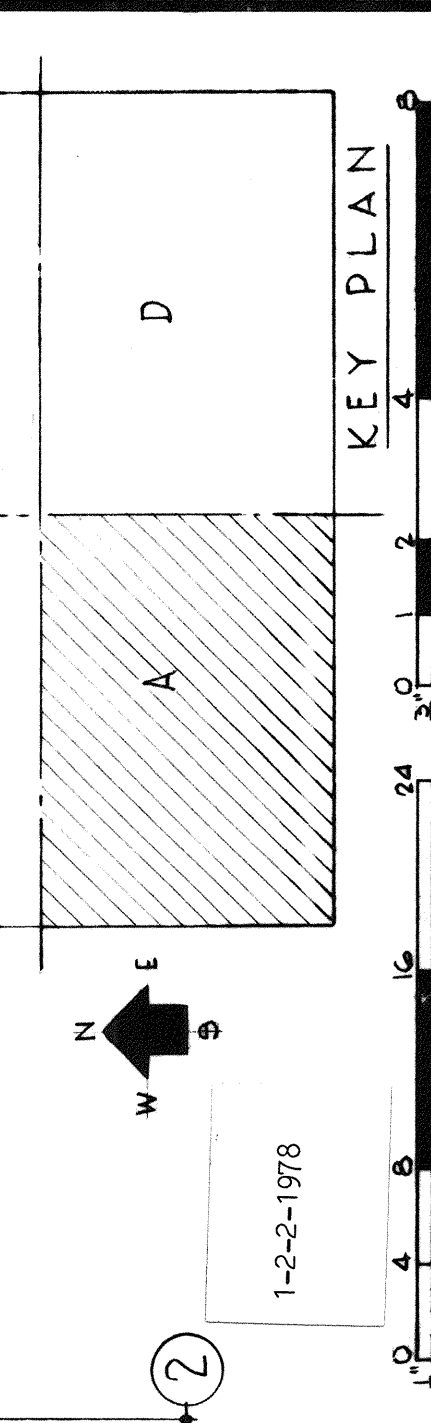

**SECOND FLOOR FRAMING PLAN-SECT."A"**

|   |  |  |   |
|---|--|--|---|
| 1062 BED<br>M. S. & N. HOSPITAL                                     |  | VETERANS ADMINISTRATION<br>MIAMI, FLORIDA                      |   |
| DRAWING NO. <i>5-1-106</i><br>CHECKED <i>HH</i>                     | PROJ. NO. <i>13-500-70</i><br>DATE <i>NOV 5 1964</i> | REV/SIONS  | DRAWING NUMBER<br><b>1-521</b><br>SHEET <i>194</i> OF <i>502</i><br>PROJ. NO. 99-5212 |
| SMITH & KORACH<br>BEISWINGER, HOCH & KANOLD<br>ARCHITECTS-ENGINEERS |  | 721 N.W. 21 STREET - MIAMI, FLORIDA<br>PROJECT <i>113-50-1</i> |   |

