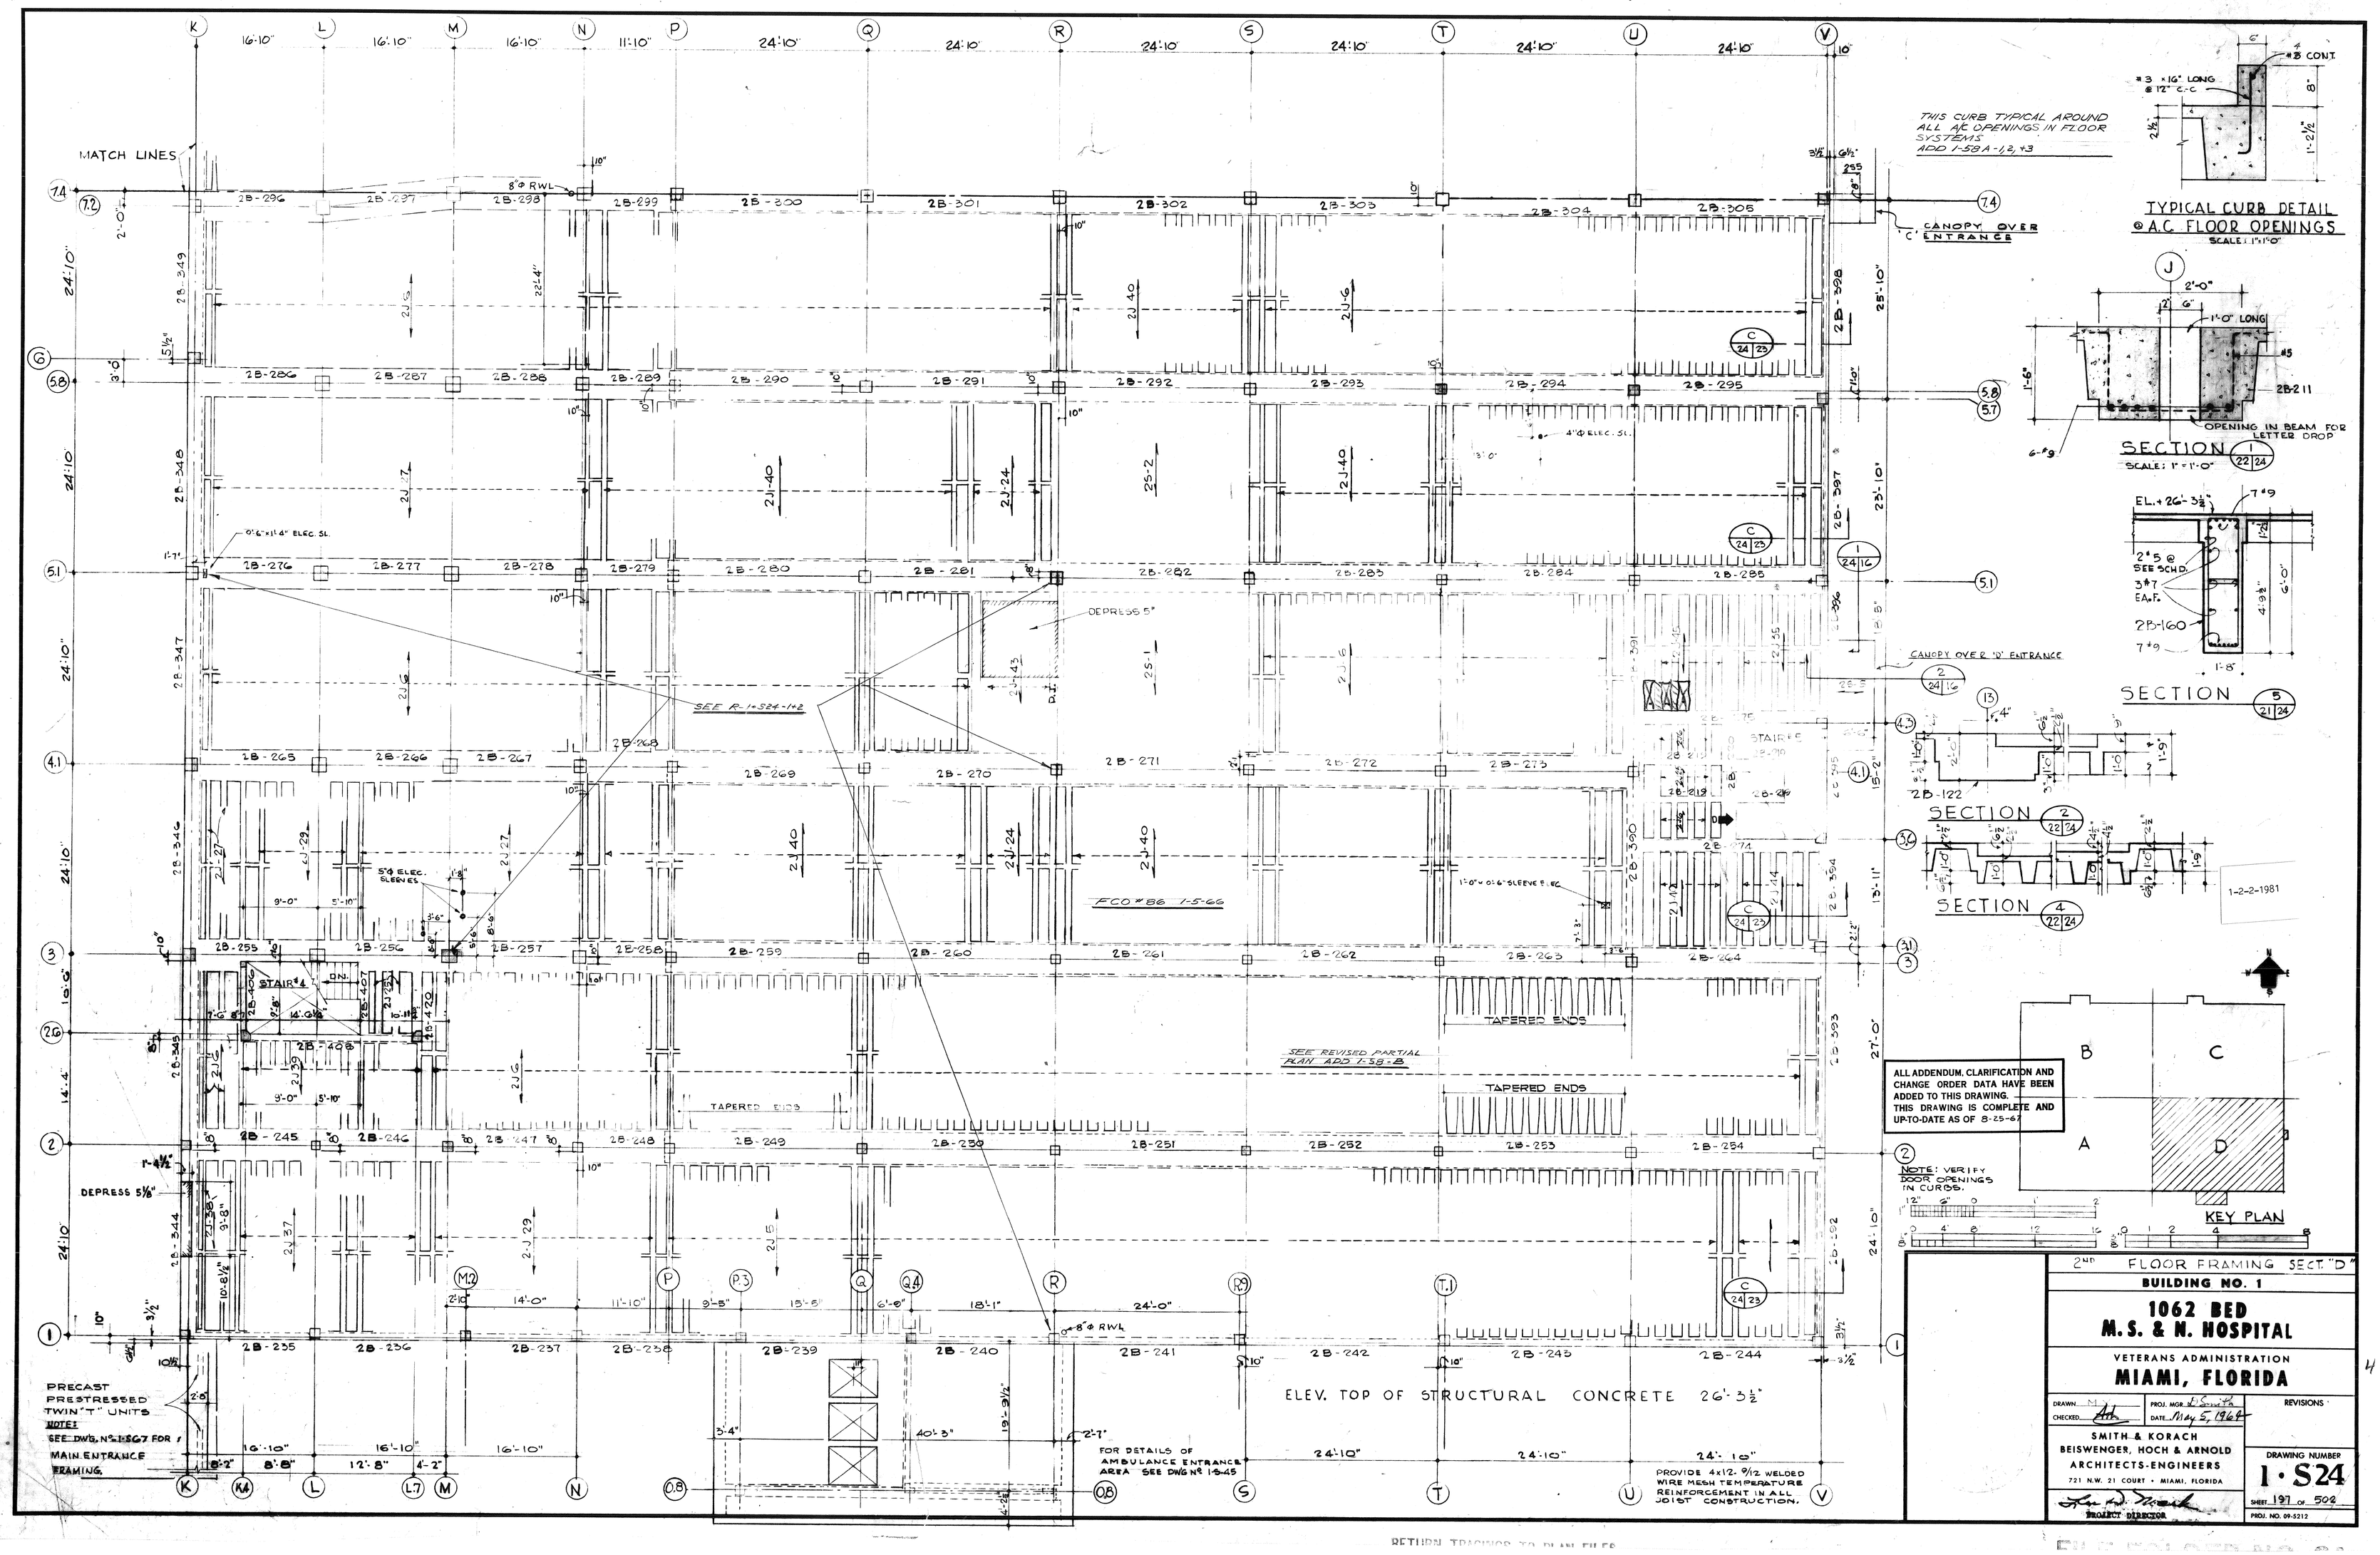

MATCH LINES
THIS CURB TYPICAL AROUND ALL A/C OPENINGS IN FLOOR SYSTEMS ADD 1-58A-1,2,+3
TYPICAL CURB DETAIL @ A.C. FLOOR OPENINGS
SCALE: 1"=1'-0"
CANOPY OVER 'C' ENTRANCE
CANOPY OVER 'D' ENTRANCE
SECTION 1 22 24
SCALE: 1"=1'-0"
OPENING IN BEAM FOR LETTER DROP
SECTION 5 21 24
SECTION 2 22 24
SECTION 4 22 24
SEE R-1-S24-1+2
FCO #86 1-5-66
SEE REVISED PARTIAL PLAN ADD 1-58-B
TAPERED ENDS
DEPRESS 5"
DEPRESS 5 1/8"
STAIR #4
STAIR #5
ELEV. TOP OF STRUCTURAL CONCRETE 26'-3 1/2"
PRECAST PRESTRESSED TWIN "T" UNITS
NOTE: SEE DWG. No. 1-S67 FOR MAIN ENTRANCE FRAMING.
FOR DETAILS OF AMBULANCE ENTRANCE AREA SEE DWG No 1-S-45
PROVIDE 4x12-9/12 WELDED WIRE MESH TEMPERATURE REINFORCEMENT IN ALL JOIST CONSTRUCTION.
ALL ADDENDUM, CLARIFICATION AND CHANGE ORDER DATA HAVE BEEN ADDED TO THIS DRAWING. THIS DRAWING IS COMPLETE AND UP-TO-DATE AS OF 8-25-67
NOTE: VERIFY DOOR OPENINGS IN CURBS.
KEY PLAN
1-2-2-1981
2ND FLOOR FRAMING SECT. "D"
BUILDING NO. 1
1062 BED
M.S. & N. HOSPITAL
VETERANS ADMINISTRATION
MIAMI, FLORIDA
DRAWN
CHECKED
PROJ. MGR.
DATE May 5, 1964
REVISIONS
SMITH & KORACH
BEISWENGER, HOCH & ARNOLD
ARCHITECTS-ENGINEERS
721 N.W. 21 COURT • MIAMI, FLORIDA
PROJECT DIRECTOR
DRAWING NUMBER
1·S24
SHEET 197 OF 502
PROJ. NO. 09-5212