


ALL ADDENDUM CLARIFICATION AND CHANGE ORDER DATA HAVE BEEN ADDED TO THIS DRAWING. THIS DRAWING IS THE LATEST AND UPTO-DATE AS OF 8-15-87

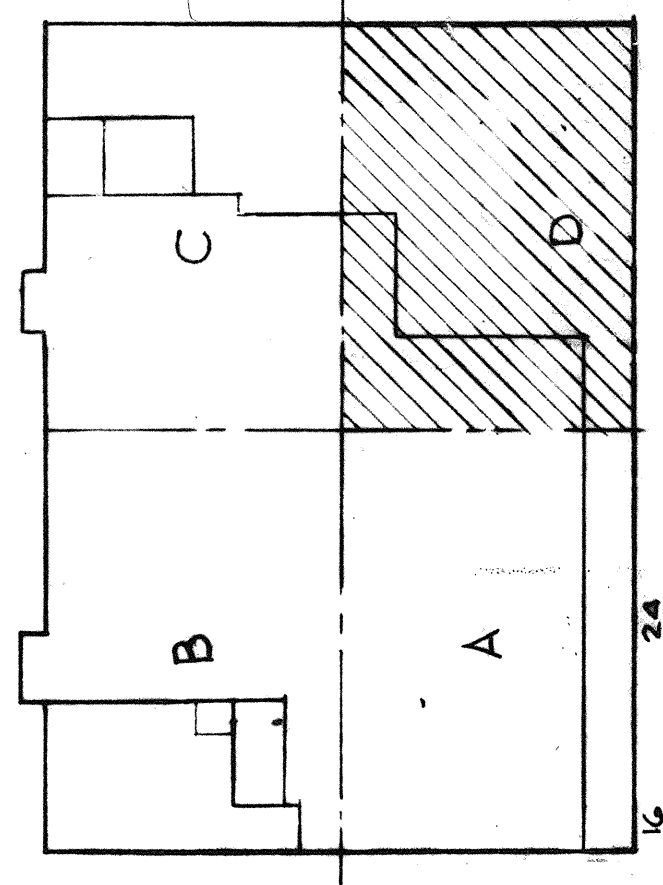

KEY PLAN
1-2-2-1986

BUILDING NO. 1
1062 BED
M. S. & N. HOSPITAL
VETERANS ADMINISTRATION
MIAMI, FLORIDA

REVISIONS

NO.	DATE	DESCRIPTION
1	10/15/84	SMITH & KORACH BEISWENGER, HOCH & ARNOLD ARCHITECTS-ENGINEERS 721 N.W. 21 COURT - MIAMI, FLORIDA

DRAWING NUMBER
I-531
SHEET 204 OF 502
PROJ. NO. 84-0212

ELEV. TOP OF STRUCTURAL CONCRETE 39'-1 1/2"

PROVIDE 4x12-9/12 WELDED
WOOD JOIST BRIDGE
REINFORCEMENT IN ALL
JOIST CONSTRUCTION.

RETURN TO ARCHITECT