

one eighth inch = one foot  
one quarter inch = one foot  
three eighths inch = one foot  
one half inch = one foot  
one inch = one foot  
one and one half inches = one foot  
three inches = one foot

Room Name	Room No.	Quantity	Notes
Equipment Storage	A207	1	
Bathing Suite	A208	1	
Staff Lounge	A209	1	
Staff Lockers	A209A	1	
Staff Toilet	A209B	1	
Semi-Private Office	A210A	1	
Existing Laundry Vestibule	A210B	1	Replace Existing A209 Sign
Workstations	A213	1	
Soiled Utility	C201	1	
Clean Supply	C202	1	
Living Room	C203	1	
Public Toilet	C204	1	ADA Accessible
Dining Room	C205	1	
Kitchen/Servery	C205A	1	
Pantry	C205B	1	
Living Room	C206	1	
Living Room	C207	1	
Bariatric Resident Room	C208	1	
Resident Room	C209	1	
Resident Room	C210	1	
Resident Room	C211	1	
Resident Room	C212	1	
Resident Room	C213	1	
Resident Room	C214	1	
Bariatric Resident Room	C215	1	
Existing Electrical Room	C216	1	
Secondary Carts Storage	C217	1	
Resident Room	C218	1	
Resident Room	C219	1	
Resident Room	C220	1	
Resident Room	C221	1	
Resident Room	C222	1	
Resident Room	C223	1	
Resident Room	C224	1	
Resident Room	C225	1	
HAC/Soiled Trash	C226	1	
Storage	C227	1	
Clean Oxygen	C227A	1	
Dirty Oxygen	C227B	1	
Unit Security	C228	1	
Medication Room	C228A	1	
Team Conference Room	C229	1	
Electrical Closet	C229A	1	
Clean Linen	C230	1	
Staff Toilet	C231	1	
Laundry Room	C232	1	
Corridor	C2-200	1	
Corridor	C2-205	1	
Corridor	C2-206	1	
Corridor	C2-207	1	
Existing Stair	Stair 4	2	2nd & 3rd Floor
Existing Stair	Stair 5	2	3rd & 3rd Floor

1 Signage Schedule  
Second Floor, Wards 2A & 2C

2

Room Name	Room No.	Quantity	Notes
Semi-Private Office	A301	1	
Electrical Closet	A301A	1	
Biohazard Storage	A302	1	
Building Connection	A303	1	
Elevator Lobby	A304	1	
Service Elevator Lobby	A305	1	
Electrical Closet	A305A	1	
Existing Telephone Room	A306	1	
Equipment Storage	A307	1	
Bathing Suite	A308	1	
Staff Lounge	A309	1	
Staff Lockers	A309A	1	
Staff Toilet	A309B	1	
Semi-Private Office	A310	1	
Laundry Chute Vestibule	A311	1	
Multipurpose Room	A312	2	
Multipurpose Room Closet	A312A	1	
Multipurpose Room Closet	A312B	1	
Multipurpose Room Closet	A312C	1	



2 Signage Schedule  
Third Floor, Wards 3A

3



Room Name	Room No.	Quantity	Notes
Soiled Utility	C301	1	
Clean Supply	C302	1	
Living Room	C303	1	
Public Toilet	C304	1	ADA Accessible
Dining Room	C305	1	
Kitchen/Servery	C305A	1	
Pantry	C305B	1	
Living Room	C306	1	
Living Room	C307	1	
Bariatric Resident Room	C308	1	
Resident Room	C309	1	
Resident Room	C310	1	
Resident Room	C311	1	
Resident Room	C312	1	
Resident Room	C313	1	
Resident Room	C314	1	
Bariatric Resident Room	C315	1	
Existing Electrical Room	C316	1	
Secondary Carts Storage	C317	1	
Resident Room	C318	1	
Resident Room	C319	1	
Resident Room	C320	1	
Resident Room	C321	1	
Resident Room	C322	1	
Resident Room	C323	1	
Resident Room	C324	1	
Resident Room	C325	1	
HAC/Soiled Trash	C326	1	
Storage	C327	1	
Clean Oxygen	C327A	1	
Dirty Oxygen	C327B	1	
Unit Security	C328	1	
Medication Room	C328A	1	
Team Conference	C329	1	
Electrical Closet	C329A	1	
Clean Linen	C330	1	
Staff Toilet	C331	1	
Laundry Room	C332	1	
Corridor	C3-300	1	
Corridor	C3-301	1	
Corridor	C3-305	1	
Corridor	C3-306	1	
Corridor	C3-307	1	
Existing Stair	Stair 1	1	

3 Signage Schedule  
Third Floor, Ward 3C

6

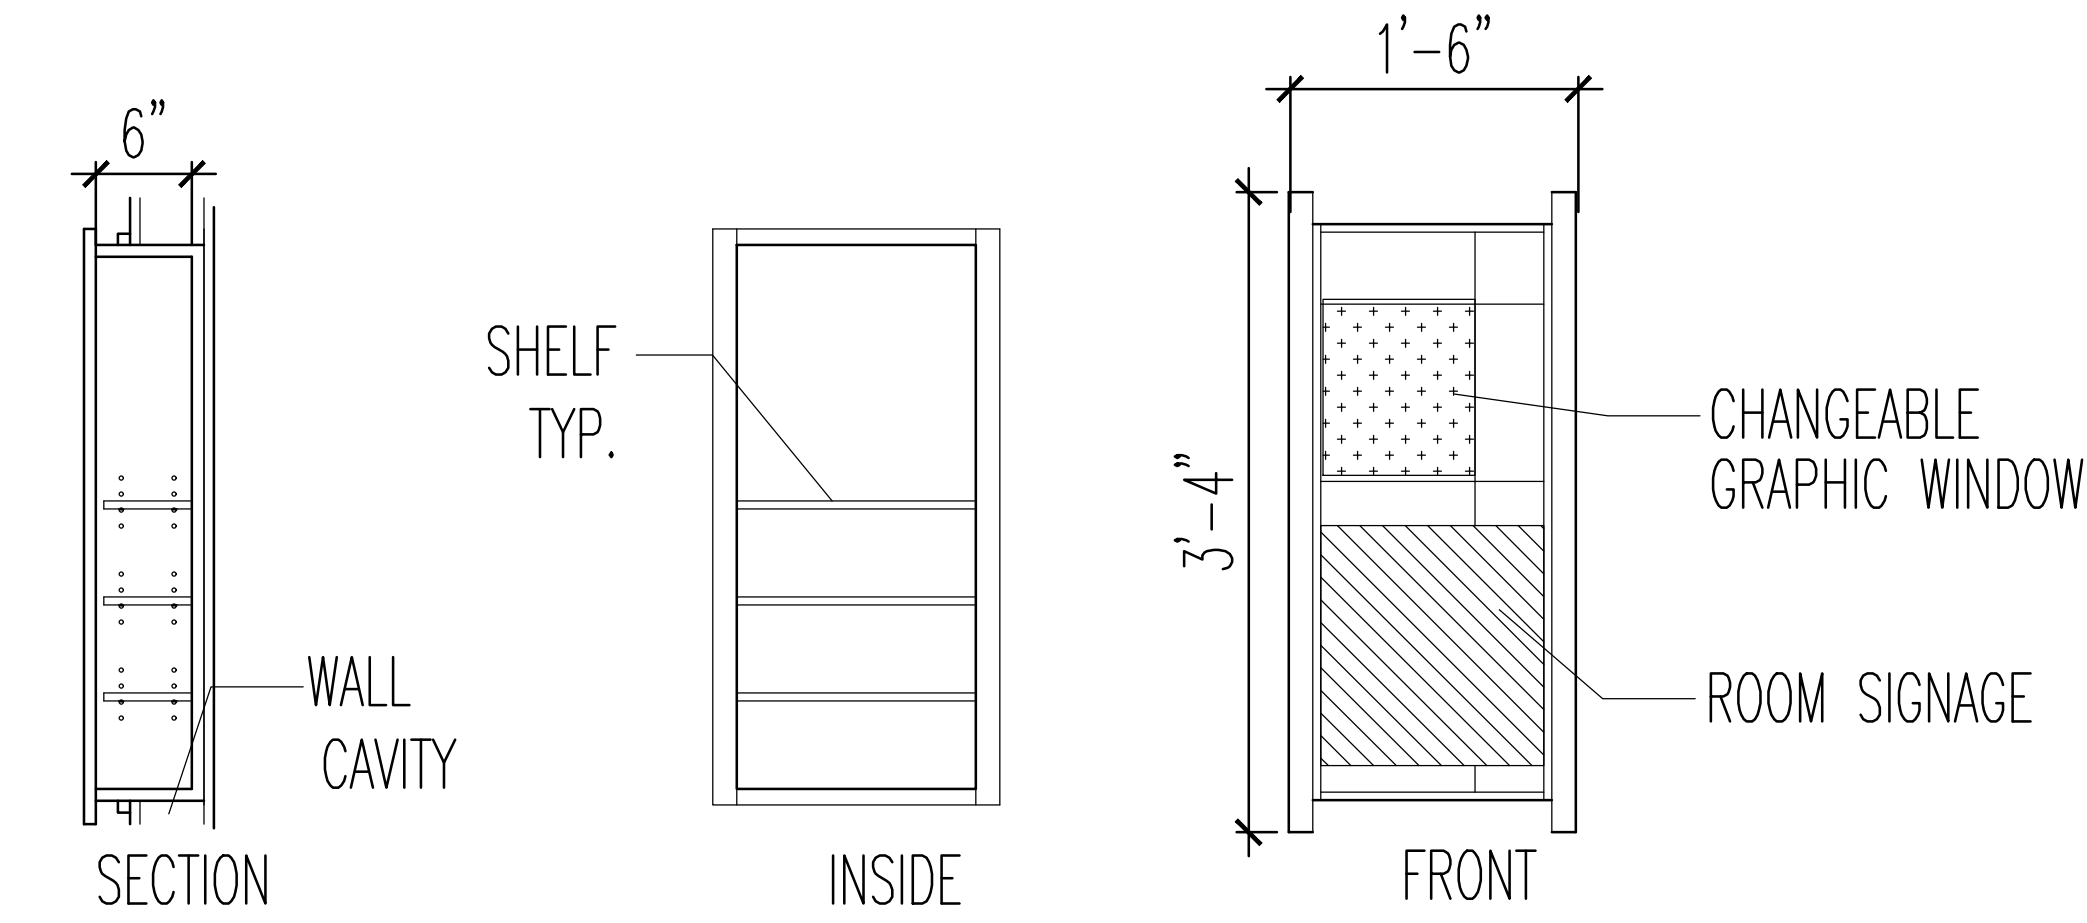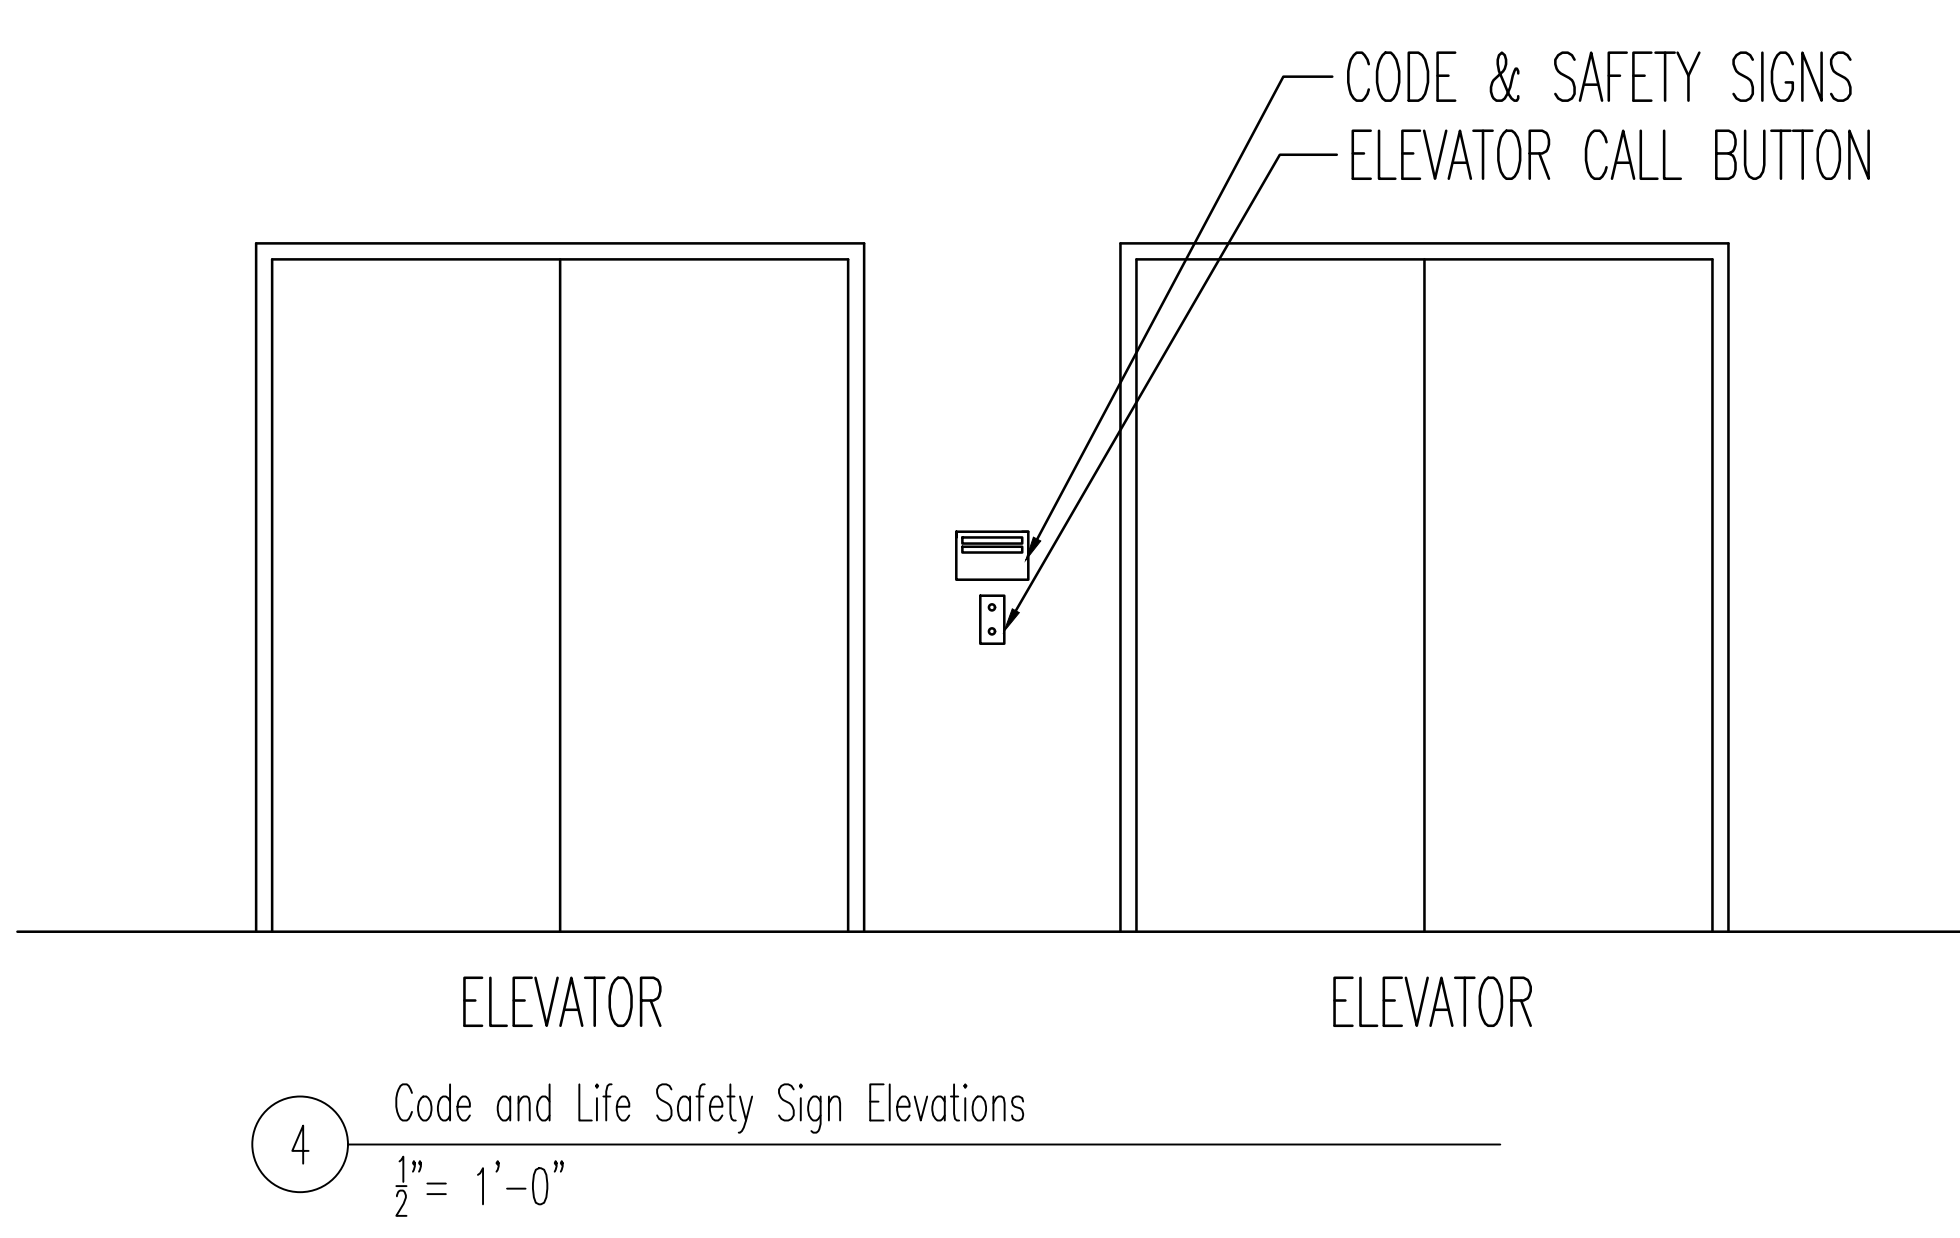

5 Resident Cabinet Details  
1" = 1'-0"

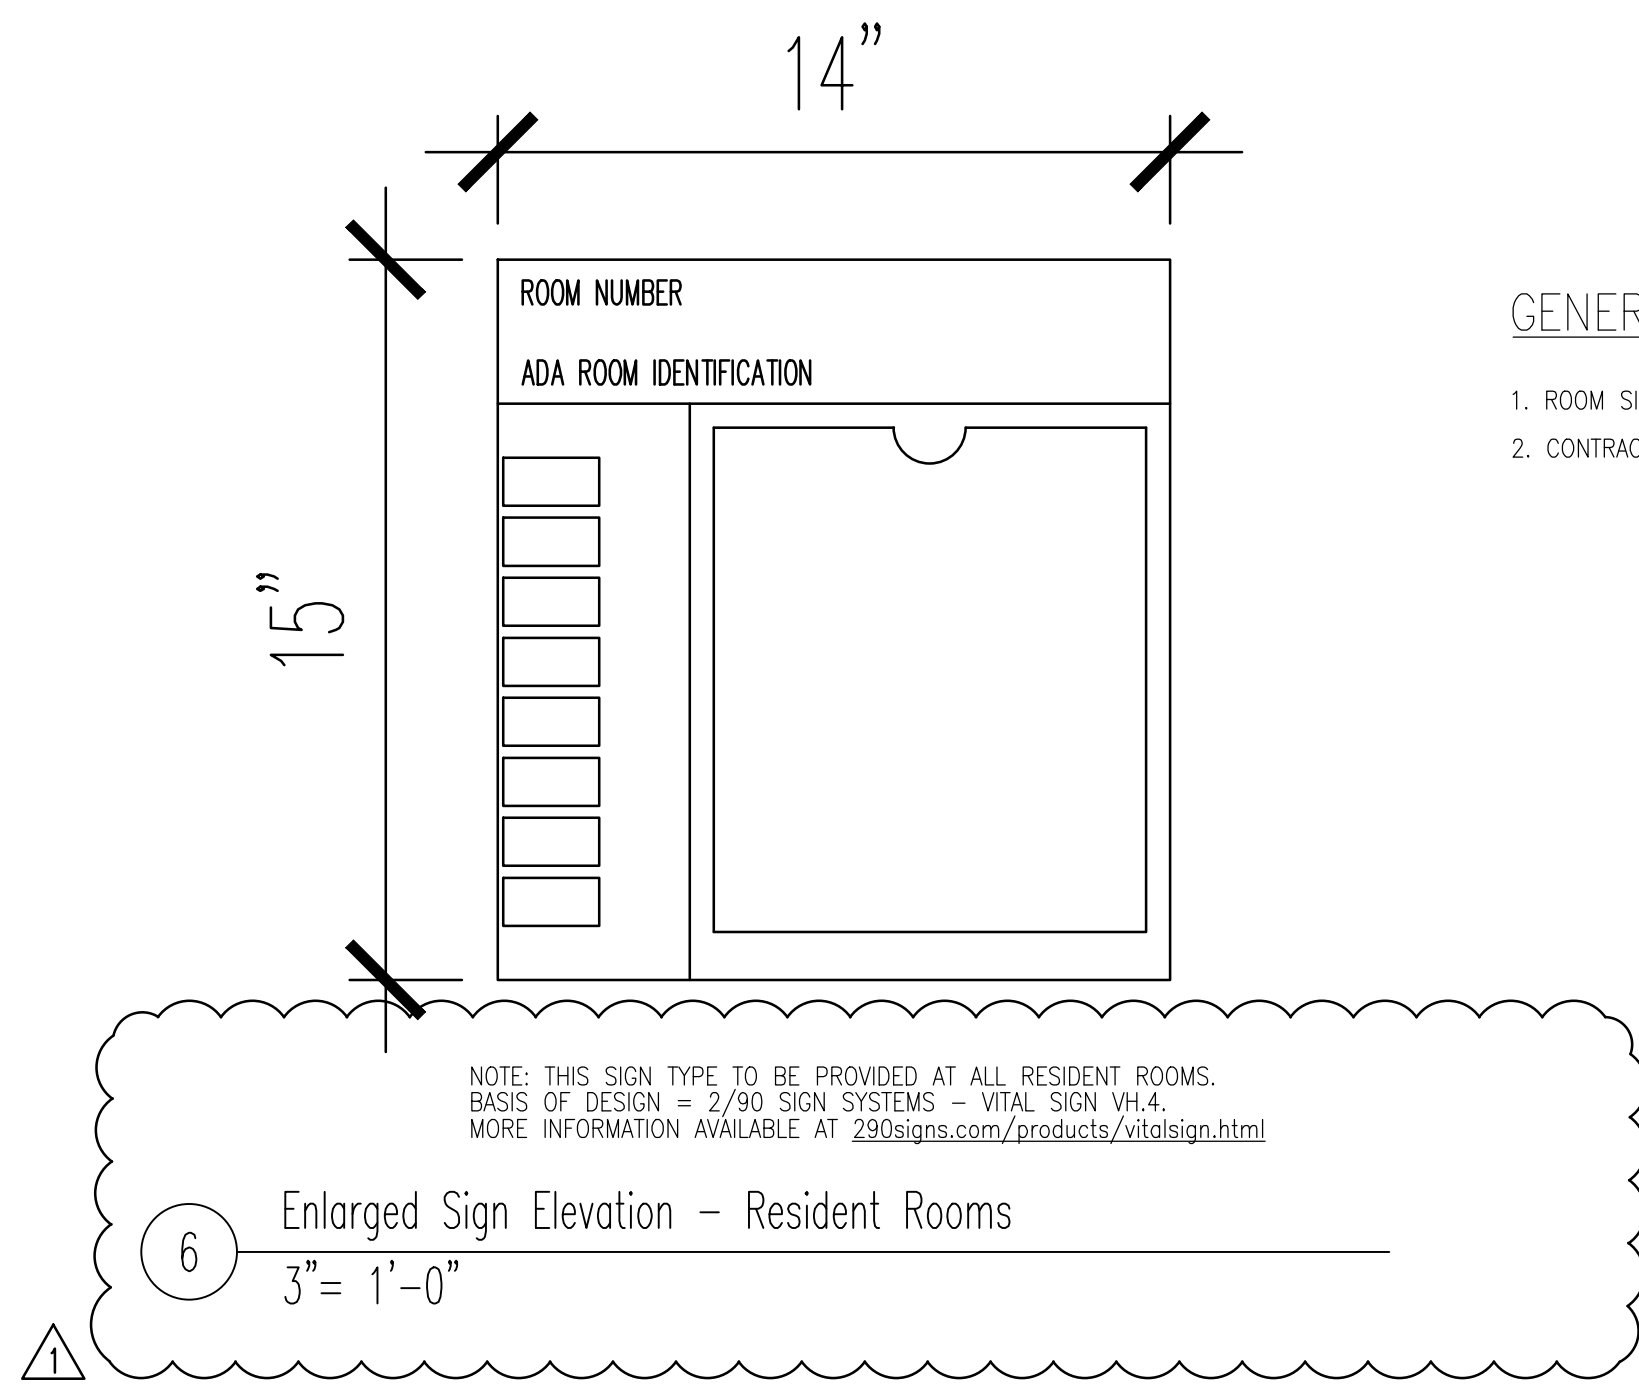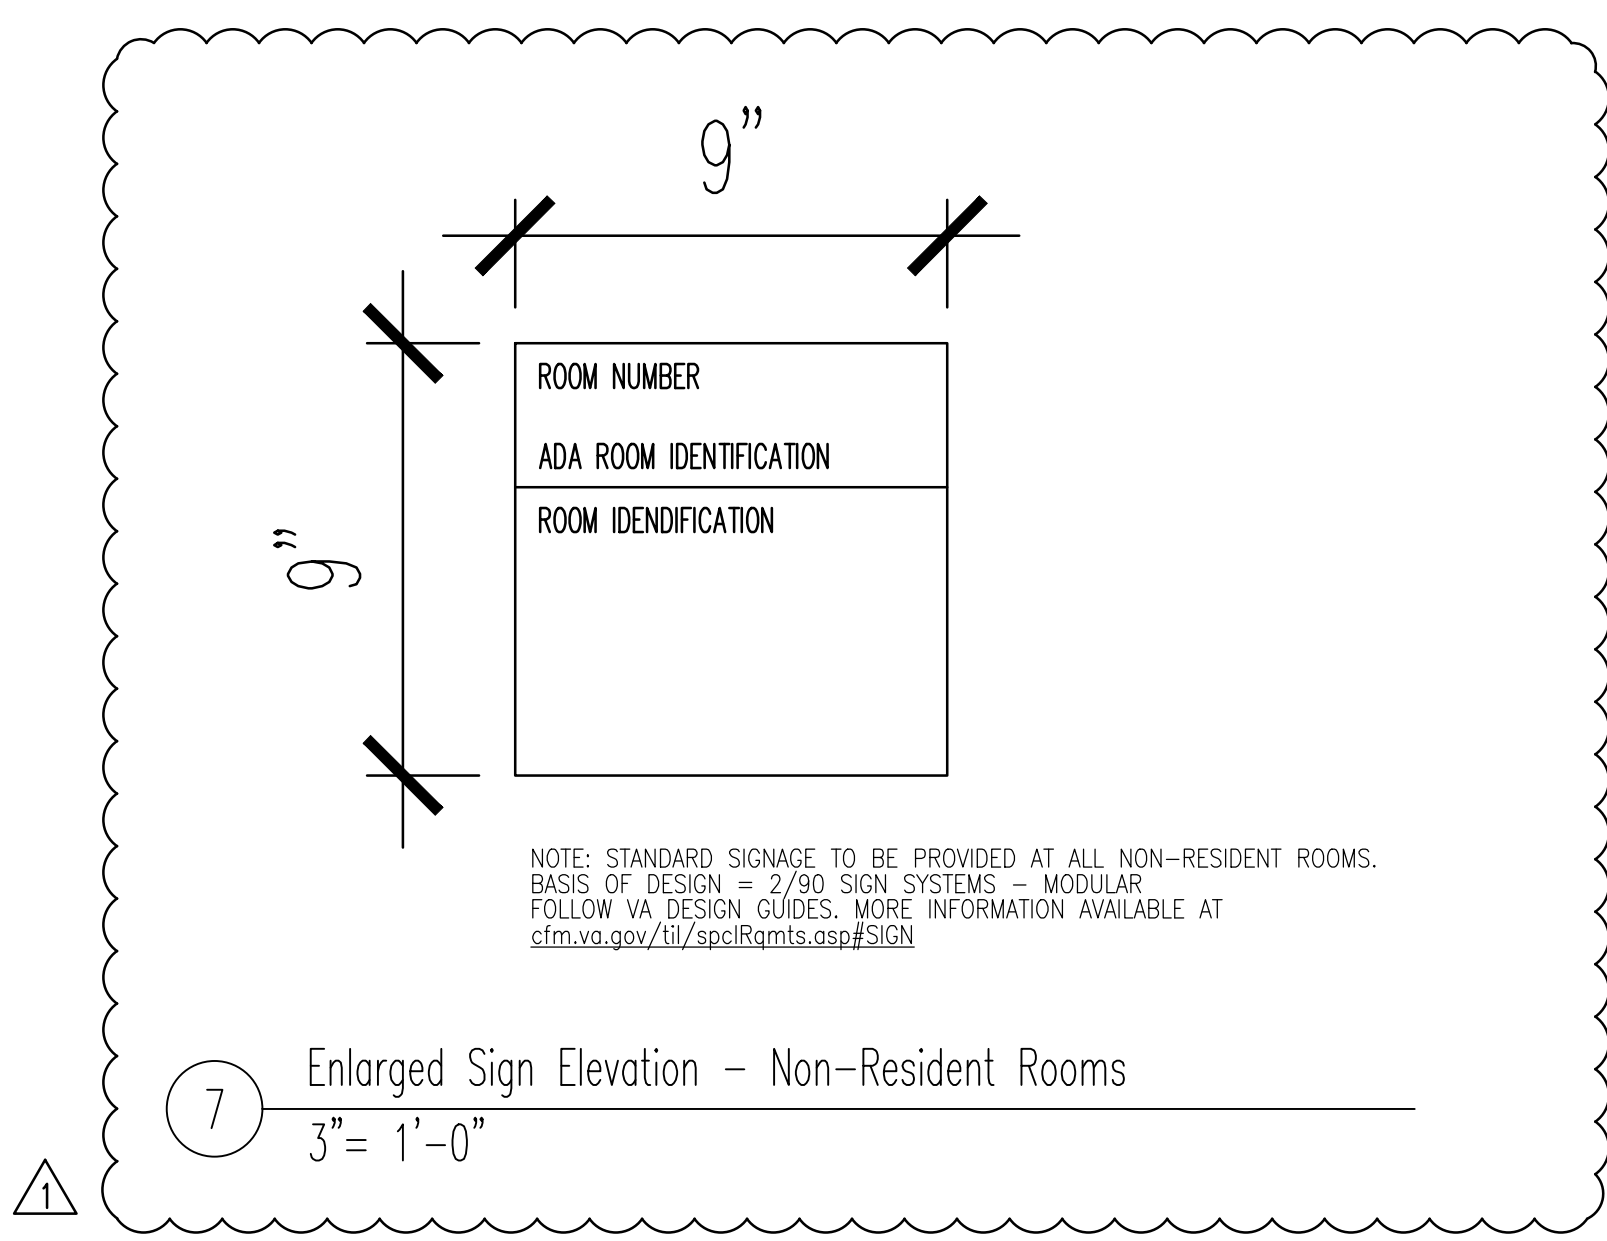

GENERAL NOTES:  
1. ROOM SIGN TO BE INTEGRATED INTO RESIDENT HALL CABINETS  
2. CONTRACTOR TO PROVIDE RESIDENT HALL CABINETS AND ROOM SIGNS

Revisions:	Date
1	11/23/2016
2	
3	
4	
5	
6	
7	
8	
9	
10	
11	
12	
13	
14	
15	
16	

CONSULTANTS:		
Altus Architectural Studios, Inc. 12925 W. Dodge Road Omaha, Nebraska 68154	Avanti Environmental Group 309 North Water Street Suite 650 Milwaukee, WI 53202	Specialized Engineering Solutions, Inc. 10360 Ellison Circle Omaha, Nebraska 68134
American Structurespoint, Inc. 7260 Shadeland Station Indianapolis, IN 46256	Middleton Construction Consulting 330 East Kilbourn Ave Suite 565 Milwaukee, WI 53202	

ARCHITECT/ENGINEERS:
13100 watertown plank road suite 200 elm grove, wi 53122
<b>nagel</b> architects
Nagel Architects Project Number: 140701

Drawing Title
SIGNAGE SCHEDULES AND DETAILS SECOND AND THIRD FLOOR
Approved: Project Director
-
-
-

Project Title
RENOVATE 3 WARDS OF CLC IN BLDG 134
Location
Captain James A. Lovell FHCC, North Chicago, IL
Date
June 1, 2016
Checked
SAM
Drawn
EAG

Project Number
556-14-011
Building Number
BLDG 134, WARDS 2C, 3A, 3B, 3C
Drawing Number
ASI501
Dwg 056 of 146

100% Bid Documents
Office of Construction and Facilities Management
Department of Veterans Affairs