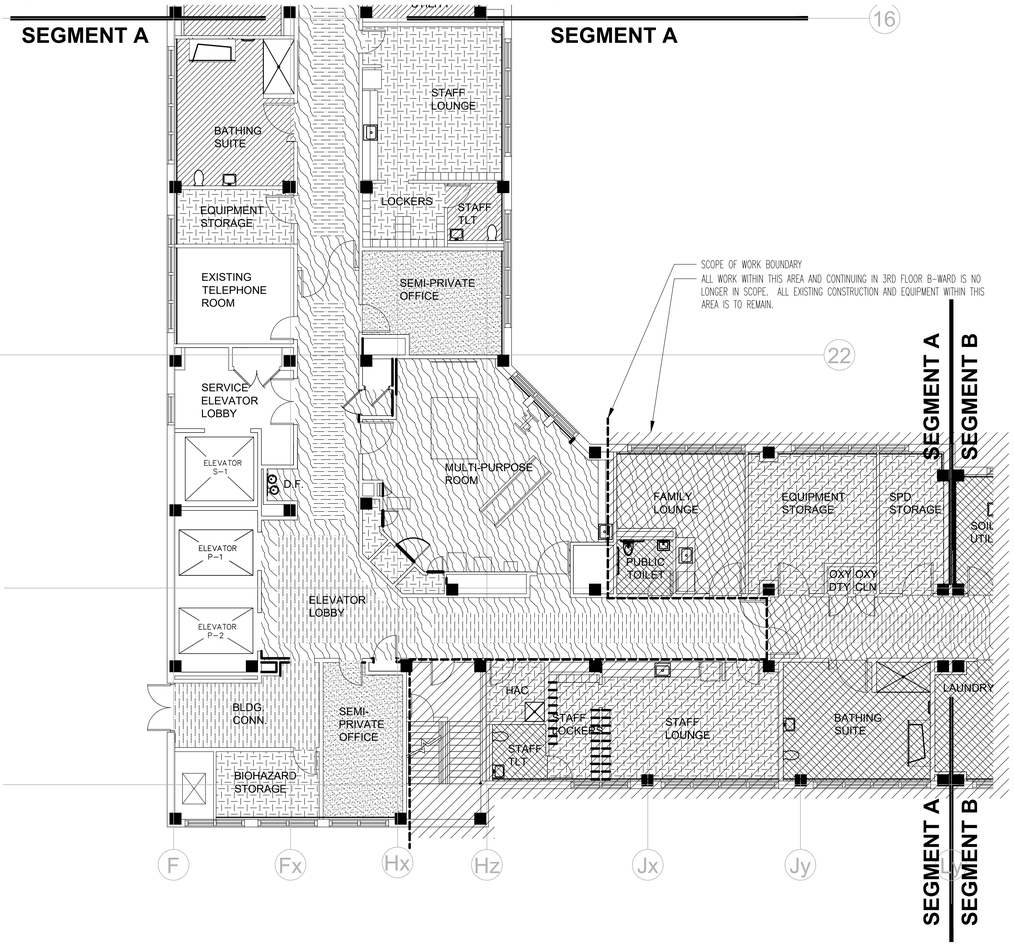

LEGEND

SV-1	VCT
SV-2	PT-1 (1)
SV-3	CT-2
EPOXY	CARPET

1 Architectural Floor Pattern Plan
Third Floor, Ward 3A
1/8" = 1'-0"

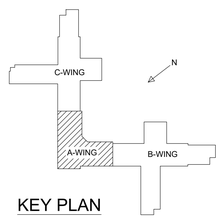

KEY PLAN

100% Bid Documents

Revisions	Date
-	-
-	-
-	-
-	-
-	-
-	-
-	-
-	-
1 BID CLARIFICATIONS (TILE IN SHOWERS)	1/20/2017

CONSULTANTS:

Altus Architectural Studios, Inc.
12925 W. Dodge Road
Omaha, Nebraska 68154

Avantti Environmental Group
309 North Water Street
Suite 650
Milwaukee, WI 53202

Specialized Engineering Solutions, Inc.
10360 Ellison Circle
Omaha, Nebraska 68134

American Structurepoint, Inc.
7260 Shadeland Station
Indianapolis, IN 46256

Middleton Construction Consulting
330 East Kilbourn Ave
Suite 565
Milwaukee, WI 53202

ARCHITECT/ENGINEERS:

13100 watertown plank road
suite 200
elm grove, wi 53122

nagel architects

Nagel Architects Project Number: 140701

Drawing Title: FLOOR PATTERN PLAN THIRD FLOOR, WARD 3A

Approved: Project Director
-
-
-

Project Title: RENOVATE 3 WARDS OF CLC IN BLDG 134

Location: Captain James A. Lovell FHCC, North Chicago, IL

Date: June 1, 2016 | Checked: SAM | Drawn: EAG

Project Number: 556-14-011

Building Number: BLDG 134, WARDS 2C, 3A, 3B, 3C

Drawing Number: AF113.A

Dwg 027 of 146

Office of Construction and Facilities Management

Department of Veterans Affairs

VA FORM 08-6231