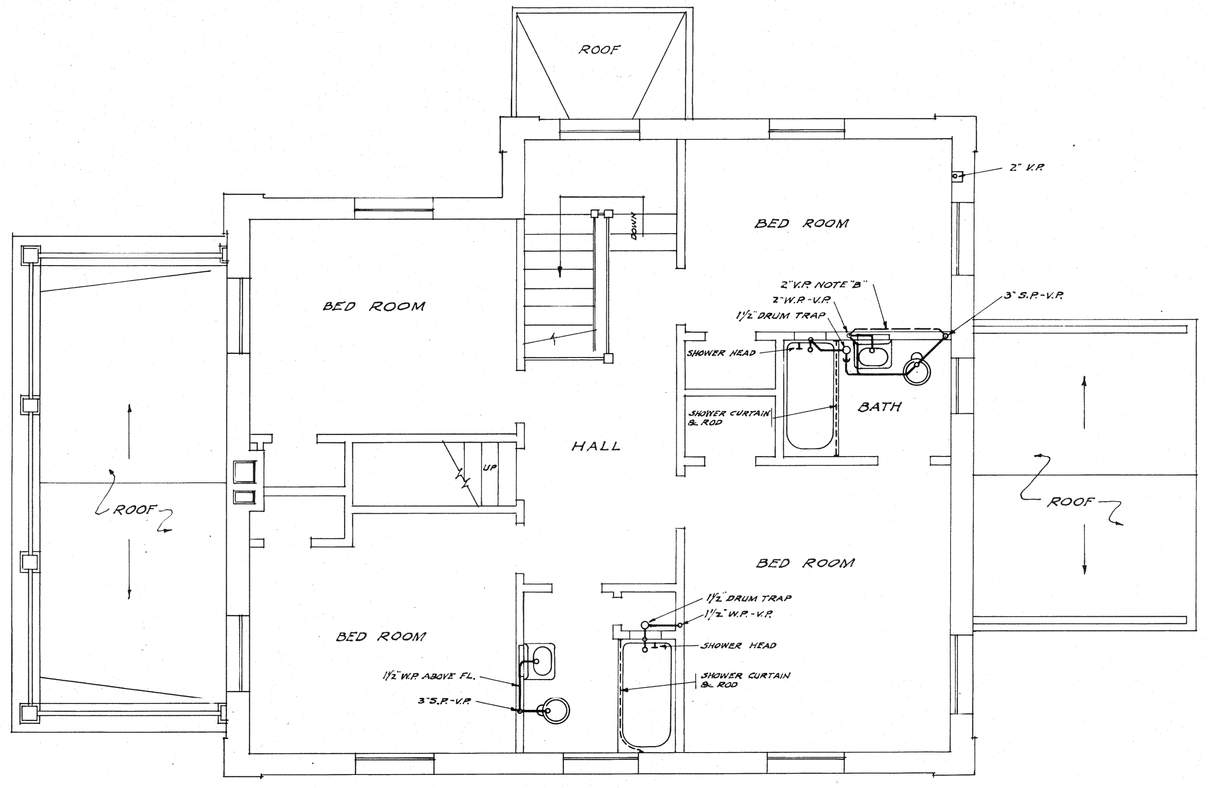

SECOND FLOOR PLAN
SCALE 1/4" = 1'-0"

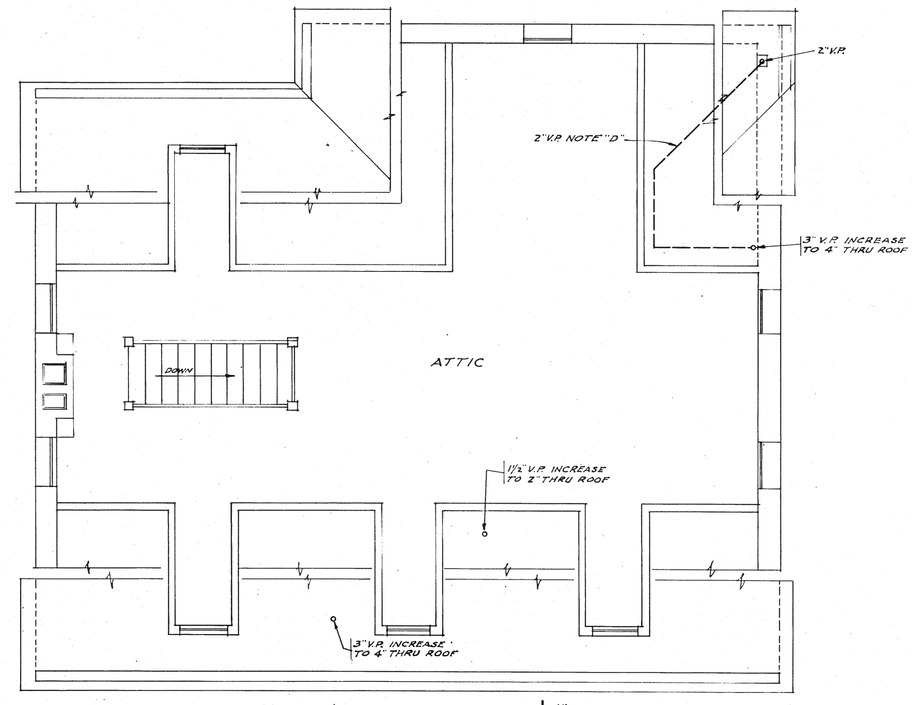

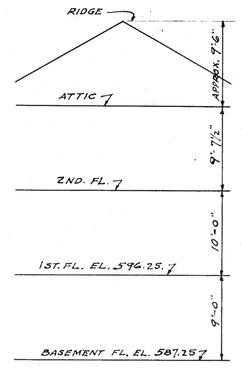

STORY HEIGHTS
NOT TO SCALE

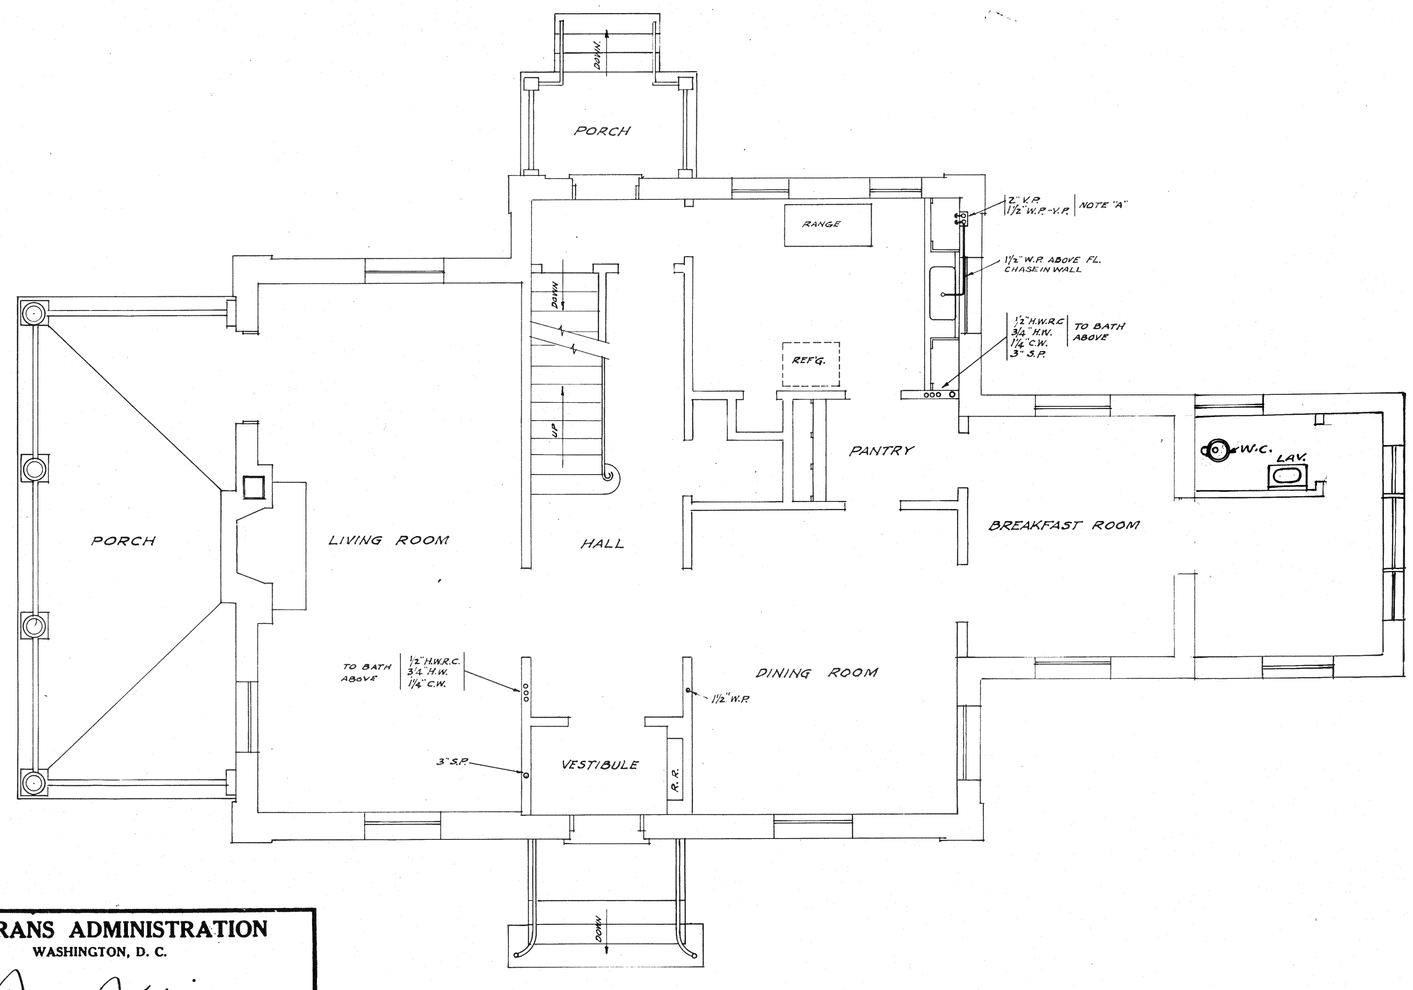

FIRST FLOOR PLAN
SCALE 1/4" = 1'-0"

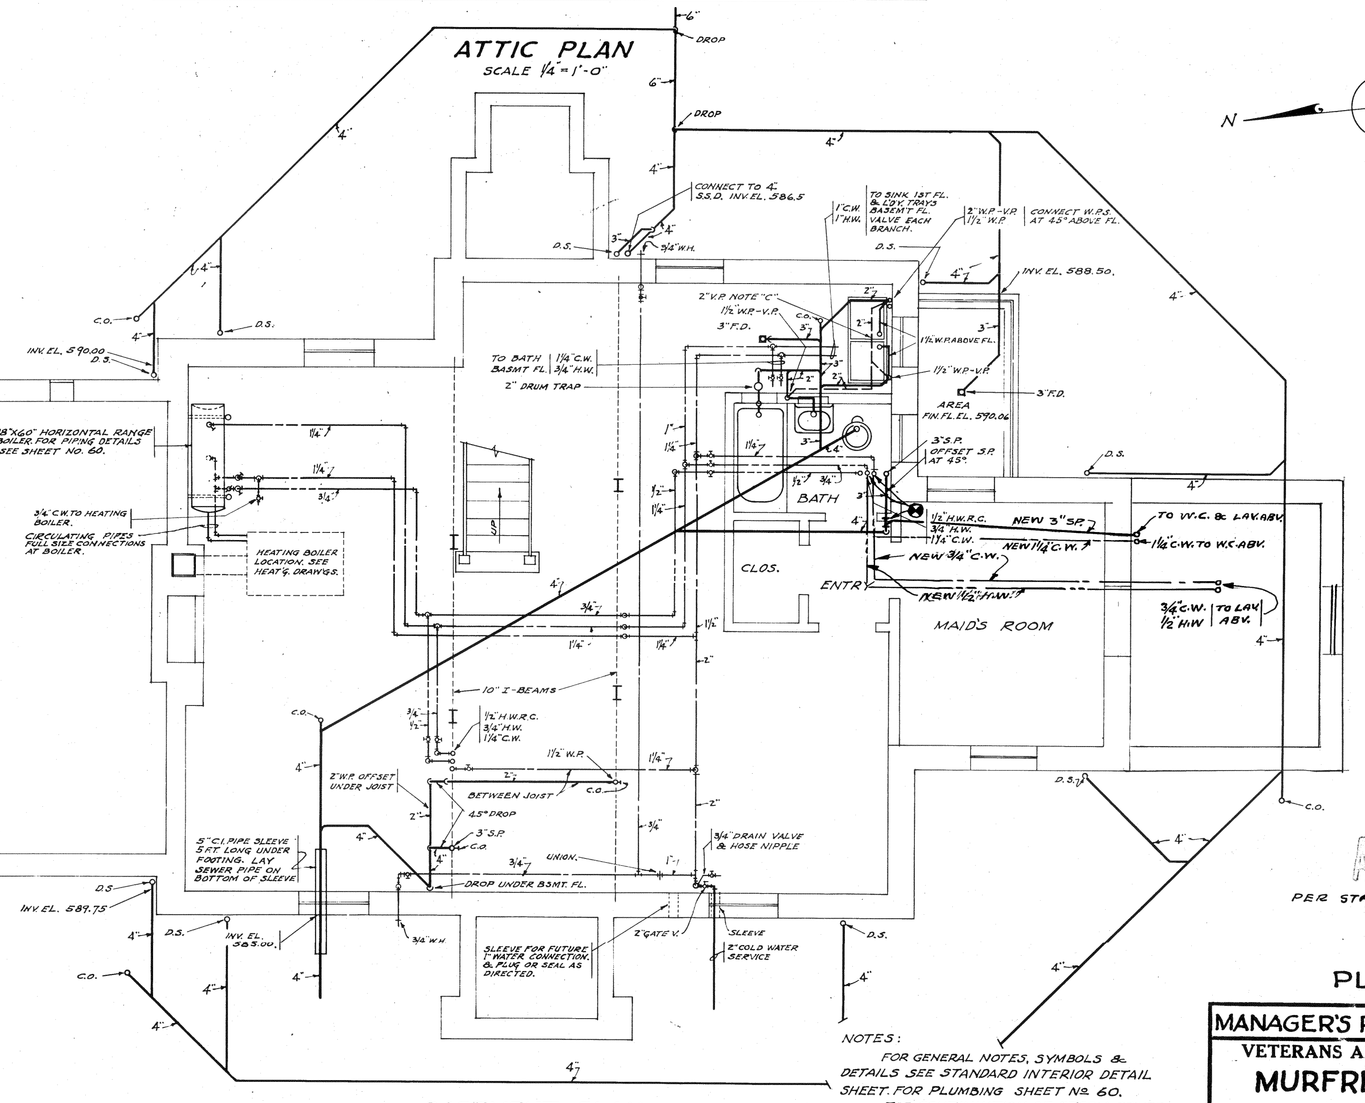

BASEMENT PLAN
SCALE 1/4" = 1'-0"

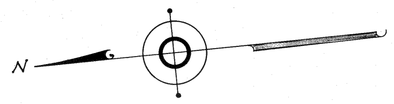

ATTIC PLAN
SCALE 1/4" = 1'-0"

AS BUILT
PER STATION LETTER 11-6-56

NOTES:
FOR GENERAL NOTES, SYMBOLS & DETAILS SEE STANDARD INTERIOR DETAIL SHEET. FOR PLUMBING SHEET No. 60.
FOR CONTINUATION OF STORM SEWER, SANITARY SEWER & WATER SERVICE SEE SHEETS Nos 4 & 5.

1-2-2-1284

VETERANS ADMINISTRATION
WASHINGTON, D. C.

APPROVED Frank T. Hines Administrator
Harry E. Jaines Assistant Administrator
Director of Construction
Chief, Technical Division

PLUMBING

MANAGER'S RESIDENCE BLDG. No 18.
VETERANS ADMINISTRATION FACILITY
MURFREESBORO, TENN.

Drawn R.Y. SMITH, JR.	REVISIONS	NUMBER
Traced R.Y. SMITH, JR.	9-4-58 "AS BUILT" R.G.H.	18-3
Sect. Chf. [illegible]		
Date MAR. 31, 1938.		SHEET 3 OF 5
Sub-division Chief [illegible]		Proj. No. 1410

6960

RETURN TRACINGS TO PLAN FILES

FILE FOLDER NO 2

3