



three inches = one foot
one and one half inches = one foot
one inch = one foot
three quarters inch = one foot
one half inch = one foot
three eighths inch = one foot
one eighth inch = one foot
one quarter inch = one foot
one eighth inch = one foot

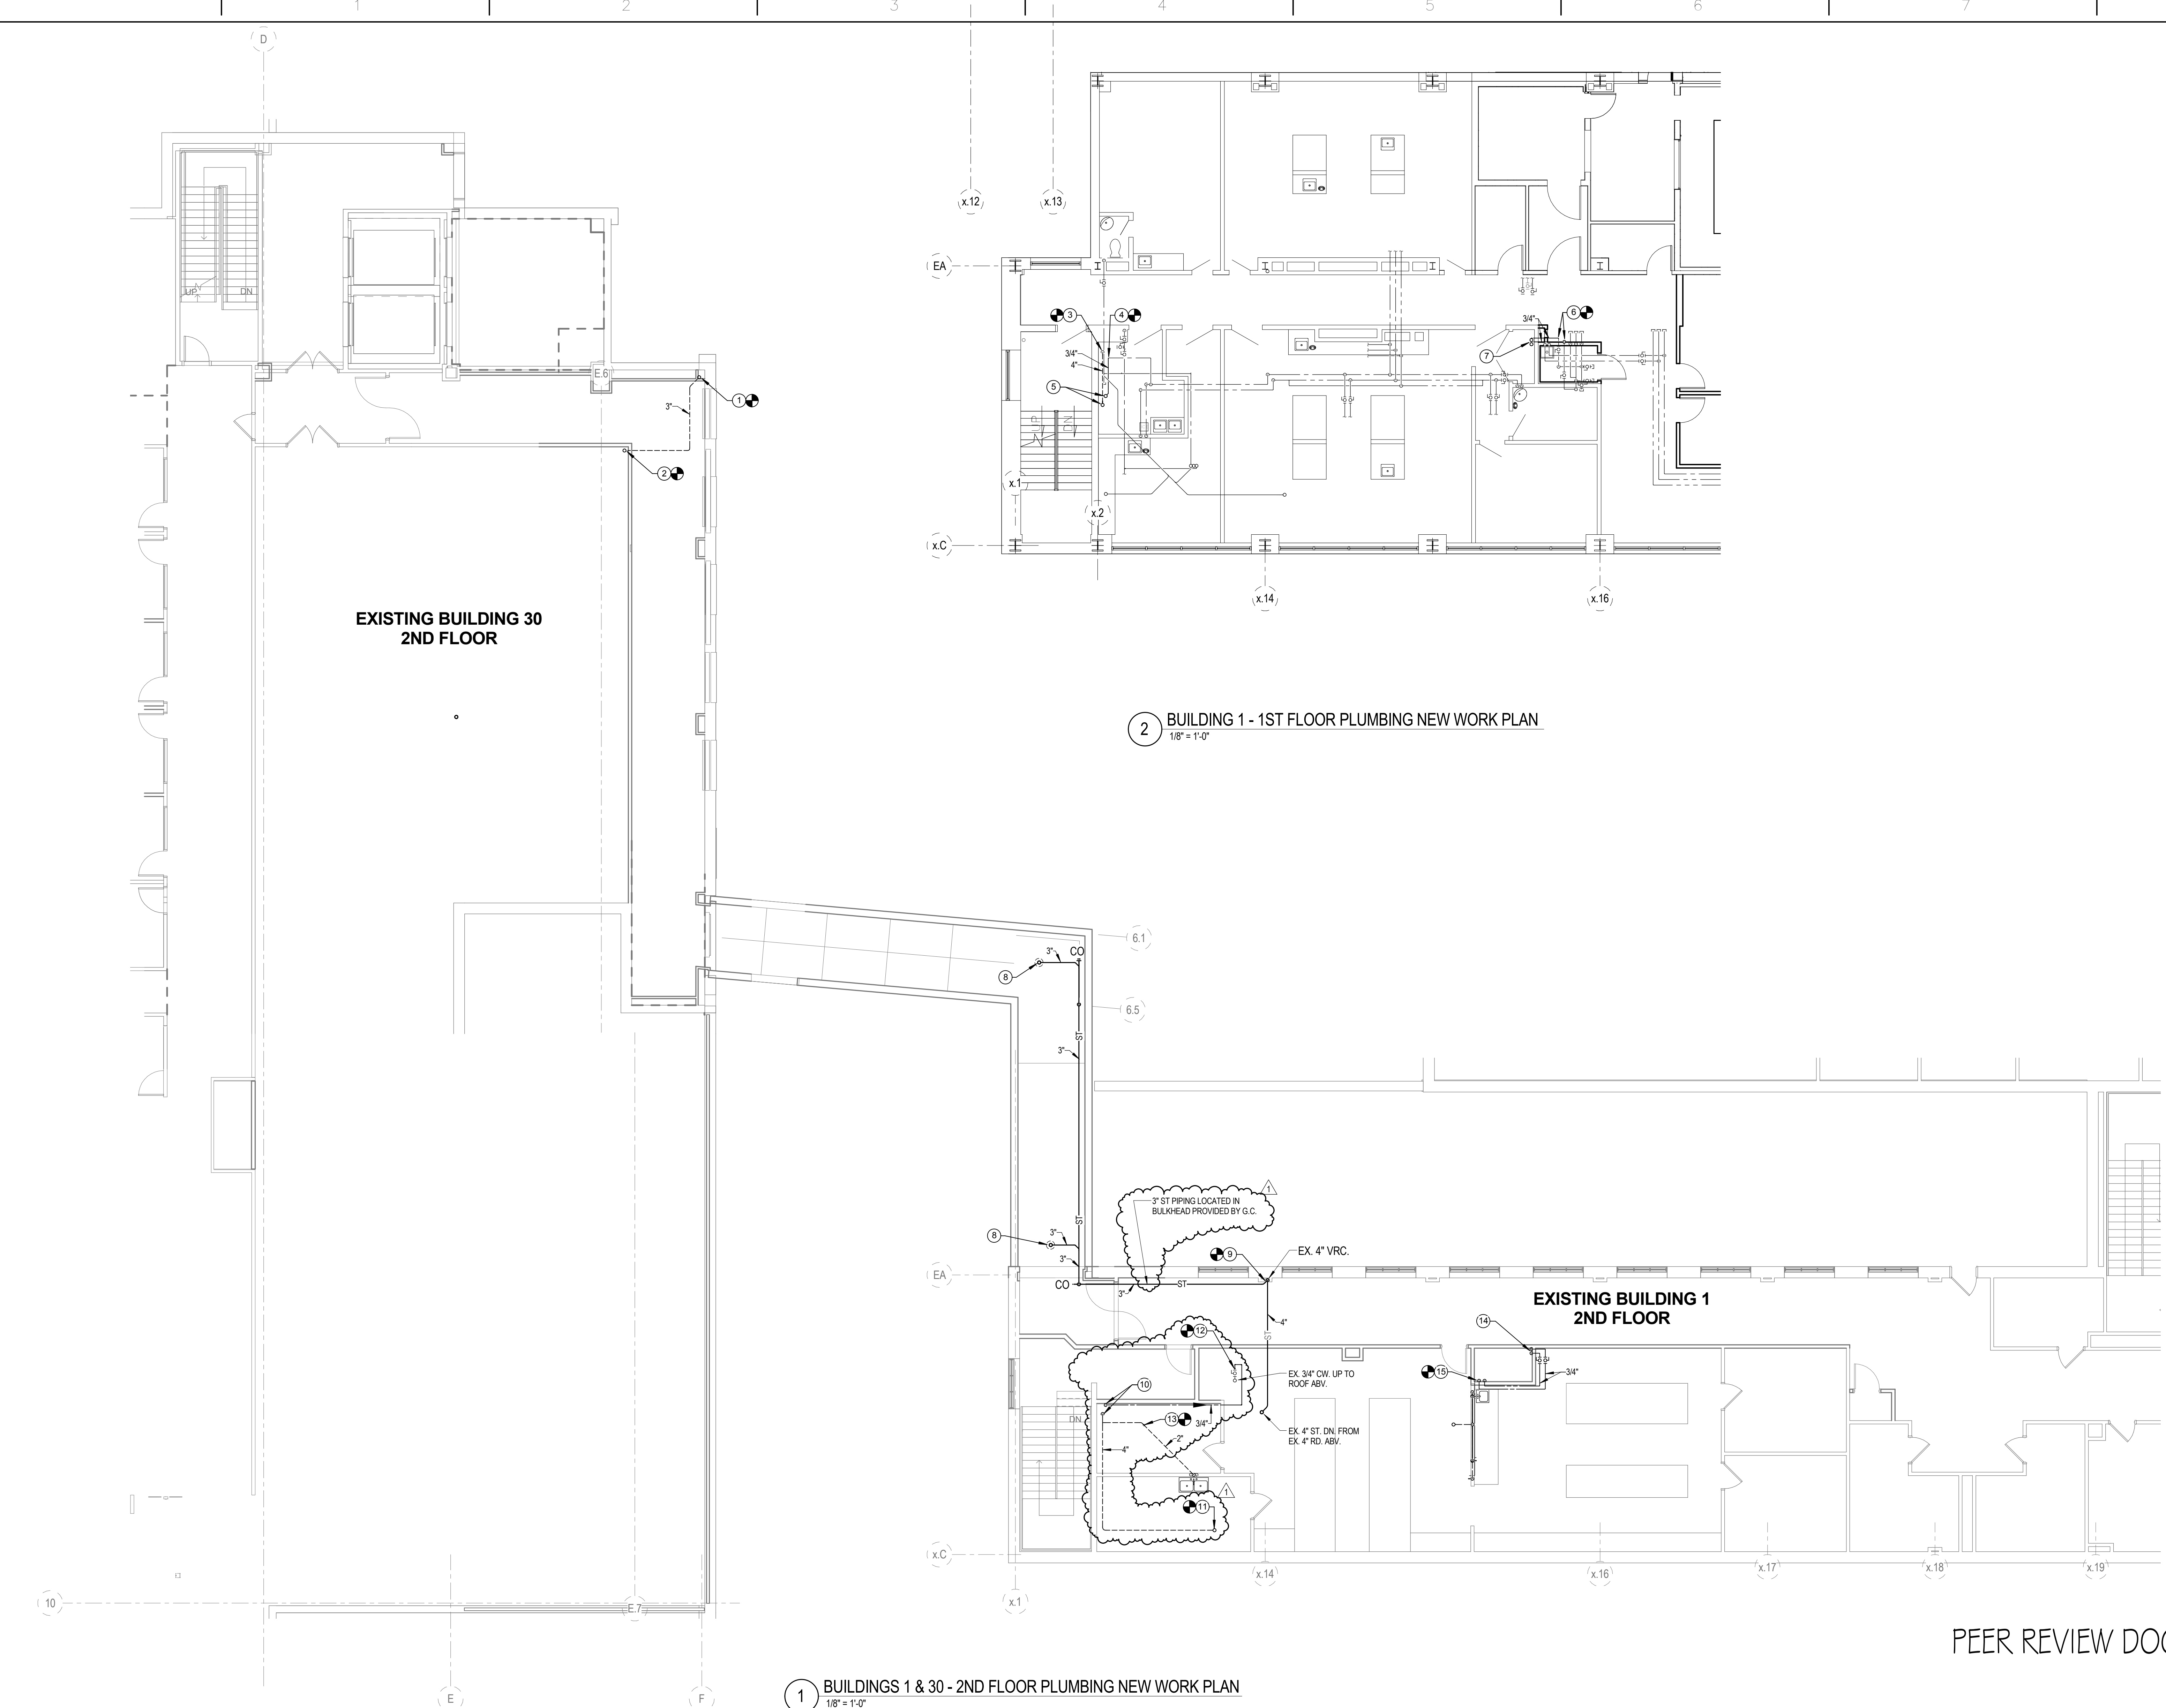

- PLUMBING KEYED NOTES**
 - CONNECT NEW 3" V. TO EX. 3" V. RISE UP & OFFSET ABOVE CEILING.
 - CONNECT NEW 3" V. TO EX. 3" V. RISE AT CEILING.
 - CONNECT NEW 4" V. TO EX. 4" SV. & OFFSET ABOVE CEILING.
 - CONNECT NEW 3/4" CW. TO EX. CW. ABOVE CEILING (FIELD VERIFY EXACT SIZE & LOCATION).
 - NEW 3/4" CW. & 4" V. ABOVE CEILING: RISE UP TO FLOOR ABOVE.
 - CONNECT NEW 3/4" CW. & 3/4" HW. TO EX. CW. & HW. ABOVE CEILING (FIELD VERIFY EXACT SIZE & LOCATION).
 - NEW 3/4" CW. & 3/4" HW. ABOVE CEILING: RISE UP TO FLOOR ABOVE.
 - NEW 3" ST. DN. FROM ROOF DRAIN (RD-1) ON ROOF ABOVE: OFFSET ABOVE CEILING.
 - CONNECT NEW 3" ST. TO EX. 4" VRC.
 - NEW 3/4" CW. & 4" V. UP FROM FLOOR BELOW: RISE ABOVE CEILING & OFFSET.
 - PROVIDE NEW 4" VENT THRU ROOF - MAINTAIN 25'-0" FROM ANY O.A. INTAKES.
 - CONNECT NEW 3/4" CW. TO EX. 3/4" CW. ABOVE CEILING (FIELD VERIFY EXACT SIZE & LOCATION).
 - CONNECT NEW 2" V. TO EX. 2" V. ABOVE CEILING: EXTEND AND CONNECT TO 4" VENT ABOVE CEILING. (FIELD VERIFY EXACT SIZE & LOCATION).
 - NEW 3/4" CW. & 3/4" HW. UP FROM FLOOR BELOW: RISE ABOVE CEILING & OFFSET.
 - NEW 3/4" CW. & 3/4" HW. ABOVE CEILING: DROP DN. IN CHASE & CONNECT TO EX. CW. & HW. (FIELD VERIFY EXACT SIZE & LOCATION).
- GENERAL PLUMBING NOTES:**
 - COORDINATE ALL NEW AND DEMOLITION WORK REQUIRED WITH EXISTING USERS TO KEEP AREAS OF WORK UP AND RUNNING IN CASE OF POSSIBLE SHUTDOWNS AND/OR DISRUPTIONS.

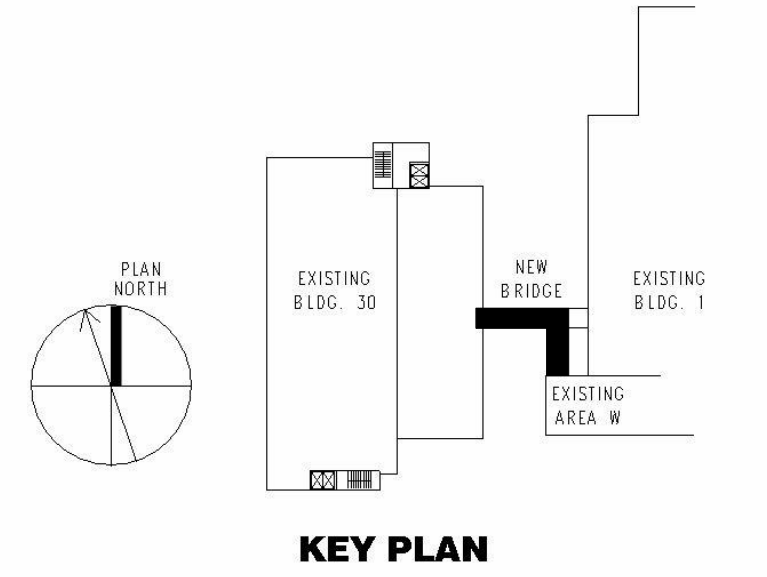

PEER REVIEW DOCUMENTS - DECEMBER 21st, 2016

FULLY SPRINKLERED

--	--	