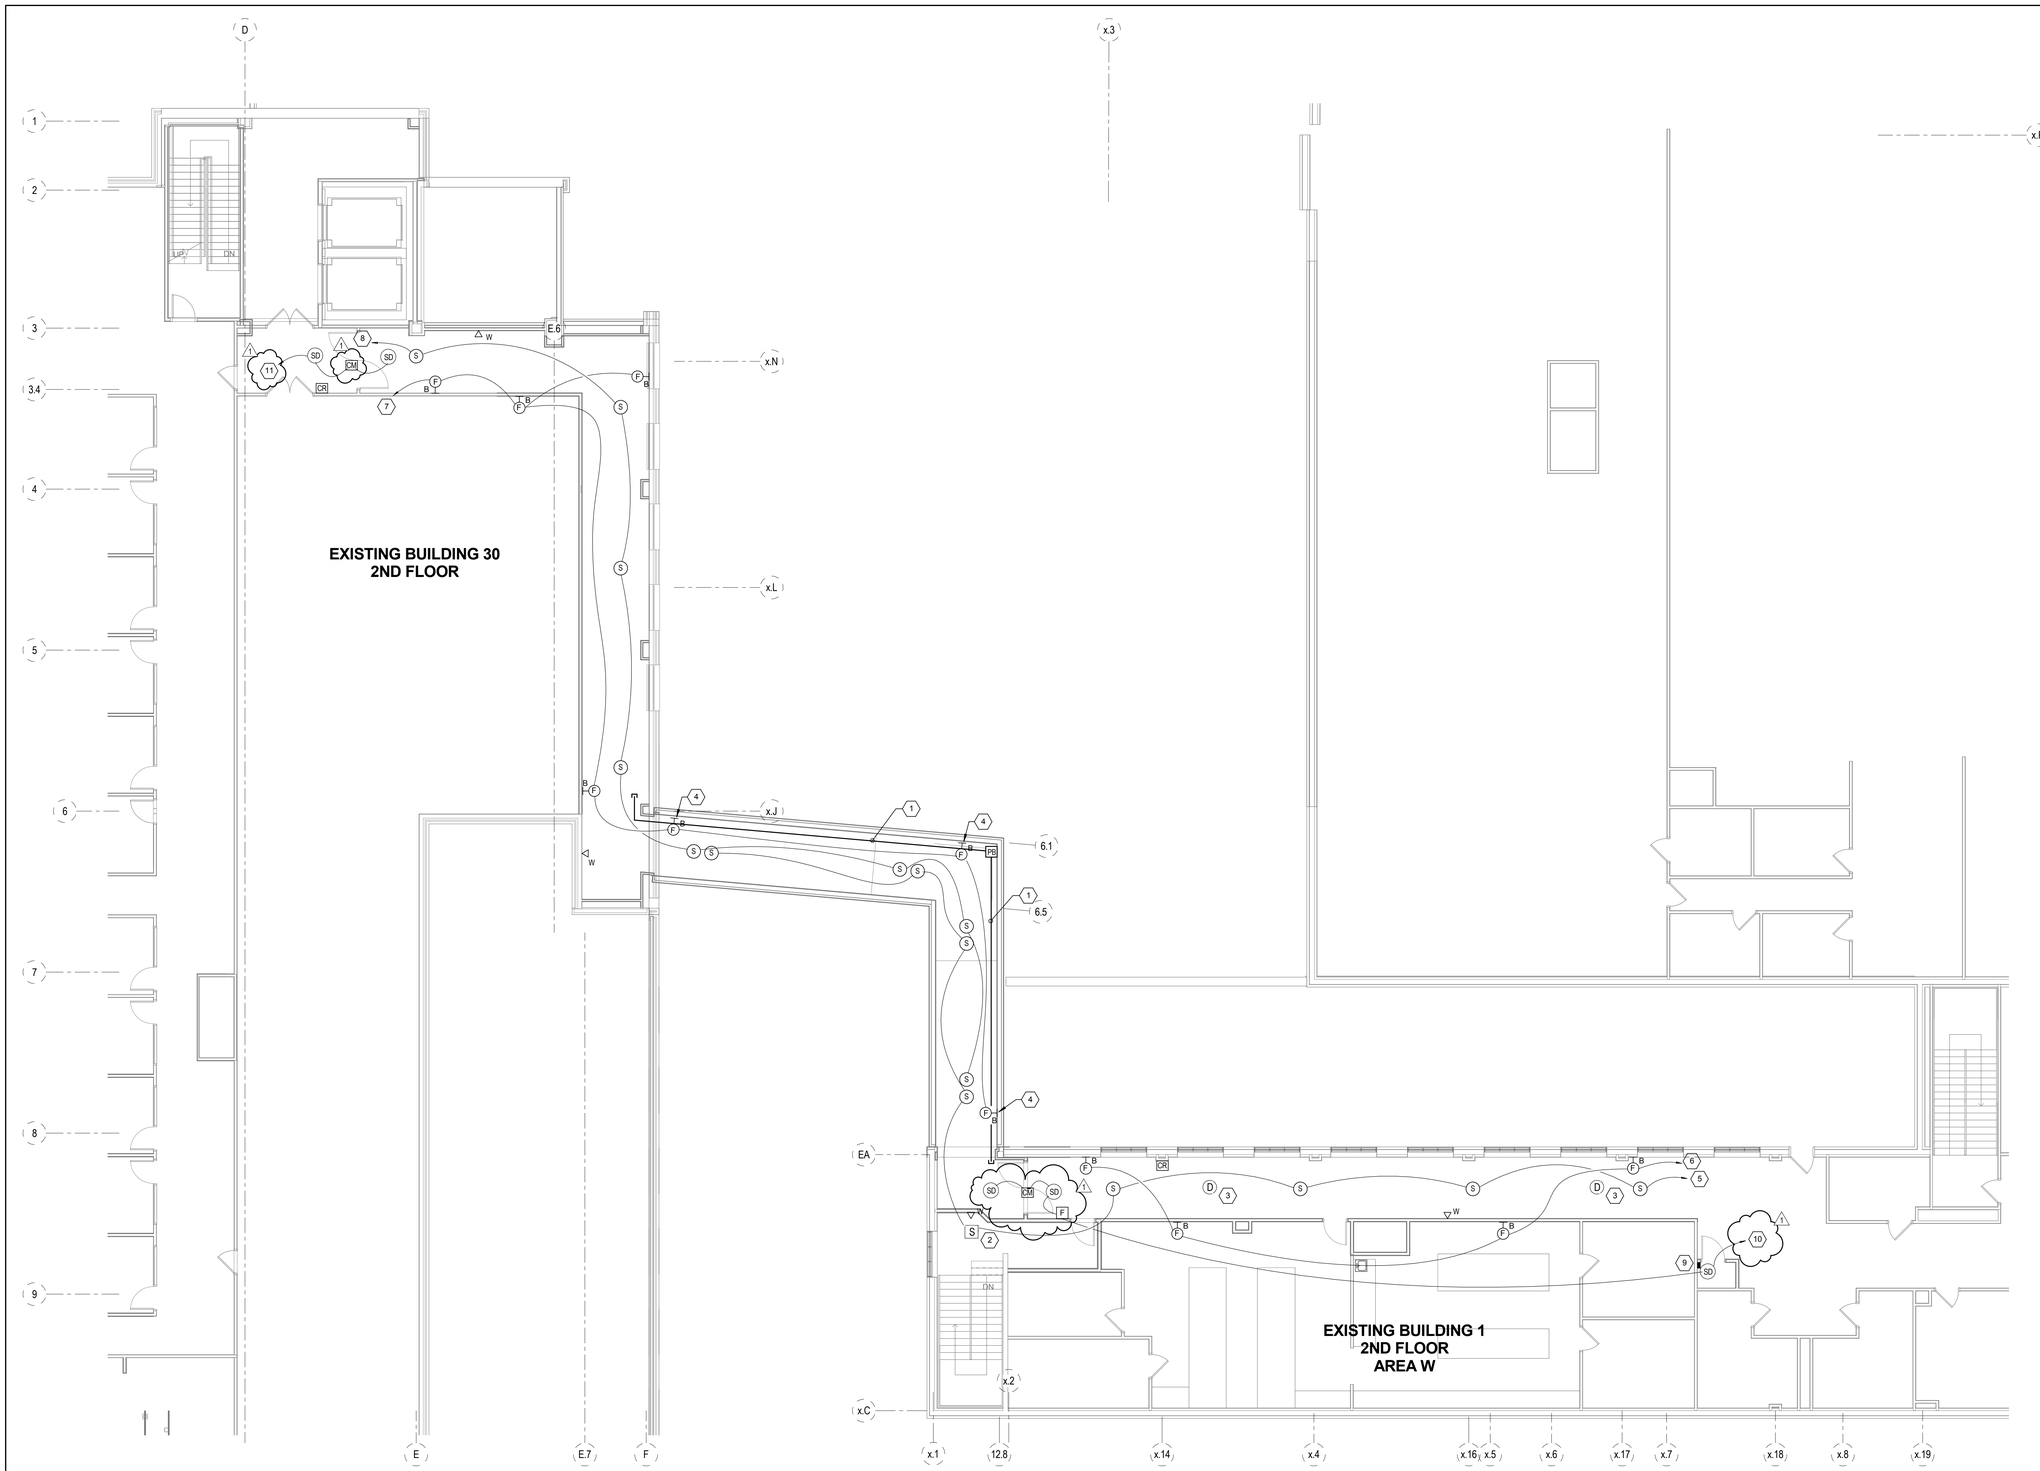

General Notes

1. NEW FIRE ALARM DEVICES TO BE SERVED FROM THE EXISTING SIMPLEX BUILDING #30 AND BUILDING #1 FIRE ALARM CONTROL PANELS. PROVIDE ALL NECESSARY SOFTWARE MODIFICATION REQUIRED.

Key Notes

1. 3 - 4" EMT CONDUITS WITH DRAGWIRE FOR FUTURE TELECOMMUNICATION CABLING.
2. RELOCATED SURFACE MOUNTED PAGING SPEAKER.
3. EXISTING SECURITY TRAC DURESS CEILING SENSOR TO BE REMOVED FROM CEILING AND SUPPORTED ABOVE CEILING FOR REINSTALLATION BY SECURITY VENDOR.
4. FIRE ALARM HORN STROBE LOCATED IN BRIDGE SHALL BE PROGRAMMED TO OPERATE FROM BOTH BUILDING #30 AND BUILDING #1 FIRE ALARM SYSTEMS.
5. TO NEW PA AMPLIFIER LOCATED IN ELECTRICAL ROOM.
6. TO NEAREST FIRE ALARM NOTIFICATION APPLIANCE PANEL LOCATED IN BUILDING #1. CONTRACTOR TO PROVIDE A NEW BOOSTER PANEL FOR APPLIANCE DEVICES IF REQUIRED.
7. TO NEAREST FIRE ALARM NOTIFICATION APPLIANCE PANEL LOCATED IN BUILDING #30. CONTRACTOR TO RPOVIDE A NEW BOOSTER PANEL FOR APPLIANCE DEVICES IF REQUIRED.
8. TO NEAREST PAGING SYSTEM AMP LOCATED IN BUILDING #30.
9. PA 100W AMPLIFIER/ CABINET
   120V 1 PHASE NE PWR.
   BOGEN #C100
   CONTACT: NICK WASKIEWICZ FROM DSX AT 412-848-8326
10. TO NEAREST EXISTING FIRE ALARM INITIATING DEVICE IN BUILDING #1.
11. TO NEAREST EXISTING FIRE ALARM INITIATING DEVICE IN BUILDING #30.

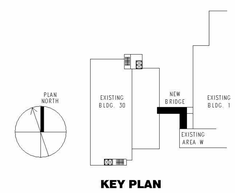

KEY PLAN

1 ET1-101_1_
1/8" = 1'-0"

PEER REVIEW DOCUMENTS - DECEMBER 21st, 2016

FULLY SPRINKLERED

Revisions:	Date
1 AMENDMENT 3	01-31-17

CONSULTANTS:

ARCHITECT/ENGINEERS:

ARCHITECTURE
ENGINEERING
INTERIOR DESIGN
DESIGN/BUILD
ASTORINO
227 Fort Pitt Boulevard Pittsburgh Pennsylvania 15222
TEL 412 765 1700 FAX 412 765 1711 www.astorino.com

Drawing Title: **BRIDGE SYSTEMS PLAN**

Approved: Project Director

Project Title: **VA CARES CONSOLIDATION VAMC, PITTSBURGH, PA CONNECTING BRIDGE**

Location: **VAPHS UNIVERSITY DRIVE**

Date | Checked: **Checker** | Drawn: **Author**

Project Number: **646CA2500B**

Building Number: **1 & 30**

Drawing Number: **ET1-101**

Dwg. of

Office of Facilities Management

Department of Veterans Affairs

VA FORM 08-6231, OCT 1978