


three inches = one foot
one and one half inches = one foot
one inch = one foot
three quarters inch = one foot
one half inch = one foot
three eighths inch = one foot
one quarter inch = one foot
one eighth inch = one foot

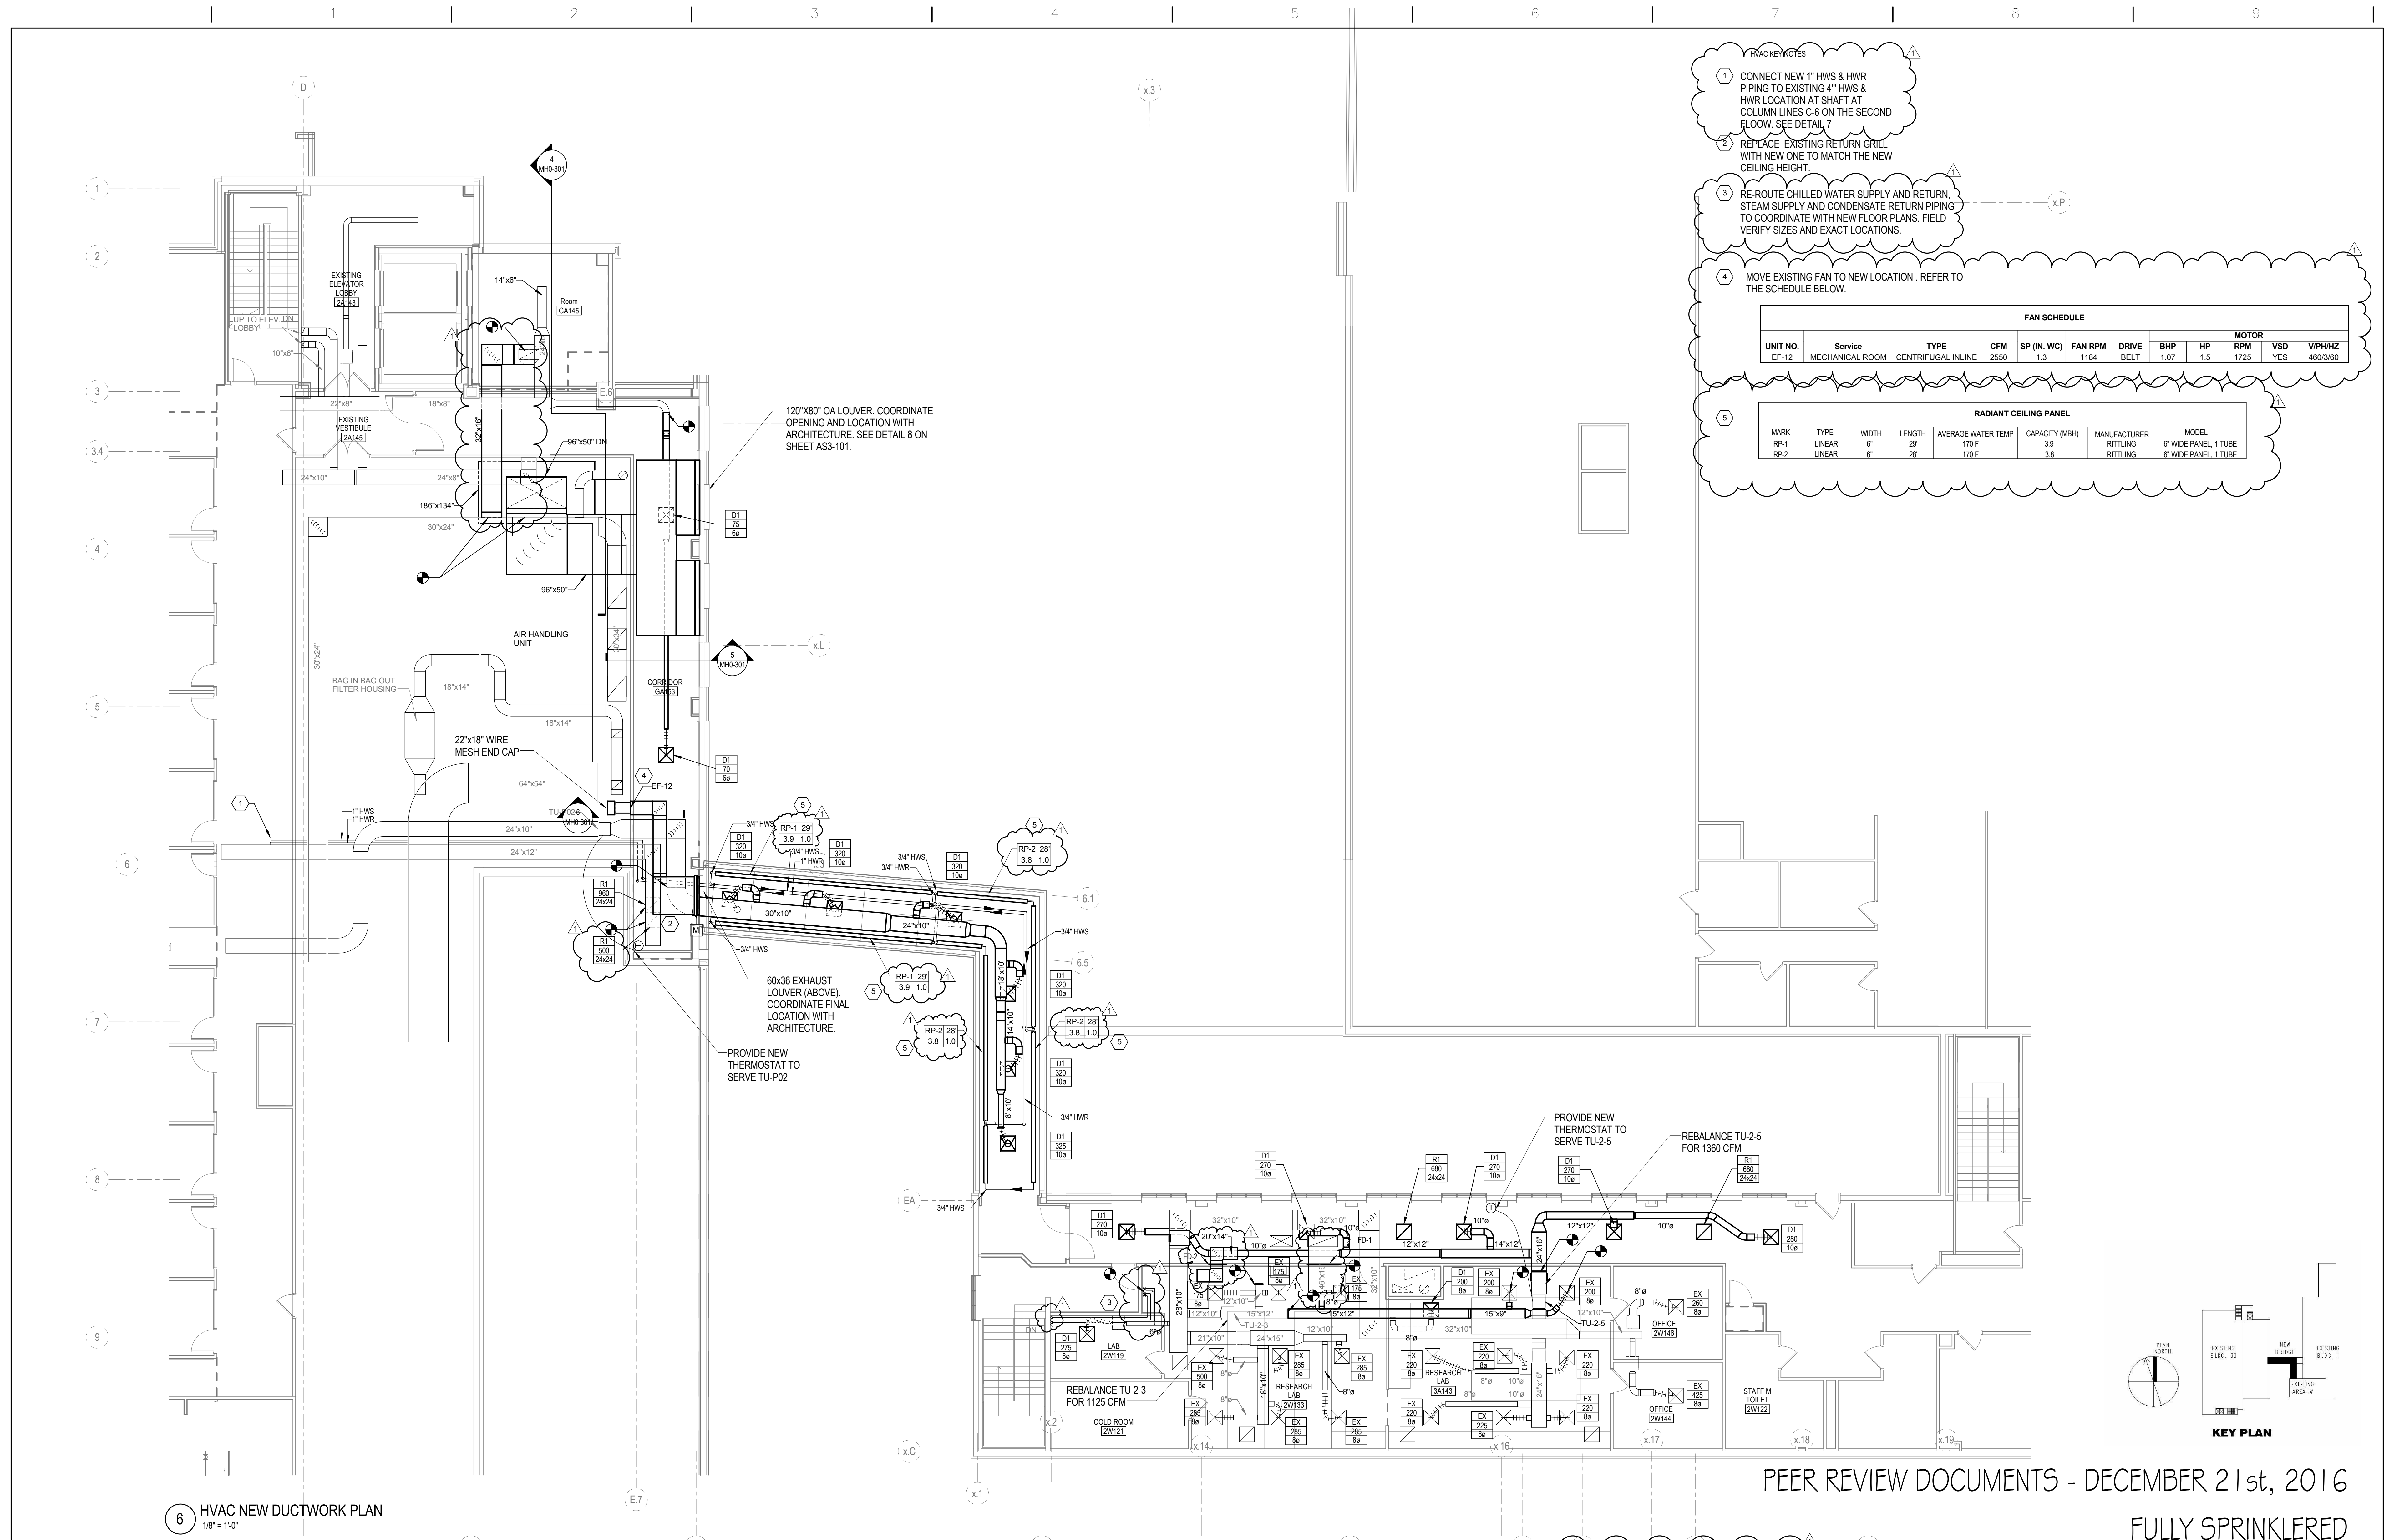

- CONNECT NEW 1" HWS & HWR PIPING TO EXISTING 4" HWS & HWR LOCATION AT SHAFT AT COLUMN LINES C-6 ON THE SECOND FLOOR. SEE DETAIL 7.
 - REPLACE EXISTING RETURN GRILL WITH NEW ONE TO MATCH THE NEW CEILING HEIGHT.
 - RE-ROUTE CHILLED WATER SUPPLY AND RETURN, STEAM SUPPLY AND CONDENSATE RETURN PIPING TO COORDINATE WITH NEW FLOOR PLANS. FIELD VERIFY SIZES AND EXACT LOCATIONS.
 - MOVE EXISTING FAN TO NEW LOCATION. REFER TO THE SCHEDULE BELOW.

FAN SCHEDULE										
UNIT NO.	Service	TYPE	CFM	SP (IN. WC)	FAN RPM	DRIVE	BHP	HP	RPM	VSD
EF-12	MECHANICAL ROOM	CENTRIFUGAL INLINE	2550	1.3	1184	BELT	1.07	1.5	1725	YES

RADIANT CEILING PANEL							
MARK	TYPE	WIDTH	LENGTH	AVERAGE WATER TEMP	CAPACITY (MBH)	MANUFACTURER	MODEL
RP-1	LINEAR	6"	29'	170 F	3.9	RITTLING	6" WIDE PANEL, 1 TUBE
RP-2	LINEAR	6"	28'	170 F	3.8	RITTLING	6" WIDE PANEL, 1 TUBE

CONSULTANTS:		ARCHITECT/ENGINEERS:		SECOND FLOOR NEW DUCTWORK PLAN		VA CARES CONSOLIDATION VAMC, PITTSBURGH, PA CONNECTING BRIDGE		Office of Facilities Management	
227 Fort Pitt Boulevard Pittsburgh, Pennsylvania 15222 TEL 412 765 1700 FAX 412 765 1711 www.astorino.com		ASTORINO		Approved: Project Director		Project Title		Project Number	
1 AMENDMENT 3 01-31-17						Building Number		646CA2500B	
Revisions:						Location		1 & 30	
VA FORM 08-6231, OCT 1978						VAPHS UNIVERSITY DRIVE		MHO-100	
						Date		Dwg. of	
						Checked			
						Drawn			
						Checker		Author	