FIRE PROTECTION KEYED NOTES

1. EXTENT OF NEW SPRINKLER WORK CONNECTING TO EXISTING BRIDGE ZONE CONTROL VALVE ASSEMBLY.
2. EXTENT OF NEW SPRINKLER WORK CONNECTING TO EXISTING BUILDING 1 - 2ND FLOOR ZONE CONTROL VALVE ASSEMBLY.
3. CONNECT NEW SPRINKLER FEED MAIN TO EXISTING SPRINKLER FEED MAIN CAPPED CONNECTION (FIELD VERIFY EXACT SIZE, LOCATION & ELEVATION).
4. NEW SPRINKLER: PROVIDE NEW BRANCH PIPE AND CONNECT TO EXISTING SPRINKLER FEED MAIN PIPING.
5. NEW SPRINKLER: CONNECT TO NEW SPRINKLER FEED MAIN PIPING.
6. EXISTING SPRINKLER (TYP.)
7. EXISTING SPRINKLER RISER
8. EXISTING BUILDING #30 - 2ND FLOOR ZONE CONTROL VALVE ASSEMBLY.
9. EXISTING BRIDGE ZONE CONTROL VALVE ASSEMBLY.
10. EXISTING SPRINKLER FEED MAIN TO 2ND FLOOR SPRINKLER SYSTEM.
11. EXISTING STANDPIPE. RAISE WITH 2-1/2" FIRE HOSE VALVE TO NOT LESS THAN 3'-0" OR MORE THAN 5'-0" ABOVE NEW FLOOR LINE.
12. RELOCATED BUILDING #1 - 2ND FLOOR ZONE CONTROL VALVE ASSEMBLY.

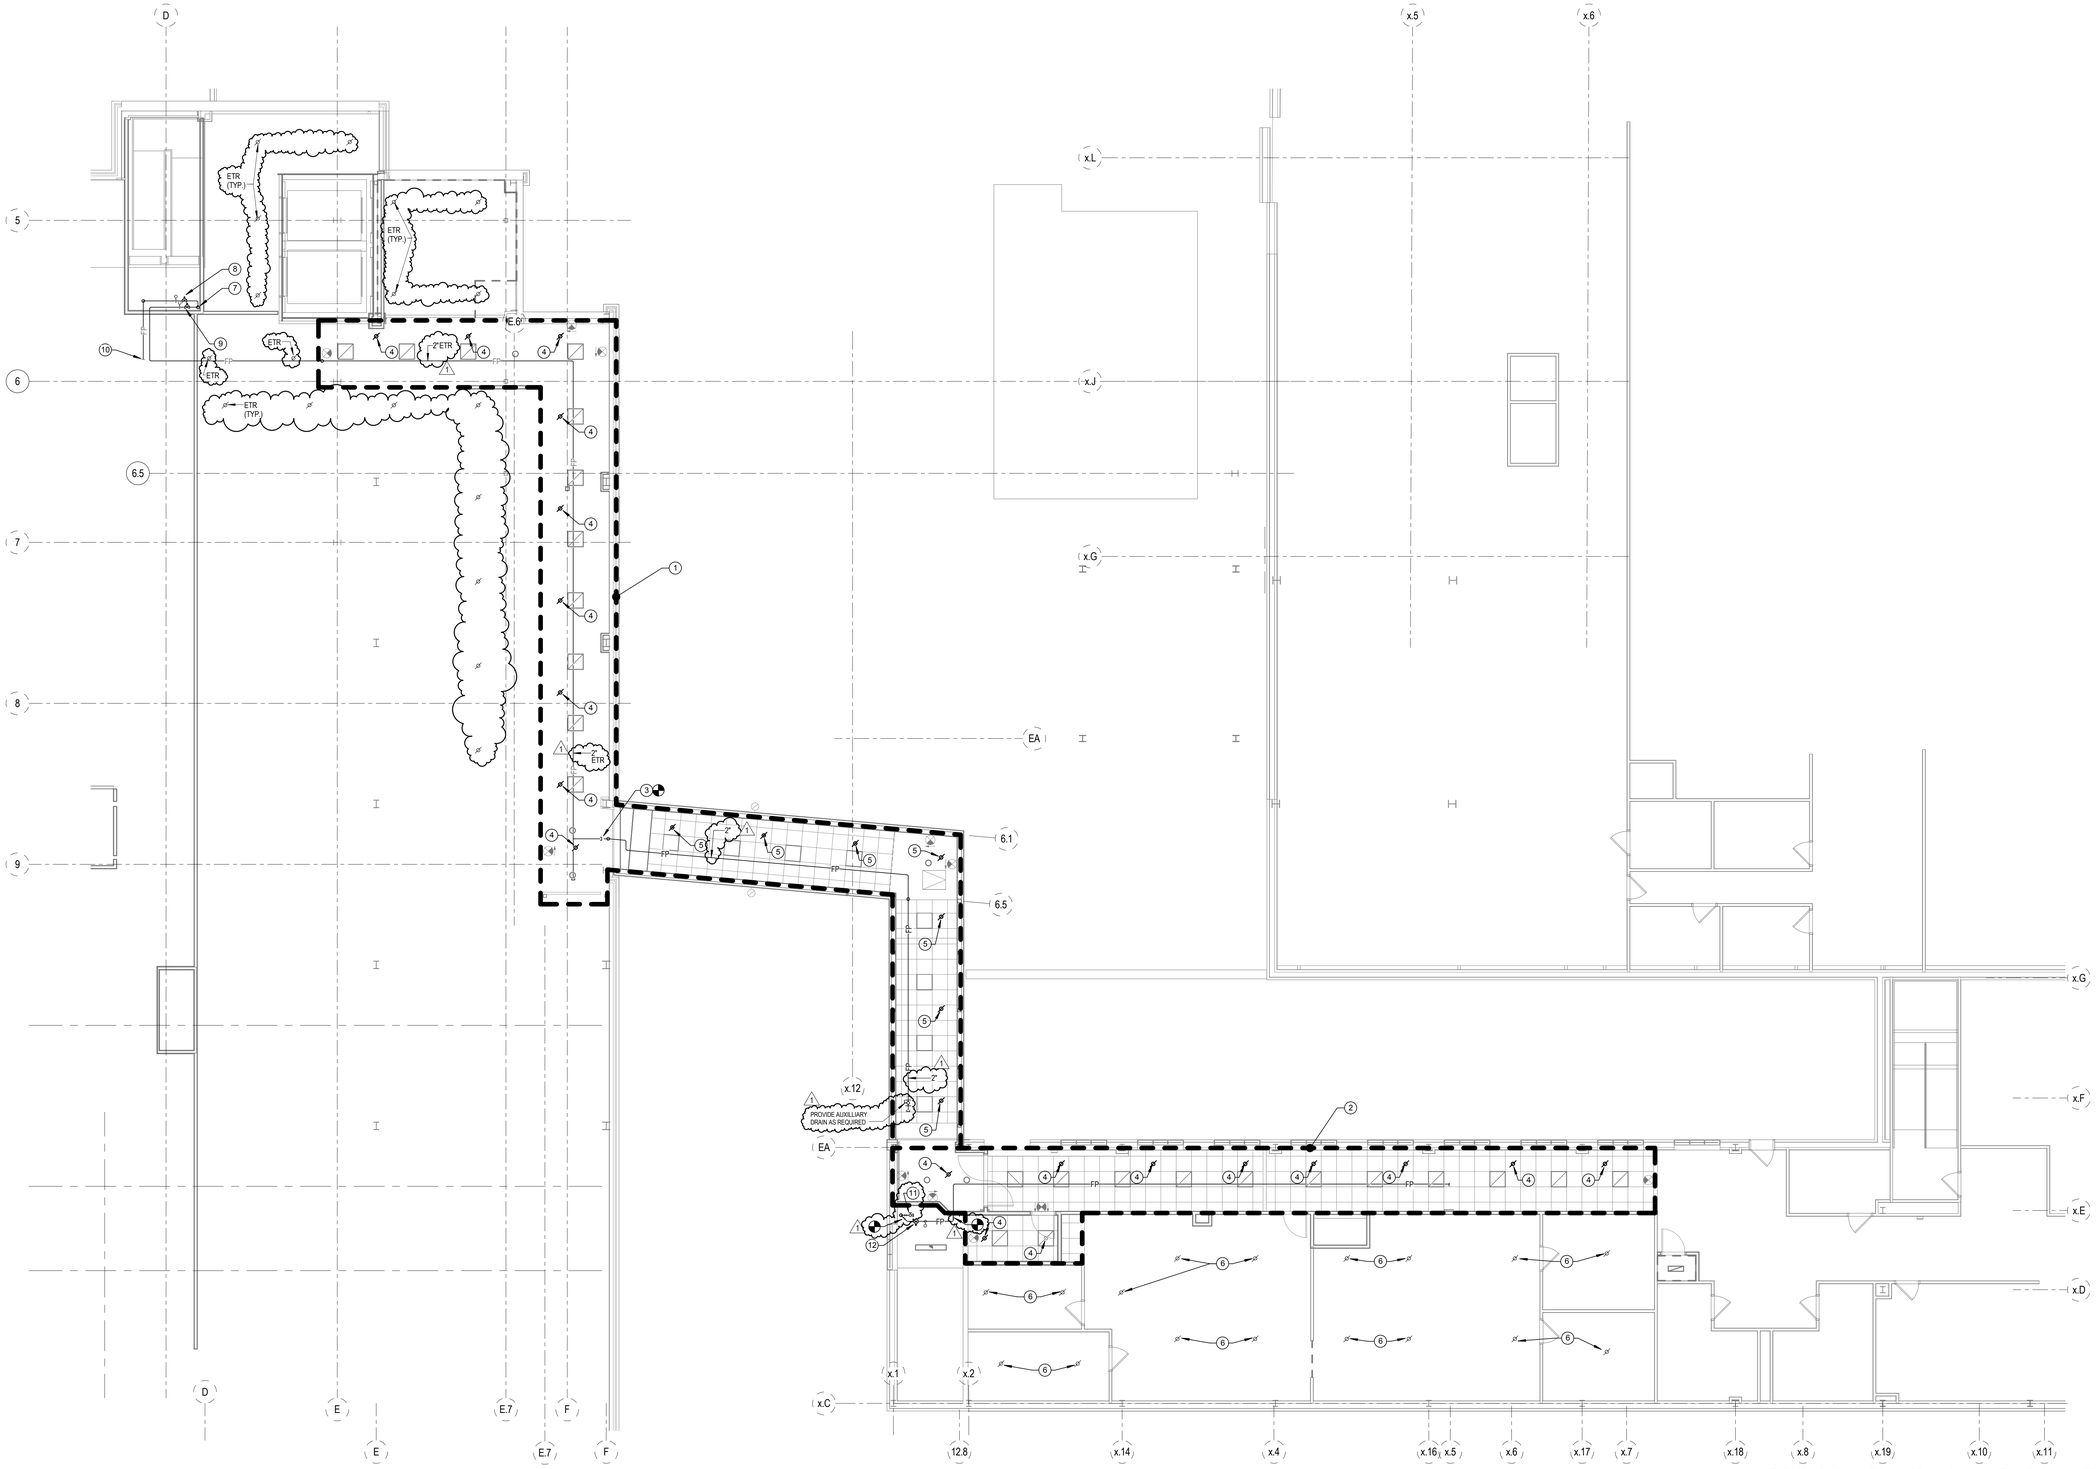

1 FIRE PROTECTION FLOOR PLAN
1/8" = 1'-0"

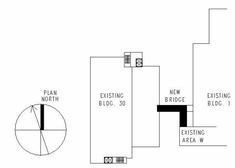

KEY PLAN

PEER REVIEW DOCUMENTS - DECEMBER 21st, 2016

FULLY SPRINKLERED

Revisions:	Date
1 AMENDMENT 3	01-31-17

CONSULTANTS:

ARCHITECT/ENGINEERS:

ARCHITECTURE ENGINEERING INTERIOR DESIGN DESIGN/BUILD
ASTORINO
227 Fort Pitt Boulevard Pittsburgh Pennsylvania 15222
TEL 412 765 1700 FAX 412 765 1711 www.astorino.com

Drawing Title: **FIRE PROTECTION FLOOR PLAN**

Approved: Project Director

Project Title: **VA CARES CONSOLIDATION VAMC, PITTSBURGH, PA CONNECTING BRIDGE**

Location: **VAPHS UNIVERSITY DRIVE**

Date | Checked: **ER** | Drawn: **MPB**

Project Number: **646CA2500B**

Building Number: **1 & 30**

Drawing Number: **FA-101**

Dwg. of

Office of Facilities Management

Department of Veterans Affairs

VA FORM 08-6231, OCT 1978