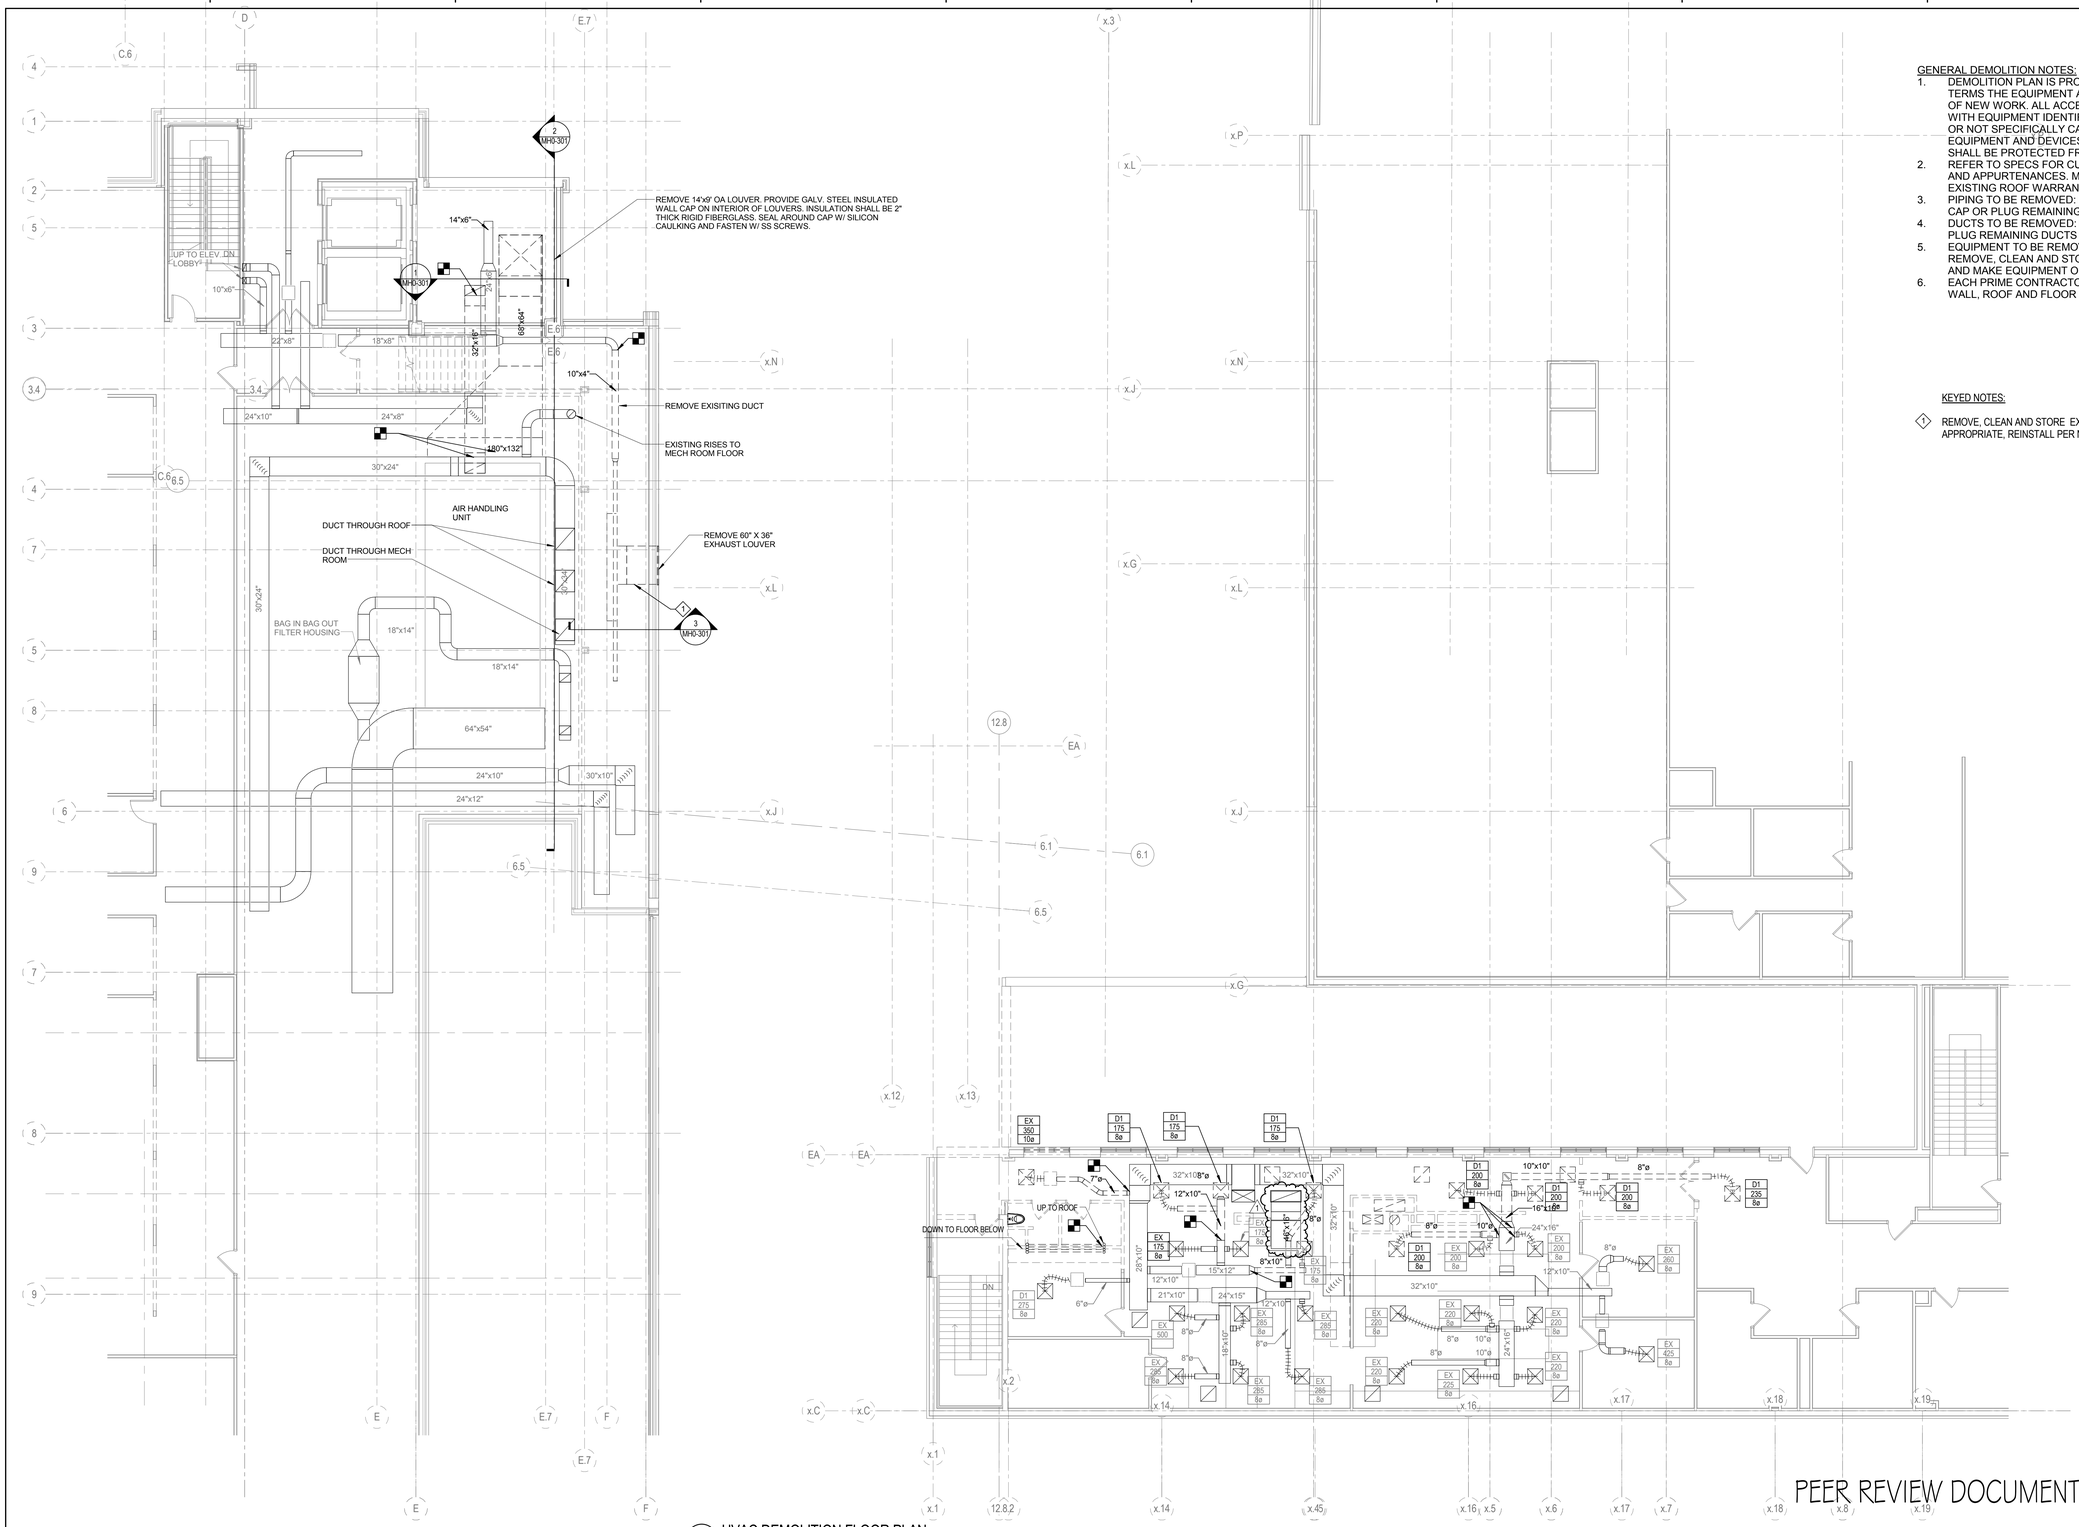

1 HVAC DEMOLITION FLOOR PLAN
1/8" = 1'-0"

KEY PLAN

GENERAL DEMOLITION NOTES:

1. DEMOLITION PLAN IS PROVIDED WITH THE EXPLICIT INTENT OF DESCRIBING IN GENERAL TERMS THE EQUIPMENT AND DEVICES TO BE REMOVED TO FACILITATE THE INSTALLATION OF NEW WORK. ALL ACCESSORIES , RELATED DEVICES, SUPPORTS, ETC. ASSOCIATED WITH EQUIPMENT IDENTIFIED TO BE REMOVED SHALL BE REMOVED AS WELL WHETHER OR NOT SPECIFICALLY CALLED OUT, UNLESS NOTED OTHERWISE TO REMAIN, ALL EQUIPMENT AND DEVICES INTENDED TO REMAIN FOR INTEGRATION IN THE NEW WORK SHALL BE PROTECTED FROM DAMAGE.
2. REFER TO SPECS FOR CUTTING AND PATCHING OF EXISTING ROOF, ROOF PRODUCTS AND APPURTENANCES. MATCH EXISTING ADJACENT MATERIALS, AND CONDITIONS OF EXISTING ROOF WARRANTY.
3. PIPING TO BE REMOVED: REMOVE PORTION OF PIPING INDICATED TO BE REMOVED AND CAP OR PLUG REMAINING PIPING WITH SAME OR COMPATIBLE PIPING MATERIAL.
4. DUCTS TO BE REMOVED: REMOVE PORTION OF DUCTS INDICATED TO BE REMOVED AND PLUG REMAINING DUCTS WITH SAME OR COMPATIBLE DUCTWORK MATERIAL
5. EQUIPMENT TO BE REMOVED AND REINSTALLED: DISCONNECT AND CAP SERVICES AND REMOVE, CLEAN AND STORE EQUIPMENT; WHEN APPROPRIATE, REINSTALL, RECONNECT AND MAKE EQUIPMENT OPERATIONAL.
6. EACH PRIME CONTRACTOR SHALL BE RESPONSIBLE FOR CUTTING AND PATCHING ALL WALL, ROOF AND FLOOR CUTTING AND PATCHING RELATED TO THEIR CONTRACTS.

KEYED NOTES:

1 REMOVE, CLEAN AND STORE EXISTING FAN. WHEN APPROPRIATE, REINSTALL PER NEW WORK PLAN MH0-100.

PEER REVIEW DOCUMENTS - DECEMBER 21st, 2016

FULLY SPRINKLERED

Revisions:	Date
1 AMENDMENT 3	01-31-17

CONSULTANTS:

ARCHITECT/ENGINEERS:

ARCHITECTURE ENGINEERING INTERIOR DESIGN DESIGN/BUILD ASTORINO

227 Fort Pitt Boulevard Pittsburgh Pennsylvania 15222
TEL 412 765 1700 FAX 412 765 1711 www.astorino.com

Drawing Title: **SECOND FLOOR DEMO DUCTWORK PLAN**

Approved Project Director

Project Title: **VA CARES CONSOLIDATION VAMC, PITTSBURGH, PA CONNECTING BRIDGE**

Location: **VAPHS UNIVERSITY DRIVE**

Date | Checked: **Checker** | Drawn: **Author**

Project Number: **646CA2500B**

Building Number: **1 & 30**

Drawing Number: **MD0-100**

Dwg. of

Office of Facilities Management

Department of Veterans Affairs

VA FORM 08-6231, OCT 1978