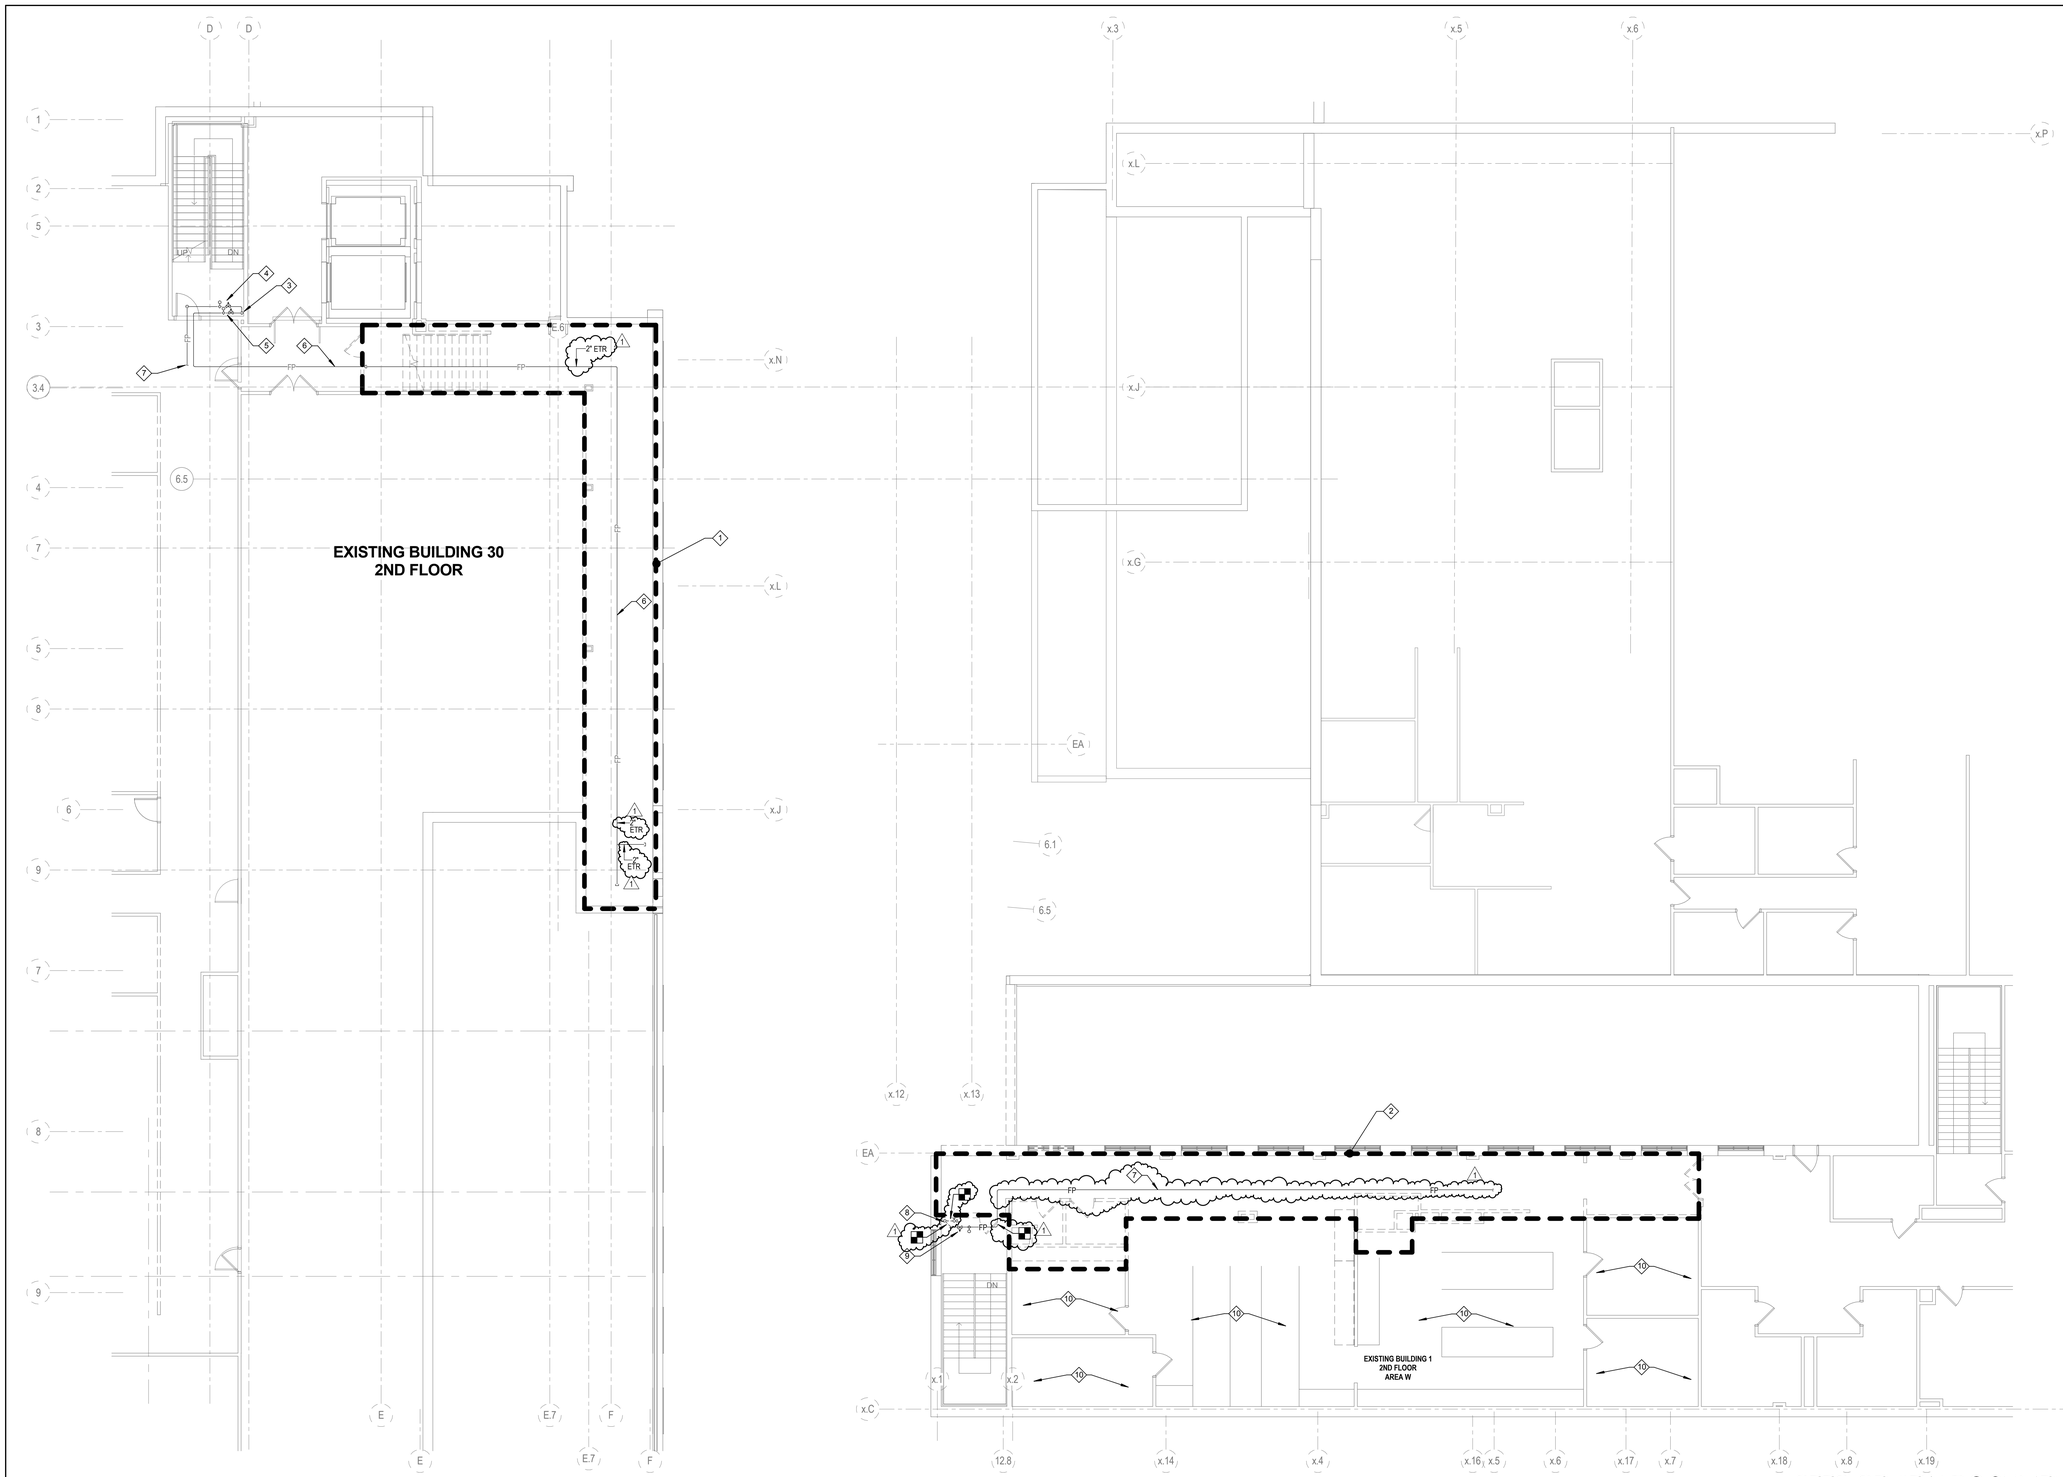

FIRE PROTECTION KEYED NOTES

1. DISCONNECT AND REMOVE EXISTING SPRINKLERS AND ASSOCIATED BRANCH PIPING ABOVE AND BELOW DEMOLISHED RAISED WALKWAY IN THIS AREA.
2. DISCONNECT AND REMOVE EXISTING SPRINKLERS AND ASSOCIATED BRANCH PIPING THIS AREA.
3. EXISTING SPRINKLER RISER
4. EXISTING BUILDING #30 - 2ND FLOOR ZONE CONTROL VALVE ASSEMBLY.
5. EXISTING BRIDGE ZONE CONTROL VALVE ASSEMBLY.
6. EXISTING SPRINKLER FEED MAIN.
7. EXISTING SPRINKLER FEED MAIN TO 2ND FLOOR SPRINKLER SYSTEM.
8. EXISTING STANDPIPE WITH 2-1/2" FIRE HOSE VALVE. RAISE EXISTING 2-1/2" FIRE HOSE VALVE AS REQUIRED. (1)
9. EXISTING BUILDING #1 - 2ND FLOOR ZONE CONTROL VALVE ASSEMBLY: DISCONNECT, RELOCATE & RECONNECT AS REQUIRED TO ACCOMMODATE NEW CORRIDOR WALL.
10. EXISTING SPRINKLER SYSTEM TO REMAIN THIS AREA.

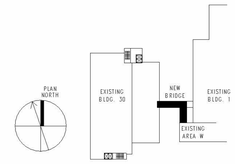

KEY PLAN

1 PLUMBING / FIRE PROTECTION DEMOLITION FLOOR PLAN
1/8" = 1'-0"

PEER REVIEW DOCUMENTS - DECEMBER 21st, 2016

FULLY SPRINKLERED

Revisions:	Date
1 AMENDMENT 3	01-31-17

CONSULTANTS:

ARCHITECT/ENGINEERS:

ARCHITECTURE ENGINEERING INTERIOR DESIGN DESIGN/BUILD
ASTORINO
227 Fort Pitt Boulevard Pittsburgh Pennsylvania 15222
TEL 412 765 1700 FAX 412 765 1711 www.astorino.com

Drawing Title: **FIRE PROTECTION DEMOLITION FLOOR PLAN**

Approved: Project Director

Project Title: **VA CARES CONSOLIDATION VAMC, PITTSBURGH, PA CONNECTING BRIDGE**

Location: **VAPHS UNIVERSITY DRIVE**

Date | Checked: **ER** | Drawn: **MPB**

Project Number: **646CA2500B**

Building Number: **1 & 30**

Drawing Number: **FAD-101**

Dwg. of

Office of Facilities Management

Department of Veterans Affairs

VA FORM 08-6231, OCT 1978