




1 DUCTWORK DEMOLITION UNDER PLATFORM SECTION  
1/8" = 1'-0"

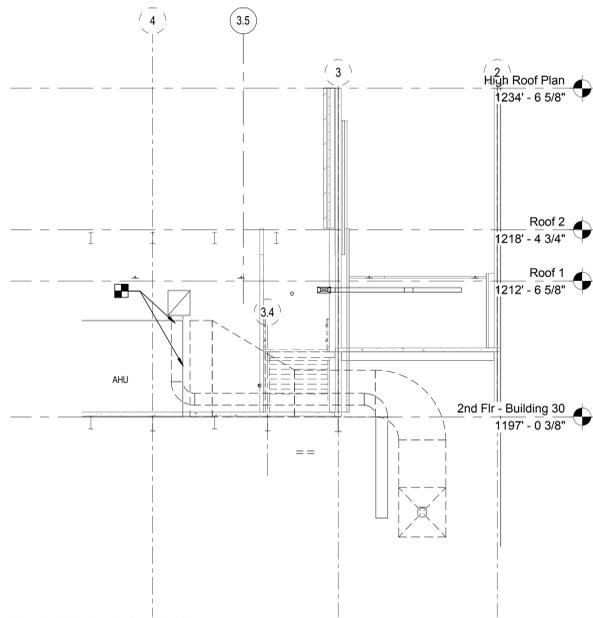


2 OA INTAKE DEMOLITION SECTION  
1/8" = 1'-0"

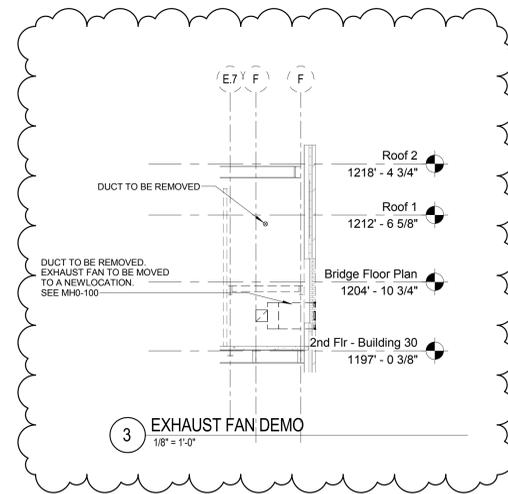


3 EXHAUST FAN DEMO  
1/8" = 1'-0"

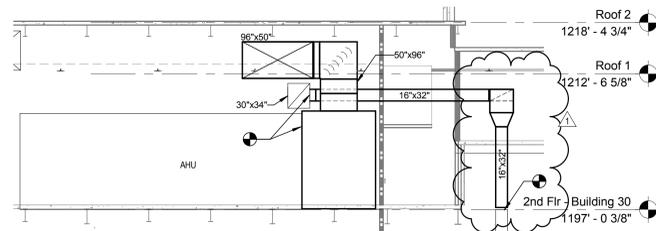


4 NEW AHU DUCTWORK SECTION  
1/8" = 1'-0"

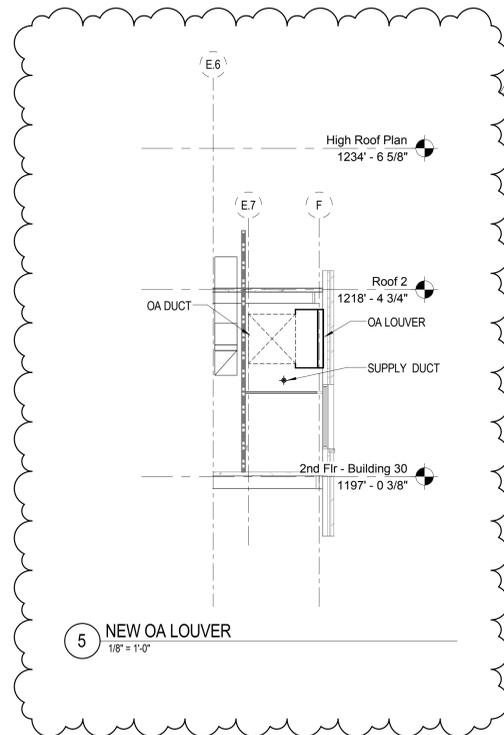

5 NEW OA LOUVER  
1/8" = 1'-0"

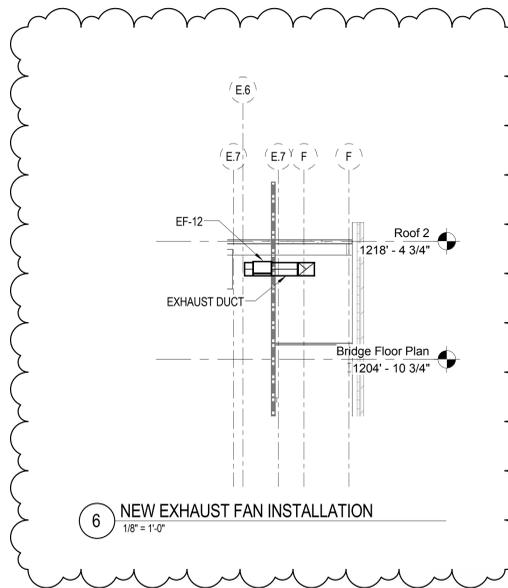

6 NEW EXHAUST FAN INSTALLATION  
1/8" = 1'-0"

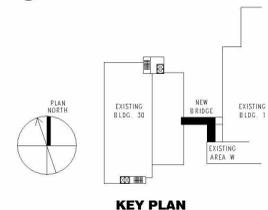

KEY PLAN

PEER REVIEW DOCUMENTS - DECEMBER 21st, 2016

FULLY SPRINKLERED

<b>CONSULTANTS:</b> 		<b>ARCHITECT/ENGINEERS:</b> ARCHITECTURE ENGINEERING INTERIOR DESIGN DESIGN/BUILD <b>ASTORINO</b> <small>227 Fort Pitt Boulevard Pittsburgh, Pennsylvania 15222          TEL 412 765 1700 FAX 412 765 1711 www.astorino.com</small>		Drawing Title <b>ENLARGED SECTIONS</b>		Project Title <b>VA CARES CONSOLIDATION          VAMC, PITTSBURGH, PA          CONNECTING BRIDGE</b>		Project Number <b>646CA2500B</b>		Office of <b>Facilities          Management</b>	
Revisions: 1 AMENDMENT 3 01-31-17 Date				Approved: Project Director		Location <b>VAPHS UNIVERSITY DRIVE</b>		Building Number <b>1 &amp; 30</b>		Drawing Number <b>MHO-301</b>	
VA FORM 08-6231, OCT 1978						Date Checked Drawn		Dwg. of		Department of <b>Veterans Affairs</b>	

three inches = one foot  
 one and one half inches = one foot  
 one inch = one foot  
 three quarters inch = one foot  
 one half inch = one foot  
 three eighths inch = one foot  
 one quarter inch = one foot  
 one eighth inch = one foot

A  
 B  
 C  
 D  
 E  
 F