


- Unknown Util (GPR)
- Radio Signal (Telcom?)
- Electric
- Water

Area (according to Joyce)

Note:
Signal was under
construction debris
So location is
questionable

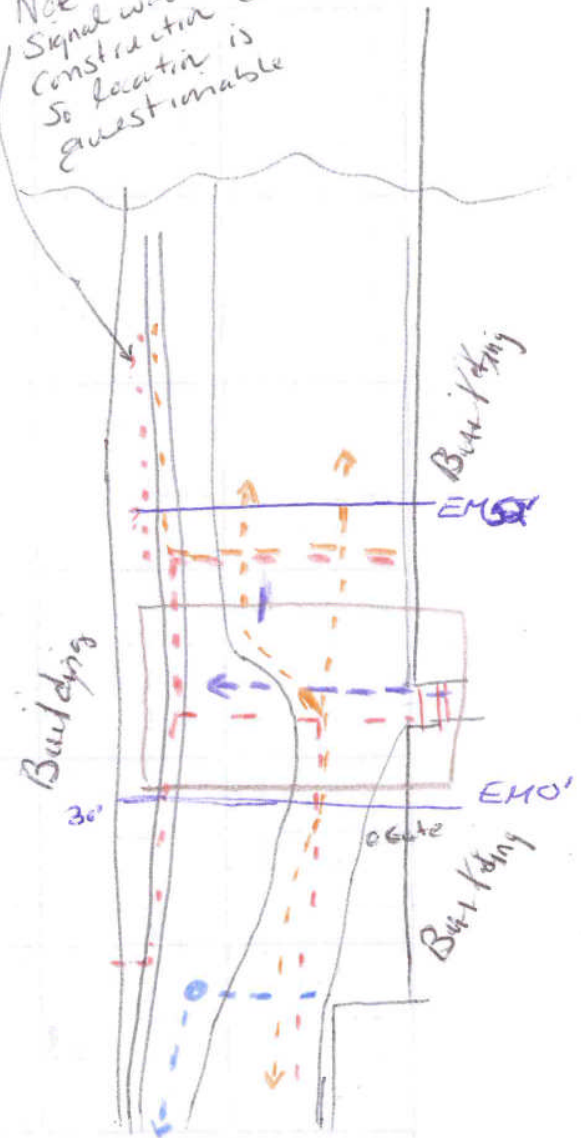

Ground Penetrating Radar Sketch
THG Geophysics

(sketch made around) February 26, 2014