

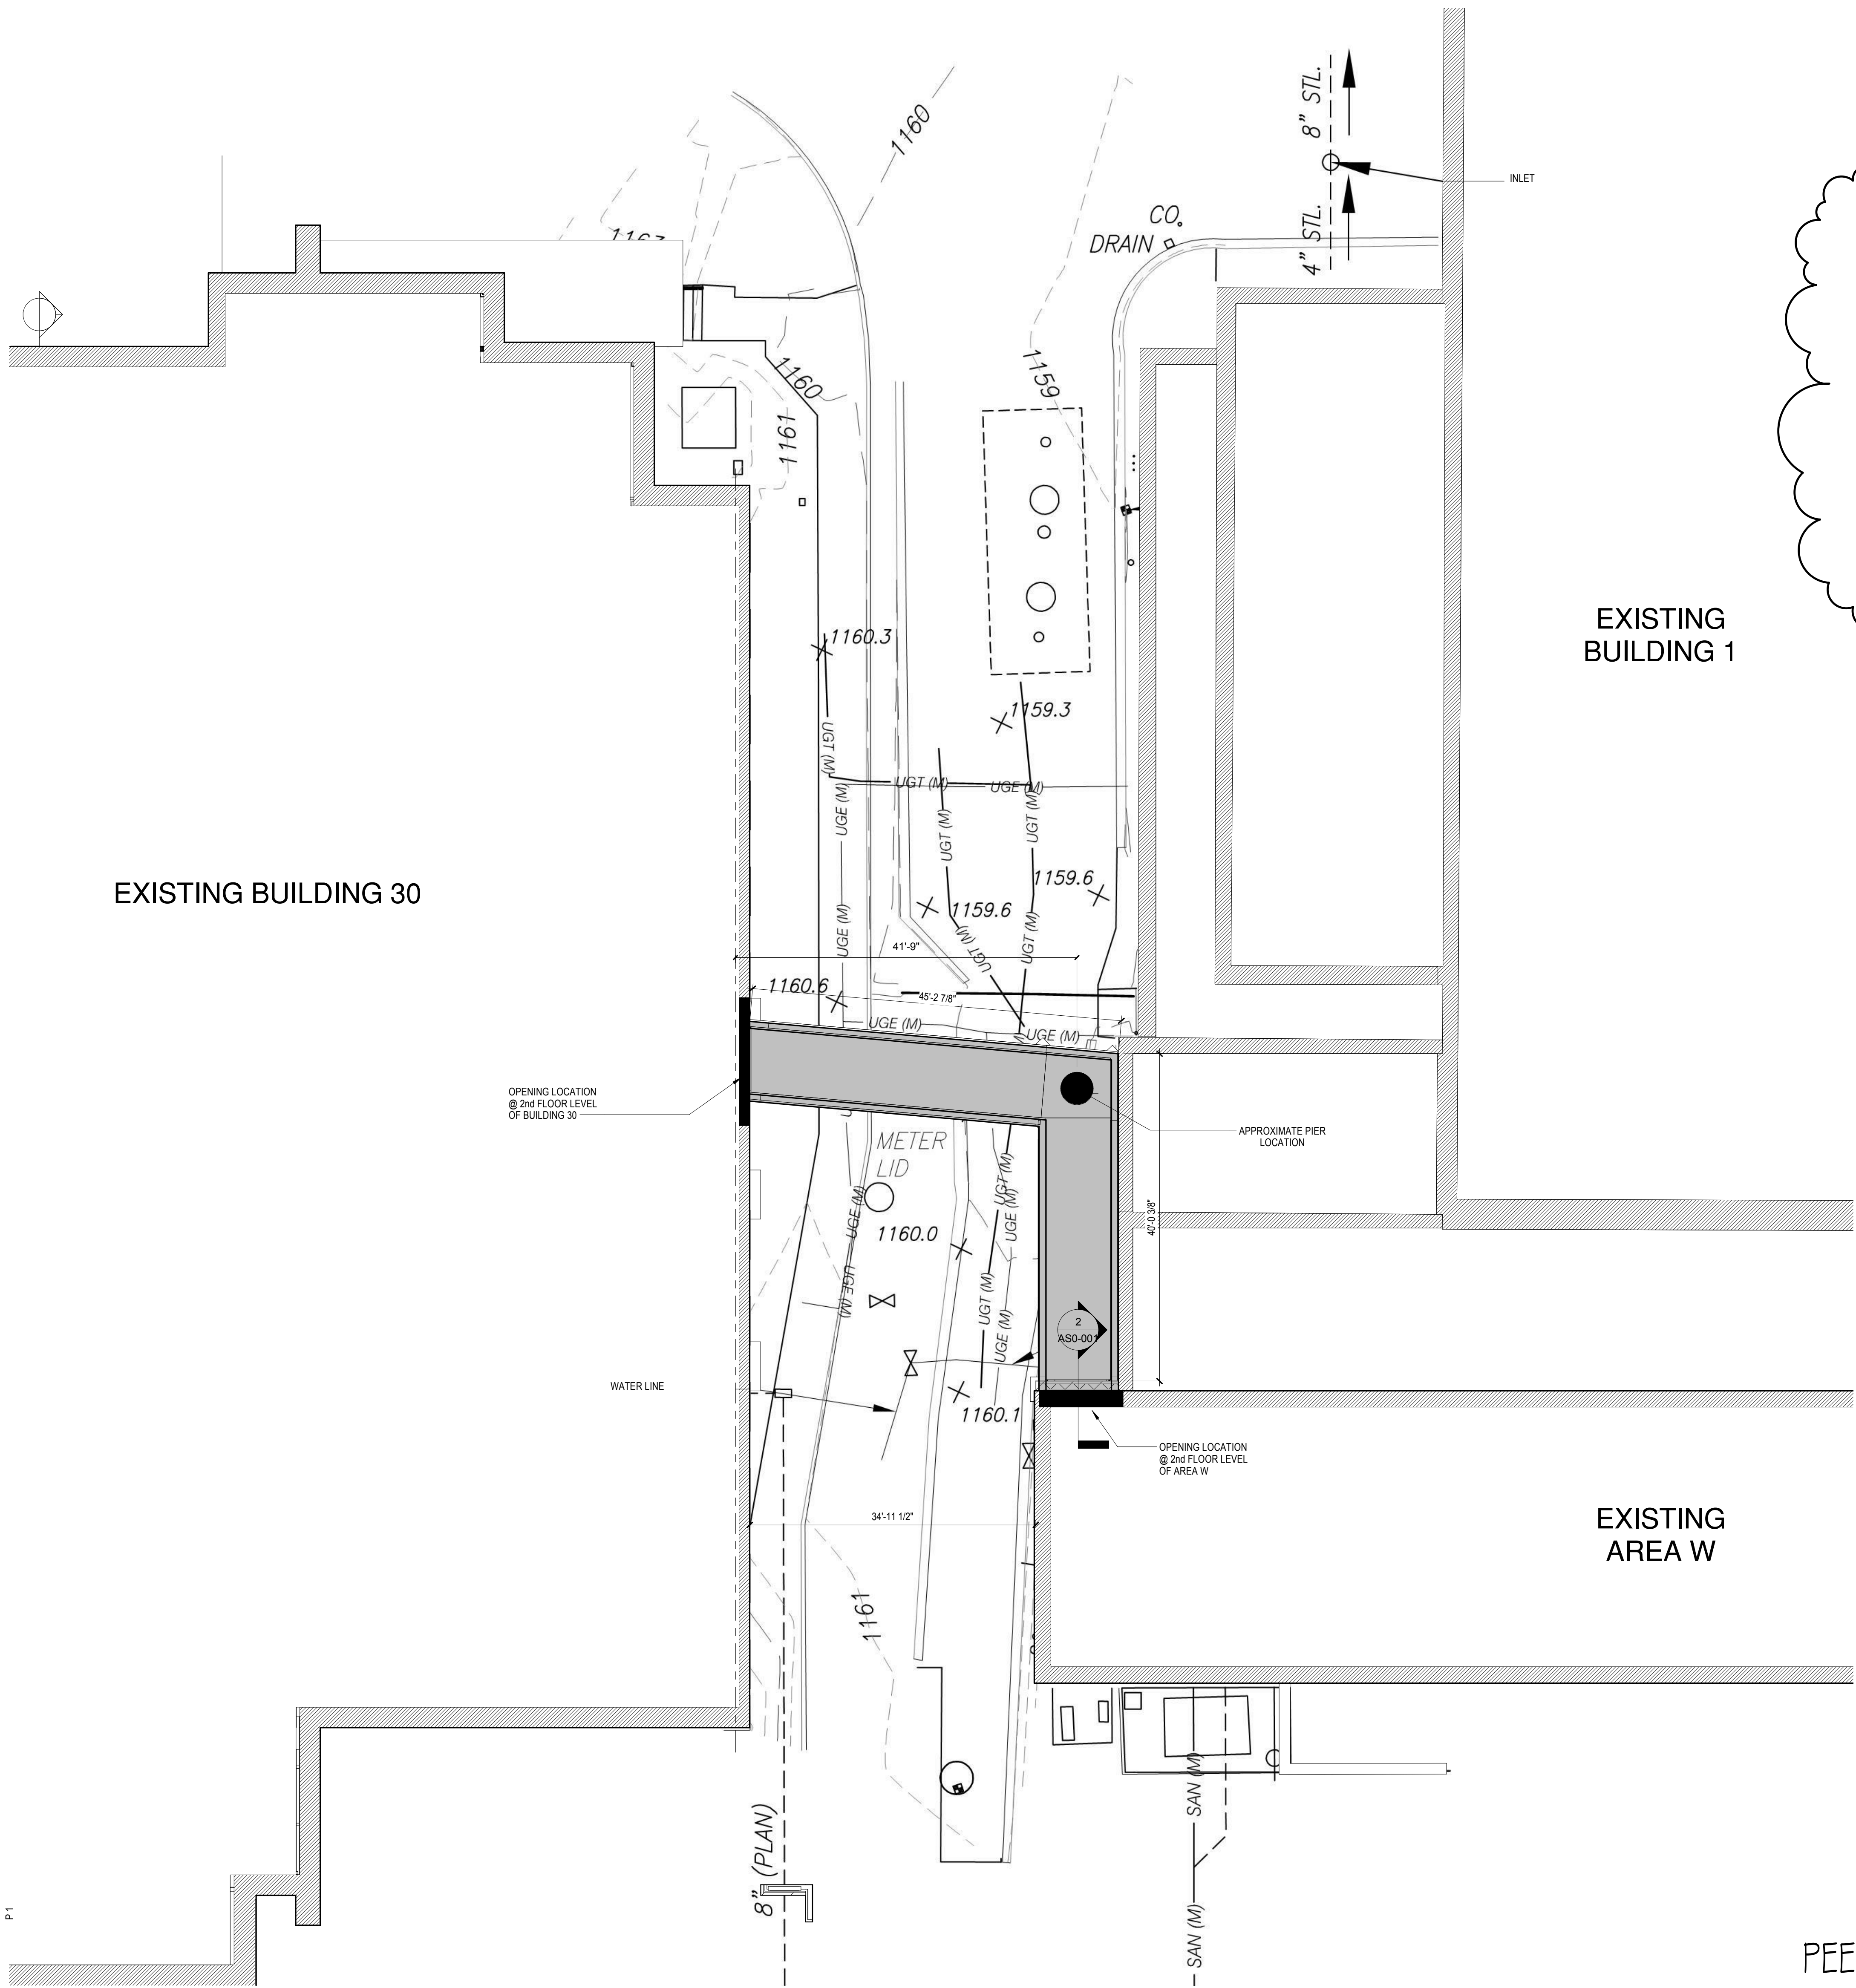



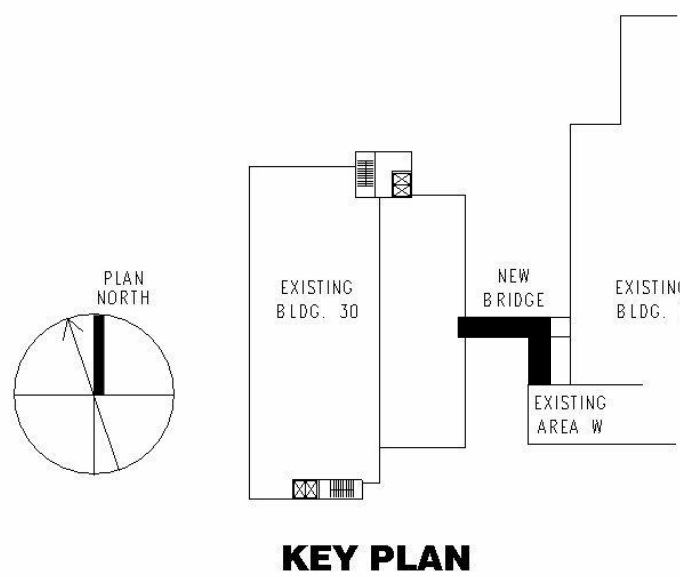


GENERAL NOTES

REFER TO SITE DRAWINGS FOR INFORMATION.

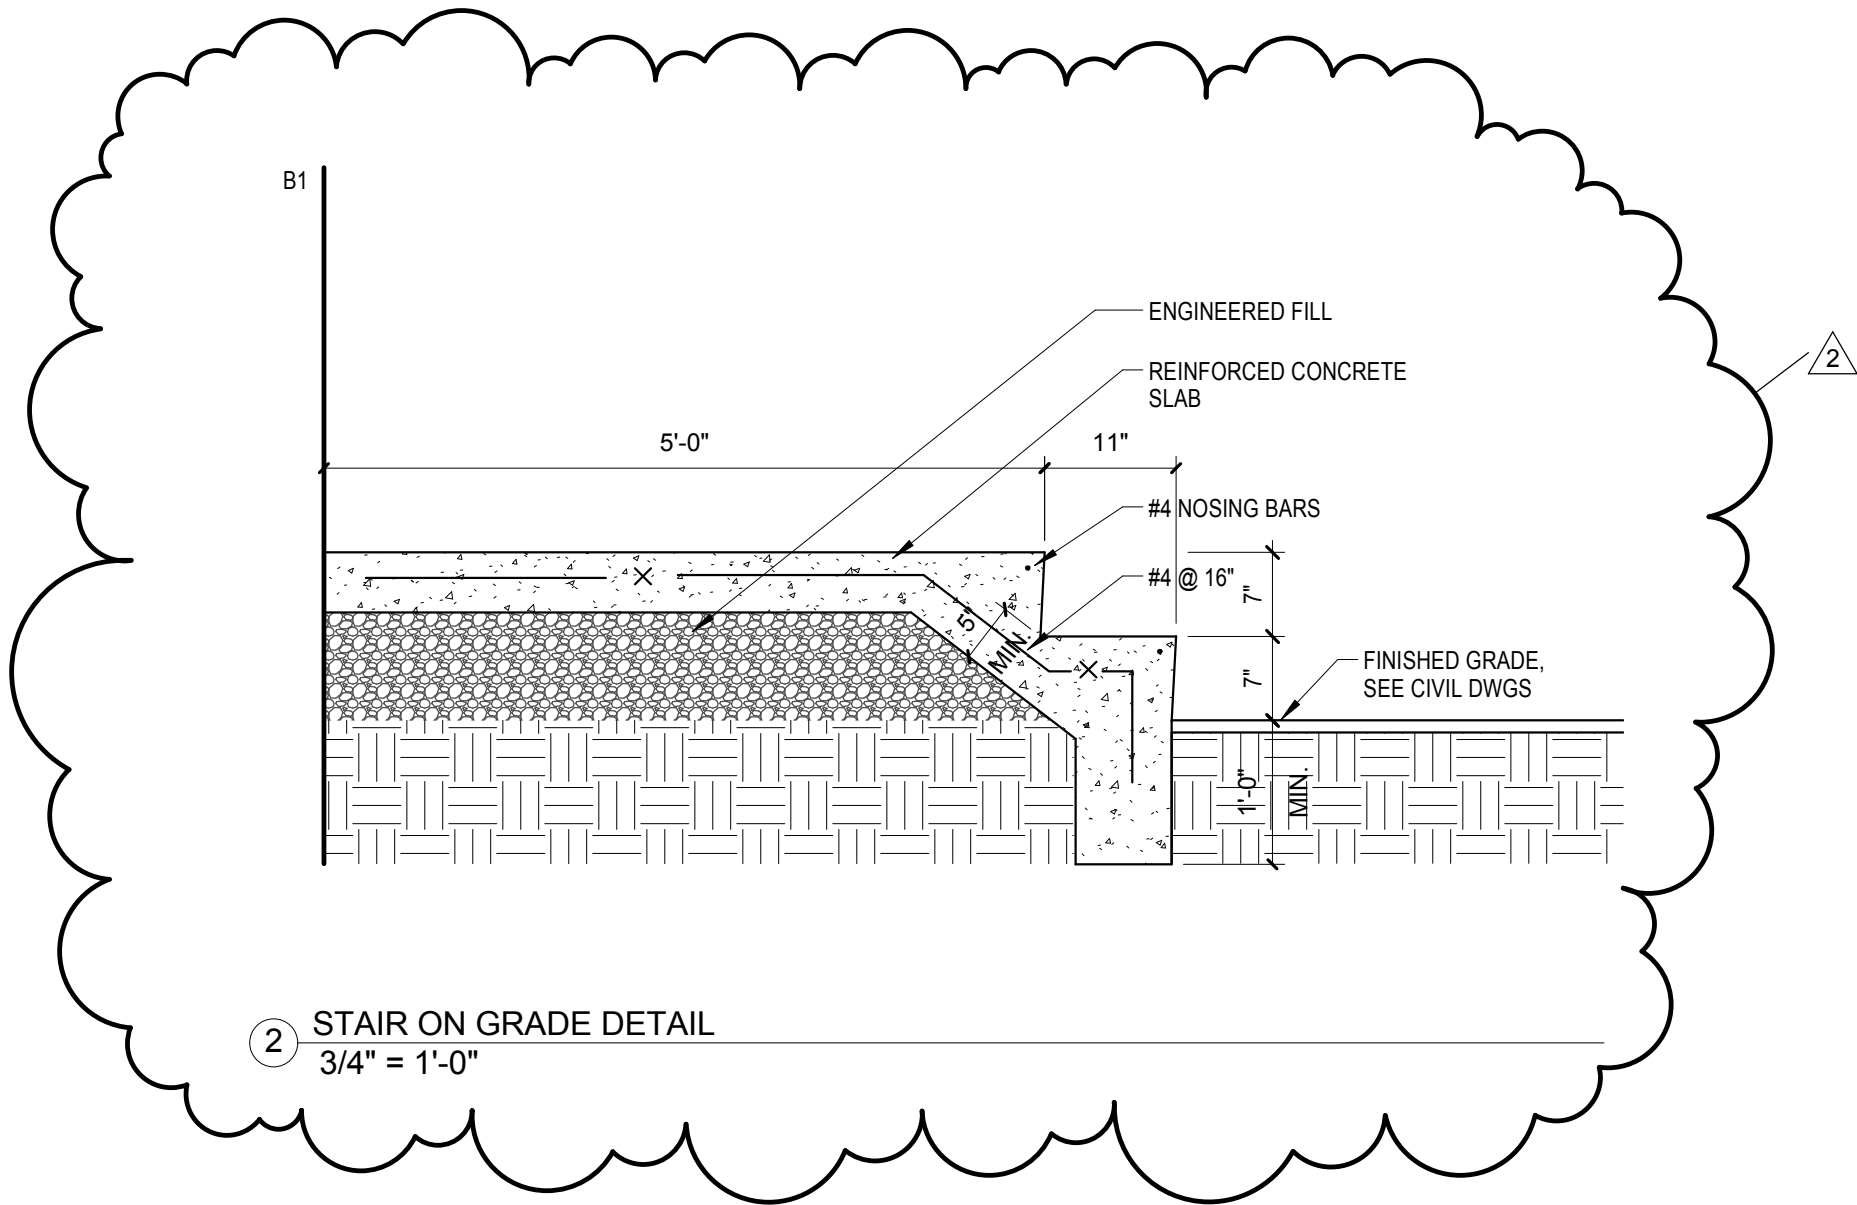

PEER REVIEW DOCUMENTS - December 21st, 2016

FULLY SPRINKLERED

		<b>CONSULTANTS:</b>				<b>ARCHITECT/ENGINEERS:</b>		Drawing Title <b>SITE PLAN</b>		Project Title <b>VA CARES CONSOLIDATION VAMC, PITTSBURGH, PA CONNECTING BRIDGE</b>		Project Number <b>646CA2500B</b>		<b>Office of Facilities Management</b>					
						<div>ARCHITECTURE ENGINEERING INTERIOR DESIGN DESIGN/BUILD</div> <div>ASTORINO • CANNON DESIGN</div> <div>227 Fort Pitt Boulevard • Pittsburgh, Pennsylvania 15222 TEL: 412 763 1500 FAX: 412 763 1511 WWW.ASTORINO.COM</div>		Approved: Project Director		Location <b>VAPHS UNIVERSITY DRIVE</b>		Building Number <b>1 &amp; 30</b>				Drawing Number <b>ASO-001</b>			
												Date		Checked		Drawn		 Department of Veterans Affairs	
												<b>Checker</b>		<b>Author</b>		Dwg. of			
2 Amendment No. 6		02-10-17																	
1 Amendment No. 4		02-03-17																	
<b>Revisions:</b>		<b>Date</b>																	