




1st FLOOR PLAN

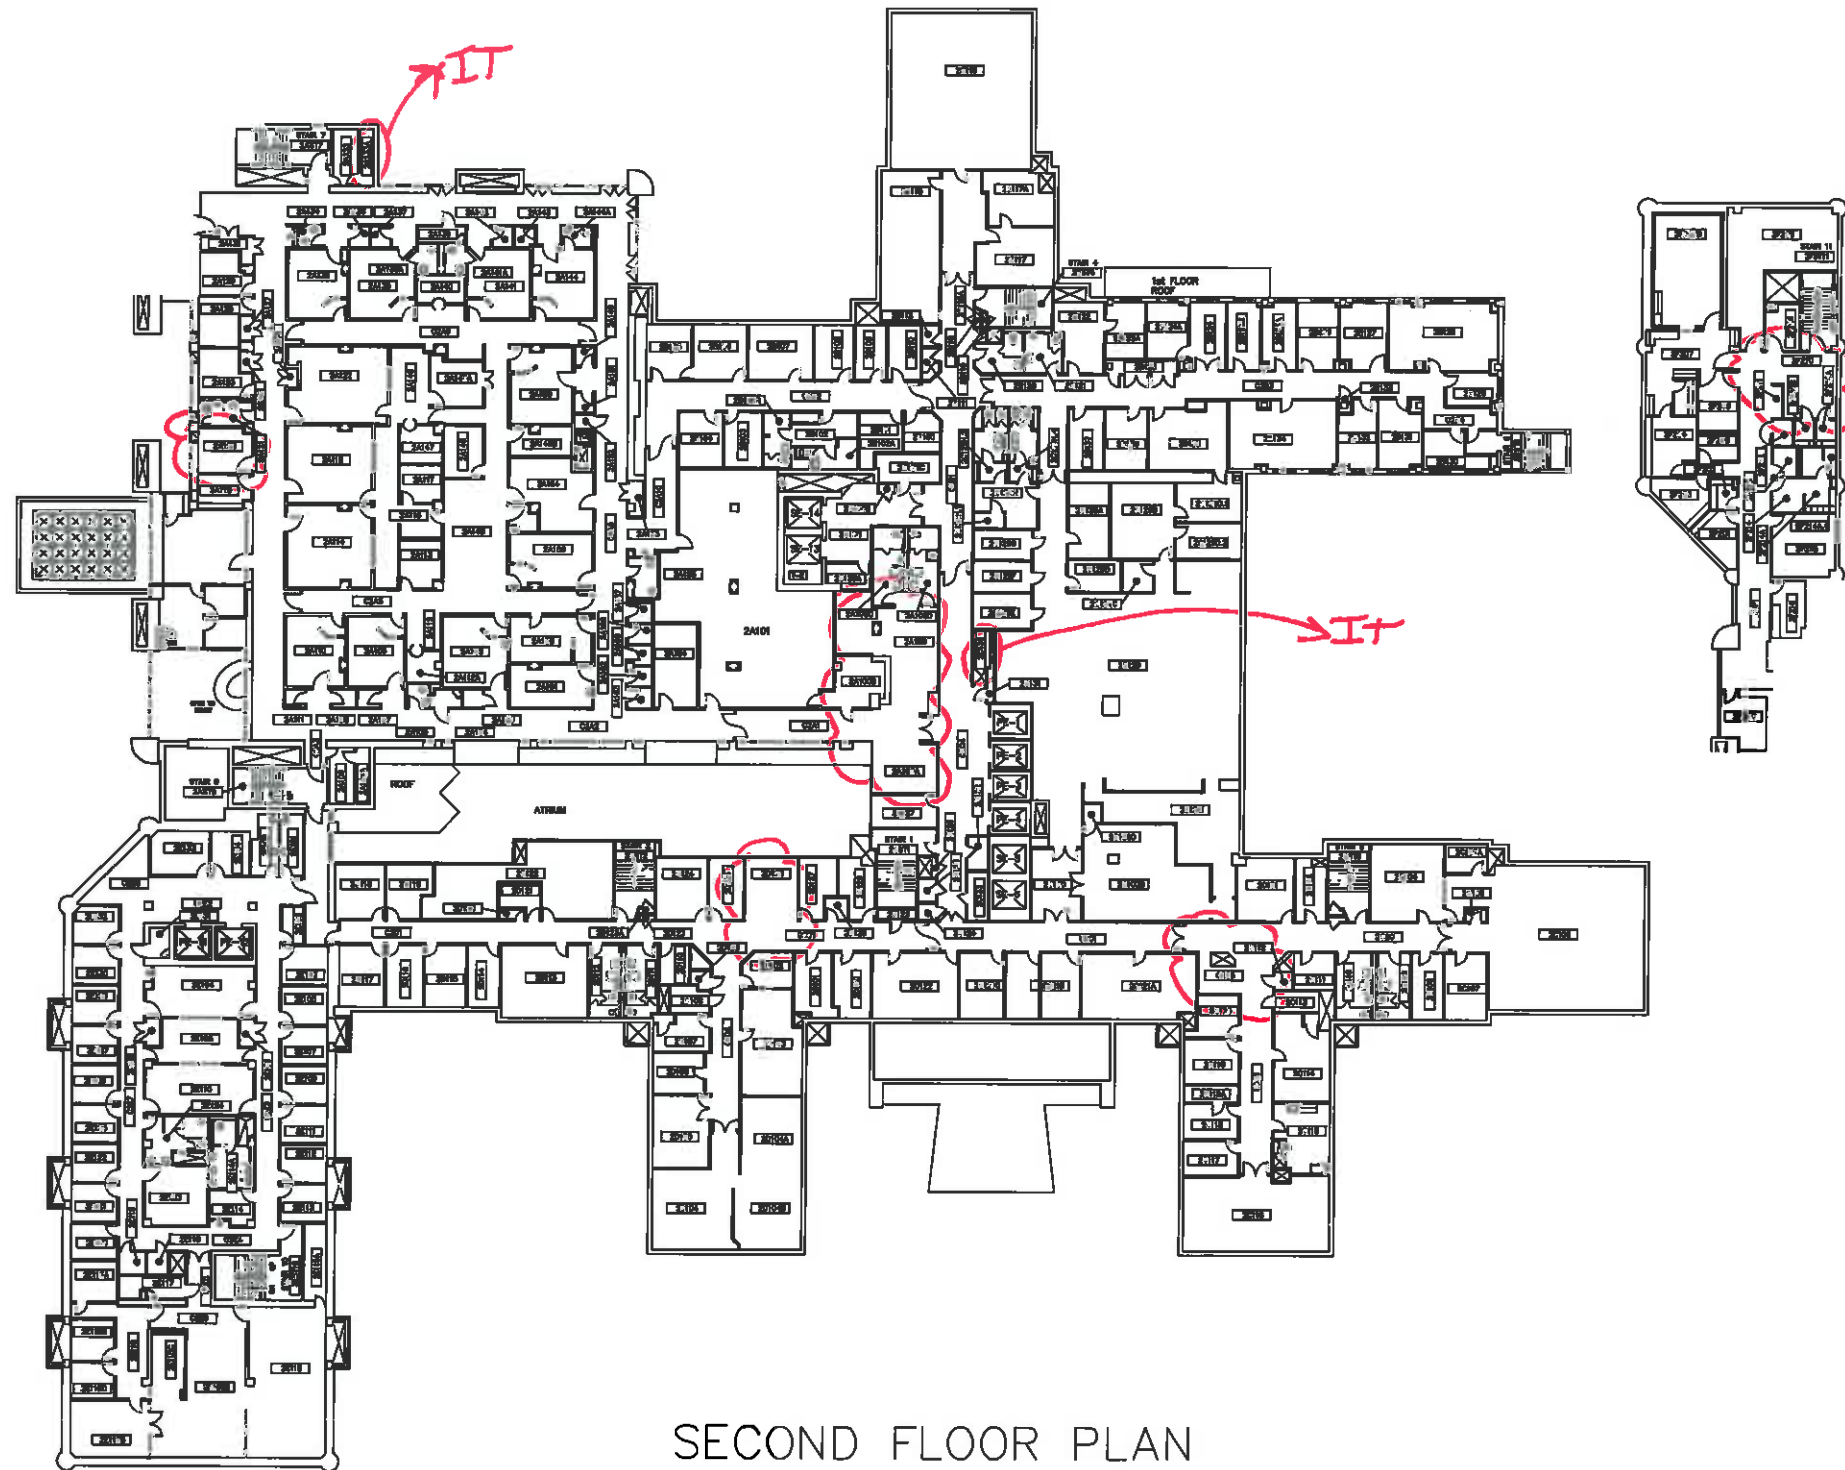


SECOND FLOOR PLAN

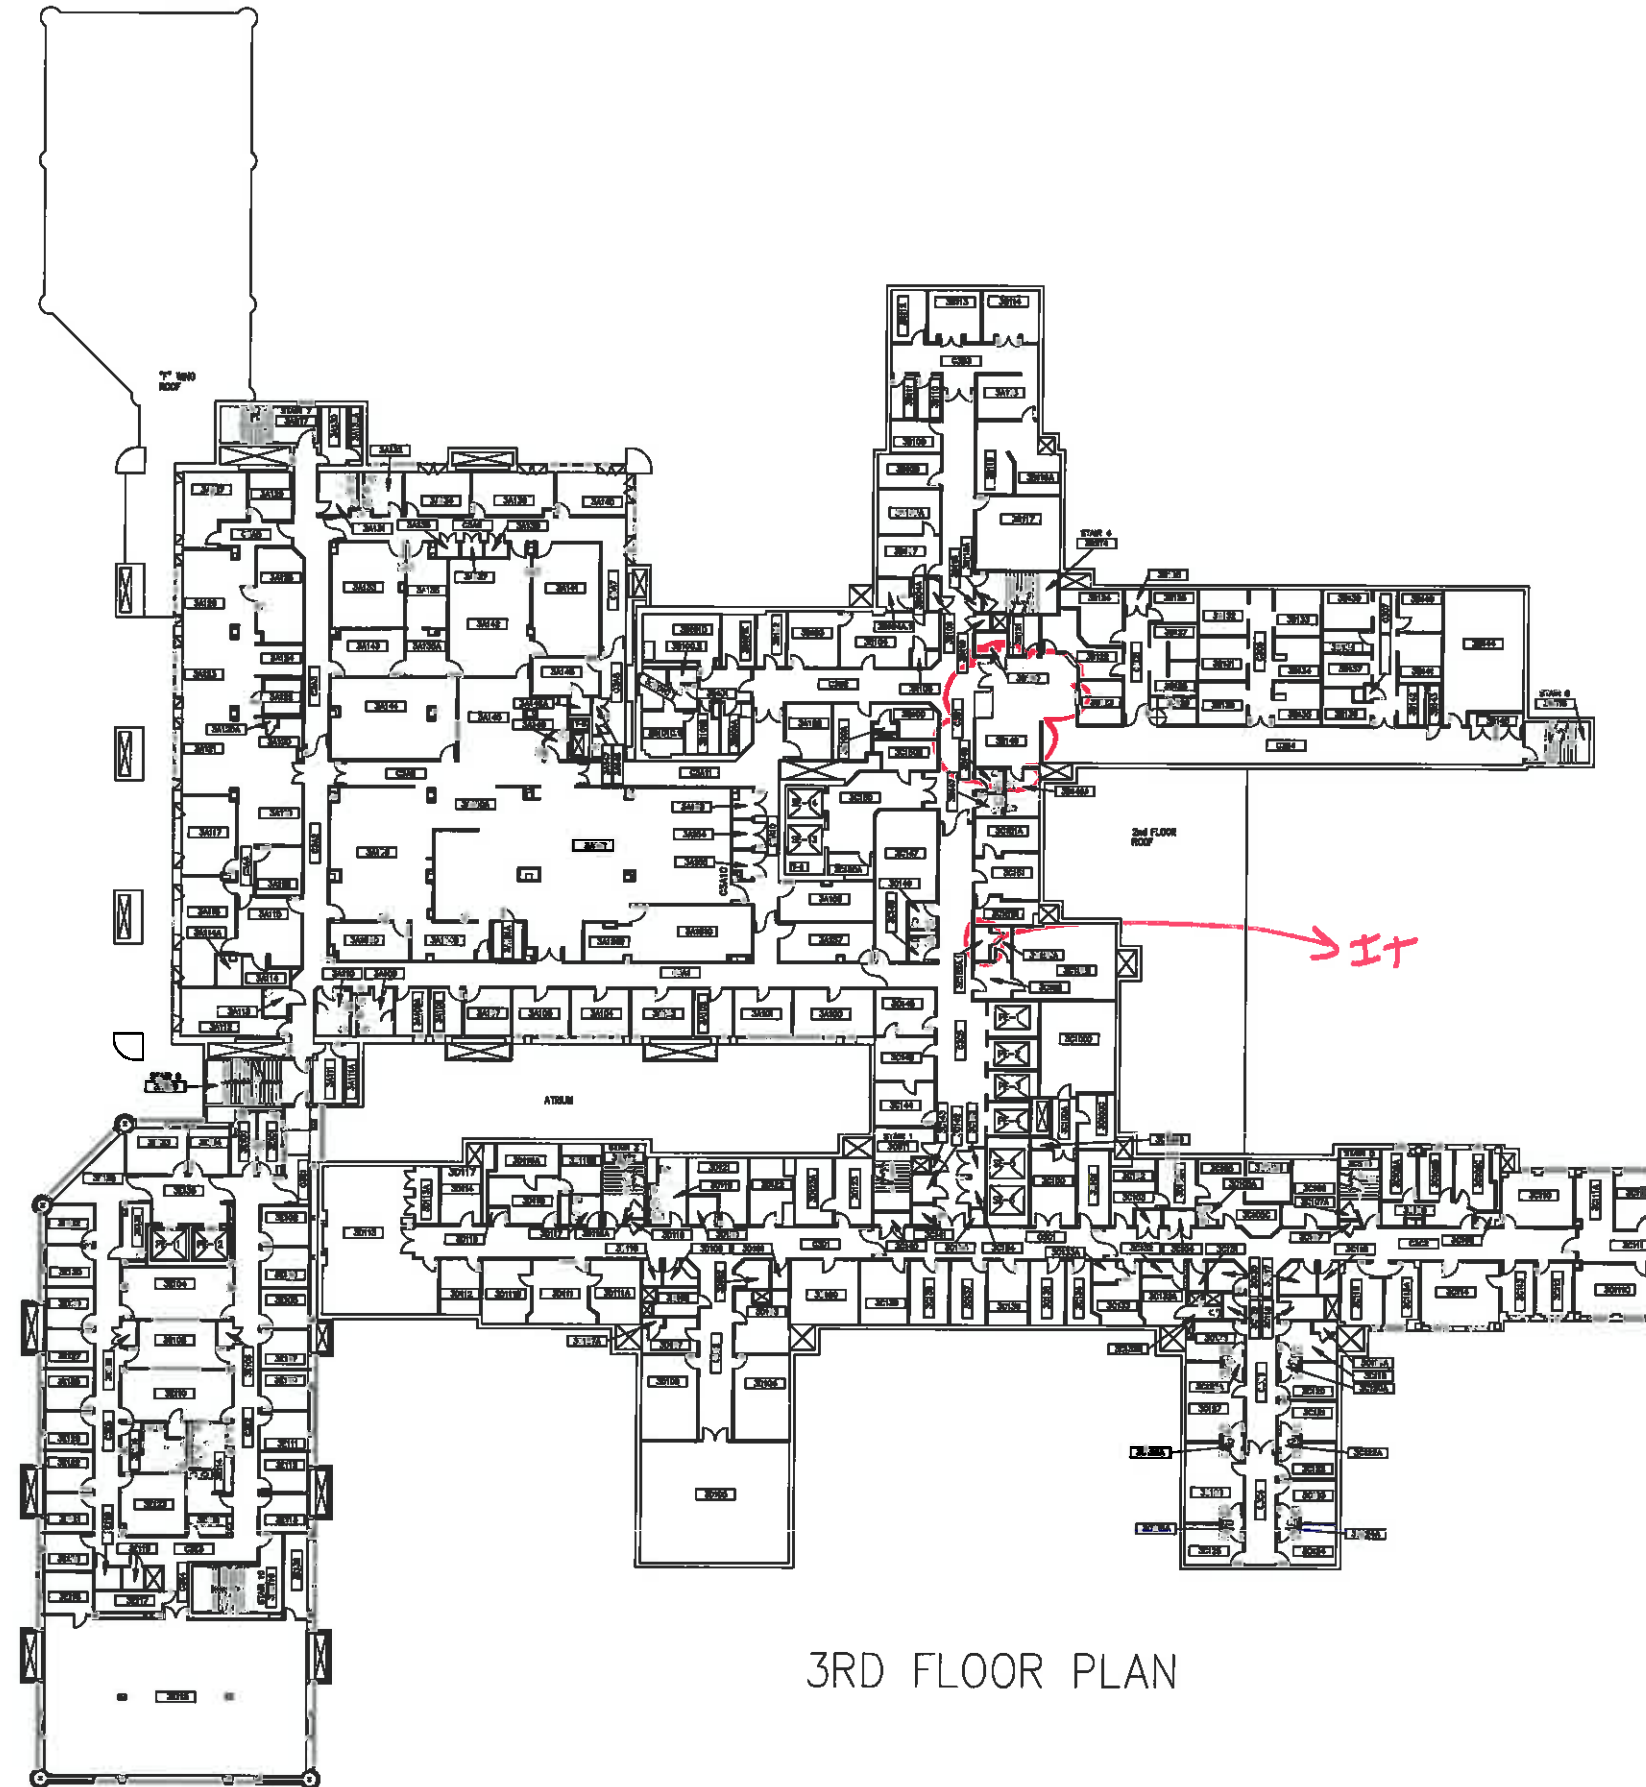


3RD FLOOR PLAN

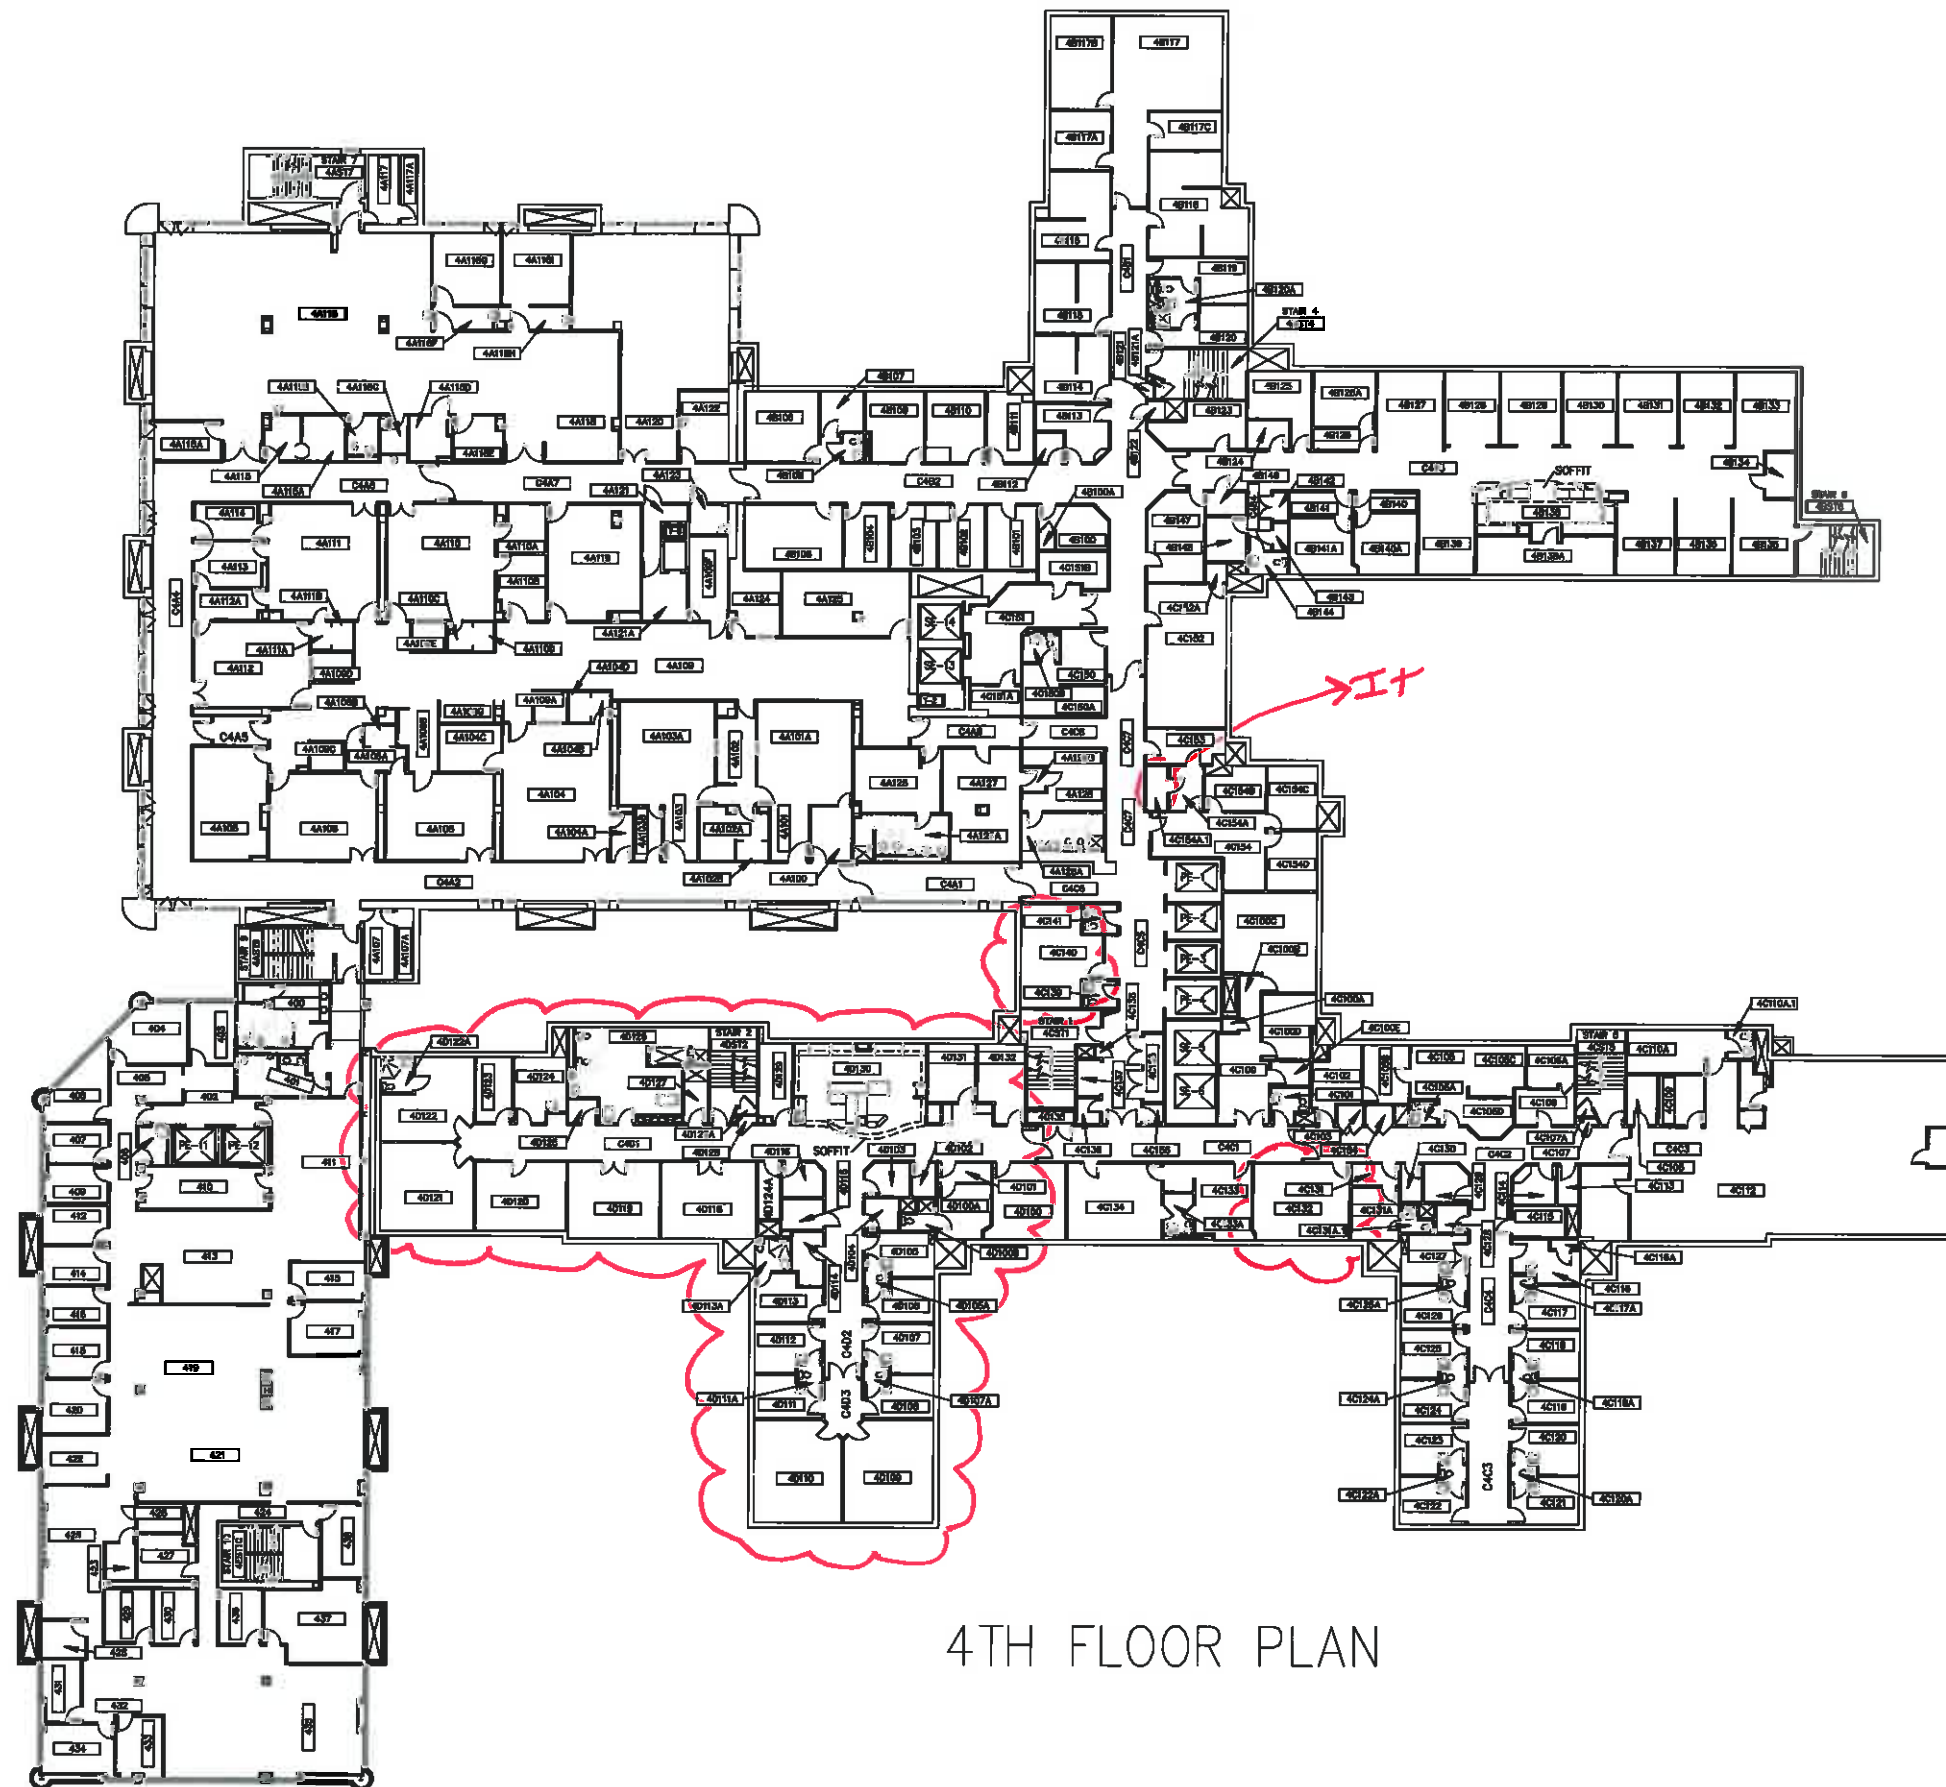


4TH FLOOR PLAN

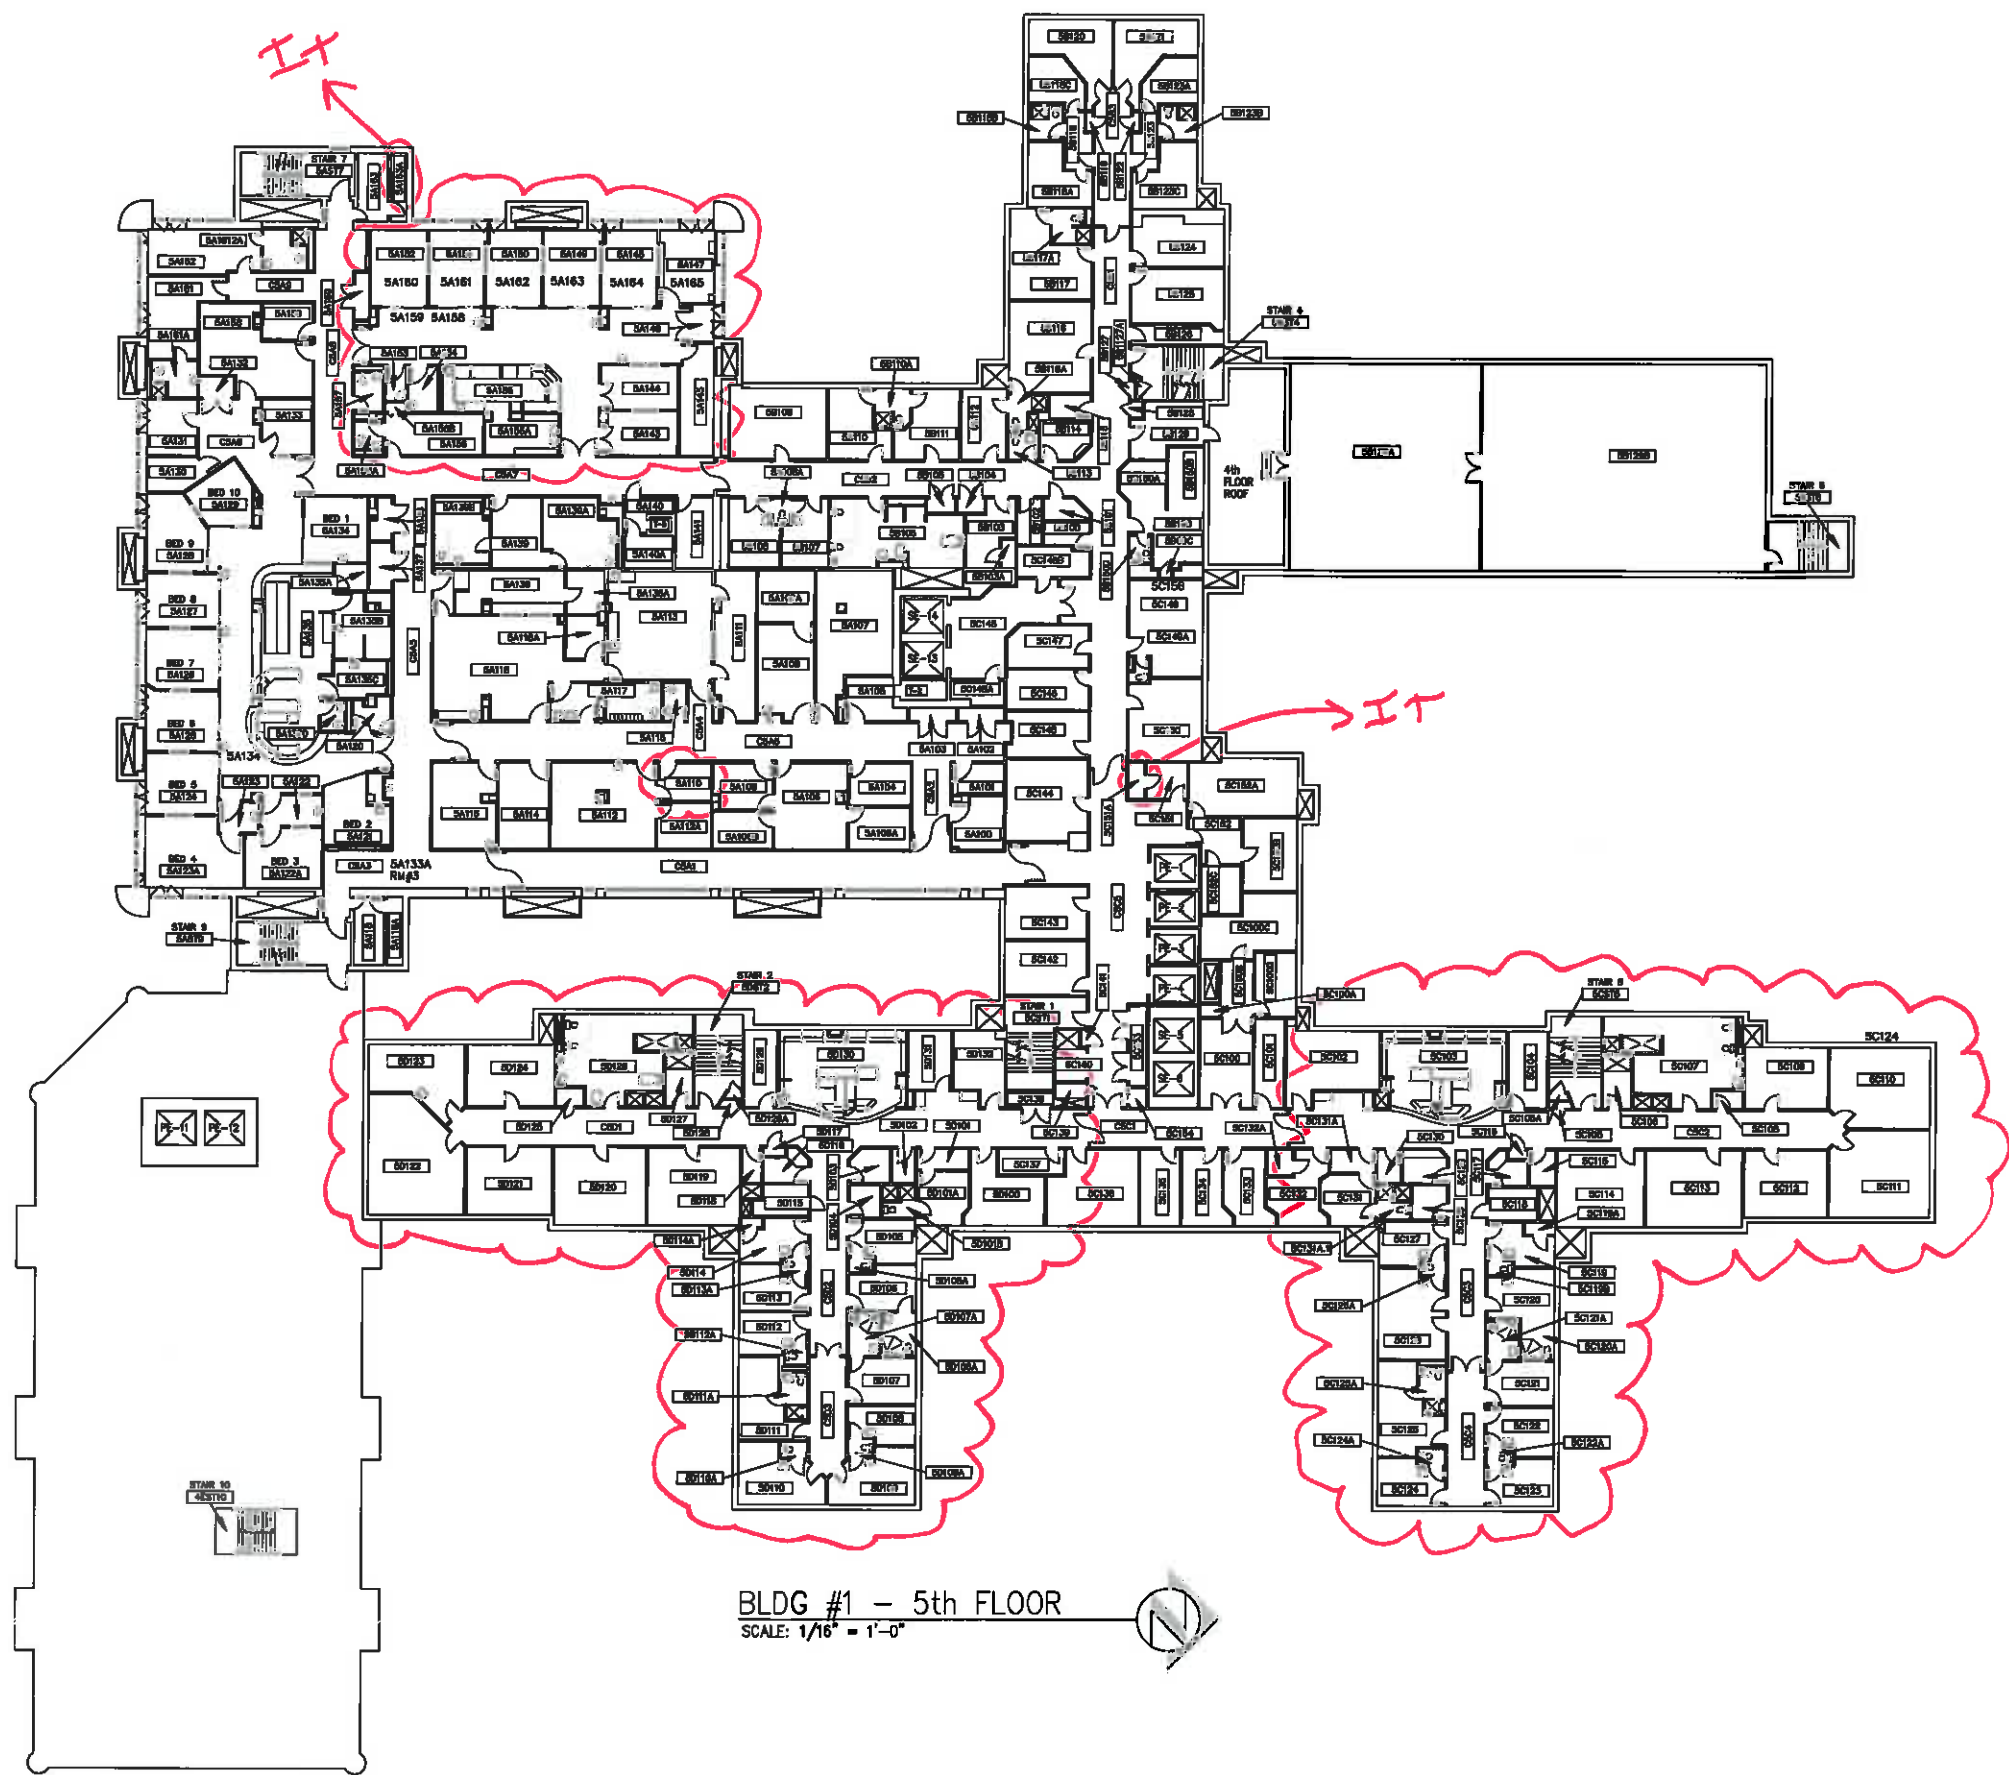

BLDG #1 - 5th FLOOR
SCALE: 1/16" = 1'-0"

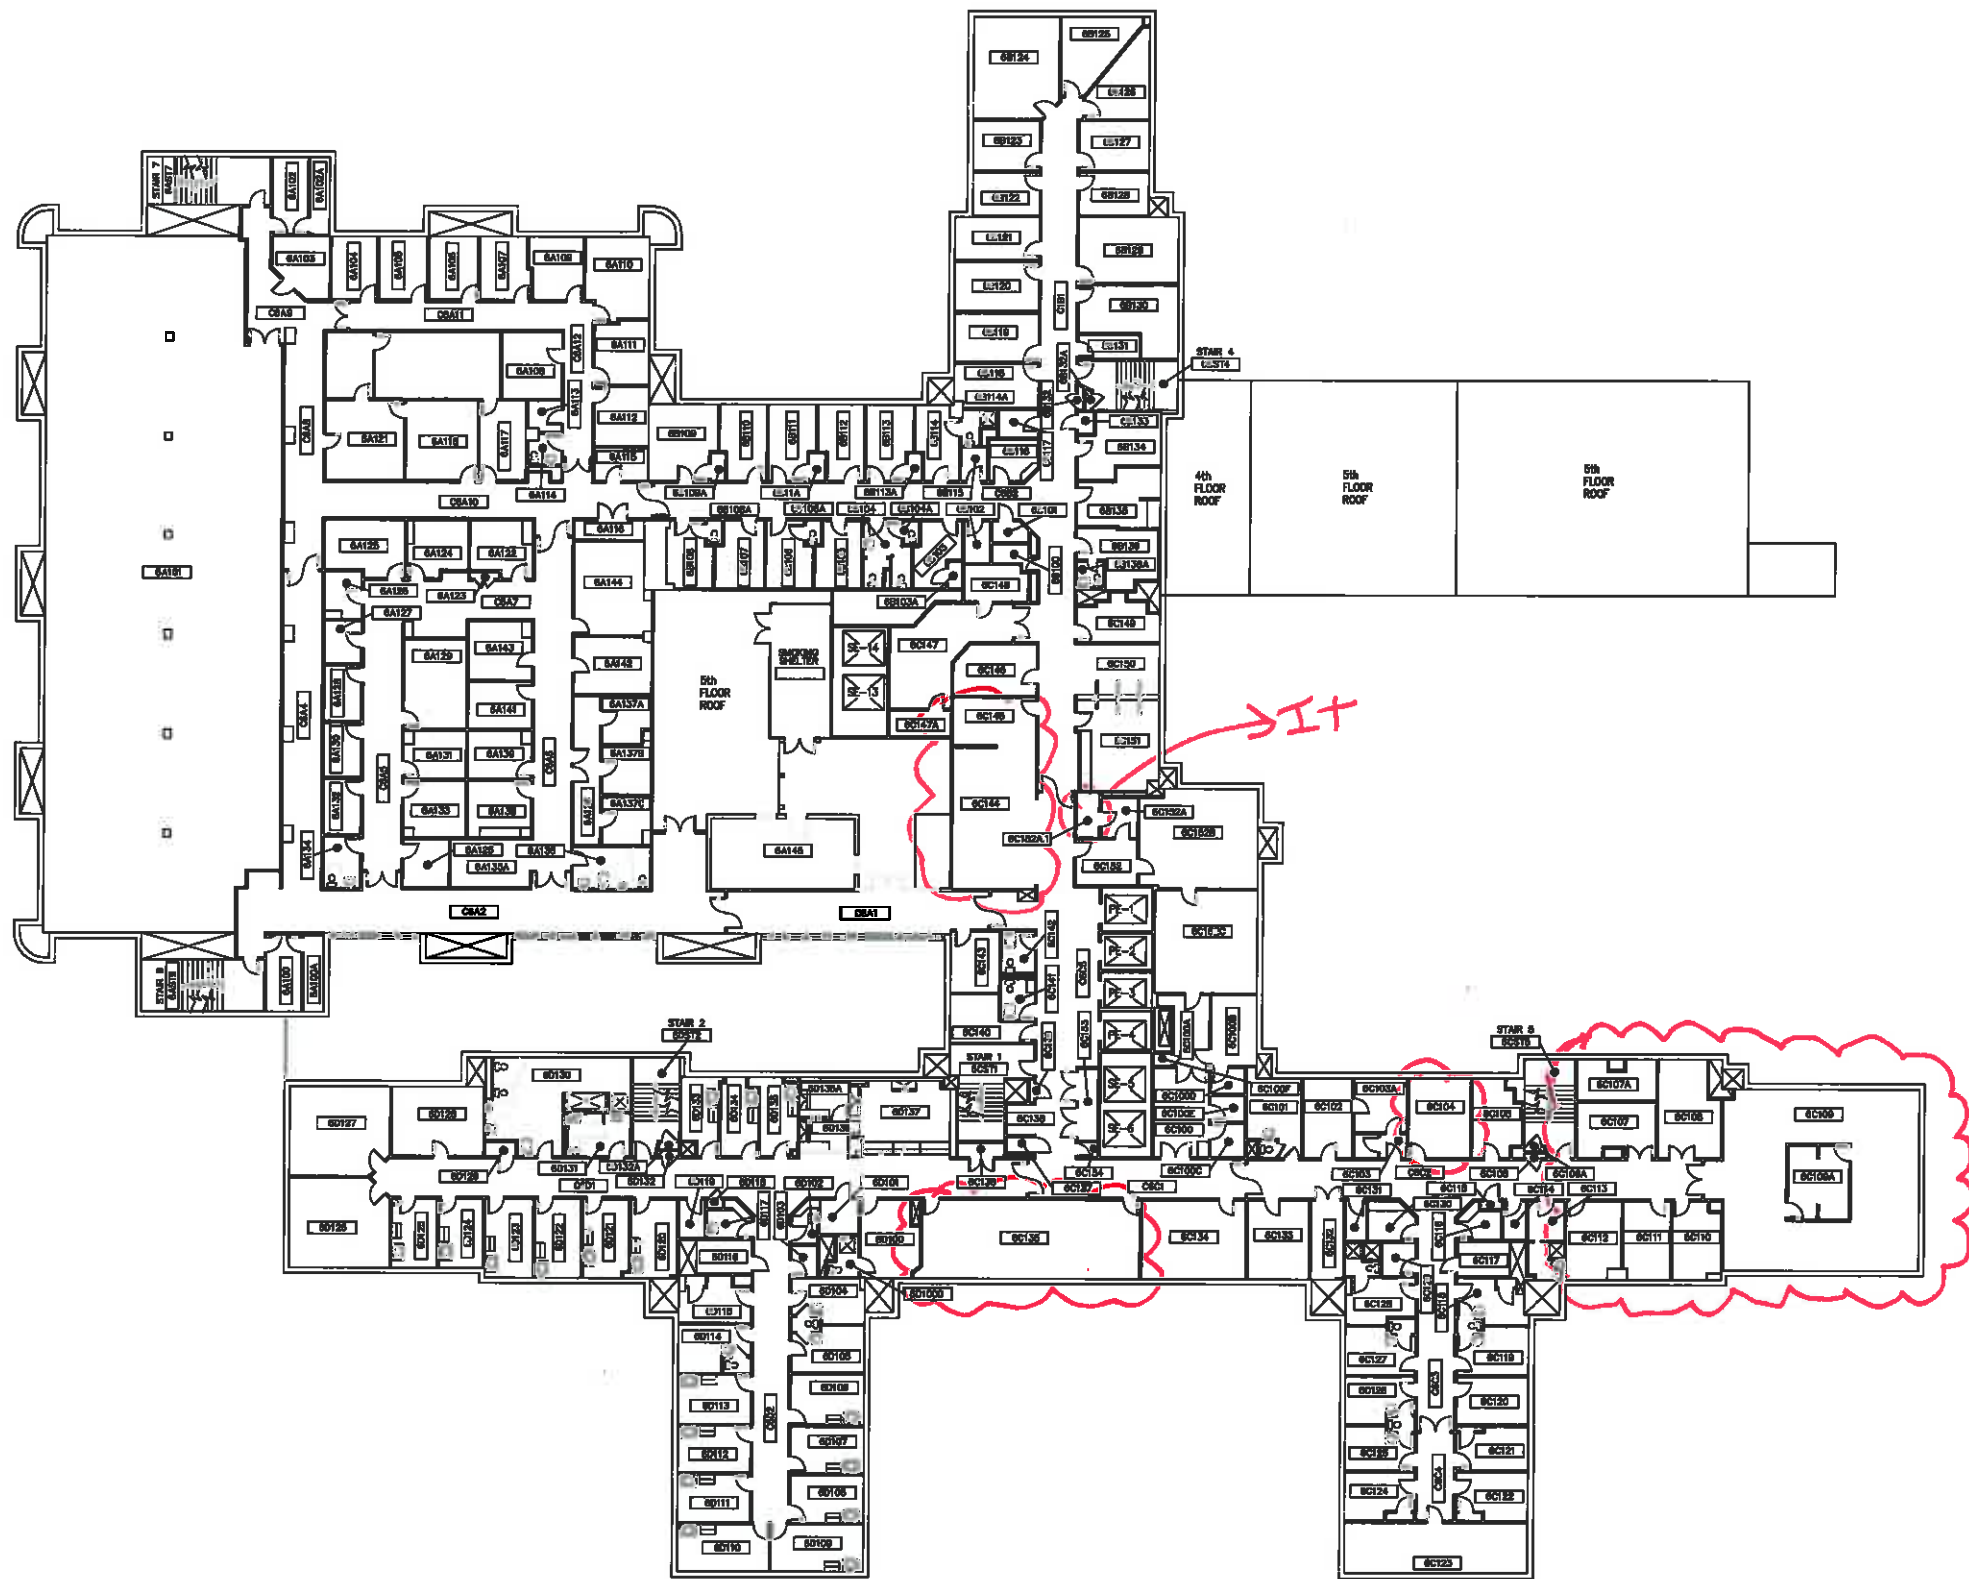


BLDG #1 - 6th FLOOR
SCALE: 1/16" = 1'-0"

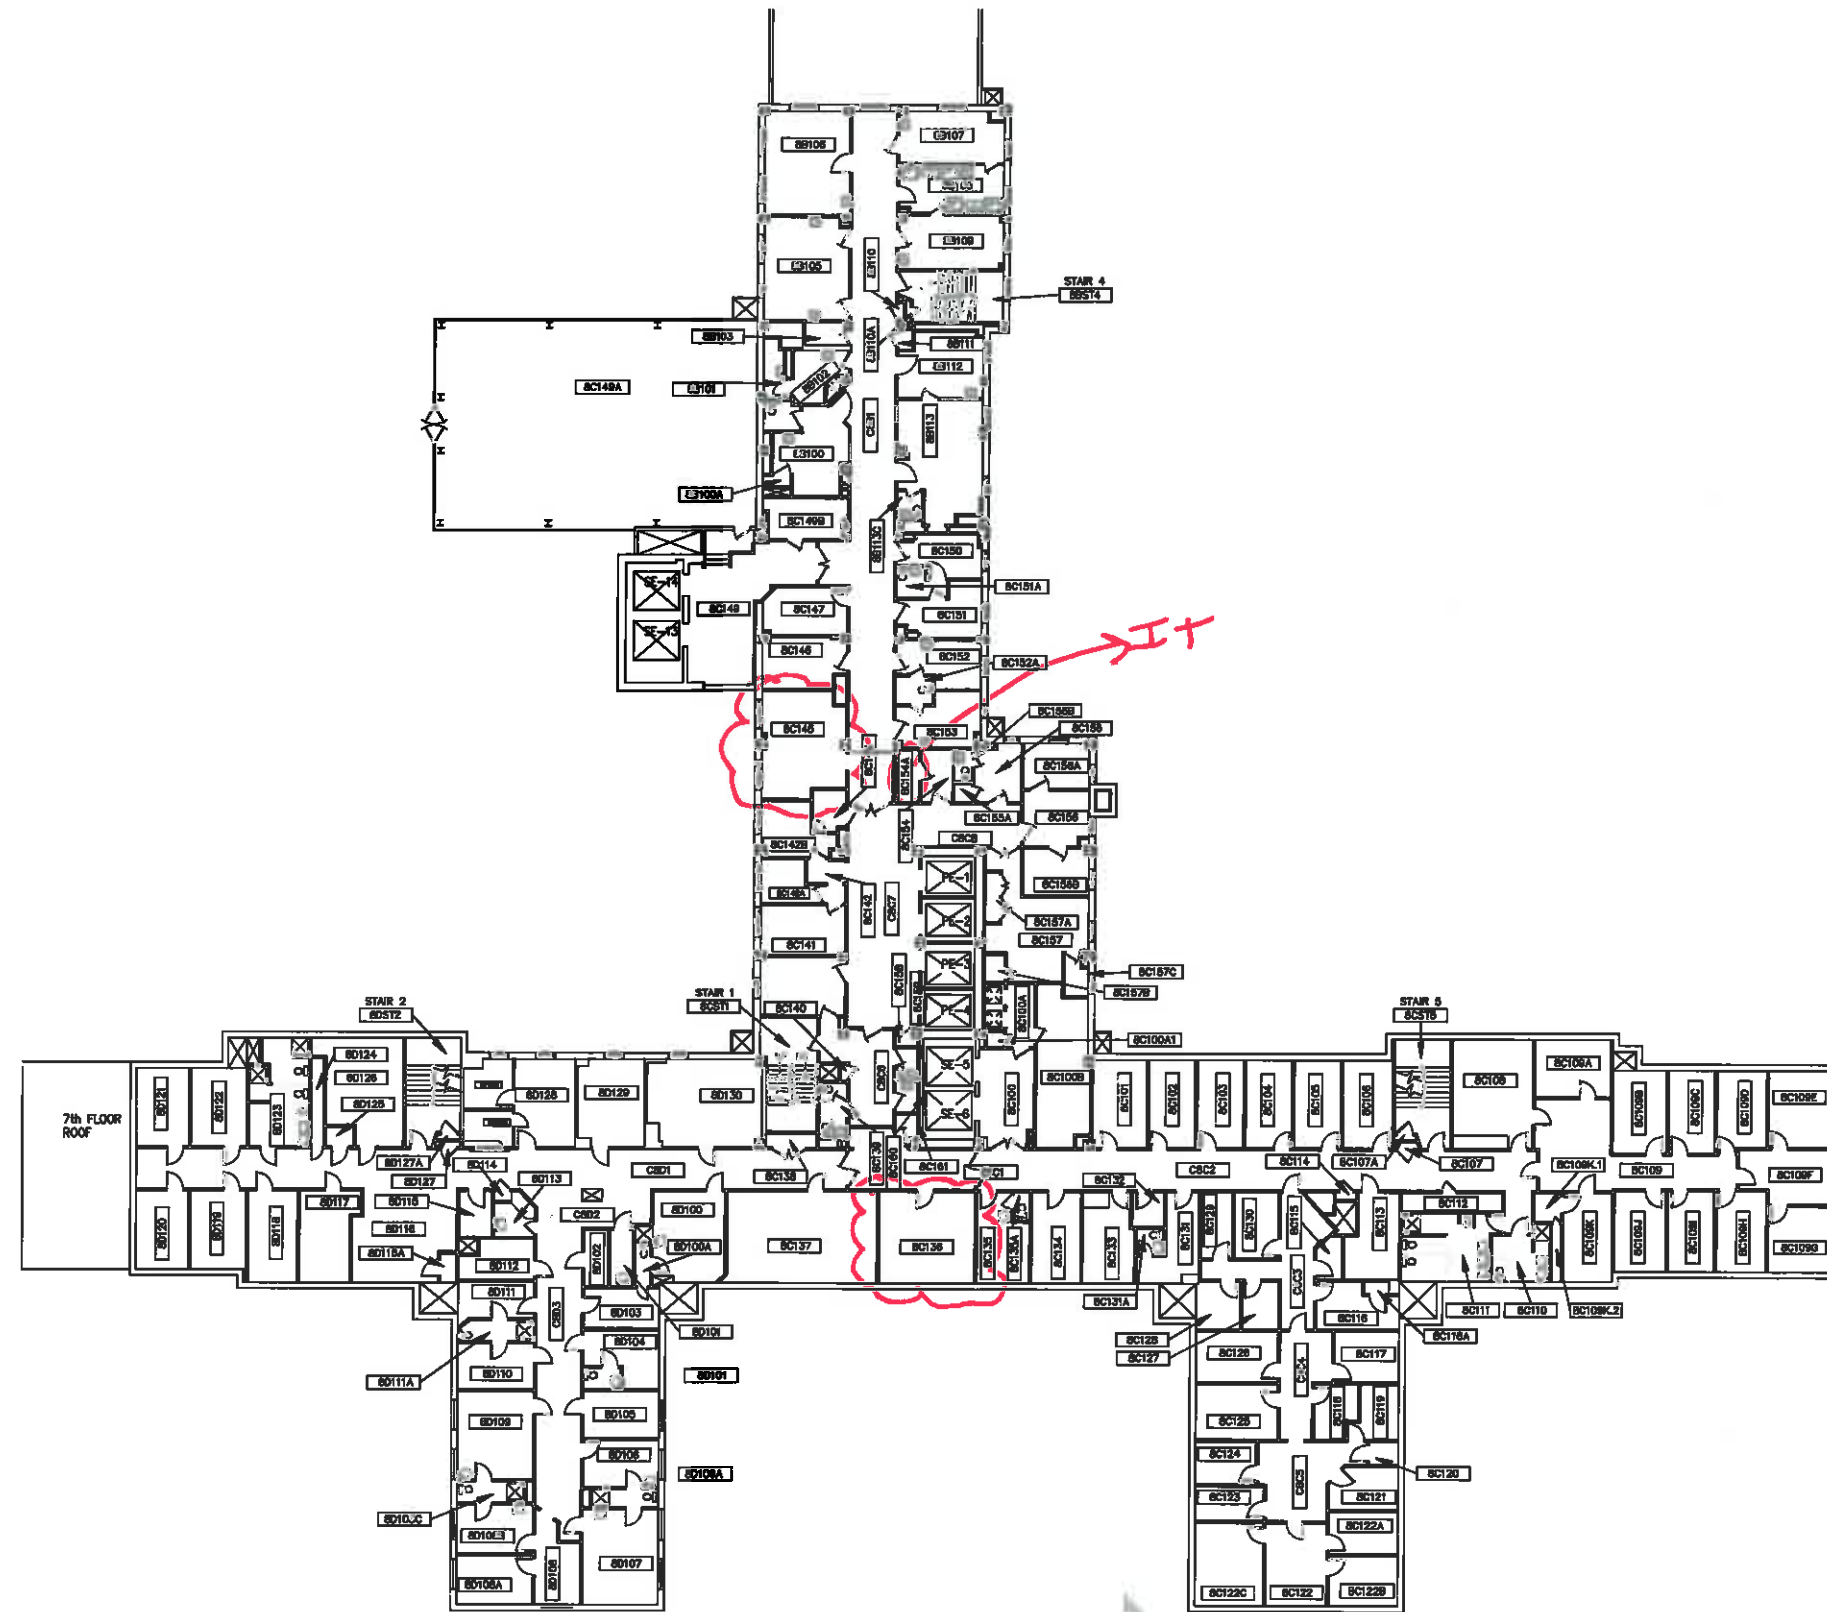


BLDG #1 - 8th FLOOR
SCALE: 1/16" = 1'-0"

FED FROM
2ND FLOOR
IT CLOSET

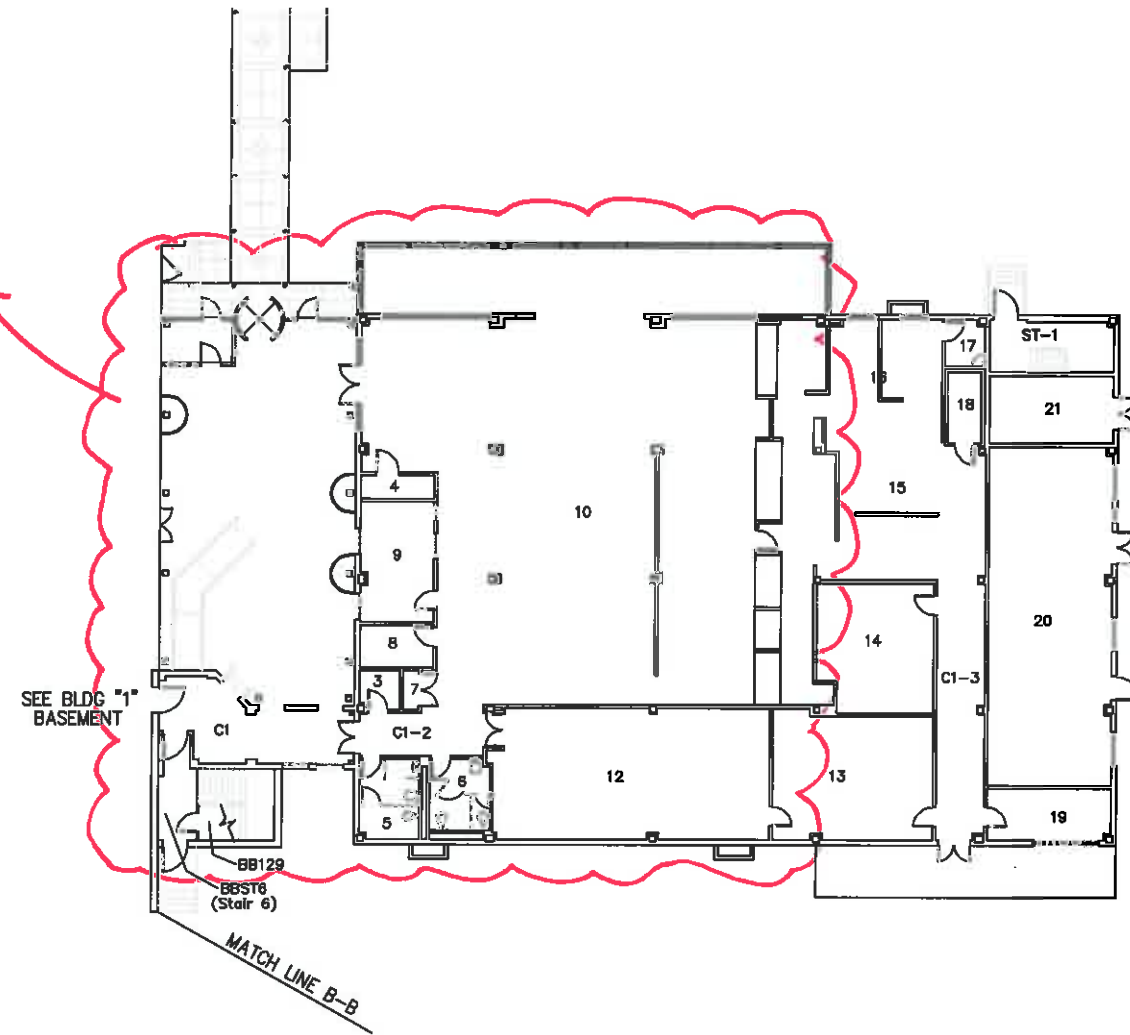

BLDG #24 - 1st FLOOR
SCALE: 1/8" = 1'-0"




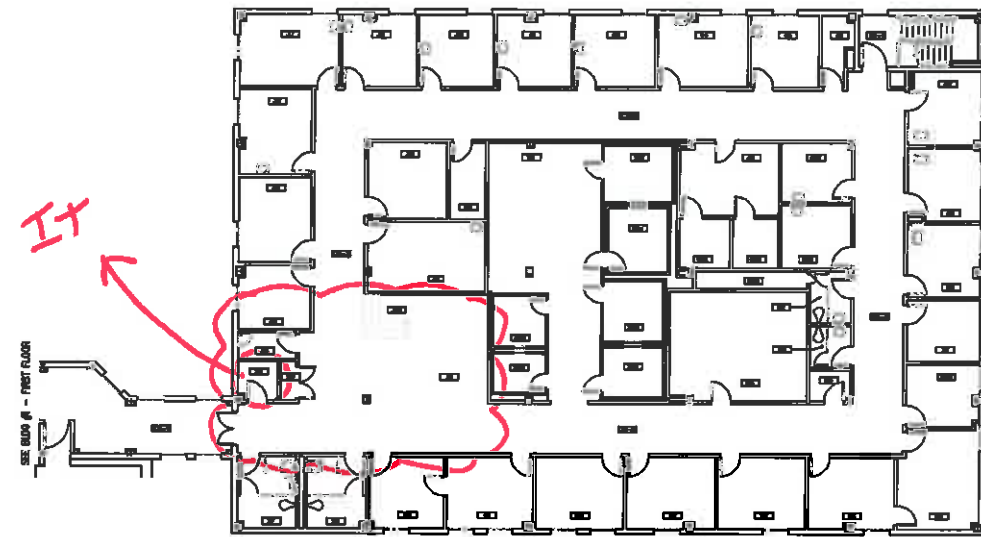

BLDG 24 - 2nd FLOOR
SCALE: 1/4" = 1'-0"



SEE BLDG #1 - BASEMENT

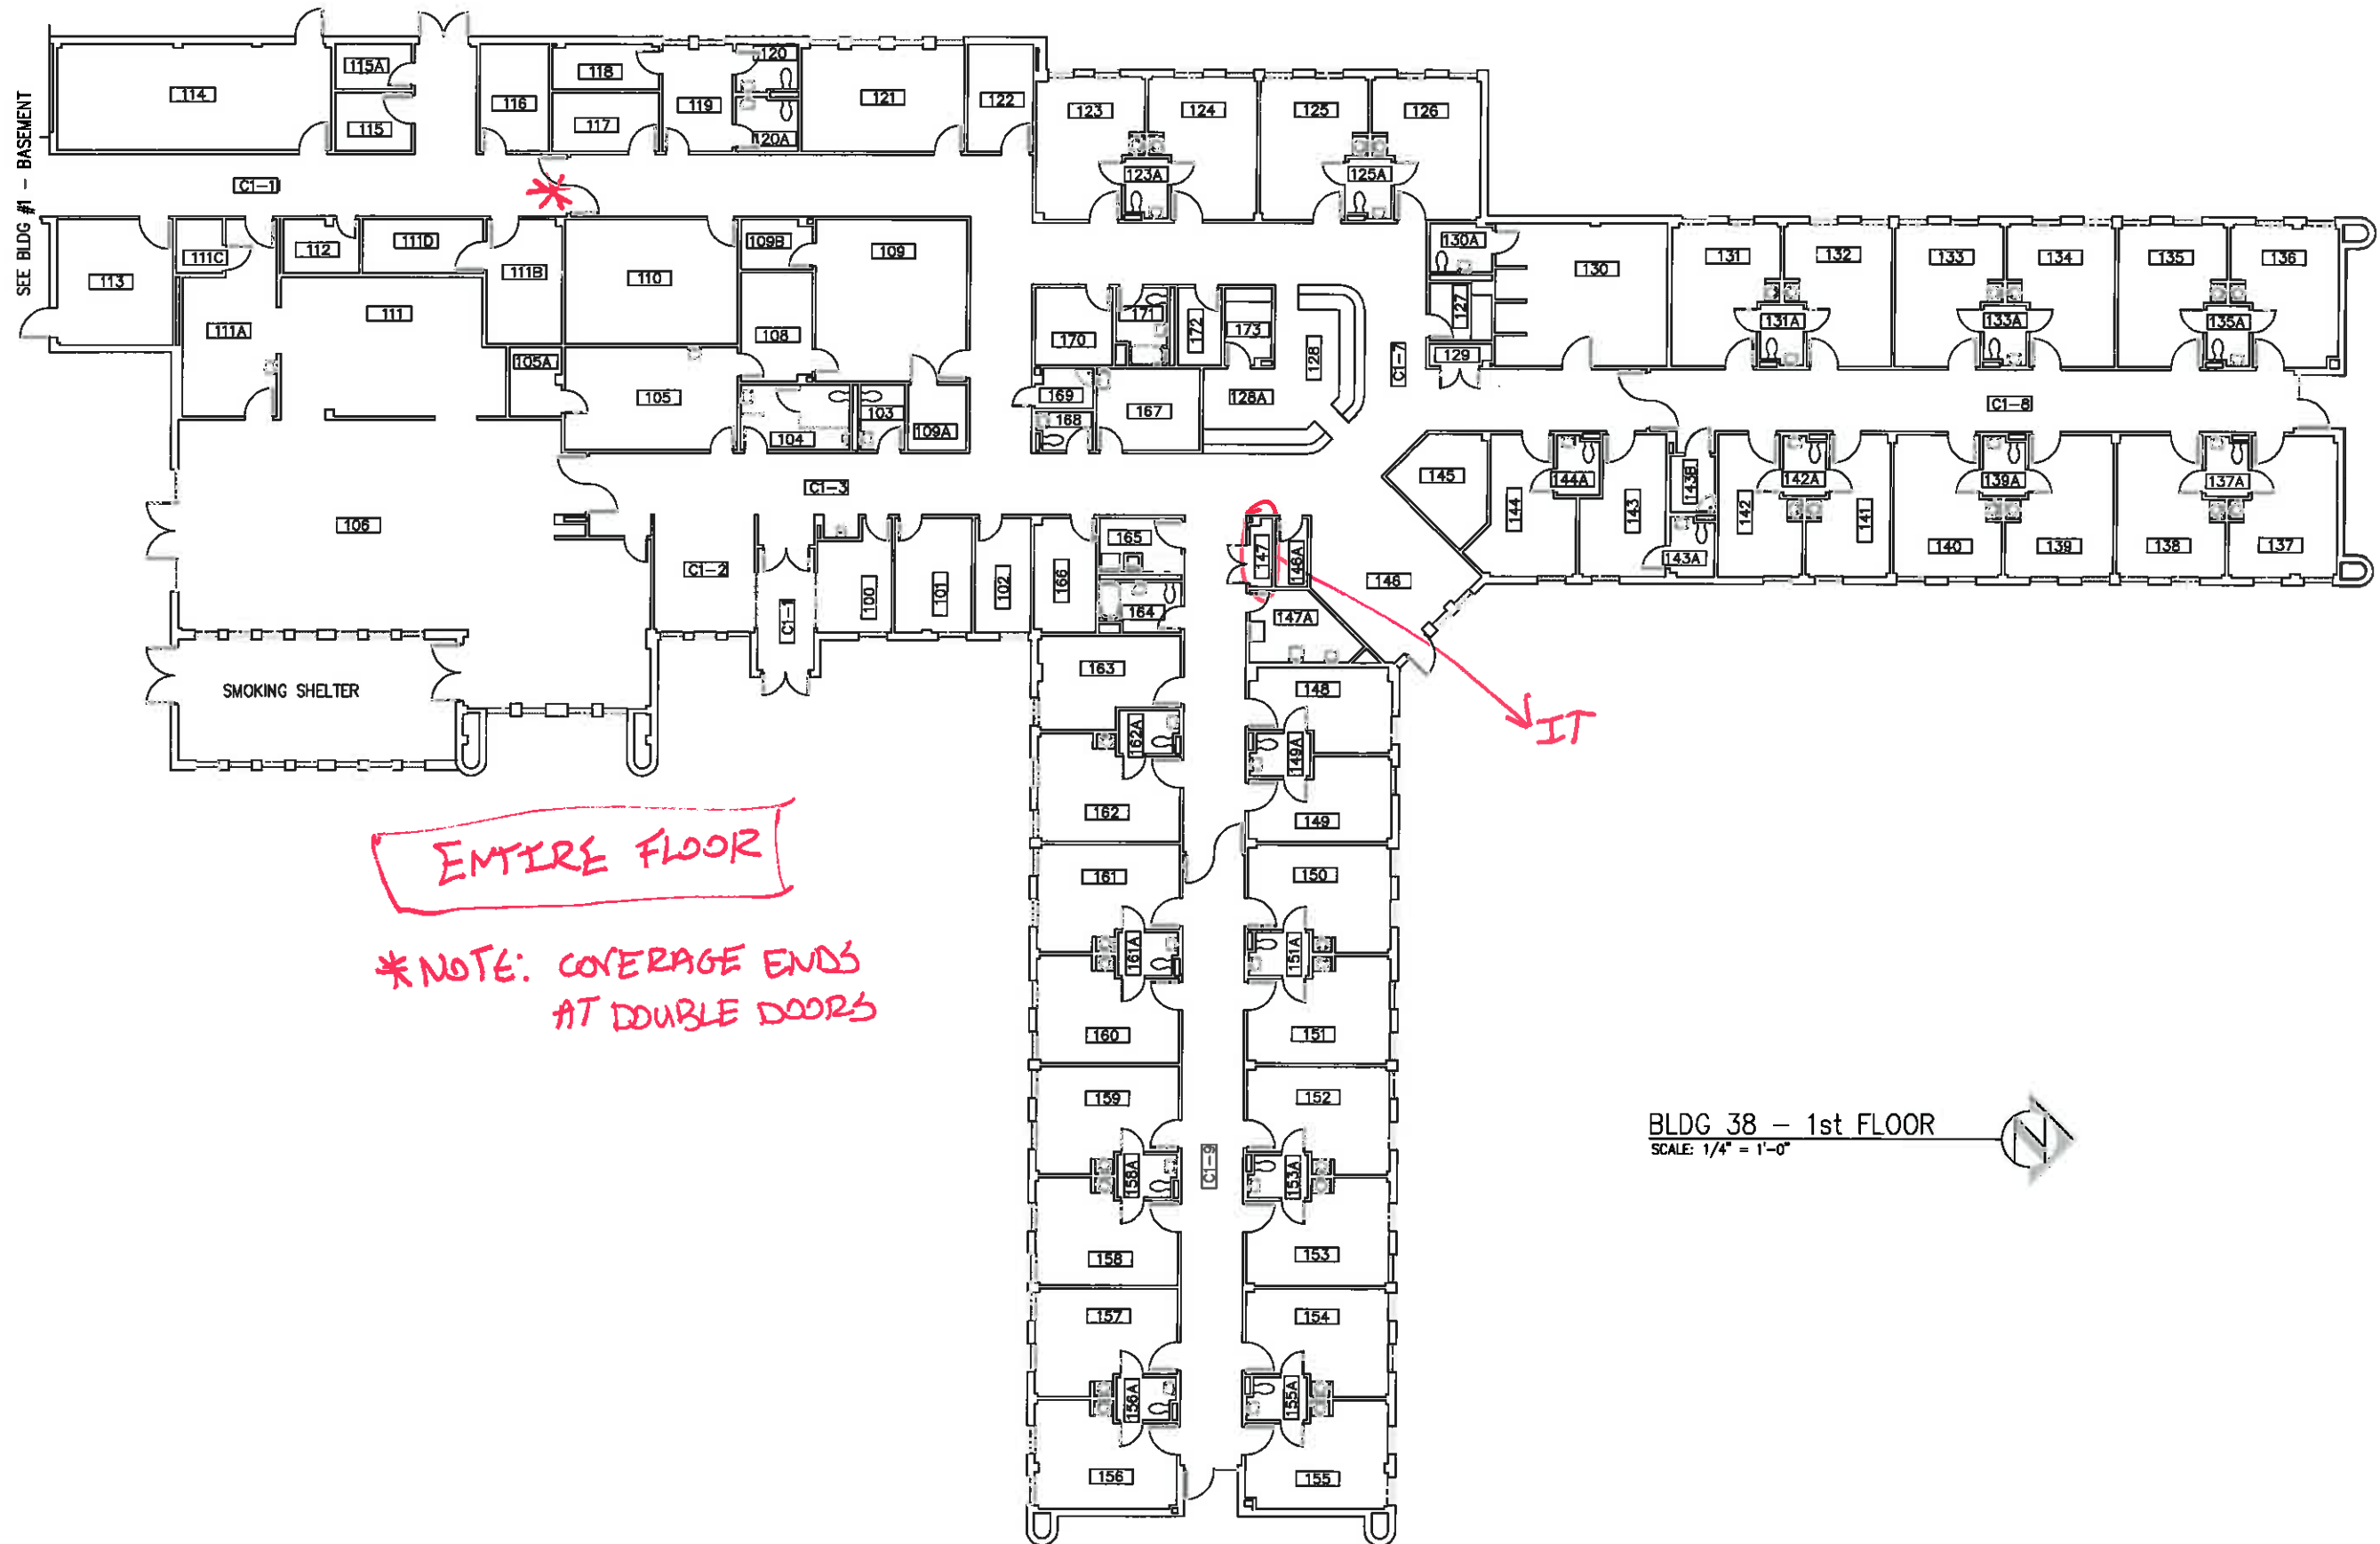

ENTIRE FLOOR

*NOTE: COVERAGE ENDS
AT DOUBLE DOORS

BLDG 38 - 1st FLOOR
SCALE: 1/4" = 1'-0"

