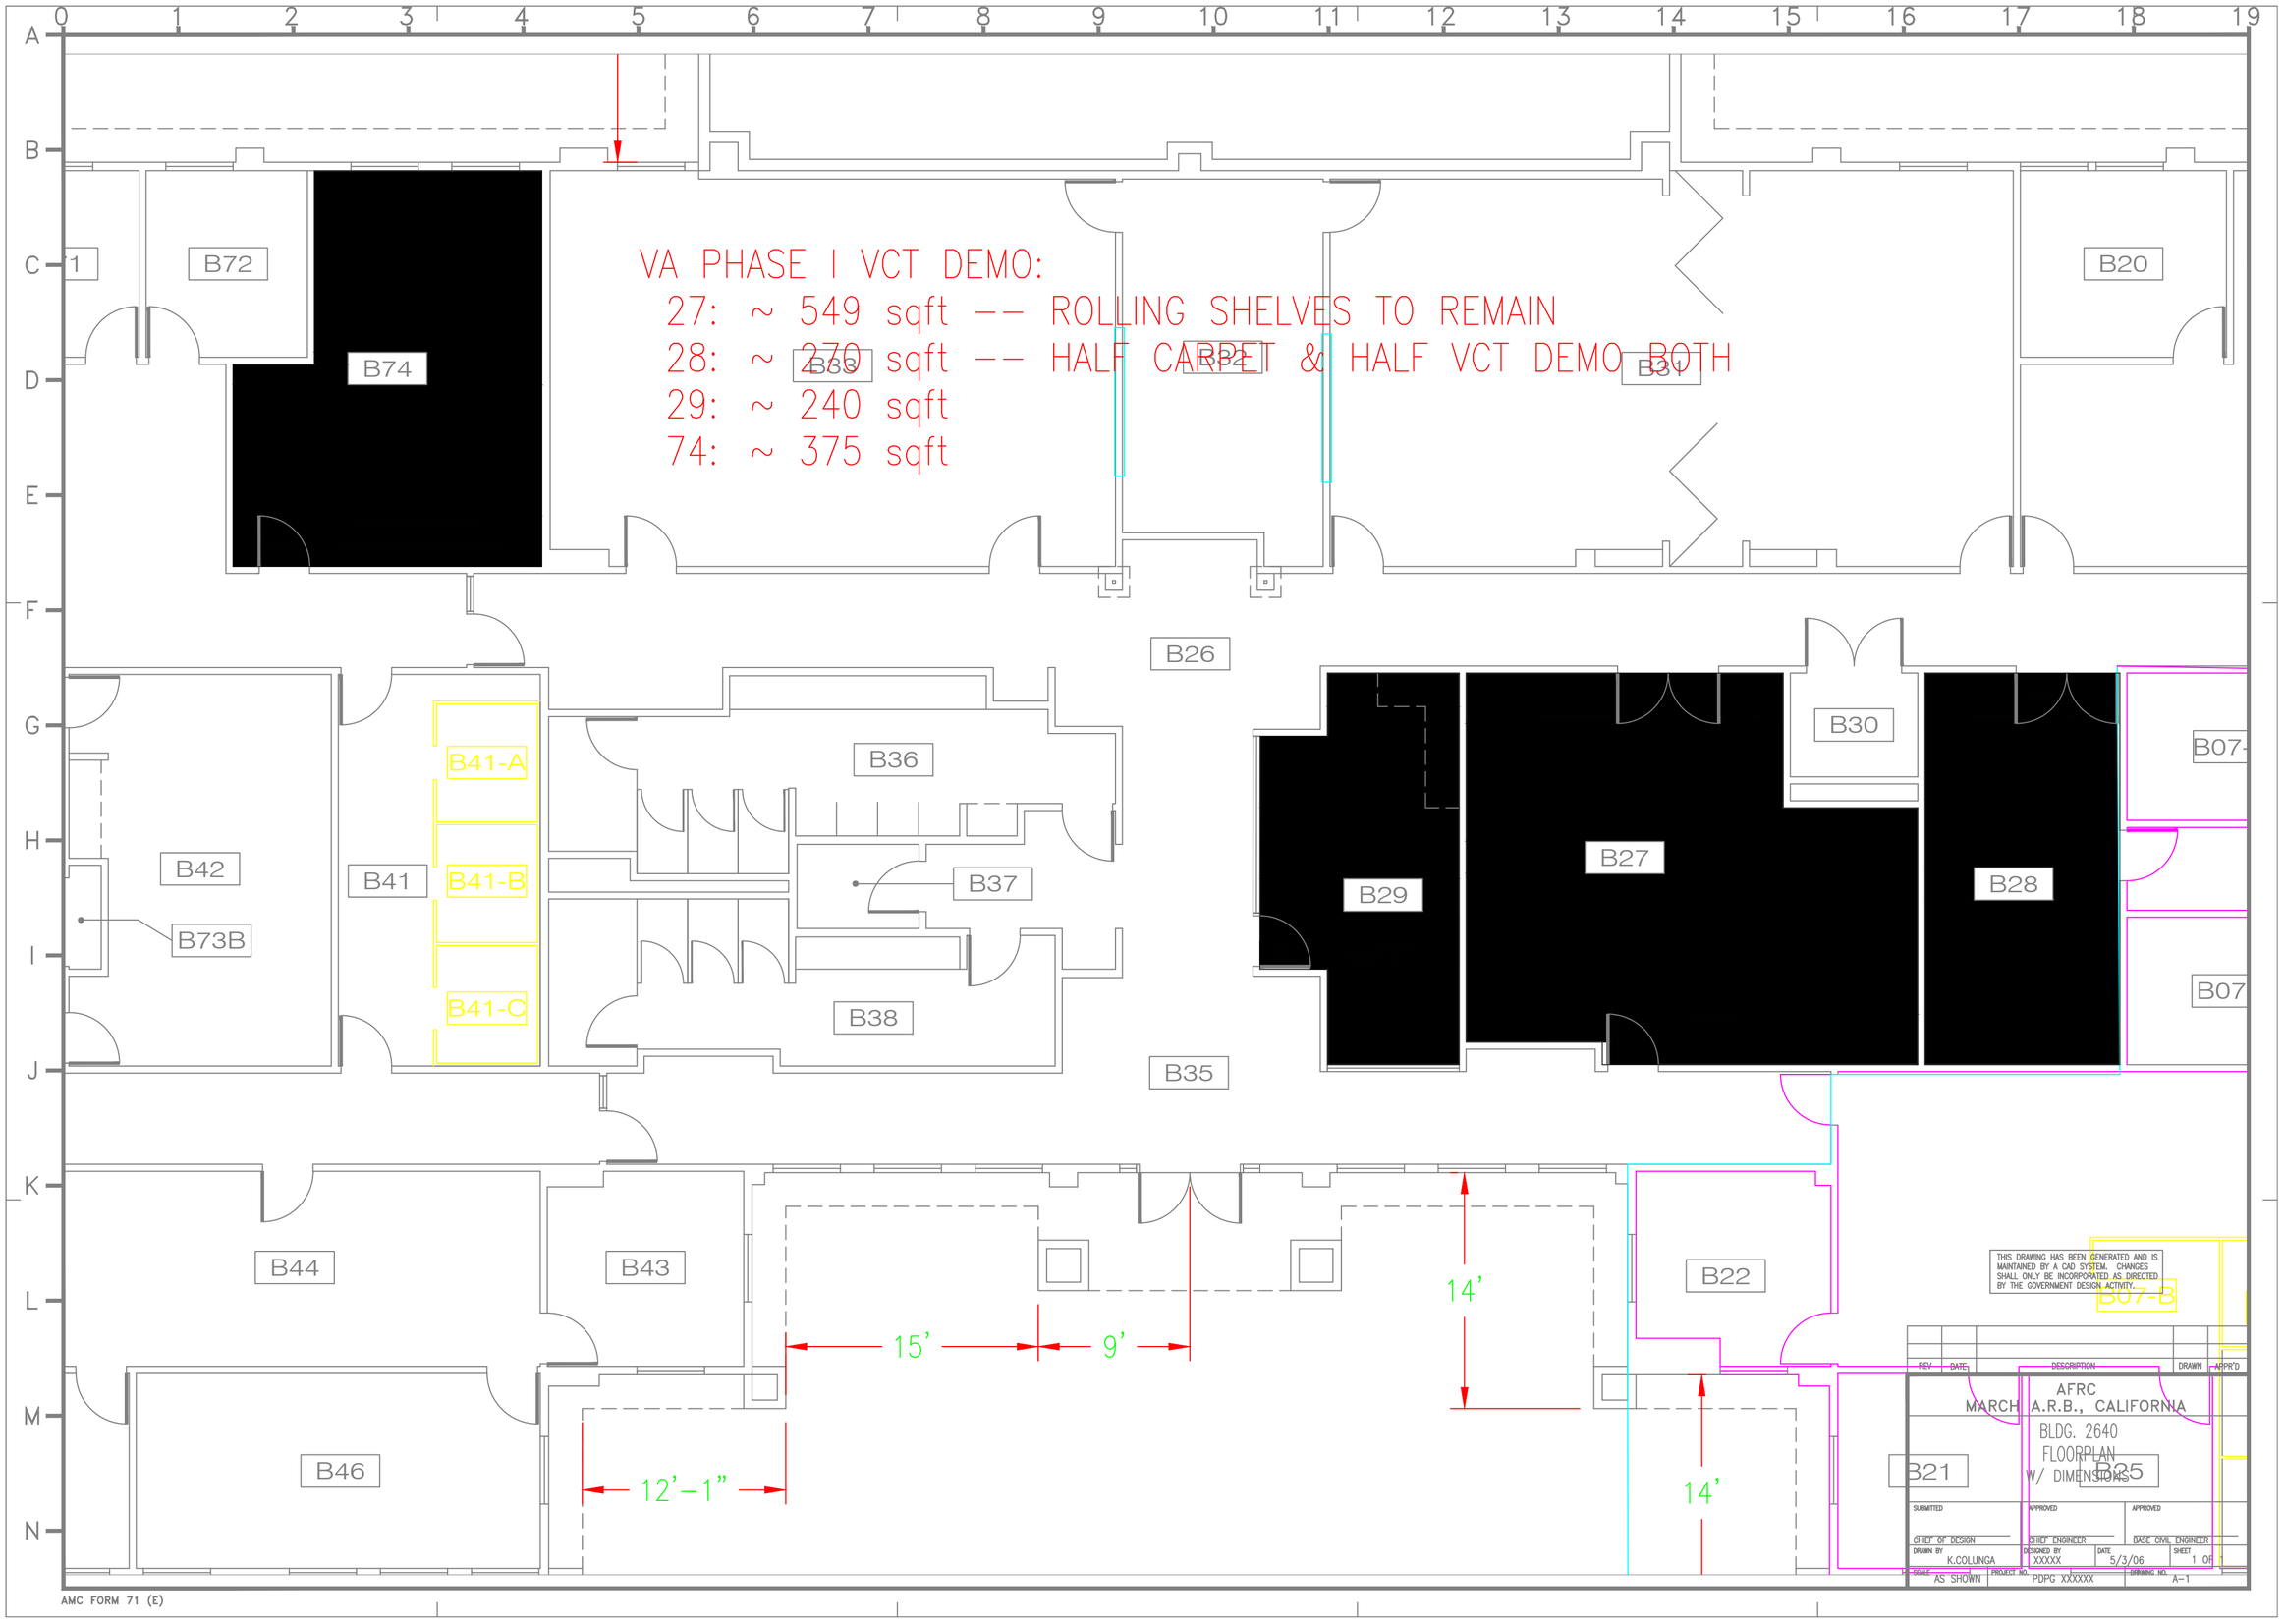
VA PHASE I VCT DEMO:
27: ~ 549 sqft -- ROLLING SHELVES TO REMAIN
28: ~ 270 sqft -- HALF CARPET & HALF VCT DEMO BOTH
29: ~ 240 sqft
74: ~ 375 sqft
B72
B74
B33
B32
B31
B20
B26
B36
B41-A
B41-B
B41-C
B42
B41
B73B
B37
B38
B35
B29
B27
B30
B28
B07-
B07
B44
B43
B22
B46
B21
B07-B
15'
9'
14'
14'
12'-1"
AFRC
MARCH A.R.B., CALIFORNIA
BLDG. 2640
FLOORPLAN
W/ DIMENSIONS
K.COLUNGA
XXXXX
5/3/06
AS SHOWN
PDPG XXXXXX
A-1
AMC FORM 71 (E)