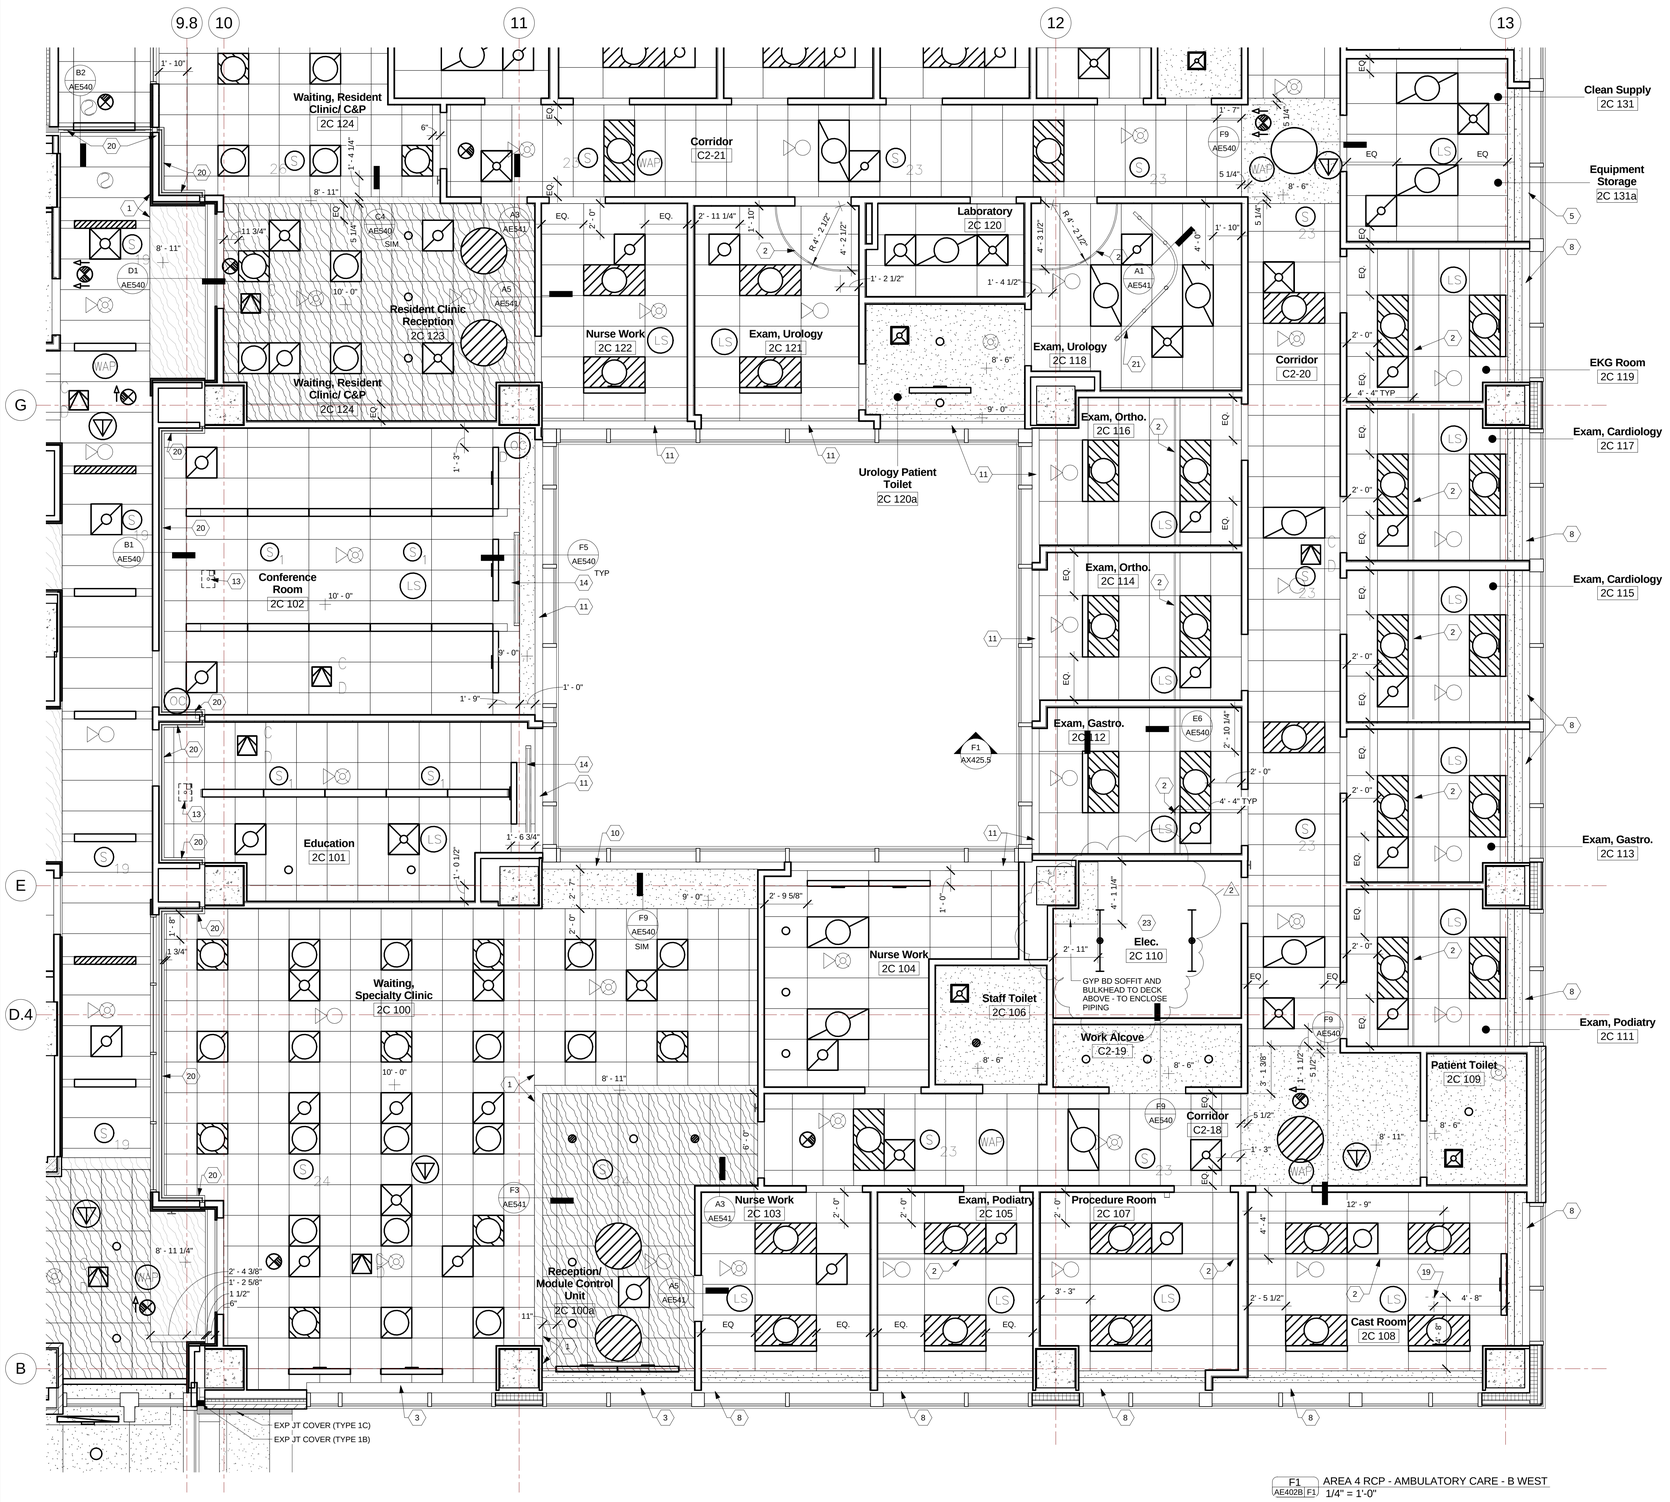

F1 AE402B F1 AREA 4 RCP - AMBULATORY CARE - B WEST
1/4" = 1'-0"

GENERAL RCP NOTES:

A. CEILINGS HEIGHTS AT 9'-0" AFF UNO.
B. SEE THIS SHEET AND AE001 FOR REFLECTED CEILING PLAN LEGEND.
C. DIMENSIONS ARE TO FACE OF GYP BD UNO.
D. MECHANICAL, ELECTRICAL, PLUMBING, TECHNOLOGY, FIRE ALARM AND FIRE PROTECTION SYMBOLS SHOWN ARE FOR COORDINATION PURPOSES ONLY AND DOES NOT REPRESENT THE SCOPE OF MECHANICAL, ELECTRICAL, PLUMBING, TECHNOLOGY, FIRE ALARM AND FIRE PROTECTION WORK. REFER TO THE APPLICABLE DISCIPLINE'S CONTRACT DOCUMENTS FOR MECHANICAL, ELECTRICAL, PLUMBING, TECHNOLOGY, FIRE ALARM AND FIRE PROTECTION WORK.
E. PROVIDE ACCESS PANELS IN HARD CEILINGS AS REQUIRED COORDINATE LOCATIONS WITH MECHANICAL, ELECTRICAL, PLUMBING & FIRE PROTECTION DRAWINGS.
F. PROVIDE SIESMIC RESTRAINT FOR SUSPENDED CEILINGS. (SEE B7/AE540)
G. LIGHT FIXTURES MOUNTED IN SUSPENDED CEILINGS SHALL BE LOCATED IN CENTERS OF CEILING PANELS UNLESS NOTED OTHERWISE.

FIRE PROTECTION SYMBOL LIST

SYMBOL:	DESCRIPTION:
●	CHROME RECESSED SPRINKLER
●	AUTOMATIC SPRINKLER SYSTEM COMPLYING WITH ICC -ES EVALUATION REPORT ESR-2397
	BRASS UPRIGHT SPRINKLER
	CORROSION RESISTANT BRASS UPRIGHT SPRINKLER
	BRASS HORIZONTAL SIDEWALL SPRINKLER
	CHROME HORIZONTAL SIDEWALL SPRINKLER
P	PHOTOELECTRIC SMOKE DETECTOR
HD	HEAT DETECTOR
	CEILING MOUNTED VISUAL APPLIANCE
	CEILING MOUNTED SPEAKER/VISUAL APPLIANCE
	CEILING MOUNTED SPEAKER APPLIANCE

KEYED NOTES - RCP

1 ALIGN
2 CUBICLE CURTAIN TRACK (SEE E6/AE540).
3 RECESSED SHADE (MOTORIZED) (SEE SCHEDULE OF FINISHES 090600)
4 RECESSED SHADE (NON-MOTORIZED) (SEE SCHEDULE OF FINISHES 090600)
5 SURFACE MOUNTED SHADE (NON-MOTORIZED) (SEE SCHEDULE OF FINISHES 090600)
6 SURFACE MOUNTED SHADE w/ (MOTORIZED) BLACK-OUT (SEE SCHEDULE OF FINISHES 090600)
7 SECURITY GRILLE (SEE SHEET AE641)
8 SURFACE MOUNTED DOUBLE SHADE (NON-MOTORIZED) (SEE SCHEDULE OF FINISHES 090600)
9 SURFACE MOUNTED DOUBLE SHADE (MOTORIZED) (SEE SCHEDULE OF FINISHES 090600)
10 RECESSED DOUBLE SHADE (MOTORIZED) (SEE SCHEDULE OF FINISHES 090600)
11 RECESSED DOUBLE SHADE (NON-MOTORIZED) (SEE SCHEDULE OF FINISHES 090600)
12 SURFACE MOUNTED SHADE (MOTORIZED) (SEE SCHEDULE OF FINISHES 090600)
13 CEILING MOUNTED MULTIMEDIA / DATA PROJECTOR (SEE E3/AE541)
14 RECESSED RETRACTABLE PROJECTION SCREEN (SEE F5/AE540)
15 CEILING TRACK FOR DENTAL OPERATING LIGHT (SEE C1/AE541)
16 OXYGEN & VACUUM OUTLETS - CEILING MOUNTED (SEE PLUMB DWGS)
17 CEILING TRACKS FOR RADIOLOGY EQUIPMENT (SEE C3/AE541)
18 EXHAUST FAN
19 CEILING MOUNTED EXAM LIGHT (SEE F5/AE541)
20 EXPANSION JOINT (SEE SHEET A1/AE540)
21 OVERHEAD LIFT (SEE A1/AE541)
22 BRICK SOFFIT (SEE D1/AE531)
23 EXPOSED STRUCTURE ABOVE(SEE STRUCT DWGS)
24 CONCEALED OVERHEAD COILING GRILLE (SEE F8/AE613)
25 CANOPY LIGHT FIXTURE (SEE ELEC DWGS)
26 DECORATIVE EXTERIOR FINISH SYSTEM (DEFS) (SEE F4/AE310)
27 CONTROL JOINT (SEE E4/AE540)
28 CONCEALED OVERHEAD COILING DOOR (SEE F7/AE613)
29 BRICK VENEER (SEE D4/AE531)
30 T & G HARDWOOD (SEE DTLS SHT AE540)
31 FIRE & SMOKE CURTAIN (SEE D6/F8 & E9/AE615)
32 FAN COIL UNIT
33 MECHANICAL UNIT
34 METAL SOFFIT
35 SOFFIT VENT
36 STANDARD SLEEVE (SEE F4/AE310)

MEPT SYMBOLS LIST

SYMBOL:	DESCRIPTION:
	LIGHT FIXTURE, RECESSED FLUORESCENT, 2'x4'
	LIGHT FIXTURE, RECESSED FLUORESCENT, 2'x2'
	LIGHT FIXTURE, RECESSED FLUORESCENT, 6'x4'
	LIGHT FIXTURE, RECESSED FLUORESCENT, 6'x2'
	LIGHT FIXTURE, RECESSED FLUORESCENT, 3'DIA.
	LIGHT FIXTURE, RECESSED DOWNLIGHT, 6"DIA.
	4' INDUSTRIAL LUMINAIRE
	LIGHTING, TWO HEAD EMERGENCY BATTERY POWER
	NOTE: CROSSHATCHING INDICATES LUMINAIRE IS CONNECTED TO AN EMERGENCY CIRCUIT
	EXIT SIGN, CEILING MOUNTED
x	PHOTO CELL
x	DAYLIGHT SENSOR
x	OCCUPANCY SENSOR
	RECEPTACLE, DUPLEX
	MOTION DETECTOR CEILING MOUNTED
	SPEAKER CEILING MOUNTED
	CONNECTION FOR OFOI CAMERA
	WIRELESS ACCESS POINT
	FCU WITH STAMPED FACE RETURN
	LINEAR SUPPLY DIFFUSER (OR RETURN)
	2'X4' RADIANT CEILING PANEL
	SUPPLY DIFFUSER
	RETURN GRILLE OR REGISTER
	EXHAUST GRILLE OR REGISTER
	CEILING MOUNTED PROJECTOR
	UNIT HEATER

2
AREA 1 | AREA 2 | AREA 3 | AREA 4 | AREA 5
NORTH

FULLY SPRINKLERED

No.	Date	Revisions
2	6/18/15	RFI 410
1	4/10/2013	Amendment #5

CONSULTANTS:

STRUCTURAL ENGINEER:
KPFF CONSULTING ENGINEERS
1630 DES PERES ROAD, SUITE 100
ST. LOUIS, MO 63131
PHONE: (314) 835-0524

MECHANICAL/ELECTRICAL/PLUMBING:
KJWW ENGINEERING CONSULTANTS
#15 SUNNEN DRIVE, SUITE 104
ST. LOUIS, MO 63143
PHONE: (314) 645-1132

CODE CONSULTANT/FIRE PROTECTION:
CODE CONSULTANTS, INC.
2043 WOODLAND PARKWAY, SUITE 300
ST. LOUIS, MO 63146
PHONE: (314) 991-2633

CIVIL ENGINEER:
STOCK & ASSOCIATES CONSULTING ENGINEERS, INC.
257 CHESTERFIELD BUSINESS PARKWAY
CHESTERFIELD, MO 63005
PHONE: (636) 530-9100

AUTOMATIC TRANSPORT:
LERCH BATES INC.
8089 S. LINCOLN STREET, SUITE 207
LITTLETON, CO 80122
PHONE: (720) 283-8182

ESTIMATING:
KWAME BUILDING GROUP, INC.
1204 WASHINGTON AVENUE, SUITE 200
ST. LOUIS, MO 63103
PHONE: (314) 862-5344

HAZARDOUS MATERIALS:
ALTEC ENVIRONMENTAL CONSULTING, LLC
P.O. BOX 17867
SHREVEPORT, LA 71138-0867
PHONE: (318) 687-3771

IRRIGATION CONSULTANT:
IRM
9502 BANYON TREE
ST. LOUIS, MO 63126
PHONE: (314) 610-4200

CERTIFICATE OF AUTHORITY: 000842

STATE OF MISSOURI
DANIEL G. WAY
NUMBER A-4419
REGISTERED ARCHITECT

ARCHITECT:

CHRISTNER
ARCHITECTS | DESIGNERS | PLANNERS | LANDSCAPE ARCHITECTS
168 N. MERAMEC AVENUE | ST. LOUIS, MISSOURI 63105
TEL 314 725 2927 | FAX 314 725 2928 | CHRISTNERINC.COM

THE SEAL (S) AND SIGNATURE(S) APPLY ONLY TO THE DOCUMENT TO WHICH THEY ARE AFFIXED, AND WE EXPRESSLY DISCLAIM ANY RESPONSIBILITY FOR ALL OTHER PLANS, SPECIFICATIONS, ESTIMATES, REPORTS, OR OTHER DOCUMENTS OR INSTRUMENTS RELATING TO OR INTENDED TO BE USED FOR ANY PART OF PARTS OF THE PROJECT.
© COPYRIGHT 2012 CHRISTNER INC.

Drawing Title: SECOND FLOOR - ENLARGED REFLECTED CEILING PLAN - AREA 4
Approved: Project Director
Project Title: CLINIC BUILDING
Location: JEFFERSON BARRACKS DIVISION
Date: 20 JANUARY 2012 | Checked: RJR | Drawn: AVR
Project Number: 657-313D
Building Number: 55
Drawing Number: AE464
DWG 151 OF 219

Office of Construction and Facilities Management
Department of Veterans Affairs