

OSCAR G. JOHNSON VA MEDICAL CENTER – IRON MOUNTAIN, MI
RENOVATE LOADING DOCK
PROJECT # - 585-12-125
SOLICITATION #: VA69D-17-B-0362

ADDENDUM NO. 1
FEBURARY 14, 2017

BID DATE: FEBURARY 21, 2017

The following additions, deletions, modifications, or clarifications shall be made to the appropriate sections of the plans and specifications and shall become part of the Contract Documents. Bidders shall acknowledge receipt of this Addendum in the space provided on the Bid Form.

Technical Specifications

Spec Section 05 40 00, “ Cold Formed Metal Framing” – Add this section

Spec Section 09 91 00, “Painting” – Revise Section 3.9.A to include paint color.

Drawings

GI001 – Modify note on Phasing plan to accept compacted base and subbase material in lieu of asphalt pavement for maintaining temporary access during construction.

AD100 – Modify note for existing compactor to state that VA will remove existing compactor prior to construction and reinstall after completion of Phase.

AE101 – Add General Note #6 regarding morgue cooler. Cooler to be constructed of stainless steel and have a minimum door opening of 42”.

AE500 - “Construction and Roofing Details,” Details #9, #10 and #12.

Add General Detail Notes:

1. Reference Spec Section 05 40 00, “Cold Formed Metal Framing” for 3 5/8” metal stud and hat channels requirements.
2. Provide 3 5/8” metal stud vertical supports for horizontal metal stud framing at each end of studs typical. Provide 3 5/8” metal stud diagonal kickers as required for lateral bracing and stability. All stud framing and hat channels shall be not less than 18 gauge thickness, minimum. Horizontal, vertical and diagonal stud framing

installations shall be a delegated design, by the contractor, as specified to resist the wind loads indicated on Sheet SB-100.

3. All stud framing and hat channels shall be galvanized.

AE502 – Revised paint schedule for interior work. Refer to Specification 09 91 00 – Painting for paint colors.

M200 - Clarification to Detail 5. Extent of mechanical snowmelt system work shall include manifold and 1" GWR and 1" GWS and capped at location shown on M102. Control Panel included as part of this work.

Attachments:

Specification Section:

1. Specifications Sections 05 40 00 - Cold Formed Metal Framing
2. 09 91 00 - Painting

Drawings:

1. GI001
2. AD100
3. AE101
4. AE502
5. M200

END OF ADDENDUM #1

**SECTION 05 40 00
COLD-FORMED METAL FRAMING**

PART 1 - GENERAL

1.1 DESCRIPTION:

A. This section specifies materials and services required for installation of cold-formed steel, including tracks and required accessories as shown and specified. This Section includes the following:

1. Steel joist framing for exterior soffits, support framing and miscellaneous accessories.

1.2 RELATED WORK:

A. Structural steel framing: Section 05 12 00, STRUCTURAL STEEL FRAMING.

1.3 DESIGN REQUIREMENTS:

A. Design steel in accordance with American Iron and Steel Institute Publication "Specification for the Design of Cold-Formed Steel Structural Members", except as otherwise shown or specified.

C. Structural Performance: Engineer, fabricate, and erect cold-formed metal framing to withstand design loads within limits and under conditions required.

1. Design Loads: As indicated on Sheet SB-100.
2. Design framing systems to withstand design loads without deflections greater than the following:
 - a. Exterior Soffit Joist Framing: Vertical deflection of $1/240$ of the span.
3. Design framing systems to provide for movement of framing members without damage or overstressing, sheathing failure, connection failure, undue strain on fasteners and anchors, or other detrimental effects when subject to a maximum ambient temperature change (range) of 67 degrees C (120 degrees F).
4. Design framing system to accommodate deflection of primary building structure and construction tolerances, and to maintain clearances at openings.
5. Engineering Responsibility: Engage a fabricator who assumes undivided responsibility for engineering cold-formed metal framing

by employing a qualified professional engineer to prepare design calculations, shop drawings, and other structural data.

1.4 SUBMITTALS:

- A. Submit in accordance with Section 01 33 23, SHOP DRAWINGS, PRODUCT DATA, AND SAMPLES.
- B. Shop Drawings: Shop and erection drawings showing steel unit layout, connections to supporting members, and information necessary to complete installation as shown and specified.
- C. For cold-formed metal framing indicated to comply with certain design loadings, include structural analysis data sealed and signed by the qualified professional engineer who was responsible for its preparation.

1.5 APPLICABLE PUBLICATIONS:

- A. Publications listed below form a part of this specification to extent referenced. Publications are referenced in text by basic designation only.
- B. American Iron and Steel Institute (AISI):
Specification and Commentary for the Design of Cold-Formed Steel Structural Members (1996)
- C. American Society of Testing and Materials (ASTM):
A36/A36M-08.....Standard Specifications for Carbon Structural Steel
A123/A123M-09.....Standard Specifications for Zinc (Hot-Dip Galvanized) Coatings on Iron and Steel Products
A153/A153M-09.....Standard Specifications for Zinc Coating (Hot-Dip) on Iron and Steel Hardware
A307-10.....Standard Specifications for Carbon Steel Bolts and Studs
A653/A653M-10.....Standard Specifications for Steel Sheet, Zinc-Coated (Galvanized) or Zinc-Iron Alloy-Coated (Galvannealed) by the Hot-Dip Process
C955.....Standard Specification for Load-Bearing (Transverse and Axial) Steel Studs, Runners

(Tracks), and Bracing or Bridging for Screw
Application of Gypsum Panel Products and Metal
Plaster Bases

E488-96 (R2003) Standard Test Methods for Strength of Anchors
in Concrete and Masonry Elements

E1190-95 (R2007) Standard Test Methods for Strength of Power-
Actuated Fasteners Installed in Structural
Members

D. American Welding Society (AWS):

D1.3/D1.3M-08 Structural Welding Code-Sheet Steel

E. Military Specifications (Mil. Spec.):

MIL-P-21035B Paint, High Zinc Dust Content, Galvanizing
Repair

PART 2 - PRODUCTS

2.1 MATERIALS:

A. Sheet Steel for joists, studs and accessories 16 gage and heavier: ASTM
A653, structural steel, zinc coated G90, with a yield of 340 MPa (50
ksi) minimum.

B. Sheet Steel for joists, studs and accessories 18 gage and lighter: ASTM
A653, structural steel, zinc coated G90, with a yield of 230 MPa (33
ksi) minimum.

C. Galvanizing Repair Paint: MIL-P-21035B.

2.2 JOIST FRAMING:

A. Steel Joists: Manufacturer's standard C-shaped steel joists, unpunched,
of web depths indicated, with lipped flanges, and complying with the
following:

1. Minimum Base-Steel Thickness: 1.09 mm (0.0428 inch). Design
Thickness: 1.45 mm (0.0566 inch).

2. Flange Width: 41 mm (1 5/8 inches) minimum.

B. Steel Joist Track: Manufacturer's standard U-shaped steel joist track,
unpunched, of web depths indicated, with straight flanges, and
complying with the following:

1. Design Thickness: Matching steel joists.

2. Flange Width: 41 mm (1 5/8-inches) minimum.

2.4 FRAMING ACCESSORIES:

- A. Fabricate steel framing accessories of the same material and finish used for framing members, with a minimum yield strength of 230 MPa (33 ksi).
- B. Provide accessories of manufacturer's standard thickness and configuration, matching thickness of the joist framing, as follows:
 1. Supplementary framing.
 2. Bracing, bridging, and solid blocking.
 3. Stud kickers and stud hanging supports.
 4. Furring and furring hat channels

2.5 ANCHORS, CLIPS, AND FASTENERS:

- A. Steel Shapes and Clips: ASTM A36, zinc coated by the hot-dip process according to ASTM A123.
- C. Expansion Anchors: Fabricated from corrosion-resistant materials, with capability to sustain, without failure, a load equal to 5 times the design load, as determined by testing per ASTM E488 conducted by a qualified independent testing agency.
- E. Mechanical Fasteners: Corrosion-resistant coated, self-drilling, self-threading steel drill screws. Low-profile head beneath sheathing, manufacturer's standard elsewhere.

2.6 REQUIREMENTS:

- A. Furnish members and accessories by one manufacturer only.

PART 3 - EXECUTION

3.1 FABRICATION:

- A. Cut framing components squarely or as required for attachment. Cut framing members by sawing or shearing; do not torch cut.
- B. Hold members in place until fastened.
- C. Fasten cold-formed metal framing members by screw fastening, as standard with fabricator. Wire tying of framing members is not permitted. Wire tying of miscellaneous hat-channels or furring channels is not permitted.

1. Locate mechanical fasteners and install according to cold-formed metal framing manufacturer's instructions with screw penetrating joined members by not less than 3 exposed screw threads.

3.2 ERECTION:

- A. Provide tracks for support of framing members to adjacent construction and roof structure. Securely anchor tracks to supports as required.
- B. Plumb, align, and securely attach studs to flanges or webs of both upper and lower tracks.
- C. Studs in one piece for their entire length, splices will not be permitted.
- D. Provide a load distribution member at top track where joist is not located directly over bearing stud.
- E. Provide joist bridging where shown.
- F. Provide end blocking where joist ends are not restrained from rotation.
- G. Provide temporary bracing and leave in place until framing is permanently stabilized.
- H. Provide vertical stud hanging supports for horizontal joists at each of the ends of the joists, anchored to the roof structure above. Hanging supports shall resist both gravity loads downward and code specified wind loads upward.
- I. Provide vertical, angled kicker supports from horizontal joists and vertical hanging supports to the roof structure above to brace the assembly. Angled kicker supports shall contribute to resisting both lateral loads sideways and code specified wind loads upward.

3.3 TOLERANCES:

- A. Horizontal alignment (levelness) of walls shall be within 1/320th of their respective lengths.
- B. Spacing of studs shall not be more than 3 mm (1/8 inch) +/- from the designed spacing providing that the cumulative error does not exceed the requirements of the finishing materials.

3.4 FIELD REPAIR:

Touch-up damaged galvanizing with galvanizing repair paint.

- - - E N D - - -

SECTION 09 91 00

PAINTING

PART 1 - GENERAL

1.1 DESCRIPTION

- A. Section specifies field painting.
- B. Section specifies prime coats which may be applied in shop under other sections.
- C. Painting includes coatings specified, and striping or markers and identity markings.

1.2 RELATED WORK

- A. Shop prime painting of steel and ferrous metals: Division 05 - METALS, Division 08 - OPENINGS, Division 21 - FIRE SUPPRESSION, Division 22 - PLUMBING, Division 23 - HEATING, VENTILATION AND AIR-CONDITIONING, Division 26 - ELECTRICAL, Division 27 - COMMUNICATIONS, and Division 28 - ELECTRONIC SAFETY AND SECURITY sections.

1.3 SUBMITTALS

- A. Submit in accordance with Section 01 33 23, SHOP DRAWINGS, PRODUCT DATA, AND SAMPLES.
- B. Manufacturer's Literature and Data:
Before work is started, or sample panels are prepared, submit manufacturer's literature, the current Master Painters Institute (MPI) "Approved Product List" indicating brand label, product name and product code as of the date of contract award, will be used to determine compliance with the submittal requirements of this specification. The Contractor may choose to use subsequent MPI "Approved Product List", however, only one list may be used for the entire contract and each coating system is to be from a single manufacturer. All coats on a particular substrate must be from a single manufacturer. No variation from the MPI "Approved Product List" where applicable is acceptable.
- C. Sample Panels:
 - 1. After painters' materials have been approved and before work is started submit sample panels showing each type of finish and color specified.
 - 2. Panels to show color: Composition board, 4 inch by 10 inch by 1/8 inch.
 - 3. Attach labels to panel stating the following:
 - a. Federal Specification Number or manufacturers name and product number of paints used.
 - b. Product type and color.
 - c. Name of project.

4. Strips showing not less than 2 inch wide strips of undercoats and 4 inch wide strip of finish coat.

1.4 DELIVERY AND STORAGE

- A. Deliver materials to site in manufacturer's sealed container marked to show following:
 1. Name of manufacturer.
 2. Product type.
 3. Batch number.
 4. Instructions for use.
 5. Safety precautions.
- B. In addition to manufacturer's label, provide a label legibly printed as following:
 1. Federal Specification Number, where applicable, and name of material.
 2. Surface upon which material is to be applied.
 3. If paint or other coating, state coat types; prime, body or finish.
- C. Maintain space for storage, and handling of painting materials and equipment in a neat and orderly condition to prevent spontaneous combustion from occurring or igniting adjacent items.
- D. Store materials at site at least 24 hours before using, at a temperature between 65 and 85 degrees F.

1.5 APPLICABLE PUBLICATIONS

- A. Publications listed below form a part of this specification to the extent referenced. Publications are referenced in the text by basic designation only.
- B. American National Standards Institute (ANSI):
A13.1-07.....Scheme for the Identification of Piping Systems
- C. Master Painters Institute (MPI):
No. 1-12.....Aluminum Paint (AP)
No. 4-12.....Interior/ Exterior Latex Block Filler
No. 8-12.....Exterior Alkyd, Flat MPI Gloss Level 1 (EO)
No. 9-12.....Exterior Alkyd Enamel MPI Gloss Level 6 (EO)
No. 10-12.....Exterior Latex, Flat (AE)
No. 11-12.....Exterior Latex, Semi-Gloss (AE)
No. 18-12.....Organic Zinc Rich Primer
No. 22-12.....Aluminum Paint, High Heat (up to 590° - 1100F)(HR)
No. 26-12.....Cementitious Galvanized Metal Primer
No. 43-12.....Interior Satin Latex, MPI Gloss Level 4
No. 44-12.....Interior Low Sheen Latex, MPI Gloss Level 2
No. 45-12.....Interior Primer Sealer
No. 46-12.....Interior Enamel Undercoat
No. 47-12.....Interior Alkyd, Semi-Gloss, MPI Gloss Level 5 (AK)

- No. 48-12.....Interior Alkyd, Gloss, MPI Gloss Level 6 (AK)
- No. 49-12.....Interior Alkyd, Flat, MPI Gloss Level 1 (AK)
- No. 50-12.....Interior Latex Primer Sealer
- No. 51-12.....Interior Alkyd, Eggshell, MPI Gloss Level 3
- No. 52-12.....Interior Latex, MPI Gloss Level 3 (LE)
- No. 53-12.....Interior Latex, Flat, MPI Gloss Level 1 (LE)
- No. 54-12.....Interior Latex, Semi-Gloss, MPI Gloss Level 5 (LE)
- No. 94-12.....Exterior Alkyd, Semi-Gloss (EO)
- No. 95-12.....Fast Drying Metal Primer
- No. 98-12.....High Build Epoxy Coating
- No. 101-12.....Epoxy Anti-Corrosive Metal Primer
- No. 108-12.....High Build Epoxy Coating, Low Gloss (EC)
- No. 114-12.....Interior Latex, Gloss (LE) and (LG)
- No. 119-12.....Exterior Latex, High Gloss (acrylic) (AE)
- No. 135-12.....Non-Cementitious Galvanized Primer
- No. 138-12.....Interior High Performance Latex, MPI Gloss Level 2
(LF)
- No. 139-12.....Interior High Performance Latex, MPI Gloss Level 3
(LL)
- No. 140-12.....Interior High Performance Latex, MPI Gloss Level 4
- No. 141-12.....Interior High Performance Latex (SG) MPI Gloss
Level 5

D. Steel Structures Painting Council (SSPC):

- SSPC SP 1-04 (R2004)....Solvent Cleaning
- SSPC SP 2-04 (R2004)....Hand Tool Cleaning
- SSPC SP 3-04 (R2004)....Power Tool Cleaning

PART 2 - PRODUCTS

2.1 MATERIALS

- A. Interior/Exterior Latex Block Filler: MPI 4.
- B. Exterior Alkyd, Flat (EO): MPI 8.
- C. Exterior Alkyd Enamel (EO): MPI 9.
- D. Exterior Latex, Flat (AE): MPI 10.
- E. Exterior Latex, Semi-Gloss (AE): MPI 11.
- F. Organic Zinc rich Coating (HR): MPI 22.
- G. High Heat Resistant Coating (HR): MPI 22.
- H. Cementitious Galvanized Metal Primer: MPI 26.
- I. Interior Satin Latex: MPI 43.
- J. Interior Low Sheen Latex: MPI 44.
- K. Interior Primer Sealer: MPI 45.
- L. Interior Enamel Undercoat: MPI 47.
- M. Interior Alkyd, Semi-Gloss (AK): MPI 47.

- N. Interior Alkyd, Gloss (AK): MPI 49.
- O. Interior Latex Primer Sealer: MPI 50.
- P. Interior Alkyd, Eggshell: MPI 51
- Q. Interior Latex, MPI Gloss Level 3 (LE): MPI 52.
- R. Interior Latex, Flat, MPI Gloss Level 1 (LE): MPI 53.
- S. Interior Latex, Semi-Gloss, MPI Gloss Level 5 (LE): MPI 54.
- T. Exterior Alkyd, Semi-Gloss (EO): MPI 94.
- U. Fast Drying Metal Primer: MPI 95.
- V. High Build Epoxy Coating: MPI 98.
- W. Interior latex, Gloss (LE) and (LG): MPI 114.
- X. Exterior Latex, High Gloss (acrylic) (AE): MPI 119.
- Y. Waterborne Galvanized Primer: MPI 134.

2.2 PAINT PROPERTIES

- A. Use ready-mixed (including colors), except two component epoxies, polyurethanes, polyesters, paints having metallic powders packaged separately and paints requiring specified additives.
- B. Where no requirements are given in the referenced specifications for primers, use primers with pigment and vehicle, compatible with substrate and finish coats specified.

2.3 REGULATORY REQUIREMENTS/quality assurance

- A. Paint materials shall conform to the restrictions of the local Environmental and Toxic Control jurisdiction.
 - 1. Volatile Organic Compounds (VOC): VOC content of paint materials shall not exceed 10g/l for interior latex paints/primers and 50g/l for exterior latex paints and primers.
 - 2. Lead-Base Paint:
 - a. Comply with Section 410 of the Lead-Based Paint Poisoning Prevention Act, as amended, and with implementing regulations promulgated by Secretary of Housing and Urban Development.
 - b. Regulations concerning prohibition against use of lead-based paint in federal and federally assisted construction, or rehabilitation of residential structures are set forth in Subpart F, Title 24, Code of Federal Regulations, Department of Housing and Urban Development.
 - 3. Asbestos: Materials shall not contain asbestos.
 - 4. Chromate, Cadmium, Mercury, and Silica: Materials shall not contain zinc-chromate, strontium-chromate, Cadmium, mercury or mercury compounds or free crystalline silica.
 - 5. Human Carcinogens: Materials shall not contain any of the ACGIH-BKLT and ACGHI-DOC confirmed or suspected human carcinogens.
 - 6. Use high performance acrylic paints in place of alkyd paints, where possible.

7. VOC content for solvent-based paints shall not exceed 250g/l and shall not be formulated with more than one percent aromatic hydro carbons by weight.

PART 3 - EXECUTION

3.1 JOB CONDITIONS

- A. Safety: Observe required safety regulations and manufacturer's warning and instructions for storage, handling and application of painting materials.
 1. Take necessary precautions to protect personnel and property from hazards due to falls, injuries, toxic fumes, fire, explosion, or other harm.
 2. Deposit soiled cleaning rags and waste materials in metal containers approved for that purpose. Dispose of such items off the site at end of each days work.
- B. Atmospheric and Surface Conditions:
 1. Do not apply coating when air or substrate conditions are:
 - a. Less than 5 degrees F above dew point.
 - b. Below 50 degrees F or over 95 degrees F, unless specifically pre-approved by the Contracting Officer and the product manufacturer. Under no circumstances shall application conditions exceed manufacturer recommendations.
 2. Maintain interior temperatures until paint dries hard.
 3. Do no exterior painting when it is windy and dusty.
 4. Do not paint in direct sunlight or on surfaces that the sun will soon warm.

3.2 SURFACE PREPARATION

- A. Method of surface preparation is optional, provided results of finish painting produce solid even color and texture specified with no overlays.
- B. General:
 1. Remove prefinished items not to be painted such as lighting fixtures, escutcheon plates, hardware, trim, and similar items for reinstallation after paint is dried.
 2. Remove items for reinstallation and complete painting of such items and adjacent areas when item or adjacent surface is not accessible or finish is different.
 3. See other sections of specifications for specified surface conditions and prime coat.
 4. Clean surfaces for painting with materials and methods compatible with substrate and specified finish. Remove any residue remaining from cleaning agents used. Do not use solvents, acid, or steam on concrete and masonry.

C. Ferrous Metals:

1. Remove oil, grease, soil, drawing and cutting compounds, flux and other detrimental foreign matter in accordance with SSPC-SP 1 (Solvent Cleaning).
2. Remove loose mill scale, rust, and paint, by hand or power tool cleaning, as defined in SSPC-SP 2 (Hand Tool Cleaning) and SSPC-SP 3 (Power Tool Cleaning). Exception: where high temperature aluminum paint is used, prepare surface in accordance with paint manufacturer's instructions.
3. Fill dents, holes and similar voids and depressions in flat exposed surfaces of hollow steel doors and frames, access panels, roll-up steel doors and similar items specified to have semi-gloss or gloss finish with TT-F-322D (Filler, Two-Component Type, For Dents, Small Holes and Blow-Holes). Finish flush with adjacent surfaces.
 - a. This includes flat head countersunk screws used for permanent anchors.
 - b. Do not fill screws of item intended for removal such as glazing beads.
4. Spot prime abraded and damaged areas in shop prime coat which expose bare metal with same type of paint used for prime coat. Feather edge of spot prime to produce smooth finish coat.
5. Spot prime abraded and damaged areas which expose bare metal of factory finished items with paint as recommended by manufacturer of item.

D. Zinc-Coated (Galvanized) Metal, Surfaces Specified Painted:

1. Clean surfaces to remove grease, oil and other deterrents to paint adhesion in accordance with SSPC-SP 1 (Solvent Cleaning).
2. Spot coat abraded and damaged areas of zinc-coating which expose base metal on hot-dip zinc-coated items with MPI 18 (Organic Zinc Rich Coating). Prime or spot prime with MPI 134 (Waterborne Galvanized Primer) or MPI 135 (Non- Cementitious Galvanized Primer) depending on finish coat compatibility.

E. Masonry, Concrete, Cement Board, Cement Plaster and Stucco:

1. Clean and remove dust, dirt, oil, grease efflorescence, form release agents, laitance, and other deterrents to paint adhesion.
2. Use emulsion type cleaning agents to remove oil, grease, paint and similar products. Use of solvents, acid, or steam is not permitted.
3. Remove loose mortar in masonry work.
4. Replace mortar and fill open joints, holes, cracks and depressions with new mortar specified in Section 04 05 13, MASONRY MORTARING and Section 04 05 16, MASONRY GROUTING. Do not fill weep holes. Finish to match adjacent surfaces.

5. Neutralize Concrete floors to be painted by washing with a solution of 1.4 Kg (3 pounds) of zinc sulfate crystals to 3.8 L (1 gallon) of water, allow to dry three days and brush thoroughly free of crystals.
6. Repair broken and spalled concrete edges with concrete patching compound to match adjacent surfaces as specified in CONCRETE Sections. Remove projections to level of adjacent surface by grinding or similar methods.

F. Gypsum Plaster and Gypsum Board:

1. Remove efflorescence, loose and chalking plaster or finishing materials.
2. Remove dust, dirt, and other deterrents to paint adhesion.
3. Fill holes, cracks, and other depressions with CID-A-A-1272A [Plaster, Gypsum (Spackling Compound) finished flush with adjacent surface, with texture to match texture of adjacent surface. Patch holes over 25 mm (1-inch) in diameter as specified in Section for plaster or gypsum board.

3.3 PAINT PREPARATION

- A. Thoroughly mix painting materials to ensure uniformity of color, complete dispersion of pigment and uniform composition.
- B. Do not thin unless necessary for application and when finish paint is used for body and prime coats. Use materials and quantities for thinning as specified in manufacturer's printed instructions.
- C. Remove paint skins, then strain paint through commercial paint strainer to remove lumps and other particles.
- D. For tinting required to produce exact shades specified, use color pigment recommended by the paint manufacturer.

3.4 APPLICATION

- A. Start of surface preparation or painting will be construed as acceptance of the surface as satisfactory for the application of materials.
- B. Unless otherwise specified, apply paint in three coats; prime, body, and finish. When two coats applied to prime coat are the same, first coat applied over primer is body coat and second coat is finish coat.
- C. Apply each coat evenly and cover substrate completely.
- D. Allow not less than 48 hours between application of succeeding coats, except as allowed by manufacturer's printed instructions, and approved by Resident Engineer.
- E. Finish surfaces to show solid even color, free from runs, lumps, brushmarks, laps, holidays, or other defects.
- F. Apply by brush, roller or spray, except as otherwise specified.
- G. Do not spray paint in existing occupied spaces unless approved by Resident Engineer, except in spaces sealed from existing occupied spaces.

1. Apply painting materials specifically required by manufacturer to be applied by spraying.
 2. In areas, where paint is applied by spray, mask or enclose with polyethylene, or similar air tight material with edges and seams continuously sealed including items specified in WORK NOT PAINTED, motors, controls, telephone, and electrical equipment, fronts of sterilizes and other recessed equipment and similar prefinished items.
- H. Do not paint in closed position operable items such as access doors and panels, window sashes, overhead doors, and similar items except overhead roll-up doors and shutters.

3.5 PRIME PAINTING

- A. After surface preparation prime surfaces before application of body and finish coats, except as otherwise specified.
- B. Spot prime and apply body coat to damaged and abraded painted surfaces before applying succeeding coats.
- C. Additional field applied prime coats over shop or factory applied prime coats are not required except for exterior exposed steel apply an additional prime coat.
- D. Metals except boilers, incinerator stacks, and engine exhaust pipes:
 1. Steel and iron: // MPI 95 (Fast Drying Metal Primer) //.
 2. Zinc-coated steel and iron: // MPI 134 (Waterborne Galvanized Primer) // MPI 135 (Non-Cementitious Galvanized Primer) //.
 3. Asphalt coated metal: MPI 1 (Aluminum Paint (AP)).
- E. Gypsum Board:
 1. Surfaces scheduled to have MPI 11 (Exterior Latex, Semi-Gloss (AE)) or MPI 54 (Interior Latex, Semi-Gloss, MPI Gloss Level 5 (LE)).
 2. Primer: MPI 50 (Interior Latex Primer Sealer).
 3. Surfaces scheduled to receive vinyl coated fabric wallcovering:
 4. Use MPI 45 (Interior Primer Sealer) // MPI 46 (Interior Enamel Undercoat).
- F. Concrete Masonry Units except glazed or integrally colored and decorative units:
 1. MPI 4 (Block Filler) on interior surfaces.
 2. Prime exterior surface as specified for exterior finishes.

3.6 EXTERIOR FINISHES

- A. Apply following finish coats where specified.
- B. Steel and Ferrous Metal:
 1. Two coats of MPI 8 (Exterior Alkyd, Flat (EO)) // MPI 9 (Exterior Alkyd Enamel (EO)) // MPI 94 (Exterior Alkyd, Semi-Gloss (EO)) on exposed surfaces, except on surfaces over 94 degrees C (200 degrees F).

C. Concrete Masonry Units:

1. General:

- a. Mix as specified in manufacturer's printed directions.
 - b. Do not mix more paint at one time than can be used within four hours after mixing. Discard paint that has started to set.
 - c. Dampen warm surfaces above 75 degrees F with fine mist of water before application of paint. Do not leave free water on surface.
 - d. Cure paint with a fine mist of water as specified in manufacturer's printed instructions.
2. Use two coats of TT-P-1411 (Paint, Co-polymer-Resin, Cementitious (CEP)), unless specified otherwise.

3.7 INTERIOR FINISHES

A. Apply following finish coats over prime coats in spaces or on surfaces specified.

B. Metal Work:

1. Apply to exposed surfaces.
2. Omit body and finish coats on surfaces concealed after installation except electrical conduit containing conductors over 600 volts and bar joist s and metal decks.
3. Ferrous Metal, Galvanized Metal, and Other Metals Scheduled:
 - a. Apply two coats of MPI 47 (Interior Alkyd, Semi-Gloss (AK)) unless specified otherwise.

C. Gypsum Board:

1. One coat of MPI 45 (Interior Primer Sealer) plus one coat of MPI 139 (Interior High Performance Latex, MPI Gloss level 3 (LL)).

D. Masonry and Concrete Walls:

1. Over MPI 4 (Interior/Exterior Latex Block Filler) on CMU surfaces.
2. Two coats of MPI 139 (Interior High Performance Latex, MPI Gloss level 3 (LL)).

3.8 REFINISHING EXISTING PAINTED SURFACES

- A. Clean, patch and repair existing surfaces as specified under surface preparation.
- B. Remove and reinstall items as specified under surface preparation.
- C. Remove existing finishes or apply separation coats to prevent non compatible coatings from having contact.
- D. Patched or Replaced Areas in Surfaces and Components: Apply spot prime and body coats as specified for new work to repaired areas or replaced components.
- E. Except where scheduled for complete painting apply finish coat over plane surface to nearest break in plane, such as corner, reveal, or frame.

- F. Refinish areas as specified for new work to match adjoining work unless specified or scheduled otherwise.
- G. Sand or dull glossy surfaces prior to painting.
- H. Sand existing coatings to a feather edge so that transition between new and existing finish will not show in finished work.

3.9 PAINT COLOR

- A. Color:
 - 1. PT-1, SW-3238 WHITE ROCK
 - 2. PT-2, SW-7038 TONY TAUPE
- B. Coat Colors:
 - 1. Color of priming coat: Lighter than body coat.
 - 2. Color of body coat: Lighter than finish coat.
 - 3. Color prime and body coats to not show through the finish coat and to mask surface imperfections or contrasts.

3.10 MECHANICAL AND ELECTRICAL WORK FIELD PAINTING SCHEDULE

- A. Field painting of mechanical and electrical consists of cleaning, touching-up abraded shop prime coats, and applying prime, body and finish coats to materials and equipment if not factory finished in space scheduled to be finished.
- B. Paint various systems specified in Division 21 - FIRE SUPPRESSION, Division 22 - PLUMBING, Division 23 - HEATING, VENTILATION AND AIR-CONDITIONING, Division 26 - ELECTRICAL, Division 27 - COMMUNICATIONS, and Division 28 - ELECTRONIC SAFETY AND SECURITY.
- C. Paint after tests have been completed.
- D. Omit prime coat from factory prime-coated items.
- E. Finish painting of mechanical and electrical equipment is not required when located in interstitial spaces, above suspended ceilings, in concealed areas such as pipe and electric closets, pipe basements, pipe tunnels, trenches, attics, roof spaces, shafts and furred spaces except on electrical conduit containing feeders 600 volts or more.
- F. Color:
 - 1. Paint items having no color specified to match surrounding surfaces.
 - 2. Paint colors as specified for the following:
 - a. WhiteExterior unfinished surfaces of enameled plumbing fixtures. Insulation coverings on breeching and uptake inside boiler house, drums and drum-heads, oil heaters, condensate tanks and condensate piping.
 - b. Gray:Heating, ventilating, air conditioning and refrigeration equipment (except as required to match surrounding surfaces), and water and sewage treatment equipment and sewage ejection equipment.

- c. Federal Safety Red: Exposed fire protection piping hydrants, post indicators, electrical conducts containing fire alarm control wiring, and fire alarm equipment.
- d. Color to match brickwork sheet metal covering on breeching outside of exterior wall of boiler house.
- G. Apply paint systems on properly prepared and primed surface as follows:
 - 1. Exterior Locations:
 - a. Apply two coats of MPI 94 (Exterior Alkyd, Semi-gloss (EO)) to the following ferrous metal items:
 - b. Apply two coats of MPI 11 (Exterior Latex, Semi Gloss (AE)) to the following metal items:
Galvanized and zinc-copper alloy metal.
 - 2. Interior Locations:
 - a. Apply two coats of MPI 47 (Interior Alkyd, Semi-Gloss (AK)) to following items:
 - 1) Metal under 200 degrees F of items such as bare piping, fittings, hangers and supports.
 - 2) Equipment and systems such as hinged covers and frames for control cabinets and boxes, cast-iron radiators, electric conduits and panel boards.
 - 3) Heating, ventilating, air conditioning, plumbing equipment, and machinery having shop prime coat and not factory finished.

3.11 BUILDING AND STRUCTURAL WORK FIELD PAINTING

- A. Painting and finishing of interior and exterior work except as specified under paragraph 3.11 B.
 - 1. Painting and finishing of new and existing work.
 - 2. Painting of disturbed, damaged and repaired or patched surfaces when entire space is not scheduled for complete repainting or refinishing.
 - 3. Painting of ferrous metal and galvanized metal.
 - 4. Identity painting and safety painting.
- B. Building and Structural Work not Painted:
 - 1. Finished surfaces:
 - a. Hardware except ferrous metal.
 - b. Signs, fixtures, and other similar items integrally finished.
 - 2. Concealed surfaces:
 - a. Inside interstitial spaces, pipe basements, crawl spaces, pipe tunnels, above ceilings, attics, except as otherwise specified.
 - b. Inside walls or other spaces behind access doors or panels.
 - c. Surfaces concealed behind permanently installed casework and equipment.
 - 3. Moving and operating parts:

- a. Shafts, chains, gears, mechanical and electrical operators, linkages, and sprinkler heads, and sensing devices.
 - b. Tracks for overhead or coiling doors, shutters, and grilles.
4. Labels:
- a. Code required label, such as Underwriters Laboratories Inc., Inchcape Testing Services, Inc., or Factory Mutual Research Corporation.
 - b. Identification plates, instruction plates, performance rating, and nomenclature.
5. Galvanized metal:
- a. Except where specifically specified to be painted.
6. Metal safety treads and nosings.
7. Gaskets.
8. Concrete curbs, gutters, pavements, retaining walls, exterior exposed foundations walls and interior walls in pipe basements.
9. Face brick.
10. Structural steel encased in concrete, masonry, or other enclosure.
11. Structural steel to receive sprayed-on fire proofing.
12. Ceilings, walls, columns in interstitial spaces.
13. Ceilings, walls, and columns in pipe basements.

3.12 IDENTITY PAINTING SCHEDULE

- A. Identify designated service in accordance with ANSI A13.1, unless specified otherwise, on exposed piping, piping above removable ceilings, piping in accessible pipe spaces, interstitial spaces, and piping behind access panels.
- 1. Legend may be identified using 2.1 G options or by stencil applications.
 - 2. Apply legends adjacent to changes in direction, on branches, where pipes pass through walls or floors, adjacent to operating accessories such as valves, regulators, strainers and cleanouts a minimum of 12 000 mm (40 feet) apart on straight runs of piping. Identification next to plumbing fixtures is not required.
 - 3. Locate Legends clearly visible from operating position.
 - 4. Use arrow to indicate direction of flow.
 - 5. Identify pipe contents with sufficient additional details such as temperature, pressure, and contents to identify possible hazard. Insert working pressure shown on drawings where asterisk appears for High, Medium, and Low Pressure designations as follows:
 - a. High Pressure - 414 kPa (60 psig) and above.
 - b. Medium Pressure - 104 to 413 kPa (15 to 59 psig).
 - c. Low Pressure - 103 kPa (14 psig) and below.

d. Add Fuel oil grade numbers.

6. Legend name in full or in abbreviated form as follows:

PIPING	COLOR OF EXPOSED PIPING	COLOR OF BACKGROUND	COLOR OF LETTERS	LEGEND BBREVIATIONS
Blow-off		Yellow	Black	Blow-off
Boiler Feedwater		Yellow	Black	Blr Feed
A/C Condenser Water Supply		Green	White	A/C Cond Wtr Sup
A/C Condenser Water Return		Green	White	A/C Cond Wtr Ret
Chilled Water Supply		Green	White	Ch. Wtr Sup
Chilled Water Return		Green	White	Ch. Wtr Ret
Shop Compressed Air		Yellow	Black	Shop Air
Air-Instrument Controls		Green	White	Air-Inst Cont
Drain Line		Green	White	Drain
High Pressure Steam		Yellow	Black	H.P. _____*
High Pressure Condensate Return		Yellow	Black	H.P. Ret _____*
Medium Pressure Steam		Yellow	Black	M. P. Stm _____*
Medium Pressure Condensate Return		Yellow	Black	M.P. Ret _____*
Low Pressure Steam		Yellow	Black	L.P. Stm _____*
Low Pressure Condensate Return		Yellow	Black	L.P. Ret _____*
High Temperature Water Supply		Yellow	Black	H. Temp Wtr Sup
High Temperature Water Return		Yellow	Black	H. Temp Wtr Ret
Hot Water Heating Supply		Yellow	Black	H. W. Htg Sup
Hot Water Heating Return		Yellow	Black	H. W. Htg Ret
Gravity Condensate Return		Yellow	Black	Gravity Cond Ret
Pumped Condensate Return		Yellow	Black	Pumped Cond Ret
Vacuum Condensate Return		Yellow	Black	Vac Cond Ret
Pumped Condensate		Black		Pump Cond
Pump Recirculating		Yellow	Black	Pump-Recirc.
Vent Line		Yellow	Black	Vent

Cold Water (Domestic)	White	Green	White	C.W. Dom
Hot Water (Domestic)				
Supply	White	Yellow	Black	H.W. Dom
Return	White	Yellow	Black	H.W. Dom Ret
Tempered Water	White	Yellow	Black	Temp. Wtr
Sanitary Waste		Green	White	San Waste
Sanitary Vent		Green	White	San Vent
Storm Drainage		Green	White	St Drain
Pump Drainage		Green	White	Pump Disch
Fire Protection Water				
Sprinkler		Red	White	Auto Spr
Standpipe		Red	White	Stand
Sprinkler		Red	White	Drain

B. Fire and Smoke Partitions:

1. Identify partitions above ceilings on both sides of partitions except within shafts in letters not less than 2 1/2 inches high.
2. Stenciled message: "SMOKE BARRIER" or, "FIRE BARRIER" as applicable.
3. Locate not more than 20 feet on center on corridor sides of partitions, and with a least one message per room on room side of partition.
4. Use semigloss paint of color that contrasts with color of substrate.

3.13 PROTECTION CLEAN UP, AND TOUCH-UP

- A. Protect work from paint droppings and spattering by use of masking, drop cloths, removal of items or by other approved methods.
- B. Upon completion, clean paint from hardware, glass and other surfaces and items not required to be painted of paint drops or smears.
- C. Before final inspection, touch-up or refinished in a manner to produce solid even color and finish texture, free from defects in work which was damaged or discolored.

- - - E N D - - -



2

GENERAL PHASING NOTES

1. CONTRACTOR IS RESPONSIBLE TO COORDINATE WORK AND PHASING WITH VA AND COORDINATION OF FURNISHING AND EQUIPMENT. REFER TO SPECIFICATION 012100 FOR PROJECT COORDINATION AND INFECTION CONTROL INSTRUCTION.
2. AREAS OF THE BUILDING WITHIN THE WORK AREAS WILL REMAIN OCCUPIED BY THE HOSPITAL STAFF AND USERS DURING CONSTRUCTION AS INDICATED. ACCESS WILL BE GRANTED BY THE VA FOR LIMITED DURATIONS. OTHER AREAS ADJACENT TO THE WORK AREAS WILL REMAIN OCCUPIED BY THE HOSPITAL. AT NO TIME SHALL THE OCCUPANTS BE DISTURBED DURING EXECUTION OF THE WORK.
3. ALL CODE REQUIRED EGRESS SHALL BE MAINTAINED THROUGHOUT THE PERIOD OF CONSTRUCTION.
4. ALL LIFE-SAFETY UTILITIES RUNNING THROUGH WORK AREAS, SERVING AREAS OUTSIDE THE WORK AREA SHALL BE MAINTAINED WITHOUT INTERRUPTION THROUGHOUT THE DURATION OF THIS WORK.
5. NO DUST, DIRT OR DEBRIS SHALL BE ALLOWED TO EXTEND BEYOND THE WORK AREA. PROVIDE TEMPORARY FACILITIES AS REQUIRED. SEE SPEC SECTIONS 010000, 012100, 013216-17 AND 015719.
6. REFER TO SPEC DIVISION 01 FOR ADDITIONAL REQUIREMENTS, INCLUDING PHASING, OCCUPIED SPACES, SITE USAGE, ACCESS, WORK RESTRICTIONS, WORK HOURS, NOTICES, ETC., NOT NOTED THIS SHEET.
7. BUILDING 1 LOADING DOCK IS AT SOUTH SIDE OF THE BUILDING, INDICATED IN SHEET G1 000, IS TO BE USED FOR CONSTRUCTION ACCESS. COORDINATE WITH THE COR FOR LIMITED USE OF DOCK FOR CONSTRUCTION ACCESS.
8. PROPOSED PHASING PLAN AND TEMPORARY PARTITION PLAN ARE DIAGRAMMATIC ONLY. COORDINATE WITH COR FOR FINAL REQUIREMENTS.
9. TEMPORARY PARTITIONS: CONSTRUCT A TEMPORARY, DUST TIGHT, 1-HR TYP. CONSTRUCTION FULL HEIGHT BARRIER OF METAL STUD AND GYPSUM BOARD PARTITION TO EXTEND TIGHTLY TO THE UNDERSIDE OF THE EXISTING CEILING. DO NOT ANCHOR THROUGH THE EXISTING FLOOR OR OTHER NON-REPAIRABLE FINISHES. INSTALL A DUST TIGHT POLYETHYLENE SHEET BARRIER ABOVE THE EXISTING CEILING CONSTRUCTION. ALL EXPOSED SURFACES OF PARTITIONS SHALL BE FINISHED TO MATCH ADJACENT.
10. C-LABEL (4 HR) TEMPORARY DOOR IN HM FRAME WITH LATCHING HARDWARE AND CLOSERS, PERIMETER SEALS, AND DOOR BOTTOM SEAL, FOR DAILY CONSTRUCTION ACCESS. PAINT EXPOSED DOOR AND FRAME TO MATCH TEMPORARY PARTITION.

REFER TO SPEC DIVISION 01 FOR ADDITIONAL INFORMATION.

PHASE 0: OFF-SITE PRE-CONSTRUCTION ACTIVITIES
PRE-CONSTRUCTION PROCUREMENT OF LONG-LEAD TIME EQUIPMENT AND MATERIAL.
CONTRACTOR'S MOBILIZATION ON-SITE AND EXTERIOR TEMPORARY FACILITY.
OWNER'S MOVE OUT OF INTERIOR CONSTRUCTION AREA.

PHASE 1: B186 E RENOVATE
DEMOLITION OF THE ROOM B186E.
TEMPORARY PARTITION AND DUST CONTROL AT DOORS AND WINDOWS.
SELECTIVE CONSTRUCTION IN ROOM B186E PER NEW PLAN.
OWNER'S MOVE IN TO B186E AS OPERATE THE B186 E AS NEW SHREDDER ROOM.

PHASE II: B278 RENOVATE AND NEW DOCK
OWNERS MOVE OUT TO NEW SHREDDER ROOM B186E FROM B278
TEMPORARY PARTITION AND DUST CONTROL AT DOORS AND WINDOWS.
SELECTIVE DEMOLITION IN ROOM B278.
FOUNDATION AND NEW LOADING DOCK AND RAMP CONSTRUCTION.
MOBILIZATION FOR SITE CIVIL WORK.

PHASE III: B276 VESTIBULE AND SITE CIVIL WORK
TEMPORARY PARTITION AND DUST CONTROL AT DOORS AND WINDOWS.
SELECTIVE DEMOLITION IN ROOM B276 AND B274
NEW CONSTRUCTION IN ROOM B276 AND B274.
ALL NEW CIVIL SITE WORK.

- 1 PROVIDE NECESSARY PROTECTION AND DUST CONTROL AT EXISTING DOOR.
- 2 MAINTAIN DAILY ACCESS / EGRESS FOR HOSPITAL USE DURING CONSTRUCTION
- 3 LINE OF TEMPORARY PARTITION



KEY PLAN

Office of
Facilities
Management






GENERAL DEMOLITION NOTES

1. CONTRACTOR SHALL VISIT THE SITE AND BECOME FAMILIAR WITH THE EXISTING CONDITIONS PRIOR TO COMMENCING THE WORK.
2. CONTRACTOR SHALL NOTIFY THE OWNER IF ANY DISCREPANCIES BETWEEN THE DEMOLITION DRAWINGS AND ACTUAL CONDITIONS PRIOR TO PROCEEDING WITH THE WORK.
3. REFER TO SWMP# DEMOLITION AND NEW WORK DRAWINGS FOR ADDITIONAL REQUIREMENTS.
4. PROVIDE PROTECTION AGAINST MOISTURE, IMPACT AND OTHER TYPES OF DAMAGE AT ALL OPENINGS CREATED BY SELECTING DEMOLITION PROTECTED CONSTRUCTION FROM DAMAGE DURING THE DEMOLITION AND NEW CONSTRUCTION WORK. REPAIR OR REPLACE AS REQUIRED EXISTING CONSTRUCTION DAMAGED AT NO COST TO THE OWNER.
5. CONTRACTOR TO PROVIDE AT LEAST REQUIRED OPENINGS IN EXISTING WALLS AND FLOORS FOR PENETRATION OF HVAC, MECHANICAL, PLUMBING, FIRE PROTECTION, COMMUNICATIONS, AND ALL OTHER REQUIRED BUILDING SYSTEMS. PATCH TO MATCH EXISTING FIRE AND SMOKE SEPARATION TO MATCH AND MATCH SMOKE AND FIRE RATINGS AS REQUIRED. PROVIDE PRELIMINARY IDENTIFICATION MARKS ON BOTH SIDES OF EACH PENETRATION THROUGH FLOOR WALLS.
6. PROTECT EXISTING INTERIOR WALLS DURING DEMOLITION AND CONSTRUCTION. PROVIDE TEMPORARY PROTECTION FROM DUST, NOISE, DAMAGE, ETC. CONSTRUCTION BARRIERS AND OTHER SITE PROTECTION REQUIREMENTS TO BE CONSISTENT WITH THE SPECIFICATIONS SECTION AND DIVISION 1, GENERAL REQUIREMENTS. REFER TO THE PROJECT MANUAL, SPECIFICATIONS DIVISION 1, AND GENERAL REQUIREMENTS FOR RELATED PROJECT, DEMOLITION, CONSTRUCTION AND PROTECTION REQUIREMENTS.
7. PLANS ARE DIAGRAMATIC AND PROVIDED TO SHOW THE INTENT ONLY. UNLESS SPECIFICALLY NOTED OTHERWISE, ALL PARTITION ASSEMBLIES SHALL BE DEMOLISHED TO THE SUBSTRATE. THIS INCLUDES, BUT IS NOT LIMITED TO, INCLUDING ONE, STUDS, TRACKS, FASTENING DEVICES, AND ALL RELATED PARTS.
8. THE CONTRACTOR SHALL OBTAIN ALL NECESSARY PERMITS AND WORK ORDERS REQUIRED AND SHALL NOTIFY ALL UTILITIES HAVING SERVICE CONNECTIONS WITHIN THE SITE.
9. CONTRACTOR SHALL REMOVE ALL TRASH AND DEBRIS DAILY. DEMOLITION WORK SHALL REMAIN SAFE AND CLEAR FOR THE BUILDING'S OCCUPANTS AND CONSTRUCTION WORKERS. OCCUPIED AREAS ADJACENT TO THE PROJECT WORK AREAS SHALL BE KEPT CLEAR AT ALL TIMES DURING THE WORK. SEE GC# FOR ADDITIONAL WORK LIMITATIONS DUE TO OCCUPIED CONSTRUCTION.
10. ROOMLAYOUTS AND CONFIGURATIONS AND AREAS OUTSIDE OF THE CURRENT PHASE OF WORK ARE SHOWN FOR REFERENCE ONLY. EXISTING PASSAGE AND ROOMS ARE BASED UPON INFORMATION PROVIDED BY THE OWNER. FIELD VERIFICATION PRIOR TO COMMENCEMENT OF CONSTRUCTION IS REQUIRED.
11. CONTRACTOR SHALL PROVIDE TEMPORARY PROTECTION, SUPPORT, BRACING SEAMS AND CAPPING OF EXISTING PARTITIONS, CEILINGS, PIPES, DUCTS, CONDUITS, ETC. SHOWN ARE TO BE PARTIALLY DEMOLISHED IN THIS PHASE OF WORK. THE TEMPORARY WORK SHALL KEEP THE PARTIALLY DEMOLISHED WORK STABILIZED WHERE EXISTING CONSTRUCTION IS SHOWN TO BE PARTIALLY DEMOLISHED IN THIS PHASE OF WORK. EXISTING WORK SHALL BE DEMOLISHED TO A MINIMAL DIS PLACE AS REQUIRED TO MATCH LAYOUT INDICATED.
12. CONTRACTOR SHALL MAINTAIN NEGATIVE PRESSURE WITH THE EXISTING SPACE AT ALL TIMES DURING DEMOLITION AND NEW CONSTRUCTION. PROVIDE TEMPORARY VENTILATION AND TEMPORARY PERIMETER SEALS ON ALL EXISTING UTILITIES AND DUCTS PARTIALLY DEMOLISHED TO PREVENT CONTAMINATION FROM CONSTRUCTION.
13. ALL NOTES AND DRAFTING SYMBOLS INDICATING DEMOLITION INCLUDE COMPLETE DEMOLITION AND PROPER DISPOSAL OF ITEMS IDENTIFIED.


KEY PLAN

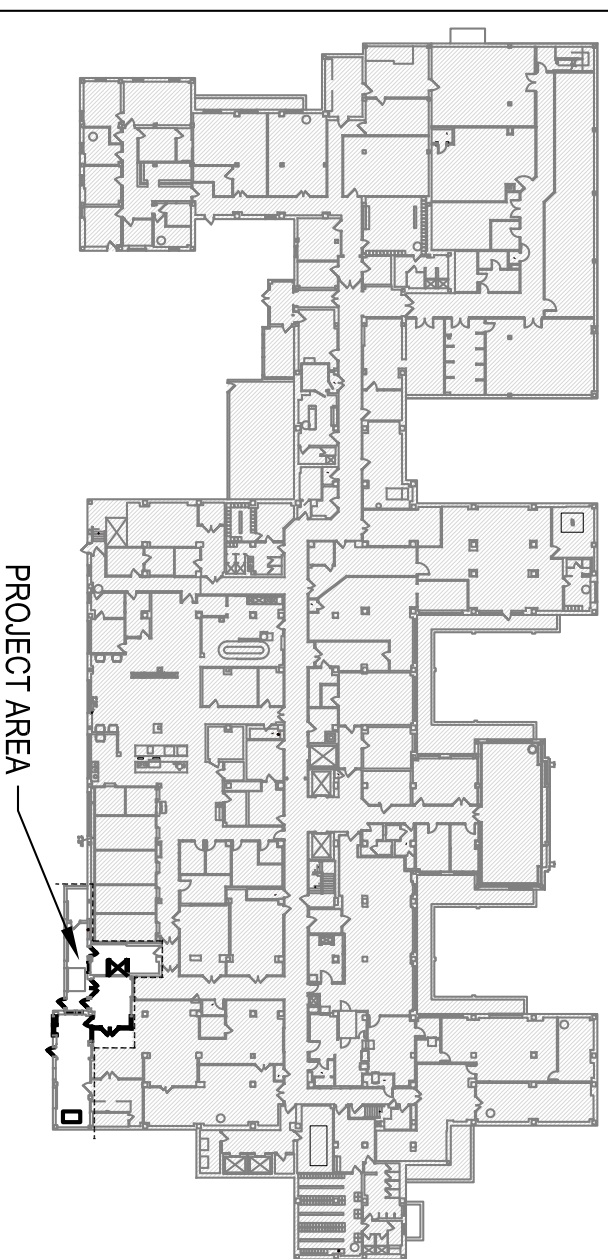


**Department of
Veterans Affairs**

GENERAL NOTES

- SEE SHEET A000 FOR ABBREVIATIONS, SYMBOLS & NOTES.
- SEE SECTION 09 91 00 - PAINTING FOR SCHEDULE OF FINISHES (INTERIOR AND EXTERIOR)
- REFER TO THE MECHANICAL AND ELECTRICAL DIVISION FOR THE DETAILS OF THE MECHANICAL AND ELECTRICAL DIVISIONS WHICH PORTIONS MAY BE SHOWN ON THE ARCHITECTURAL DIVISIONS.
- STORE ALL MATERIALS IN ACCORDANCE WITH MANUFACTURER RECOMMENDATIONS AND TO PROTECT FROM DAMPNESS AND MAINTAIN MOISTURE CONTENT.
- SEE STRUCTURAL FOR DETAILS.
- WORK COOLER TO BE CONSTRUCTED OF STAINLESS STEEL. COOLER DOOR OPENING TO BE A MINIMUM OF 42" WIDE.

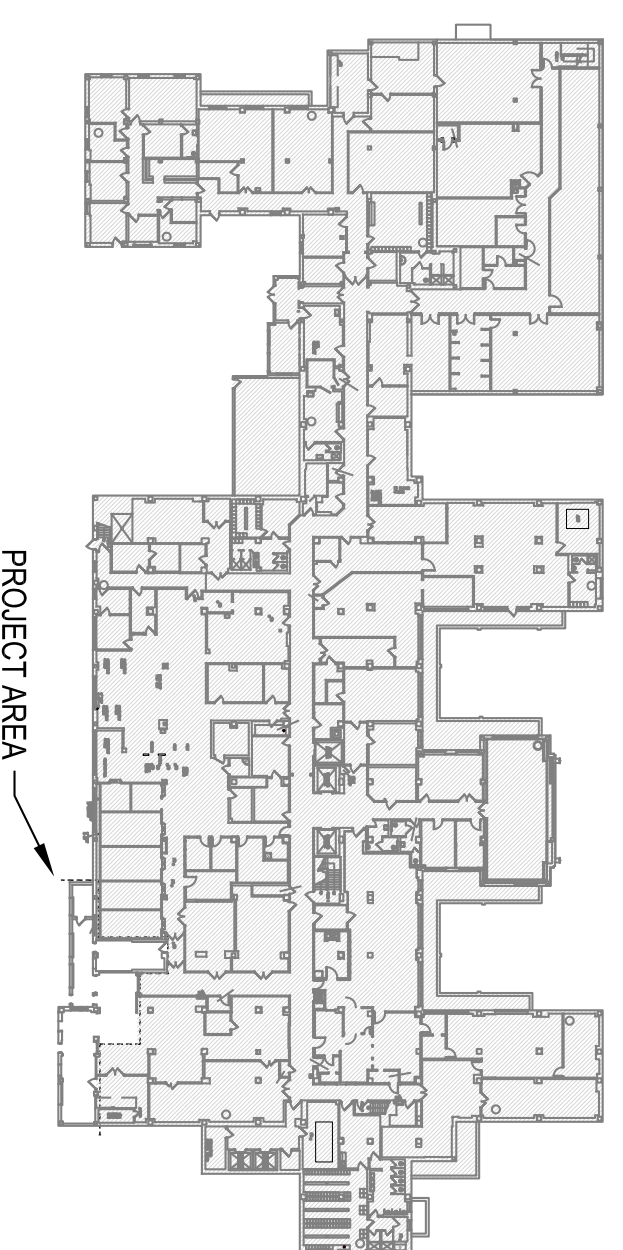


KEY PLAN

1 FLOOR PLAN - NEW WORK
SCALE: 1/4" = 1'-0"



- PLAN LEGEND
- EXISTING WALL TO REMAIN
 - NEW WALL / PARTITION
 - EXISTING DOOR TO REMAIN
 - NEW DOOR AND HARDWARE
 - AREA NOT IN SCOPE OF WORK

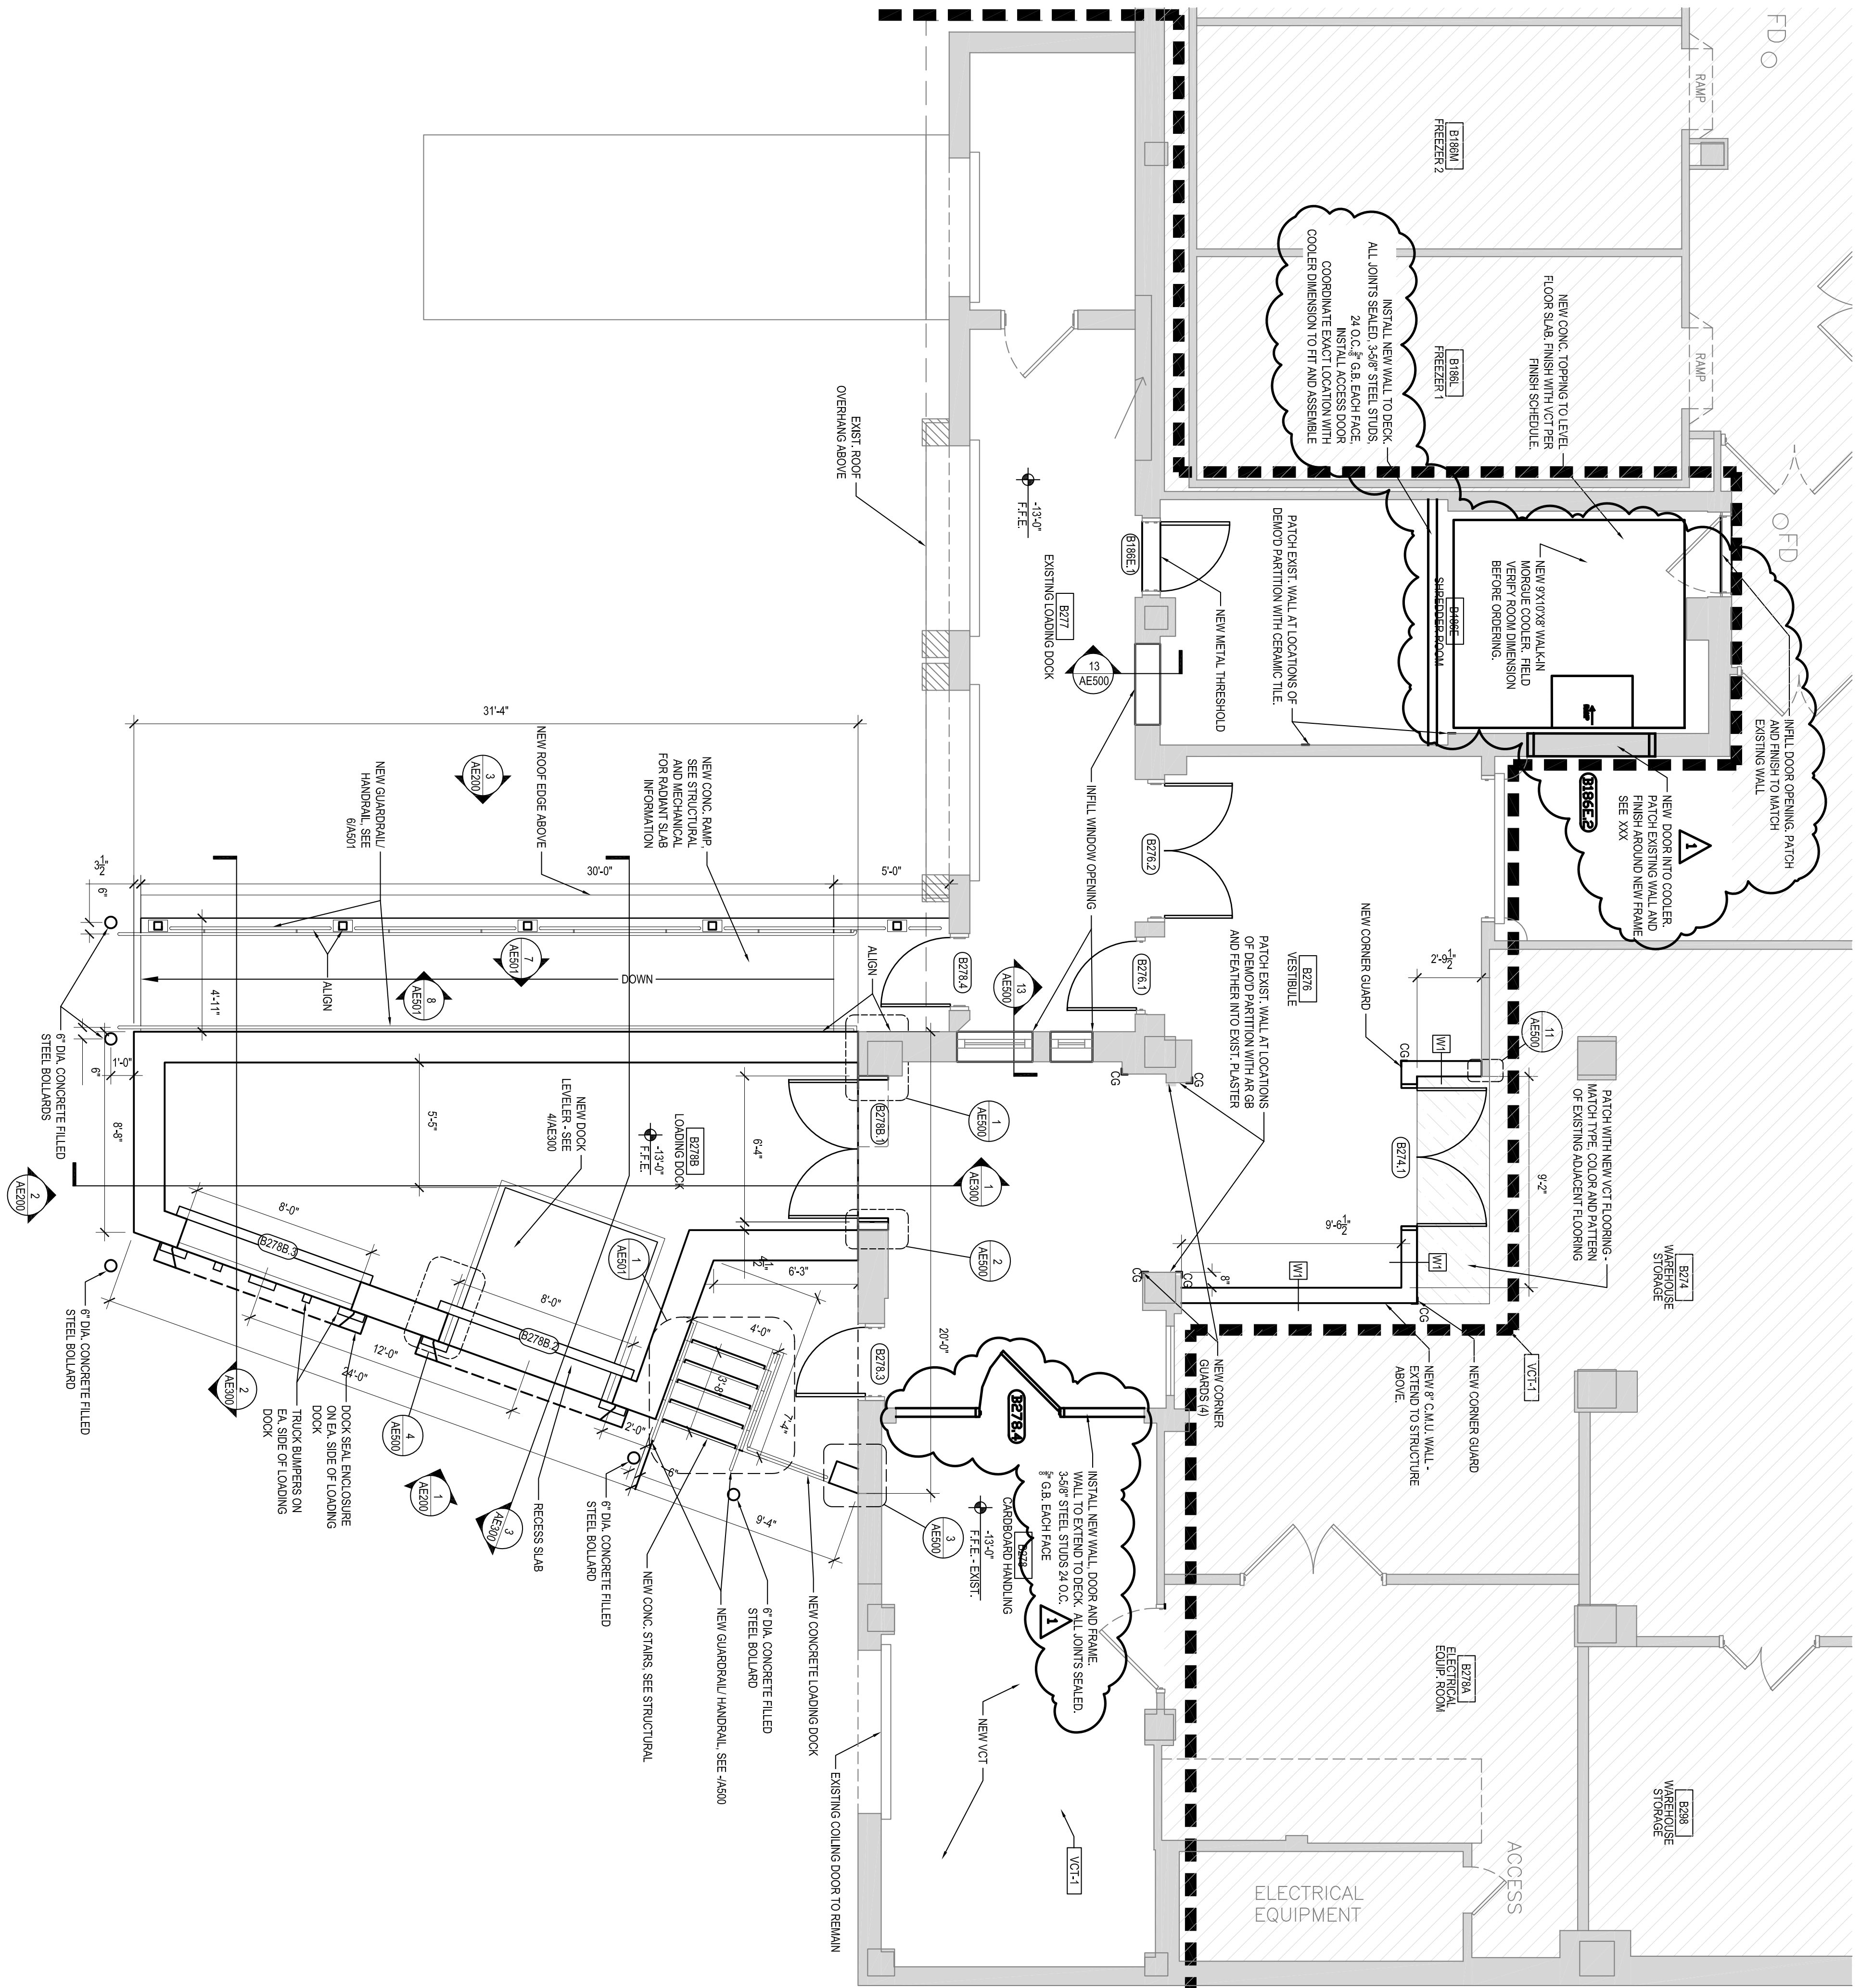

CONSULTANTS:

ADDENDUM #1 PER OWNER	2/14/17
OWNER REVISIONS	12/23/16
100% CONSTRUCTION DRAWINGS	08/22/14
95% CONSTRUCTION DRAWINGS	01/09/14
50% CONSTRUCTION DRAWINGS	11/08/13
REVISIONS:	D08

Ionilic
Structures & Design, LLC
P.O. Box 446
4445 Salsburg Road, Suite 104
Westfield, WI 53593

GEI
Consultants
925 W. Washington St. Suite 104
Madison, WI 53703

ARCHITECT/ENGINEERS:

bailey edward
1 715.233.1843
www.baileyedward.com
314 S. Gunders Ave.
Rothschild, WI
53070-5422
62014 Bailey Edward Design
Design from Madison, WI 53703-0182

Drawing Title
NEW WORK FLOOR PLAN

Project Title
RENOVATE LOADING DOCK

Location	325 EAST H. ST., IRON MOUNTAIN, MI 49801
Date	08/22/14
Checked:	PG
Drawn:	NMK

Project Number
585-12-125



Building Number
BUILDING 1

Drawing Number
AE101


Dwg. 15. of 33

Office of
Facilities
Management


Department of
Veterans Affairs

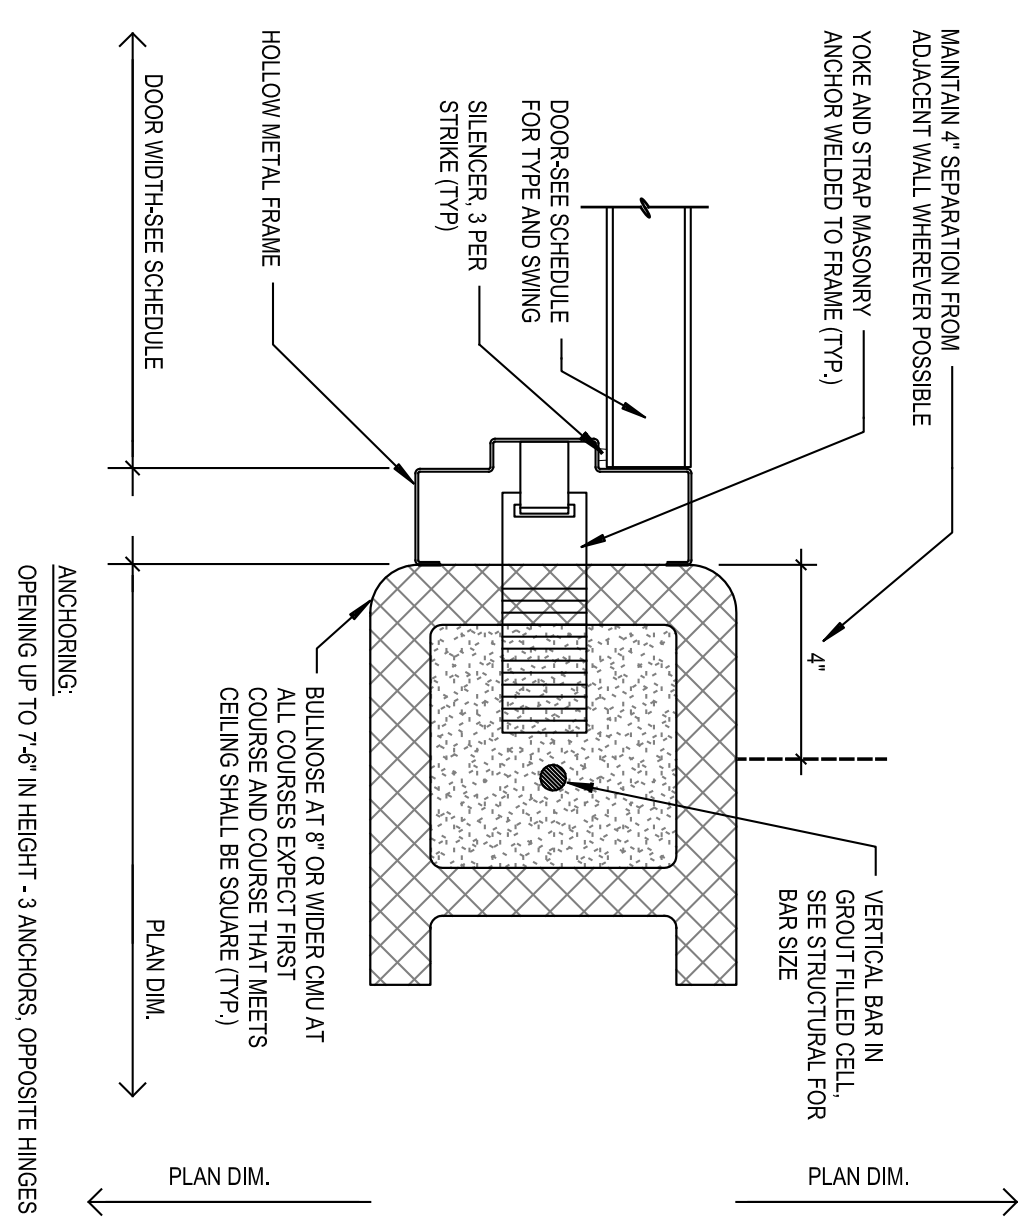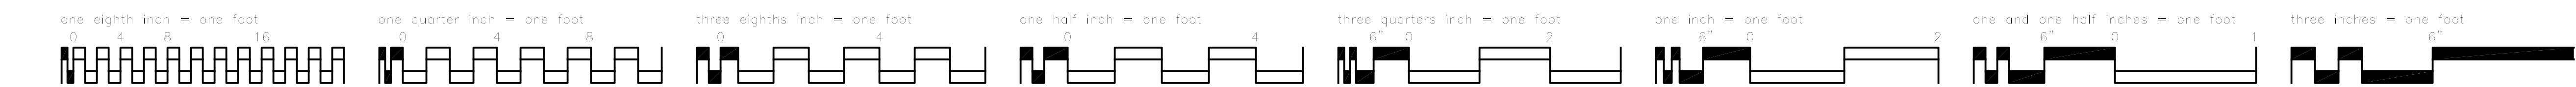


INT HM JAMB DETAIL
SCALE 3/1=1'-0"

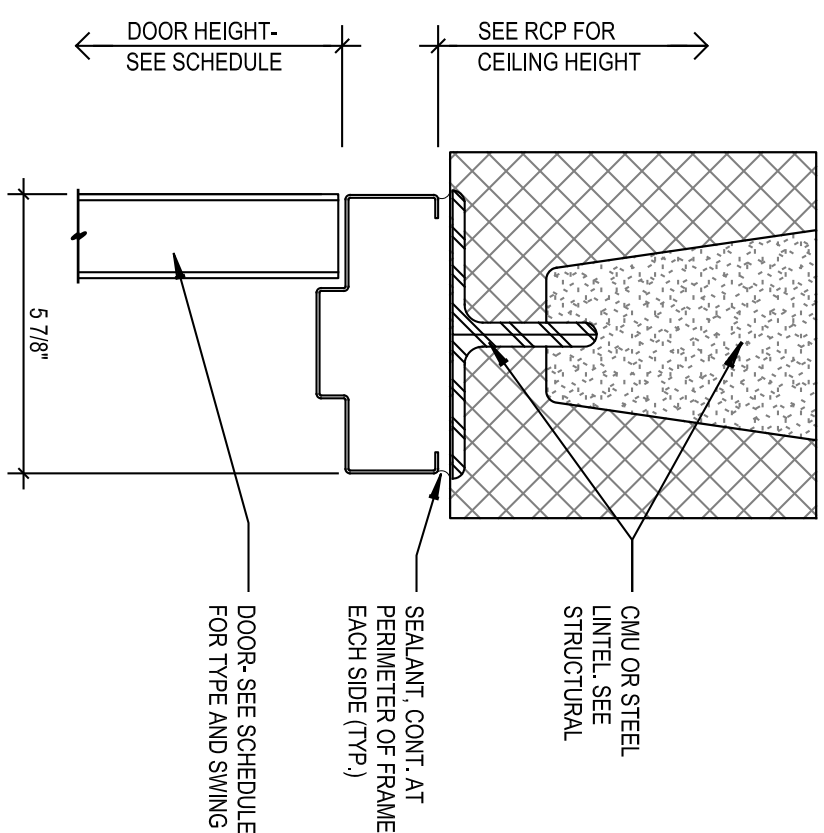


INT HM HEAD DETAIL
SCALE 3/1=1'-0"

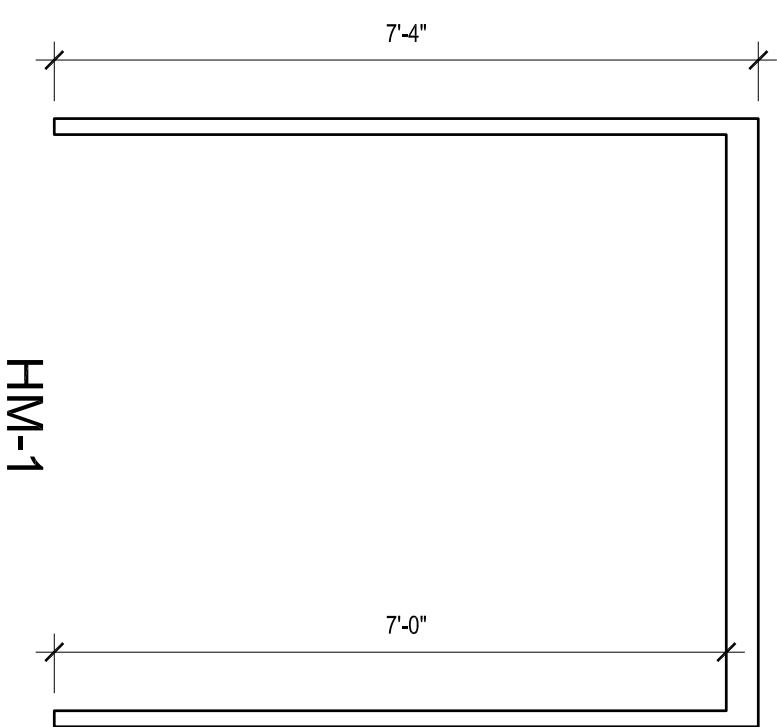

FRAME TYPES

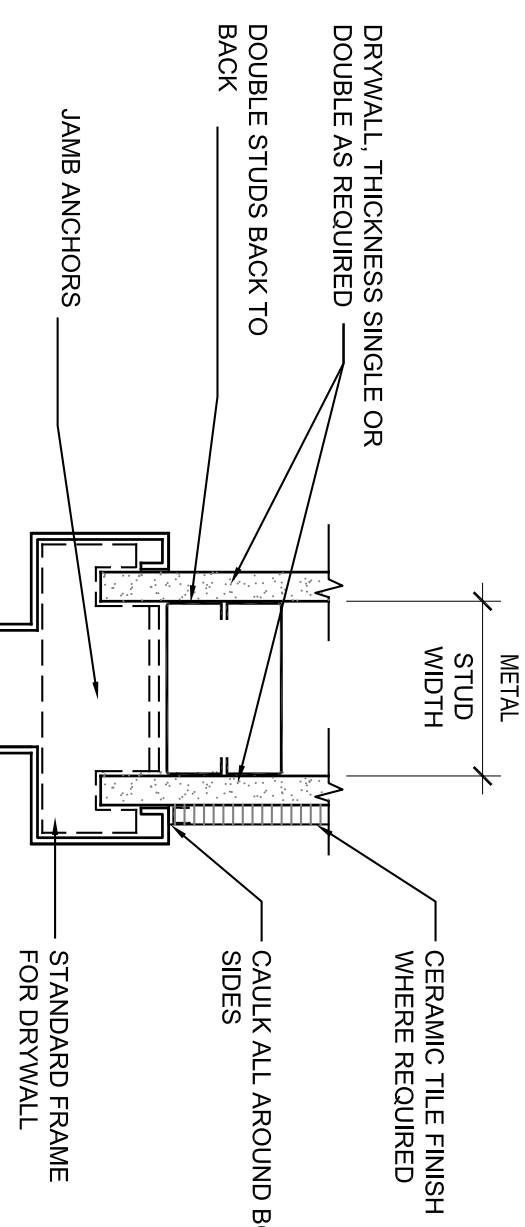

DOOR DETAILS

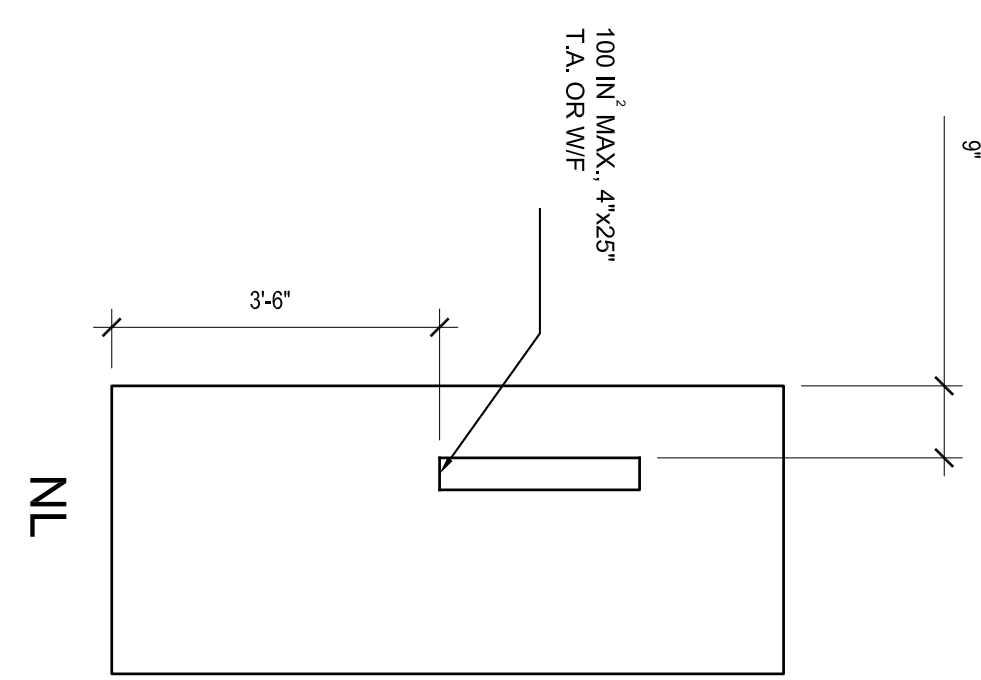


DOOR TYPES



DOOR SCHEDULE											
DOOR NUMBER	ROOM NUMBER	ROOM NAME	DOOR			FRAME			DETAILS		
			WIDTH	HEIGHT	THICKNESS	TYPE	MATERIAL	FINISH	TYPE	MATERIAL	FINISH
B274.1	B274	WAREHOUSE STORAGE	8'-0"	7'-0"	1'-3/8"	NL	MTL	PA12	HM-1	MTL	PA12
B278.3	B278	CARDBOARD HANDLING	3'-0"	7'-0"	1'-3/8"	NL	MTL	PA12	EXST	MTL	PA12
B188E.1	B188E	SHREDDER ROOM	3'-0"	7'-0"	1'-3/8"	F	MTL	PA12	EXST	MTL	PA12
B276.1	B276	VESTIBULE	3'-0"	7'-0"	1'-3/8"	NL	MTL	PA12	EXST	MTL	PA12
B272.2	B272	VESTIBULE	3'-0"	7'-0"	1'-3/8"	NL	MTL	PA12	EXST	MTL	PA12
B278.4	B277	EXIST. LOADING DOCK	3'-0"	7'-0"	1'-3/8"	F	MTL	PA12	EXST	MTL	PA12
B278B.1	B278B	LOADING DOCK	8'-0"	7'-0"	1'-3/8"	F	MTL	PA12	HM-1	MTL	PA12
B278B.2	B278B	LOADING DOCK	8'-0"	7'-0"	1'-3/8"	-	MTL	PA12	-	MTL	PA12
B278B.3	B278B	LOADING DOCK	8'-0"	7'-0"	1'-3/8"	-	MTL	PA12	-	MTL	PA12
B278.4	B278	LOADING DOCK	3'-0"	7'-0"	1'-3/8"	F	MTL	PA12	HM-1	MTL	PA12
B278E.2	B188E	MORGUE COOLER	5'-0"	7'-0"	1'-3/8"	F	MTL	PA12	HM-1	MTL	PA12

NOTE: SEE SPEC 08 71 00 FOR HARDWARE SET

ROOM NUMBER	ROOM NAME	ROOM SCHEDULE				BASE	FLOOR	CEILING
		NORTH	EAST	SOUTH	WEST			
B188E	SHREDDER ROOM	EXST.	EXST.	EXST.	EXST.	RB-1*	VCT	ACT-1
B276	VESTIBULE	PT-1	PT-1	PT-1	PT-1	RB-1	(E) CONC	ACT-1
B278	(E) LOADING DOCK	PT-1	PT-1	PT-1	PT-1	EXST.	EXST.	EXST.
B278	CARDBOARD HANDLING	PT-1	PT-1	PT-1	PT-1	RB-1	CONC.	EXP. / EXST.
B278B	LOADING DOCK	PT-1	PT-1	PT-1	PT-1	RB-1	CONC.	PT-2

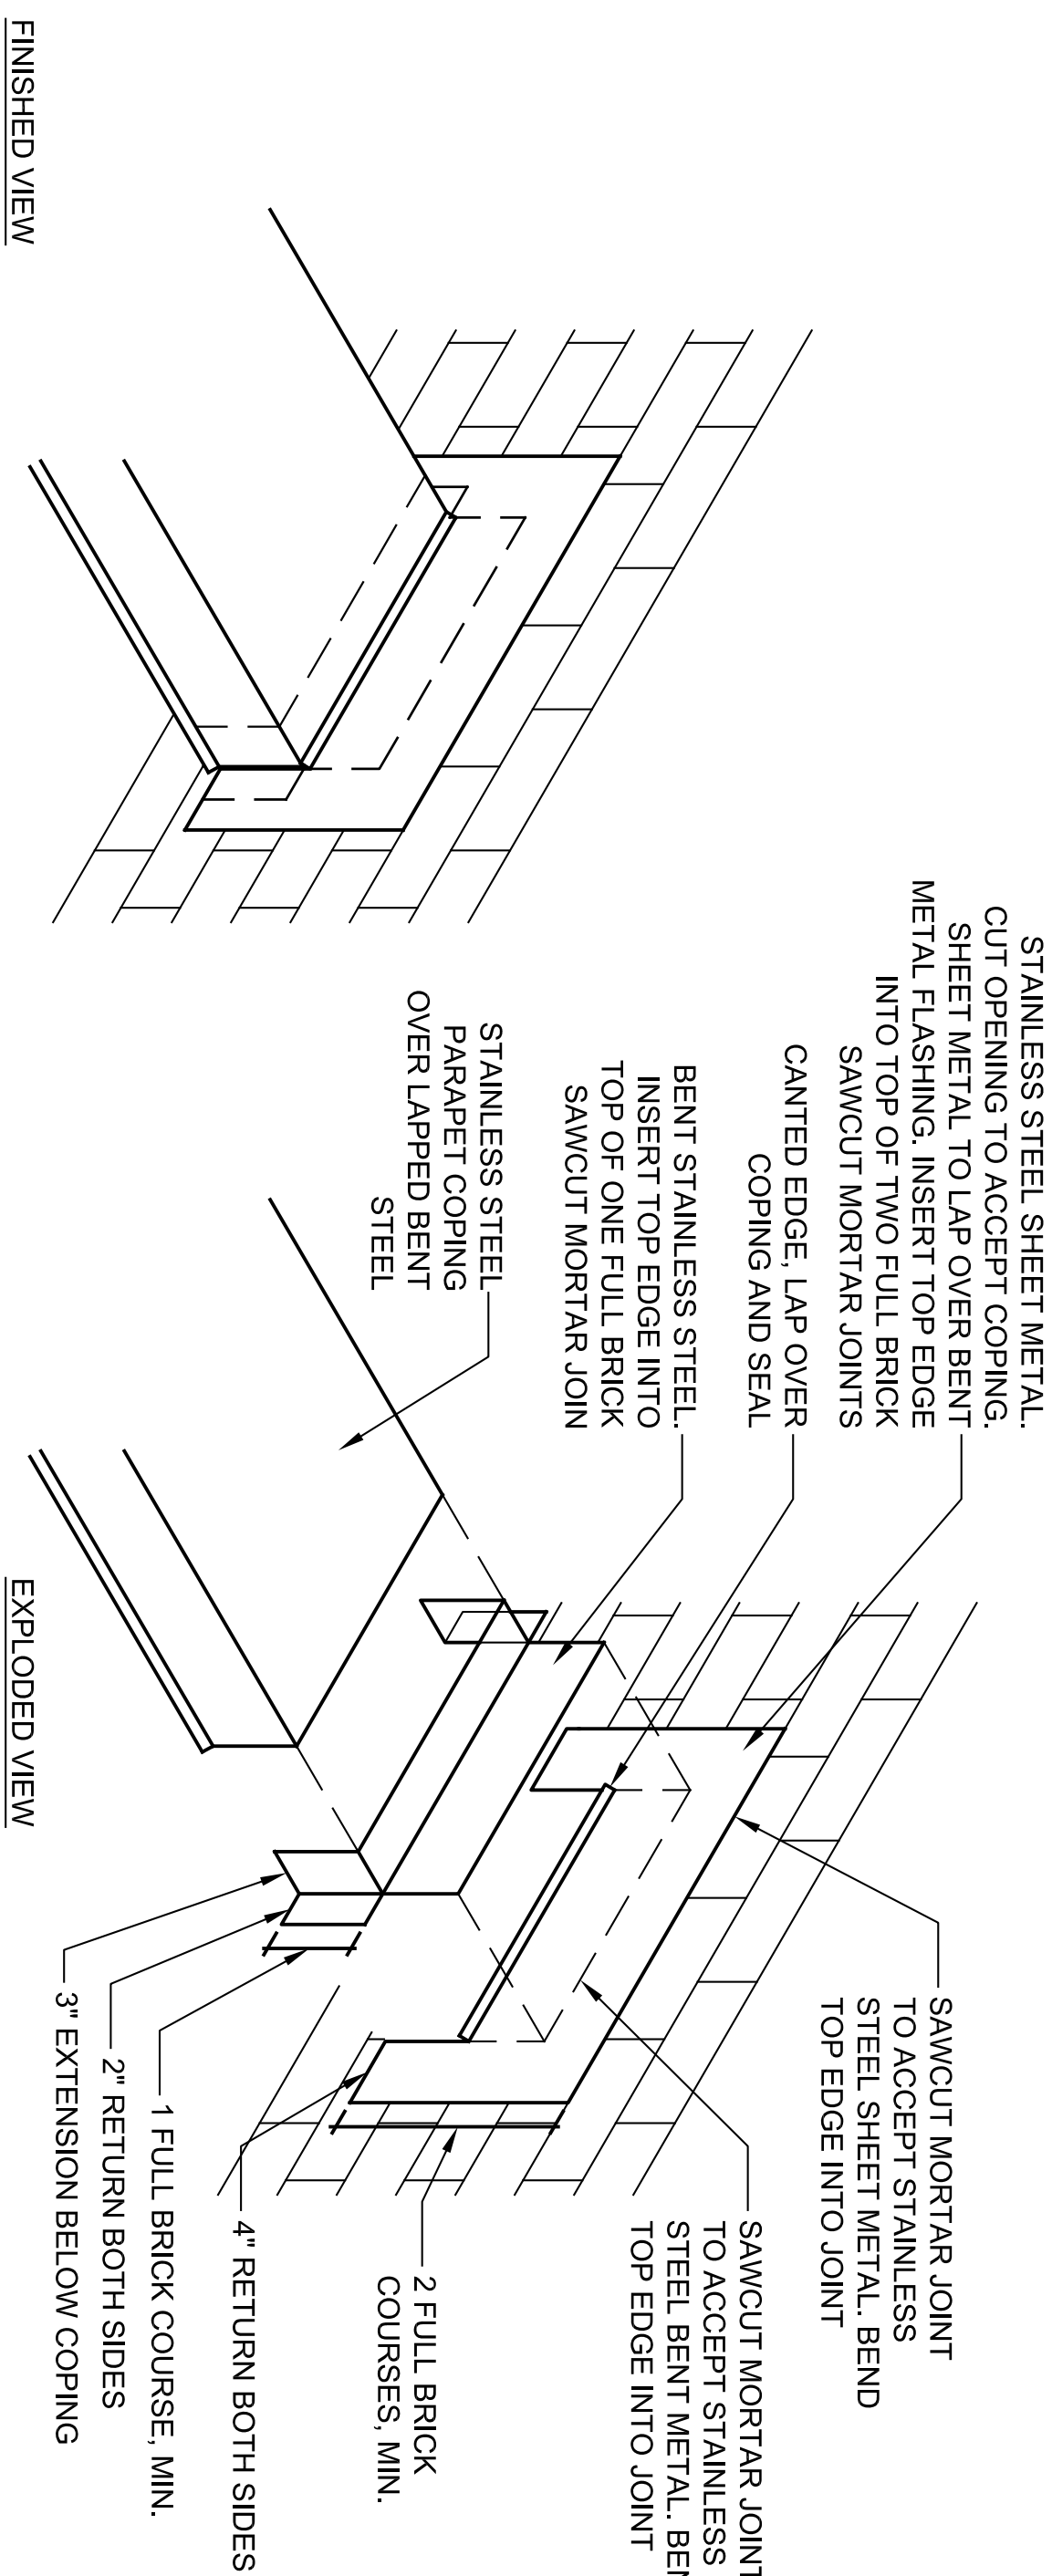

ROOF TO WALL 3-PIECE COPING FLASHING
SCALE NOT TO SCALE

ADDENDUM #1 PER OWNER	2/14/17
OWNER REVISIONS	7/23/16
100% CONSTRUCTION DRAWINGS	08/22/14
95% CONSTRUCTION DRAWINGS	07/09/14
50% CONSTRUCTION DRAWINGS	11/08/13
REVISIONS:	DBB

CONSULTANTS:

Ionilic
Structures, Inc.
100% CONSTRUCTION DRAWINGS
08/22/14

GEL
Consultants
925 W. Washington St. Suite 104
Madison, WI 53703

ARCHITECT/ENGINEERS:

bailey edward
1715 233 3463
www.baileyedward.com
311 S. Oakdale Ave.
Suite 202
Riverside, WI 53075-5422


62014 Bailey Edward Design
Design from Edward Inc. 10/20/18/2

Drawing Title		Project Title		Project Number		Office of Facilities Management	
DOOR AND FINISH SCHEDULES AND DETAILS		RENOVATE LOADING DOCK		585-12-125			
Approved Project Director		Location		Building Number			
		325 EAST H ST., IRON MOUNTAIN, MI 49801		BUILDING 1			
Date		Drawn		Drawing Number			
08/22/14		PG		AE002			
Checked		Drawn		Dwg. No. of 33			
PG		NMK					

SEQUENCE OF OPERATION:
1. STEAM CONTROL VALVE SHALL MODULATE TO MAINTAIN THE LEAVING HOT WATER TEMPERATURE AT SET POINT.
2. THE LEAVING HOT WATER TEMPERATURE SHALL BE RESET INVERSELY WITH THE OUTDOOR TEMPERATURE AS SCHEDULED.
3. THE LEAD AND LAG PUMPS AND HEAT EXCHANGERS SHALL BE SEQUENTIAL BY THE OPERATOR CONTROLS AT THE PRE-DETERMINED INTERVAL (USUALLY 7 DAYS) IN THE EVENT THE PUMP FAILS TO START WITHIN 30 SECONDS, AN ALARM SHALL BE INITIATED AND THE SECOND PUMP SHALL START AUTOMATICALLY.

VALVE SEQUENCE:

1. V1, V3 (4 CAPACITY) MODULATING FULLY OPEN TO MAINTAIN SET POINT.
2. V2, V4 (4 CAPACITY) MODULATE FULLY OPEN TO MAINTAIN SET POINT.
3. BOTH V1, V3 & V2, V4 MODULATE TOGETHER TO MAINTAIN SET POINT.

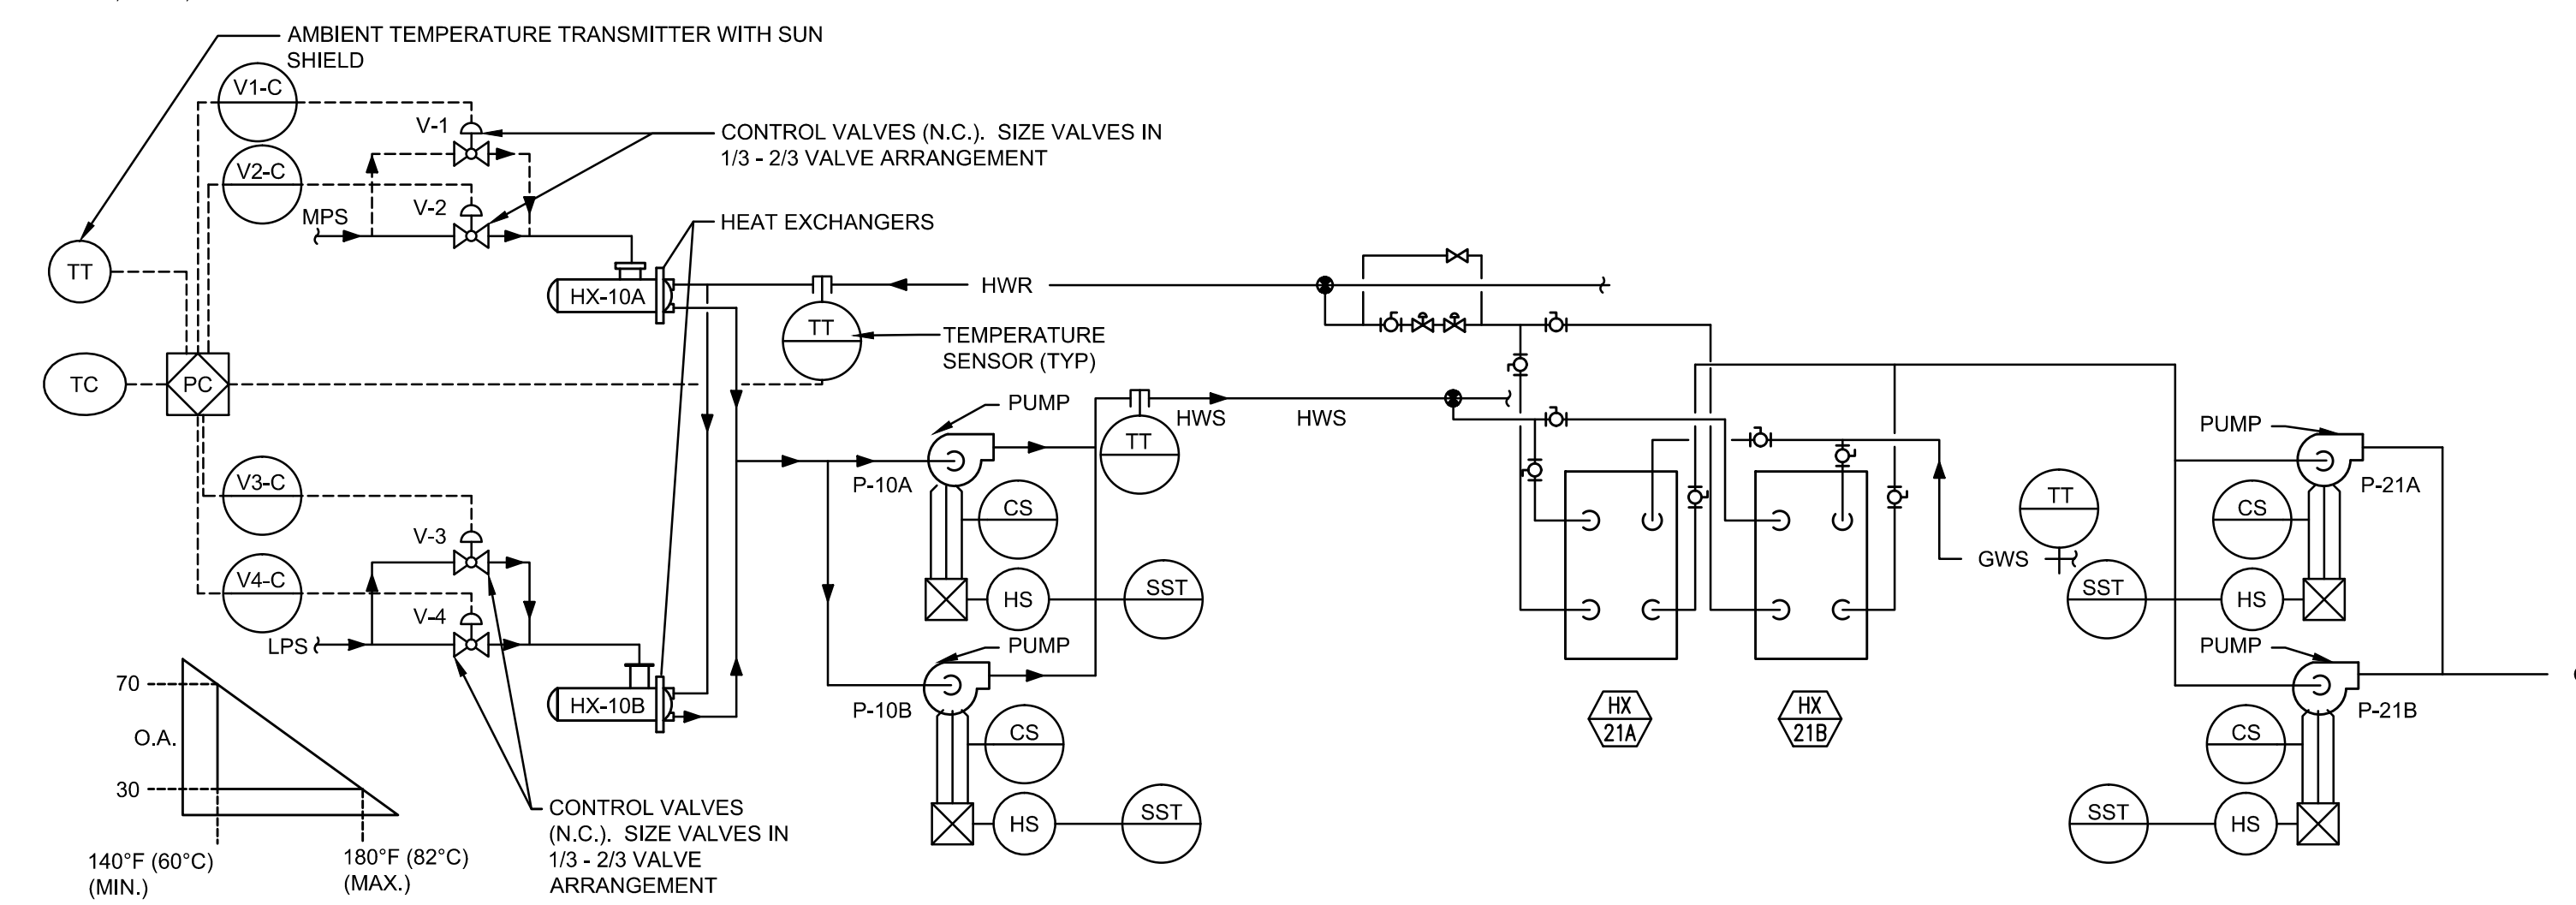


DUAL HEAT EXCHANGER CONTROLS (HEATING SYSTEM) HX10A, HX10B

N.T.S.

NOT IN CONTRACT

NOTE:

PROVIDE ENERGY MONITORING TRENDING AND CALCULATIONS FOR NEW ENERGY DASHBOARD BAS

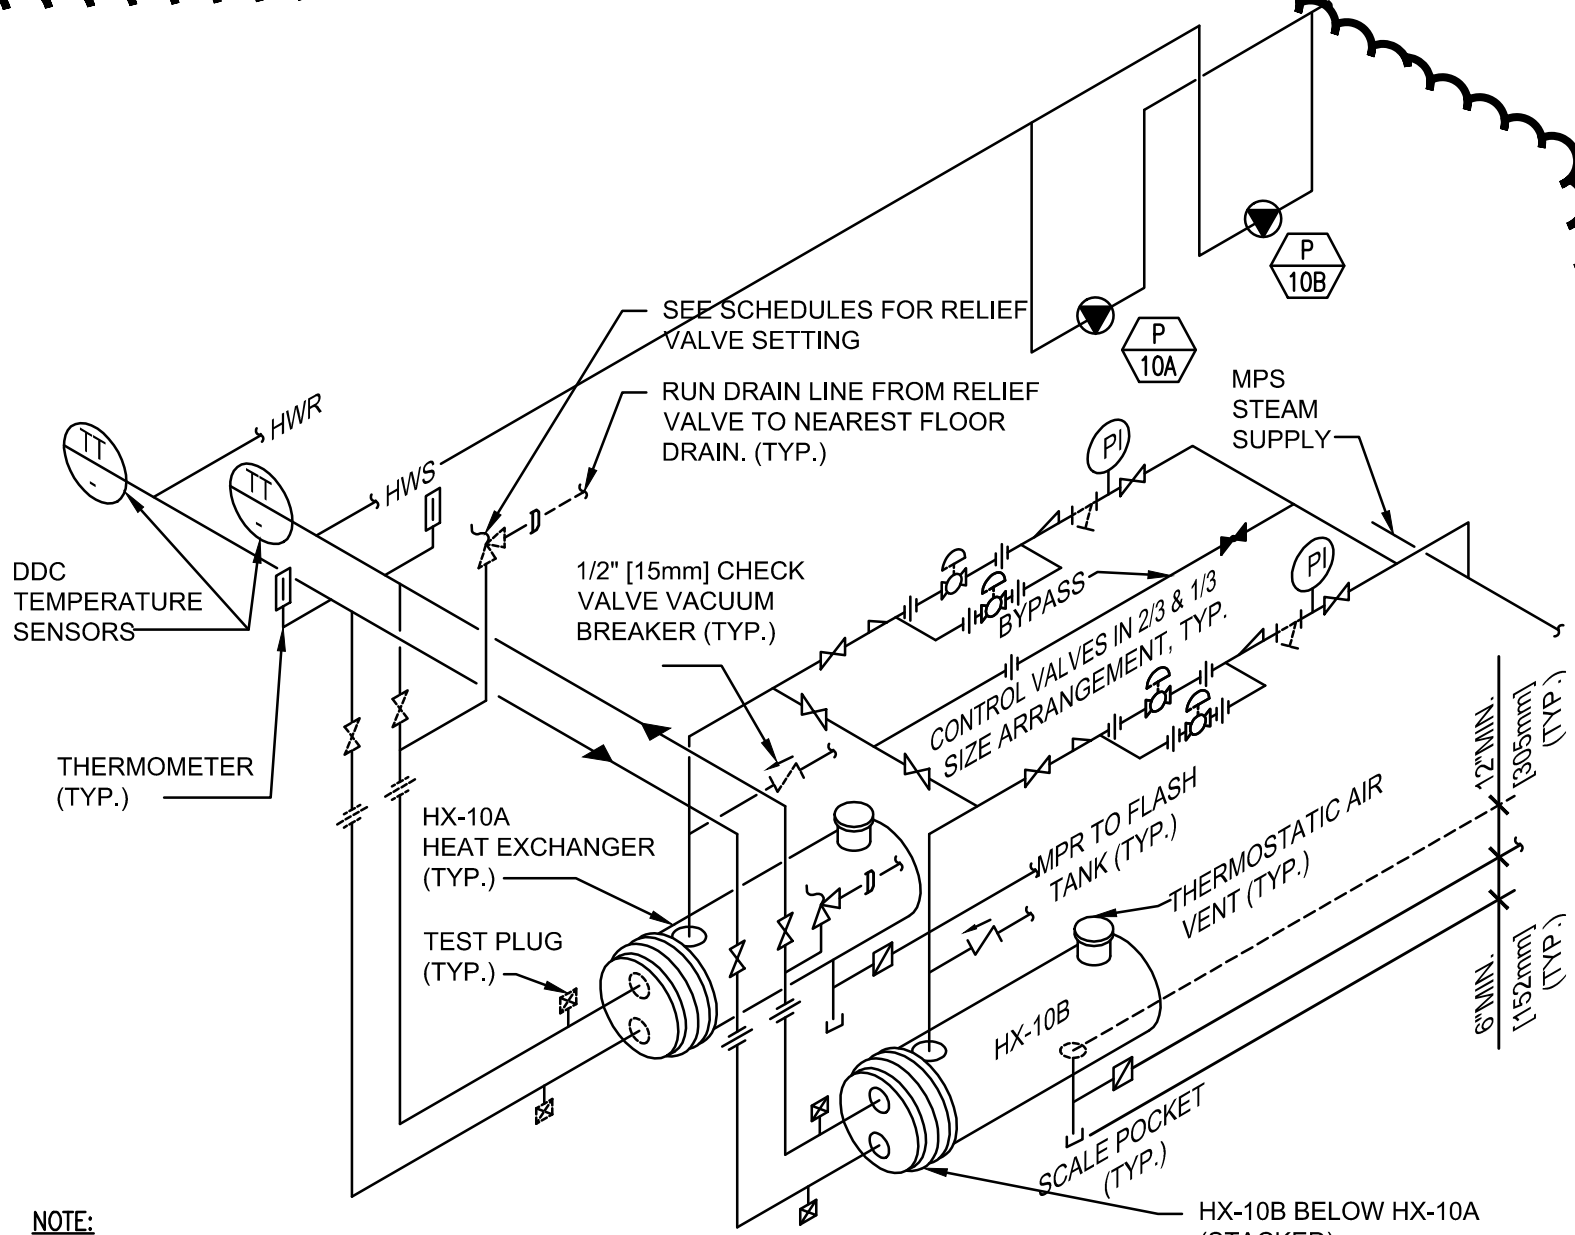


NOTE:

1. THE ABOVE DETAIL SHOWS REQUIRED PIPING FOR TWO HEAT EXCHANGERS IN PARALLEL.
2. PROVIDE SADDLE SUPPORTS AND LEGS OR HANGERS FOR HEAT EXCHANGER. MOUNTING HEIGHT SHALL BE ADJUSTED TO FACILITATE GRAVITY RETURN OF STEAM CONDENSATE.
3. MAKE THE BYPASS THE SAME SIZE AS THE CONNECTIONS TO THE CONTROL VALVES.
4. CONTROL VALVES SHALL BE IN A 1/3 AND 2/3 SIZE ARRANGEMENT.
5. REWORK/REUSE EXISTING PIPING AS REQUIRED. PROVIDE NEW VALVES, SENSORS, DEVICES AS REQUIRED.

HEAT EXCHANGER - STEAM TO HOT WATER- HX10A, HX10B

N.T.S.

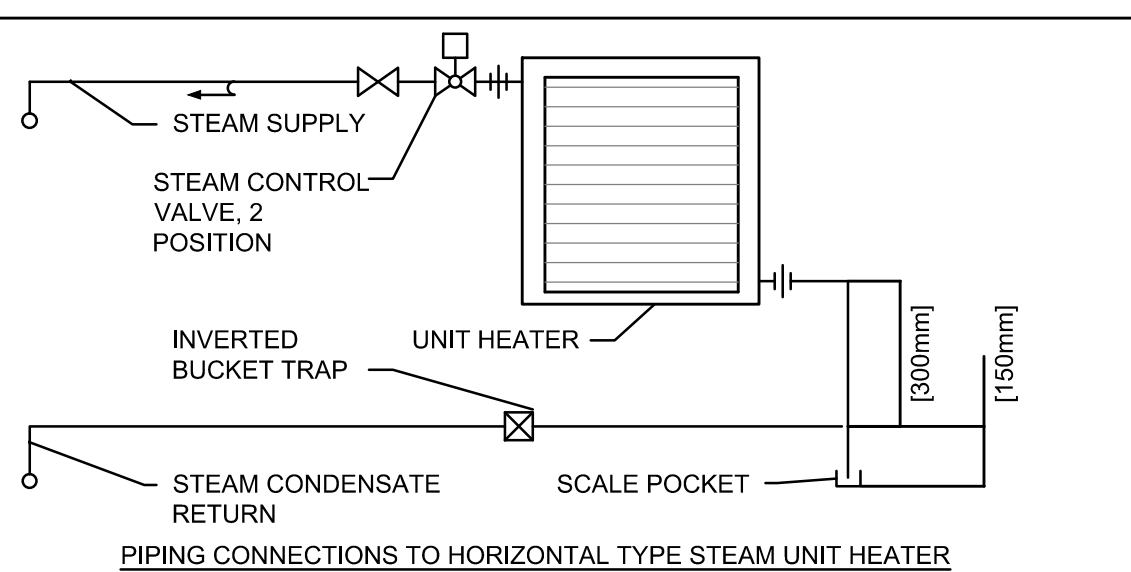


- NOTES:
1. UNIT MOUNTED THERMOSTAT SHALL MAINTAIN SPACE TEMPERATURE BY CYCLING THE FAN. THE CONTROL VALVE SHALL BE INTERLOCK WITH THE FAN.

UNIT HEATERS (STEAM) PIPING CONNECTIONS (AIR CURTAIN)


N.T.S.

- SEQUENCE OF OPERATION
- UNIT HEATER START BY THERMOSTAT DOOR SWITCH THERMOSTAT CONTROLS VALVE TO MAINTAIN SPACE SETPOINT. UNIT TO HAVE MULTIPLE SPEED ADJUSTMENTS. PROVIDE THE FOLLOWING BAS POINTS
1. FAN ON/OFF CURRENT
 2. POSITIVE AIRFLOW
 3. STEAM VALVE STATUS
 4. COND. TEMP. LBS/HR. TRENDING, ENERGY CALC. TO MATCH ENERGY DASHBOARD.
 5. MOD. STEAM VALVE.
 6. ROOM TEMP.

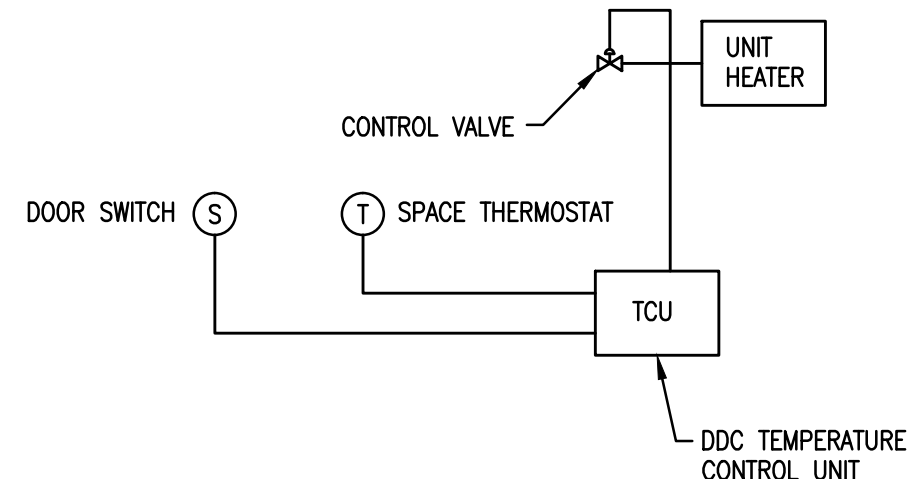


UNIT HEATERS (STEAM)

N.T.S.

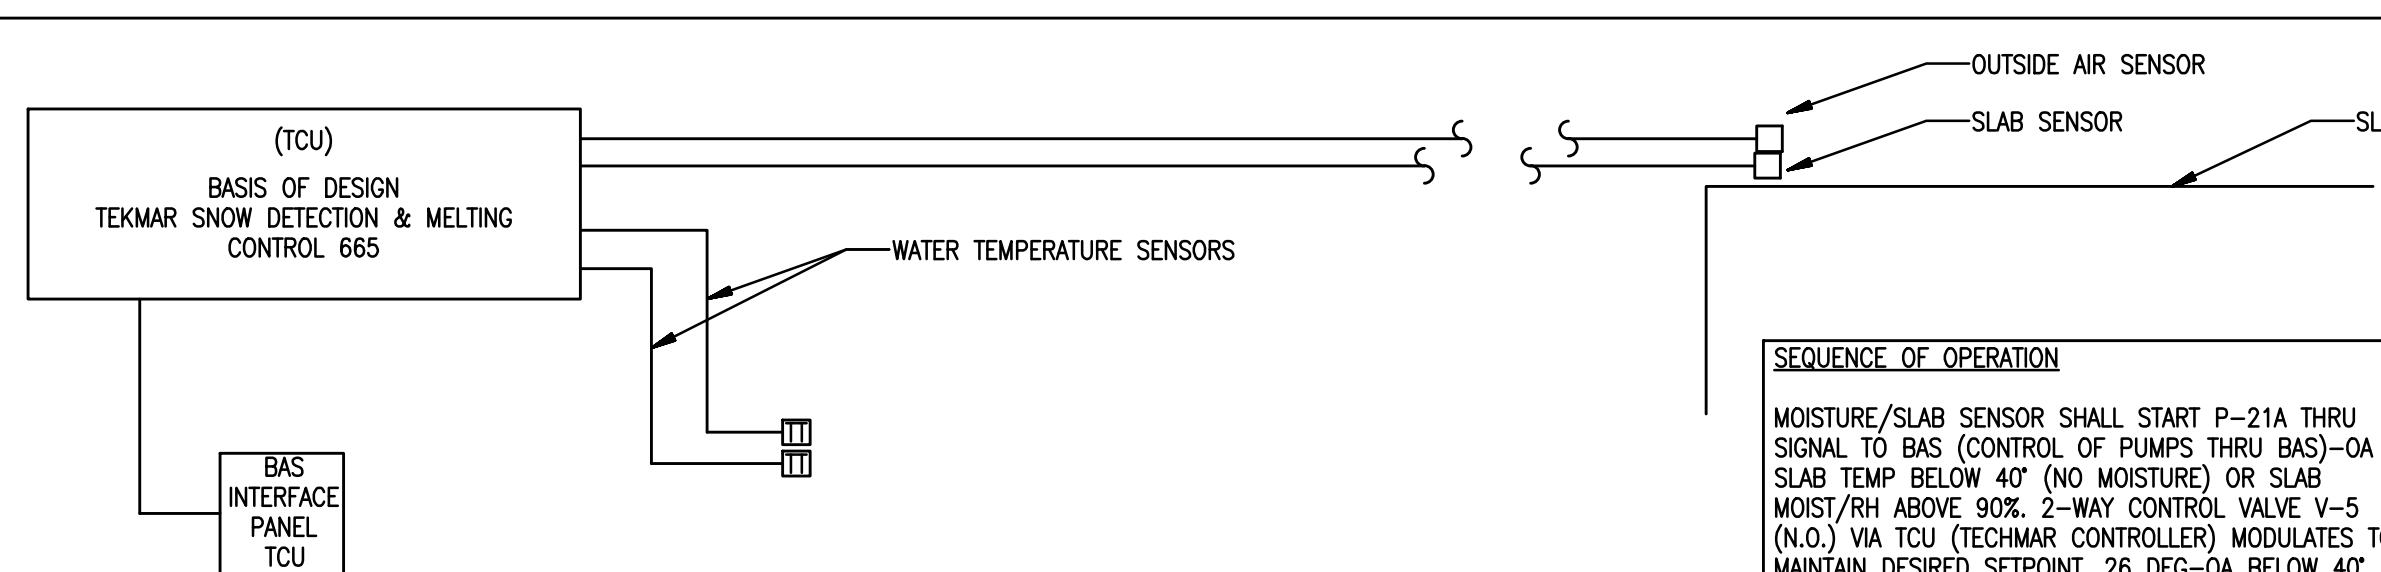


SNOW MELT SENSORS

N.T.S.

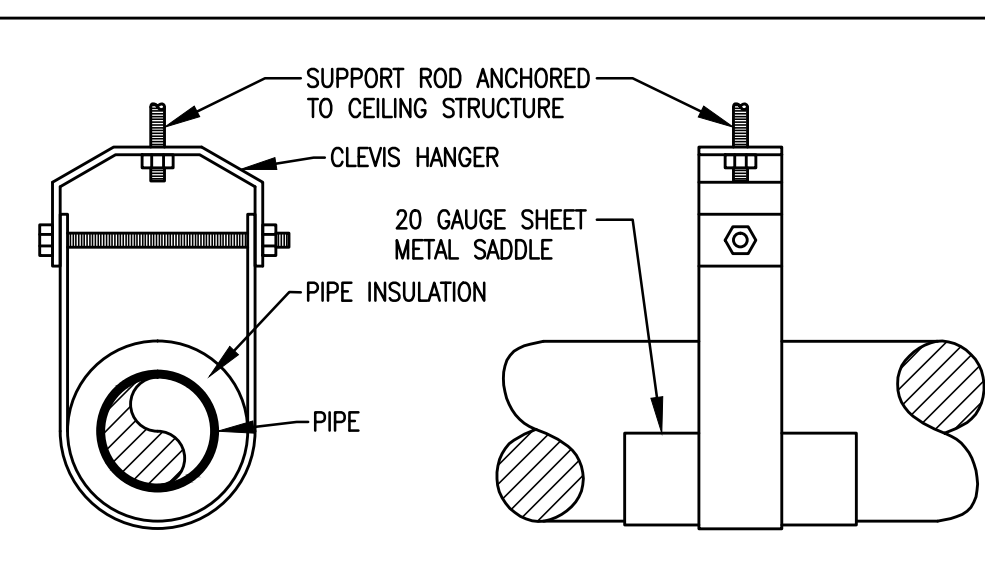

TYPICAL PIPE HANGER DETAIL


N.T.S.

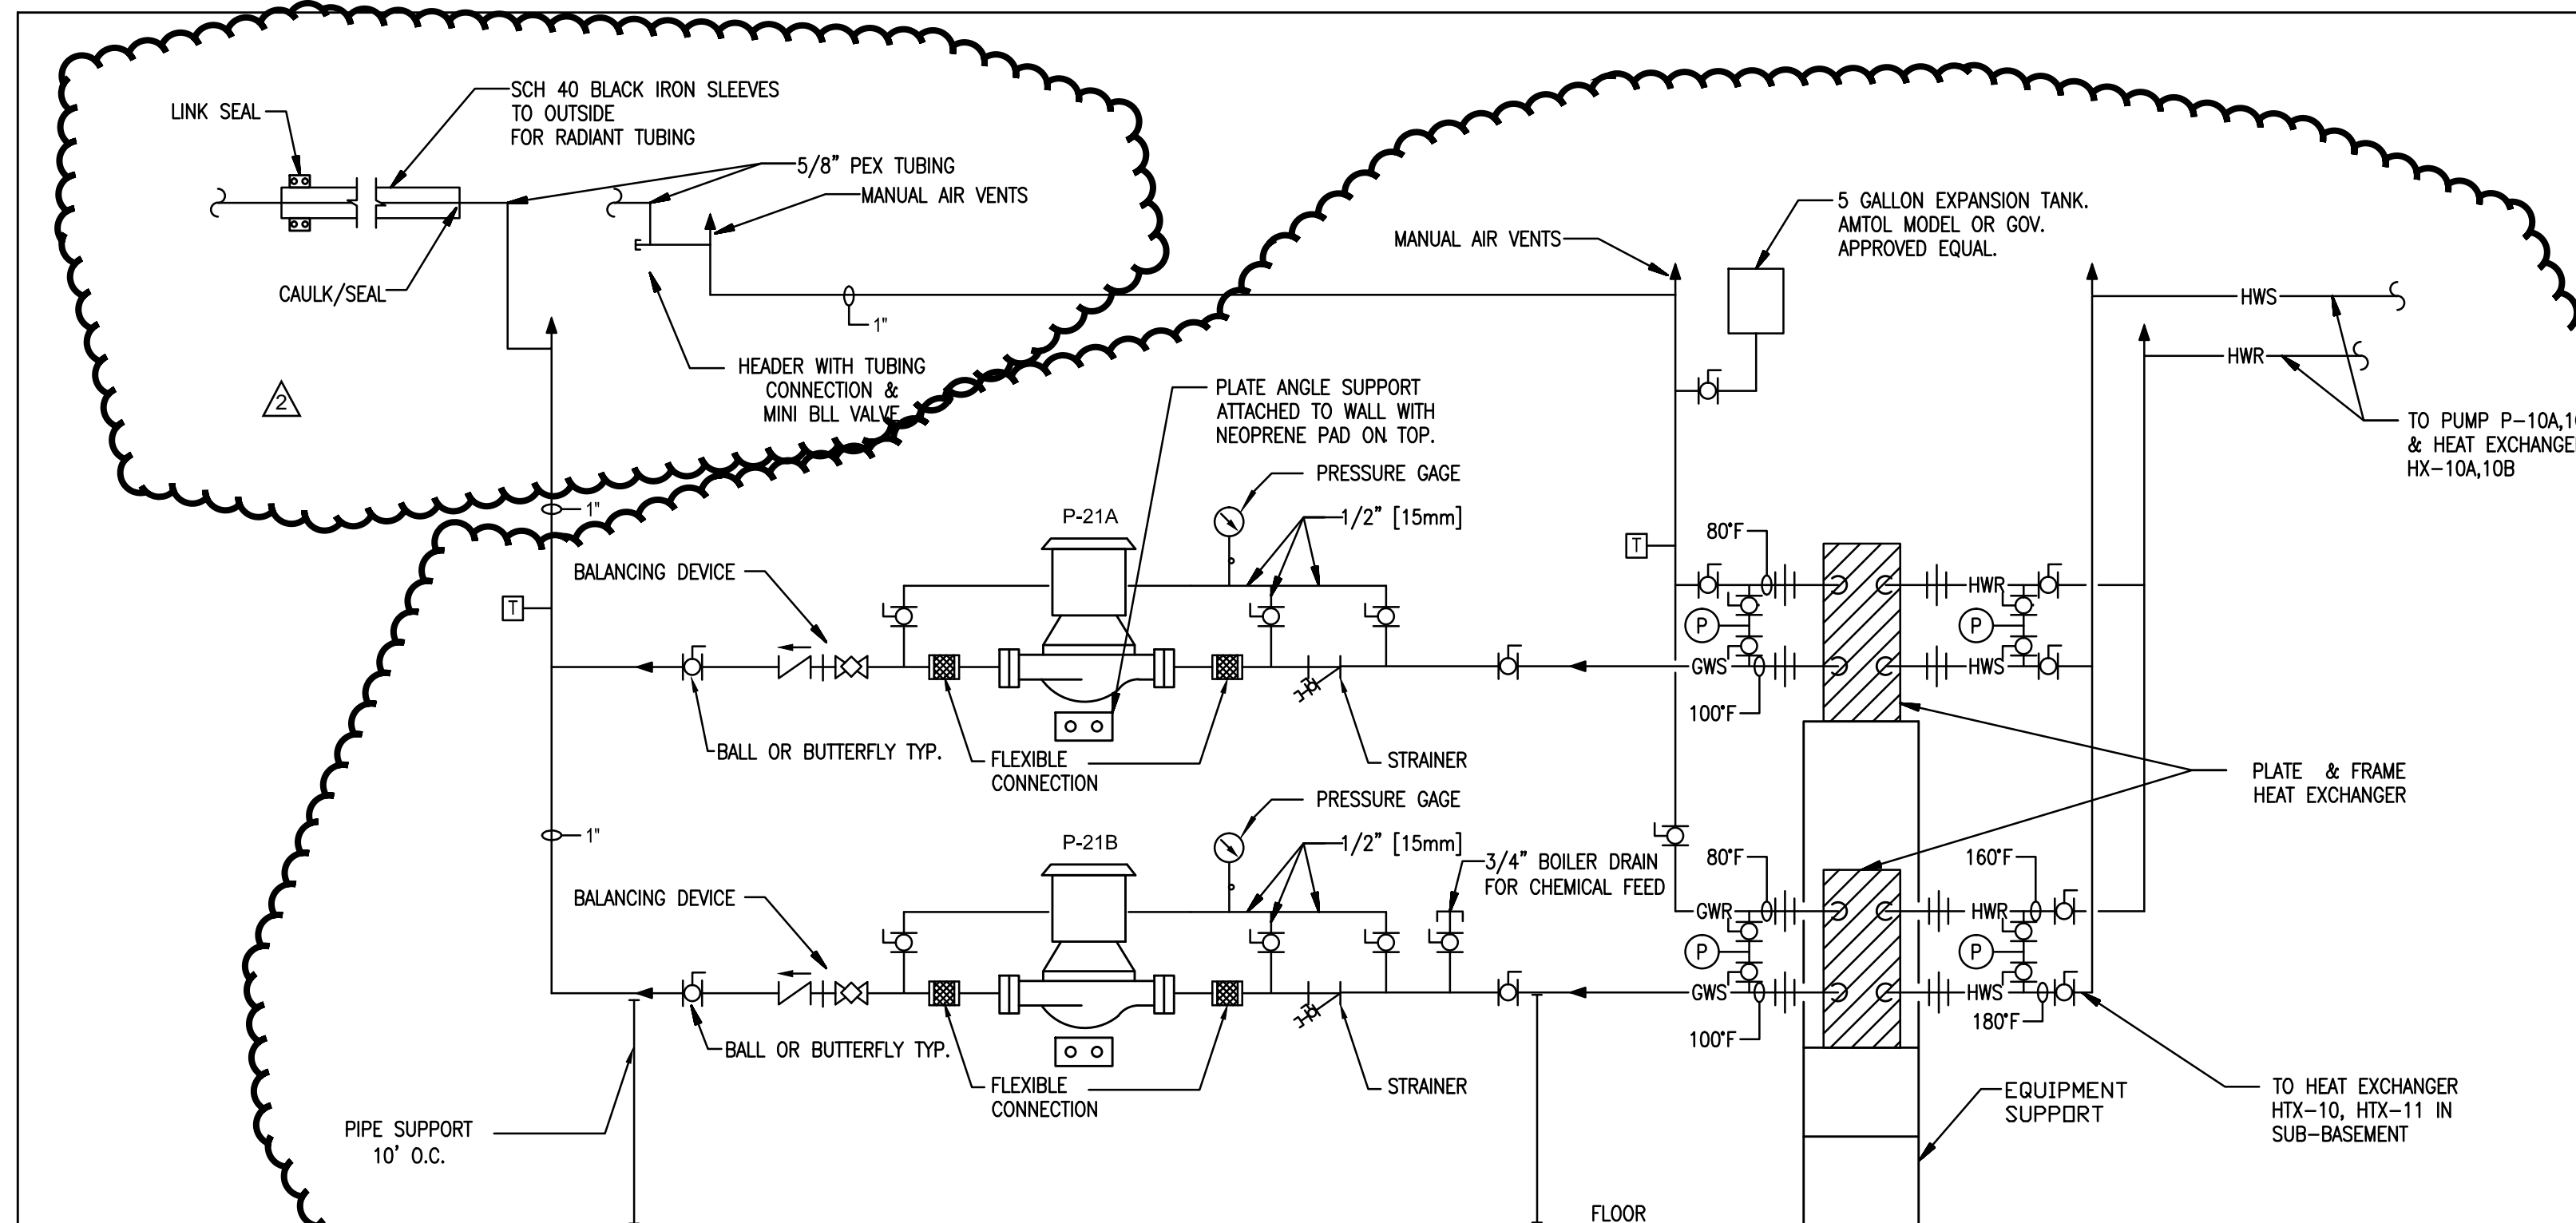

IN-LINE PUMPS - CONNECTIONS

N.T.S.

NOT IN CONTRACT

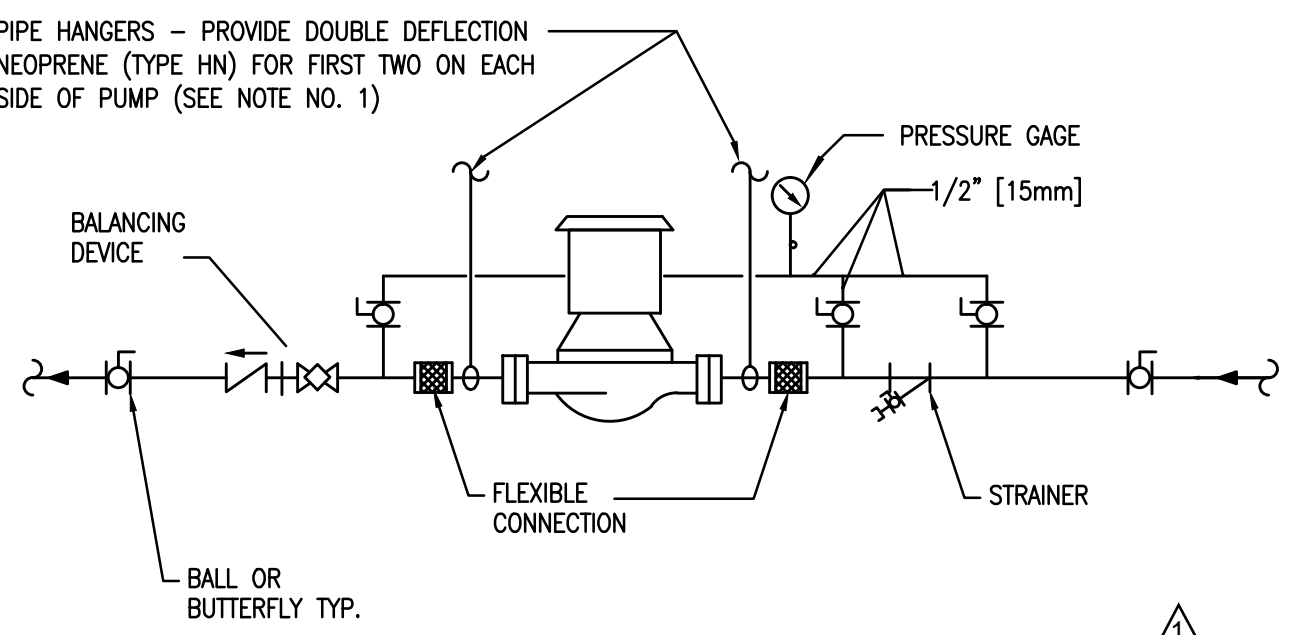

NOTES:

1. SUPPORT PUMP FROM PIPING ONLY. DO NOT SUPPORT PUMP FROM MOTOR.

IN-LINE PUMPS - CONNECTIONS

NTS

PUMP SCHEDULE

TAG NO.	SERVICE/LOCATION	CAP	PUMP TYPE	TOTAL HEAD W.C. FT.	WORKING PRESS. MAX. PSIG	LIQUID TEMP. °F	N.P.S.H. MIN. SUCT. HEAD W.C. ABSOLUTE FT.	PUMP			MOTOR			VIBRATION ISOLATION		REMARKS
								BHP	RPM	V/PH/C	HP	RPM	TYPE	MIN. STATIC DEF. IN.	IN.	
21 A	SNOW MELTING/SUB-BSEMT	7	INLINE	65	-	100	-	-	-	208/3	1	3450	-	-	-	SERIES 90, 1 AA (1) (3)
21 B	SNOW MELTING/SUB-BSEMT	7	INLINE	65	-	100	-	-	-	208/3	1	3450	-	-	-	SERIES 90, 1 AA (1) (3)
10 A	HX-10A/SUB-BSEMT	46	INLINE	65	-	100	-	-	-	460/3	3	3450	-	-	-	SERIES 90, 1 1/2 AA (1) (2)
10 B	HX-10B/SUB-BSEMT	46	INLINE	65	-	100	-	-	-	460/3	3	3450	-	-	-	SERIES 90, 1 1/2 AA (1) (2)

FLANGED ENDS

2. REMOVE 1.5 HP MOTOR AND PROVIDE 3 HP HIGH EFFICIENCY MOTOR, CHANGE IMPELLER FROM 3.75 TO 4.75, PROVIDE (2) DANFOSS MODEL FC102 VARIABLE FREQUENCY DRIVES WITH DISC SWITCH.
3. 40% PROPYLENE GLYCOL.
4. FIELD VERIFY EXACT VOLTAGE PRIOR TO ORDERING.

NOT IN CONTRACT

UNIT HEATER SCHEDULE

TAG NO.	LOCATION	TYPE	FAN APPROX CFM @ 70°F	E.S.P. INCHES H2O	RPM	AIR TEMP. °F	MIN. MBH	WGHT LBS	STEAM CAP. LBS/HR @5PSIG	STEAM TRAP SIZE	MOTOR			VIBRATION ISOLATION		REMARKS
											QTY	HP	VOLT	TYPE	MIN. STATIC DEF. INCHES	
1	DOCK	AIR CURTAIN	7035	-	-	65	100	-	274	251	-	3	1/2	120	-	BERNER INTERNATIONAL MODEL VSA30965 (1)
2	DOCK	AIR CURTAIN	7035	-	-	-	-	-	274	251	-	3	1/2	120	-	BERNER INTERNATIONAL MODEL VSA30965 (1)

1. THERMOSTAT WITH FAN SPEED SELECTOR SWITCH AND COMFORT PLUS CONTROL PACKAGE (UNIT ACTIVATED BY DOOR SWITCH OR THE THERMOSTAT TO PROVIDE SUPPLEMENTAL HEATING). EXTENSION BRACKETS, DOORSWITCH INTERLOCK, 3 SPEED SWITCH, CONTROL PANEL (UH-1-RH, UH-2-LH), STEAM COIL CONNECTIONS (UH-1-RH, UH-2-LH), INLET SPRAYER WITH WRENCH & PLUGS, STAINLESS STEEL CURTAIN, SPRT MOUNTING, 2\"/>

NOT IN CONTRACT

CONVERTER SCHEDULE

UNIT NO.	SERVICE	LOCATION	FLOW RATE		CAPACITY MBH	WATER			NO. OF PASSES	FOULING FACTOR	HEATING SURFACE SQ. FT.	APPROX. SIZE DIAM. X LENGTH	REMARKS
			SHELL	TUBES		TEMP °F							
						INLET	OUTLET						
			STEAM #/HR. AT 5 PSIG	WATER GPM			MAX. P.D. FEET H ₂ O						
10A,10B	PHARMACY	SUB-BASEMENT	477	46.9	458	160	180	2.44	—	.0006	11.5	—	B&G MODEL QSU45-2

1. CAST IRON FRONT HEADER, COPPER TUBES, STEEL SHELL, 2\"/>

BRAZED PLATE HEAT EXCHANGER SCHEDULE


UNIT NO.	SERVICE	LOCATION	HOT SIDE				COLD SIDE				CAPACITY MBH	PLATES NO.	PLATE MATL	EFFECTIVE HEAT SURFACE SQ. FT.	GASKET	REMARKS		
			FLOW GPM	EWI °F	LWT °F	PD PSI	FLOW GPM	EWI °F	LWT °F	PD PSI								
21A,21B	RAMP SNOWMELT	SUB-BASEMENT	6.3	180	160	6.77	—	6.3	80	100	7.38	40	61.5	10	316 SS	1.01	—	B&G MODEL BP400-10

1. 3/4\"/>

HEATING SYSTEM OVERVIEW

SYSTEM COMPONENT:	SYSTEM OUTPUTS			SYSTEM INPUTS										SYSTEM SOFTWARE/CONTROL		
	BINARY	ANA-LOG	BINARY	ANALOG	ANALOG	ANALOG	ANALOG	ANALOG	ANALOG	ANALOG	ANALOG	ANALOG	ANALOG	ALARM PROCESSING	APPLICATION	FUNCTION
Hot Water Pump																
On/Off																
Start/Stop																
Status Auto																
Status Hand																
VFD Control Panel Data																
Hot Water Supply Temperature																
Hot Water Return Temperature																
Hot Water Flow																

- INCLUDES P-10A, P-10B, P-21A, P-21B AND AUTOMATIC CHANGEOVER.
- ALSO PROVIDE START/STOP/STATUS FOR SNOW MELT CONTROL PANEL, GLYCOL SUPPLY & RETURN TEMPERATURES, CONTROL VALVE START/STOP FOR GLYCOL HEAT.
- ALSO PROVIDE FAN START/STOP/STATUS FOR EXISTING EXHAUST FAN IN SHREDDING ROOM.
- ALSO PROVIDE POINTS FOR EXHAUST FAN FOR NEW SHREDDER ROOM.
- ALSO PROVIDE POINTS FOR LOADING DOCK RADIATOR TEMPERATURE & STEAM VALVES.

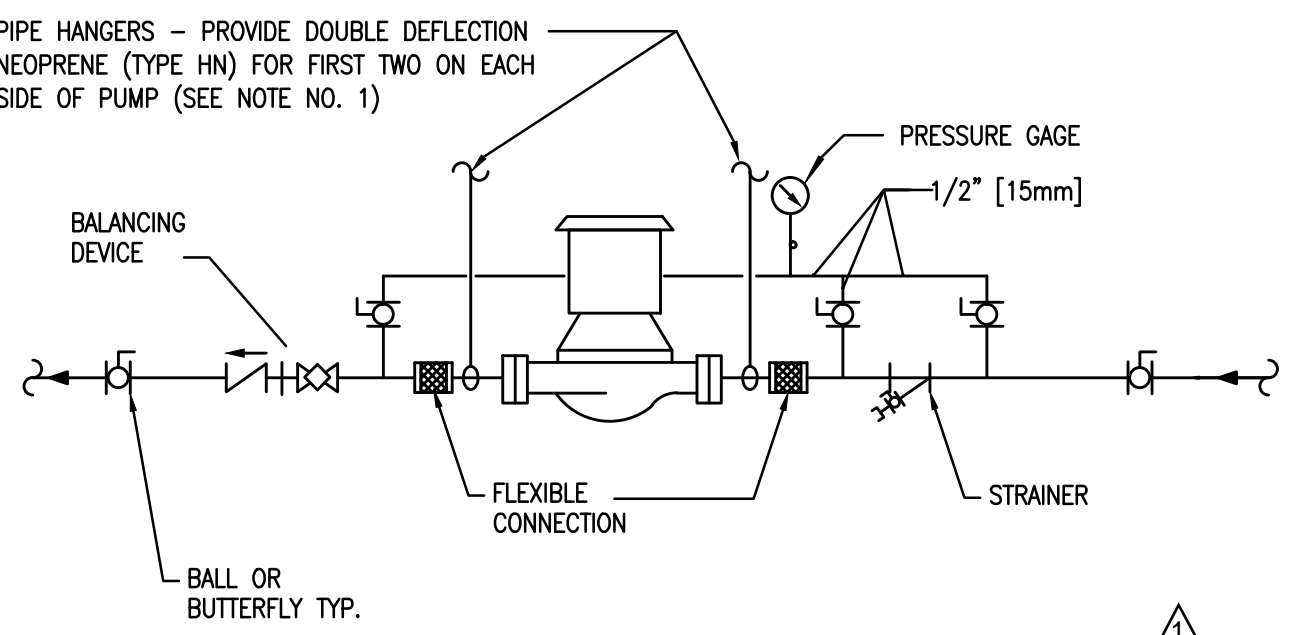

NOTES:

1. SUPPORT PUMP FROM PIPING ONLY. DO NOT SUPPORT PUMP FROM MOTOR.

IN-LINE PUMPS - CONNECTIONS

NTS

ADDENDUM #1 PER OWNER	2/14/17
OWNER REVISIONS	12/23/16
100% CONSTRUCTION DRAWINGS	08/22/14
95% CONSTRUCTION DRAWINGS	01/10/14
50% CONSTRUCTION DRAWINGS	11/08/13
Revisions:	Date

CONSULTANTS:

Ion
Structures and Design, LLC
P.O. Box 466
Plover, Wisconsin 54967
(414) 548-8759 Fax: (414) 921-9746
www.ionic-sd.com

GEI
Consultants
925 W. Washington St. Suite 104
Marquette, MI 49855

ARCHITECT/ENGINEERS:

bailey edward
1 715.203.1843
f 312.440.2303
www.baileyedward.com
315 S. Oneida Ave.
Suite 202
Rhinelander, WI
54501-3422

©2014 Bailey Edward Design
Design Firm License No. 184-001962

Drawing Title

SCHEDULES AND DETAILS

Approved Project Director

Project Title

RENOVATE LOADING DOCK

Location

325 EAST H ST. IRON MOUNTAIN, MI 49801

Date

08/22/14

Checked:

KWL

Drawn:

JB

Project Number

1301-13-06

Building Number

BUILDING 1

Drawing Number

M200

Dwg 28 of 33

Office of
Facilities
Management

Department of
Veterans Affairs